
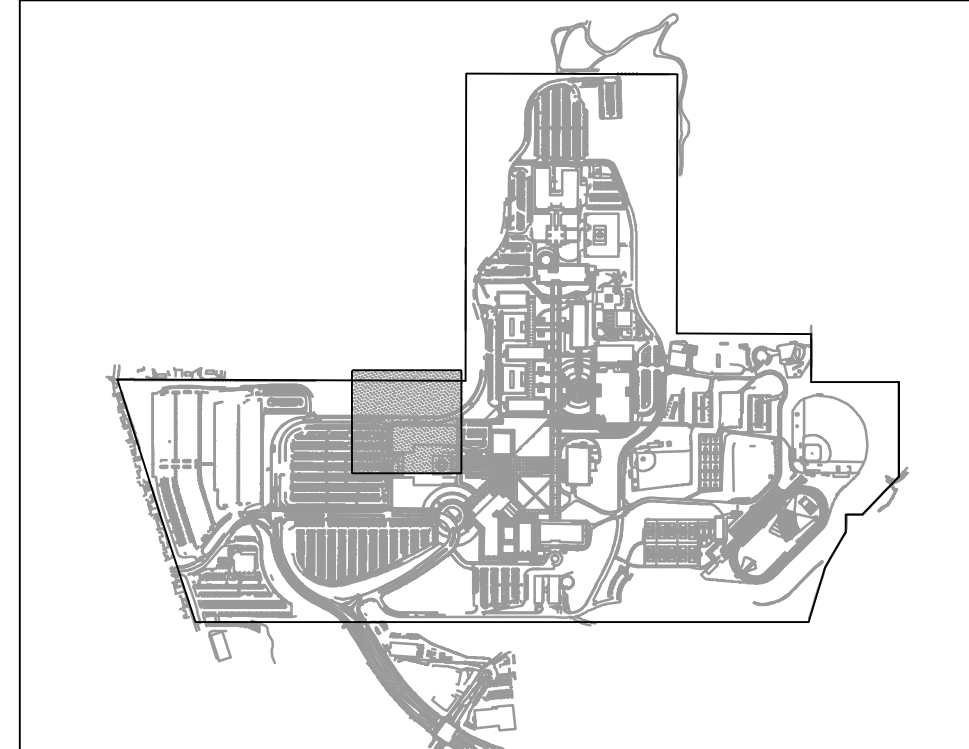


TO BUILDING "A" 2
(DISTRICT ADMIN. OFFICES)

MATCH LINE - SEE SHEET C6.08

MATCH LINE - SEE SHEET C6.04

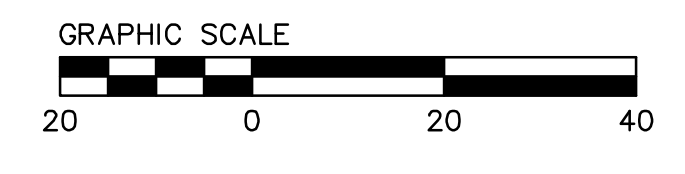

KEYMAP

NOTES

- SEE SHEETS C8.03 THROUGH C8.05 FOR UTILITY DETAILS.

RECORD DRAWINGS

THESE RECORD DOCUMENTS HAVE BEEN PREPARED BASED ON INFORMATION PROVIDED BY OTHERS. BKF ENGINEERS HAS NOT VERIFIED THE ACCURACY AND/OR COMPLETENESS OF THIS INFORMATION AND SHALL NOT BE RESPONSIBLE FOR ANY ERRORS OR OMISSIONS THAT MAY BE INCORPORATED HEREIN AS A RESULT. BKF ENGINEERS DOES NOT ASSUME ANY RESPONSIBILITY FOR THE FIELD MODIFICATIONS TO THE PLANS.


BY: BKF ENGINEERS DATE: JUNE 2011



McCarthy Building Companies, Inc.
343 Sansome Street, 14th Floor
San Francisco, California 94104
P 415 | 364-1339
F 415 | 397-5999



255 SHORELINE DRIVE, SUITE 200
REDWOOD CITY, CA 94065
PHONE: (650) 482-6300
FAX: (650) 482-6399

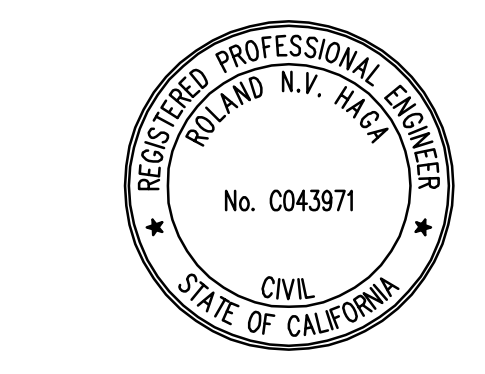

IDENTIFICATION STAMP
DIV. OF THE STATE ARCHITECT
OFFICE OF REGULATION SERVICE

APPL. #: 01-110097

AC: _____ FLS: _____ SS: _____

DATE: _____

FILE NUMBER: _____

This set of other project documents and all items, methods and design incorporated therein are instruments of service. All project documents are the registered property of LPA, INC. LPA, INC. and cannot be copied, used, in whole or in part, for any other project or purpose without the written consent of the undersigned. LPA, INC. and the undersigned hereby agree that the use of the project documents for reproduction or modification (reused) is not only unlawful but also a violation of the public trust. LPA, INC. and the undersigned hereby agree to defend, indemnify and hold LPA, INC. and LPA, INC. harmless to the maximum legal extent against all claims, demands, losses or damages arising directly or indirectly from project documents. Project documents shall be the property of LPA, INC. and shall not be reproduced, in whole or in part, without the written consent of LPA, INC. and LPA, INC. LPA, INC. and LPA, INC. shall not be responsible for any discrepancies between project documents and the existing conditions.

© Copyright 2008

College of San Mateo
Site Package
San Mateo, CA

Developed for
San Mateo County Community College District

Revision	Description	Date

Revision	Description	Date
01	SUBMITTAL	19 SEPT 2008
02	FINAL	09 APRIL 2009
03	PROJECT RECORD DRAWING	JUNE 2011

Job No.	27082.30
Date	02 APRIL 2009
Drawn by	MD, JT
Checked by	RH
Scale	1"=20'

UTILITY PLAN

C6.07