



McCarthy Building Companies, Inc.
 343 Sansome Street, 14th Floor
 San Francisco, California 94104
 P 415 | 364-1339
 F 415 | 397-5999

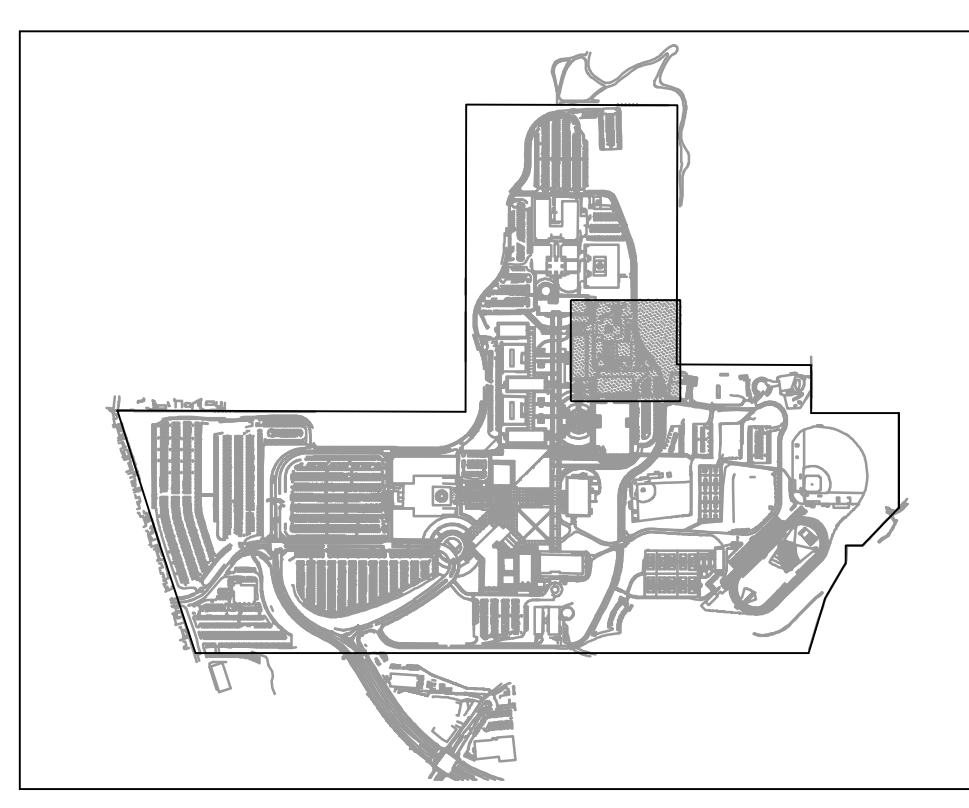

ENGINEERS / SURVEYORS / PLANNERS
 255 SHORELINE DRIVE, SUITE 200
 REDWOOD CITY, CA 94065
 PHONE: (650) 482-6300
 FAX: (650) 482-6399

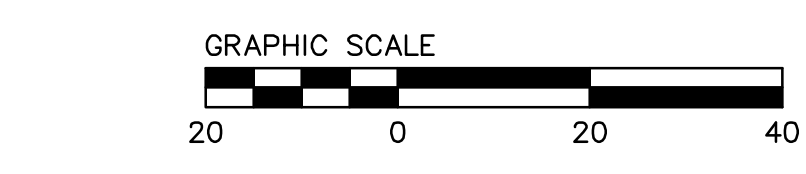

IDENTIFICATION STAMP
 DIV. OF THE STATE ARCHITECT
 OFFICE OF REGULATION SERVICE
 APPL. #: 01-110097
 AC: FLS: SS:
 DATE: _____
 FILE NUMBER: _____

NOTES

- SEE SHEET C8.03 THROUGH C8.05 FOR UTILITY DETAILS.

This and all other project documents are the property of BKF Engineers, Inc. (BKF) and cannot be used, copied, or reproduced in any form without the written consent of BKF. BKF is not responsible for any errors or omissions in this document. BKF is not responsible for any damage to property or injury to persons resulting from the use of this document. BKF is not responsible for any damage to property or injury to persons resulting from the use of this document. BKF is not responsible for any damage to property or injury to persons resulting from the use of this document.

© Copyright 2008

RECORD DRAWINGS

THESE RECORD DOCUMENTS HAVE BEEN PREPARED BASED ON INFORMATION PROVIDED BY OTHERS. BKF ENGINEERS HAS NOT VERIFIED THE ACCURACY AND/OR COMPLETENESS OF THIS INFORMATION AND SHALL NOT BE RESPONSIBLE FOR ANY ERRORS OR OMISSIONS THAT MAY BE INCORPORATED HEREIN AS A RESULT. BKF ENGINEERS DOES NOT ASSUME ANY RESPONSIBILITY FOR THE FIELD MODIFICATIONS TO THE PLANS.

BY: BKF ENGINEERS DATE: JUNE 2011

College of San Mateo
 Site Package
 San Mateo, CA

Developed for
 San Mateo County Community College District

Revision	Description	Date
1	DSN SUBMITTAL	19 SEPT 2008
2	DSA FINAL	09 APRIL 2009
3	RFI # 57	05 AUG 2009
4	RFI # 58	23 JUN 2010
5	PROJECT RECORD DRAWING	JUNE 2011

Revision	Description	Date
1	DSN SUBMITTAL	19 SEPT 2008
2	DSA FINAL	09 APRIL 2009
3	RFI # 57	05 AUG 2009
4	RFI # 58	23 JUN 2010
5	PROJECT RECORD DRAWING	JUNE 2011

Job No. 27082.30
 Date 02 APRIL 2009
 Drawn by MD, JT
 Checked by RH
 Scale 1"=20'

UTILITY PLAN

C6.12