




**1** CATCH BASIN APRON  
NTS

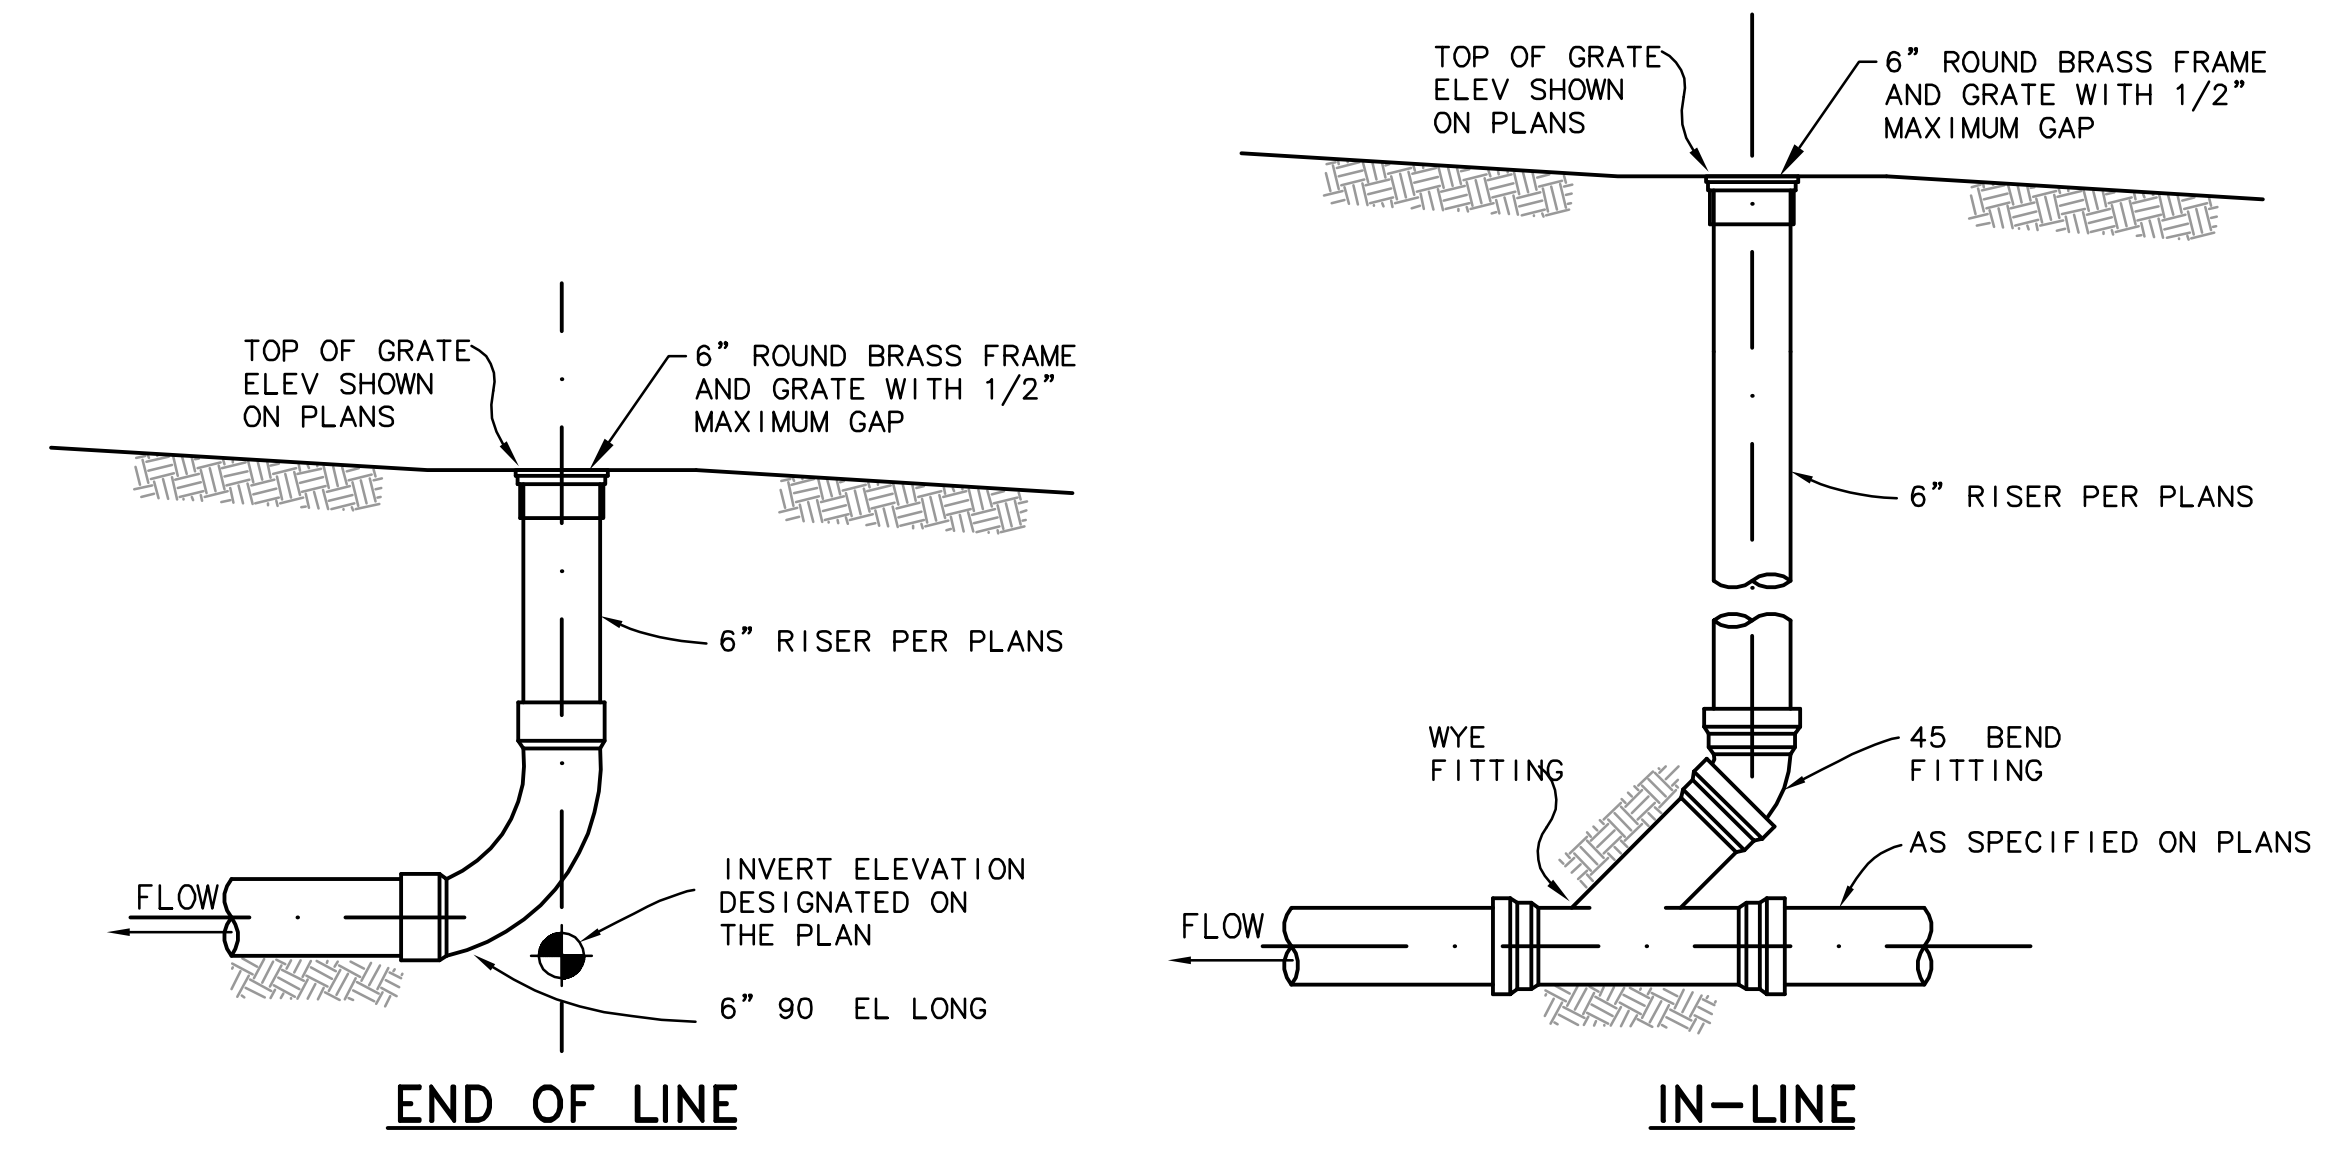


**2** AREA DRAIN  
NTS

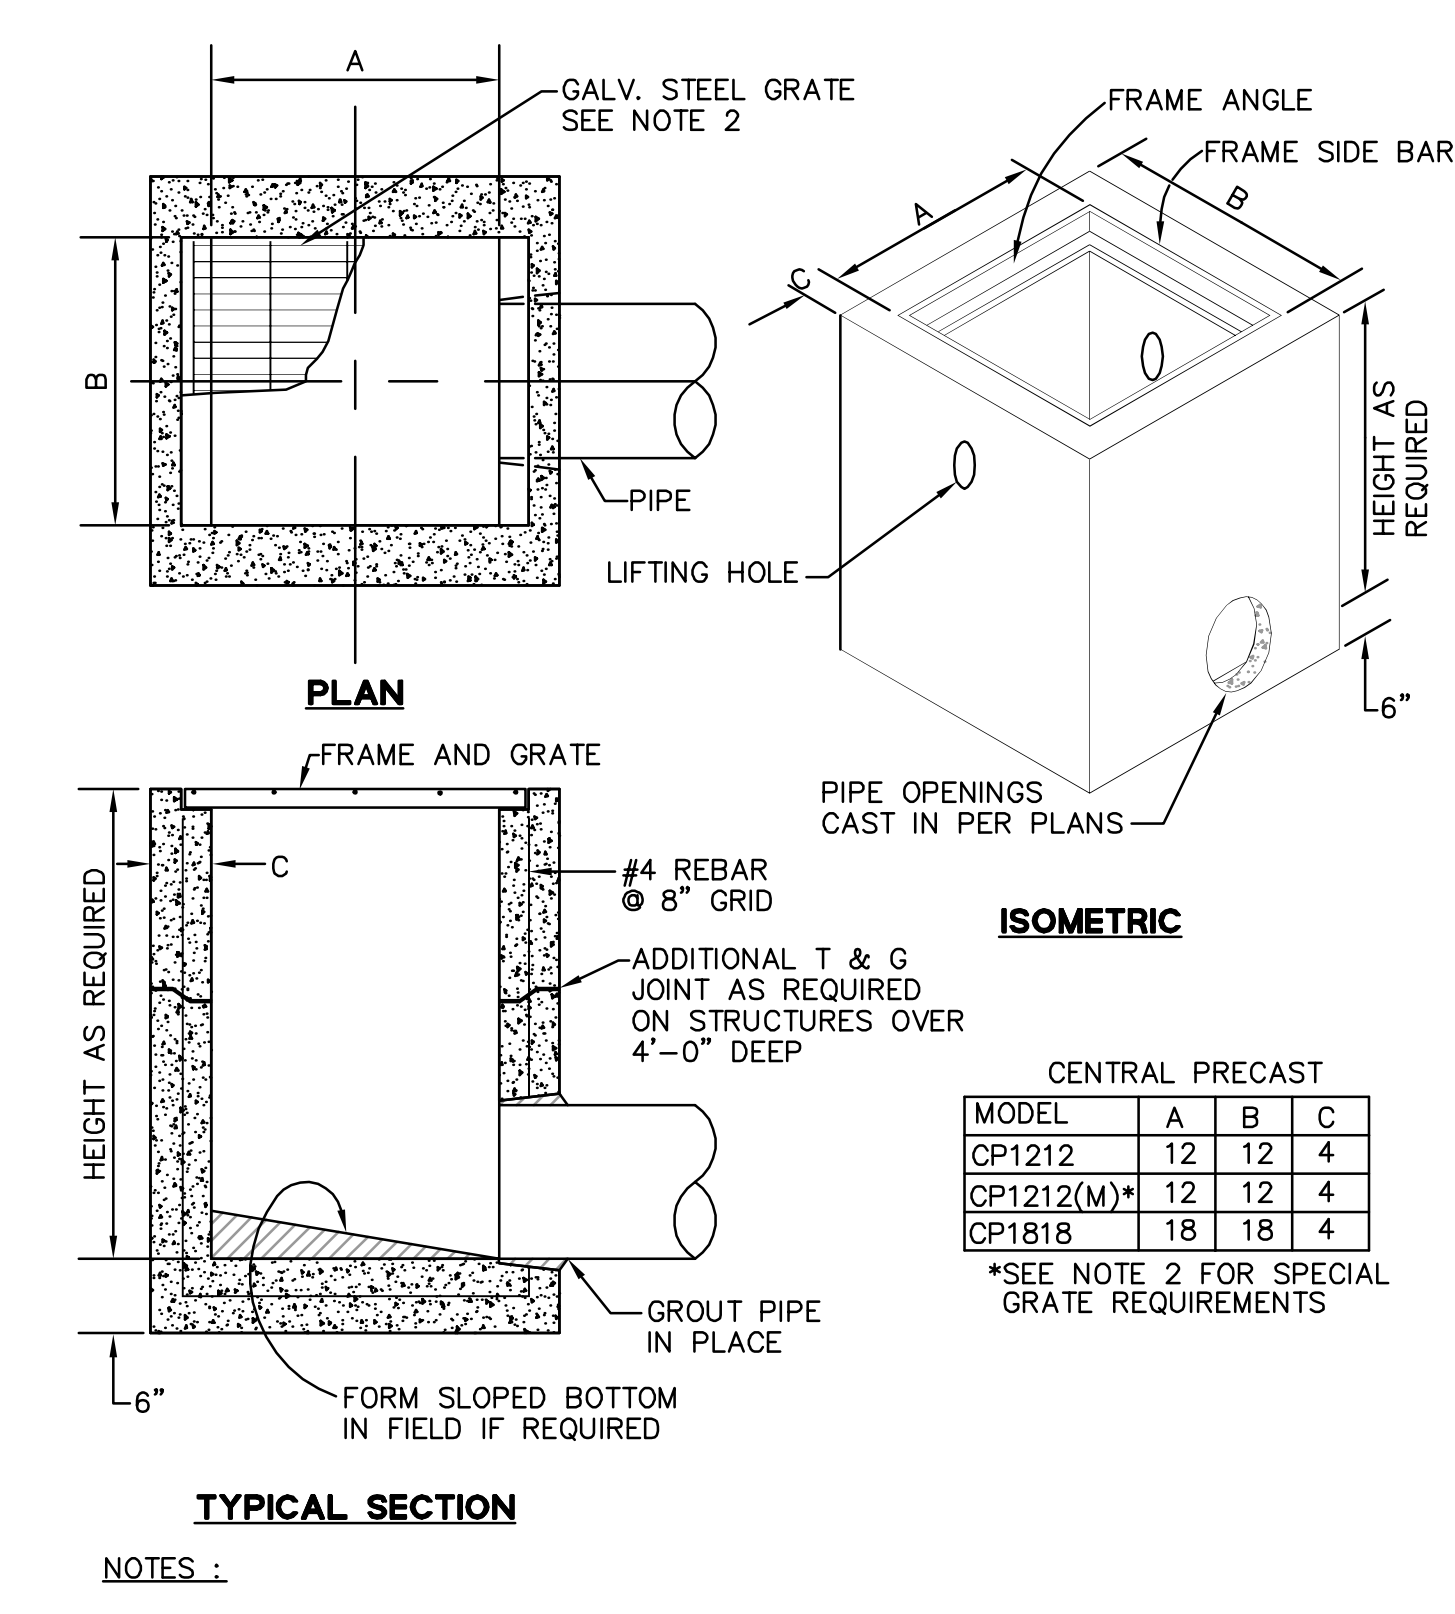


**3** CATCH BASINS FOR LANDSCAPE AREAS  
NTS

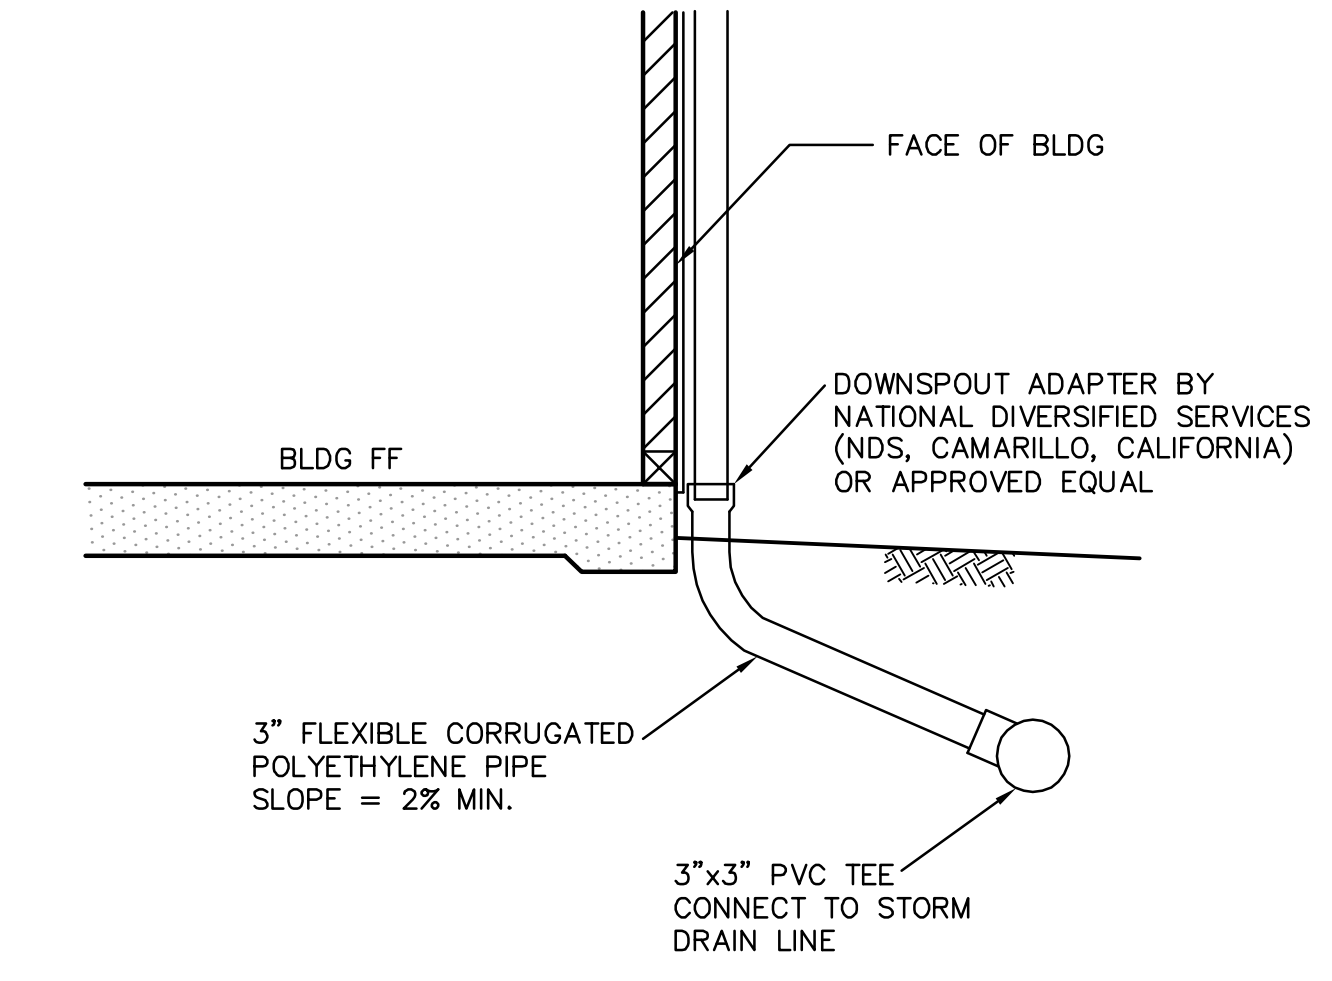


**4** DOWNSPOUT CONNECTION TO AREA DRAIN LATERAL  
NTS

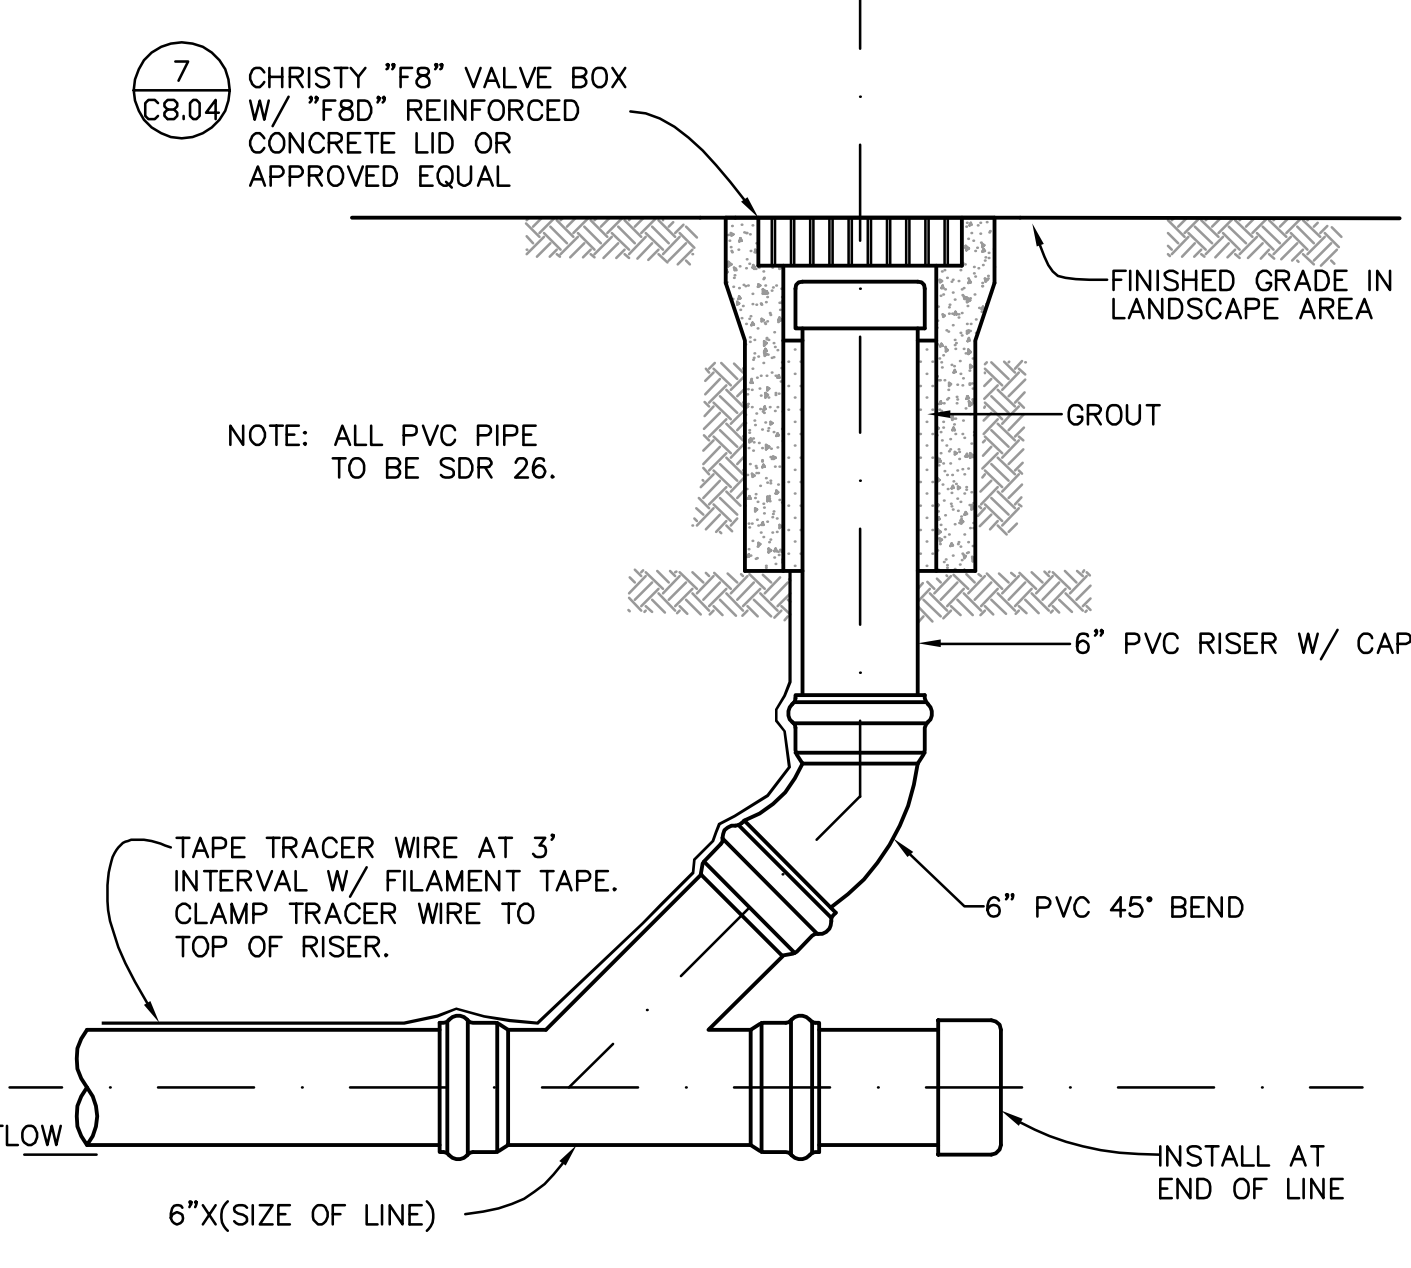

**5** CLEANOUT  
NTS

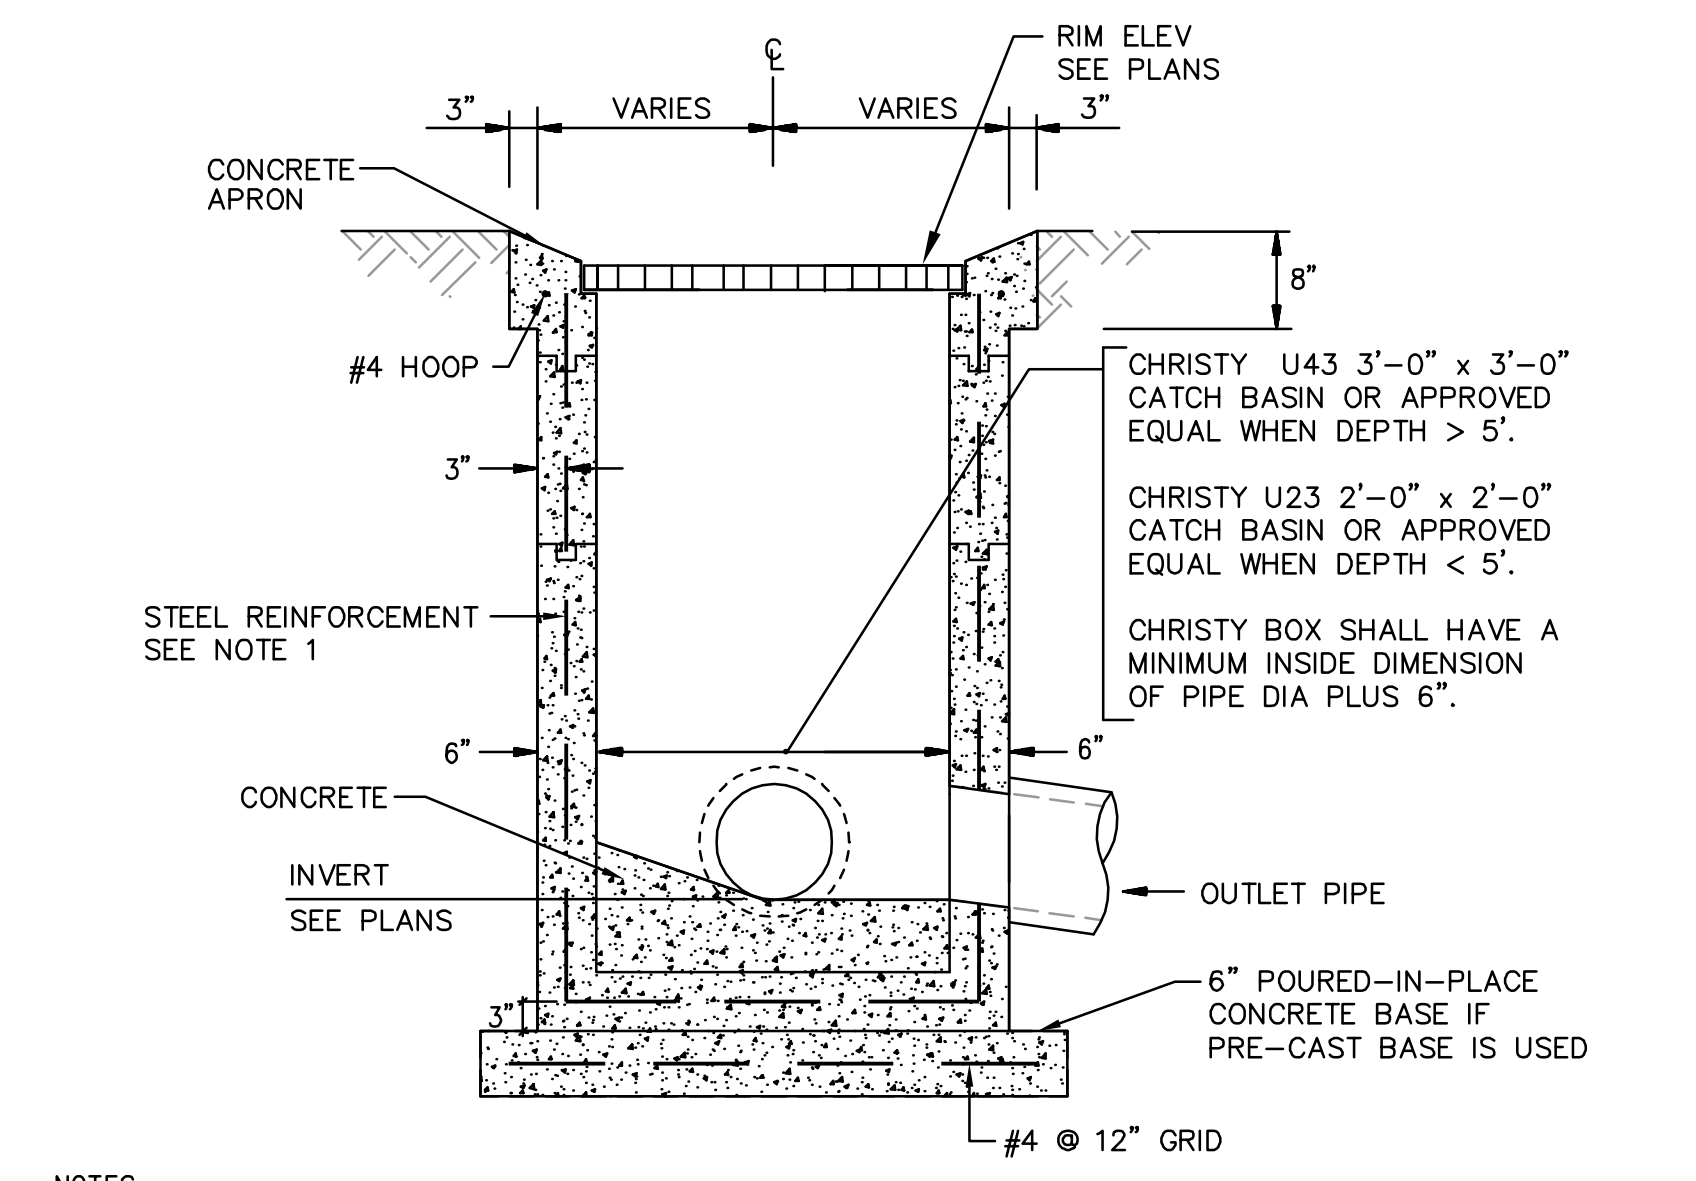


**6** DROP INLET  
NTS

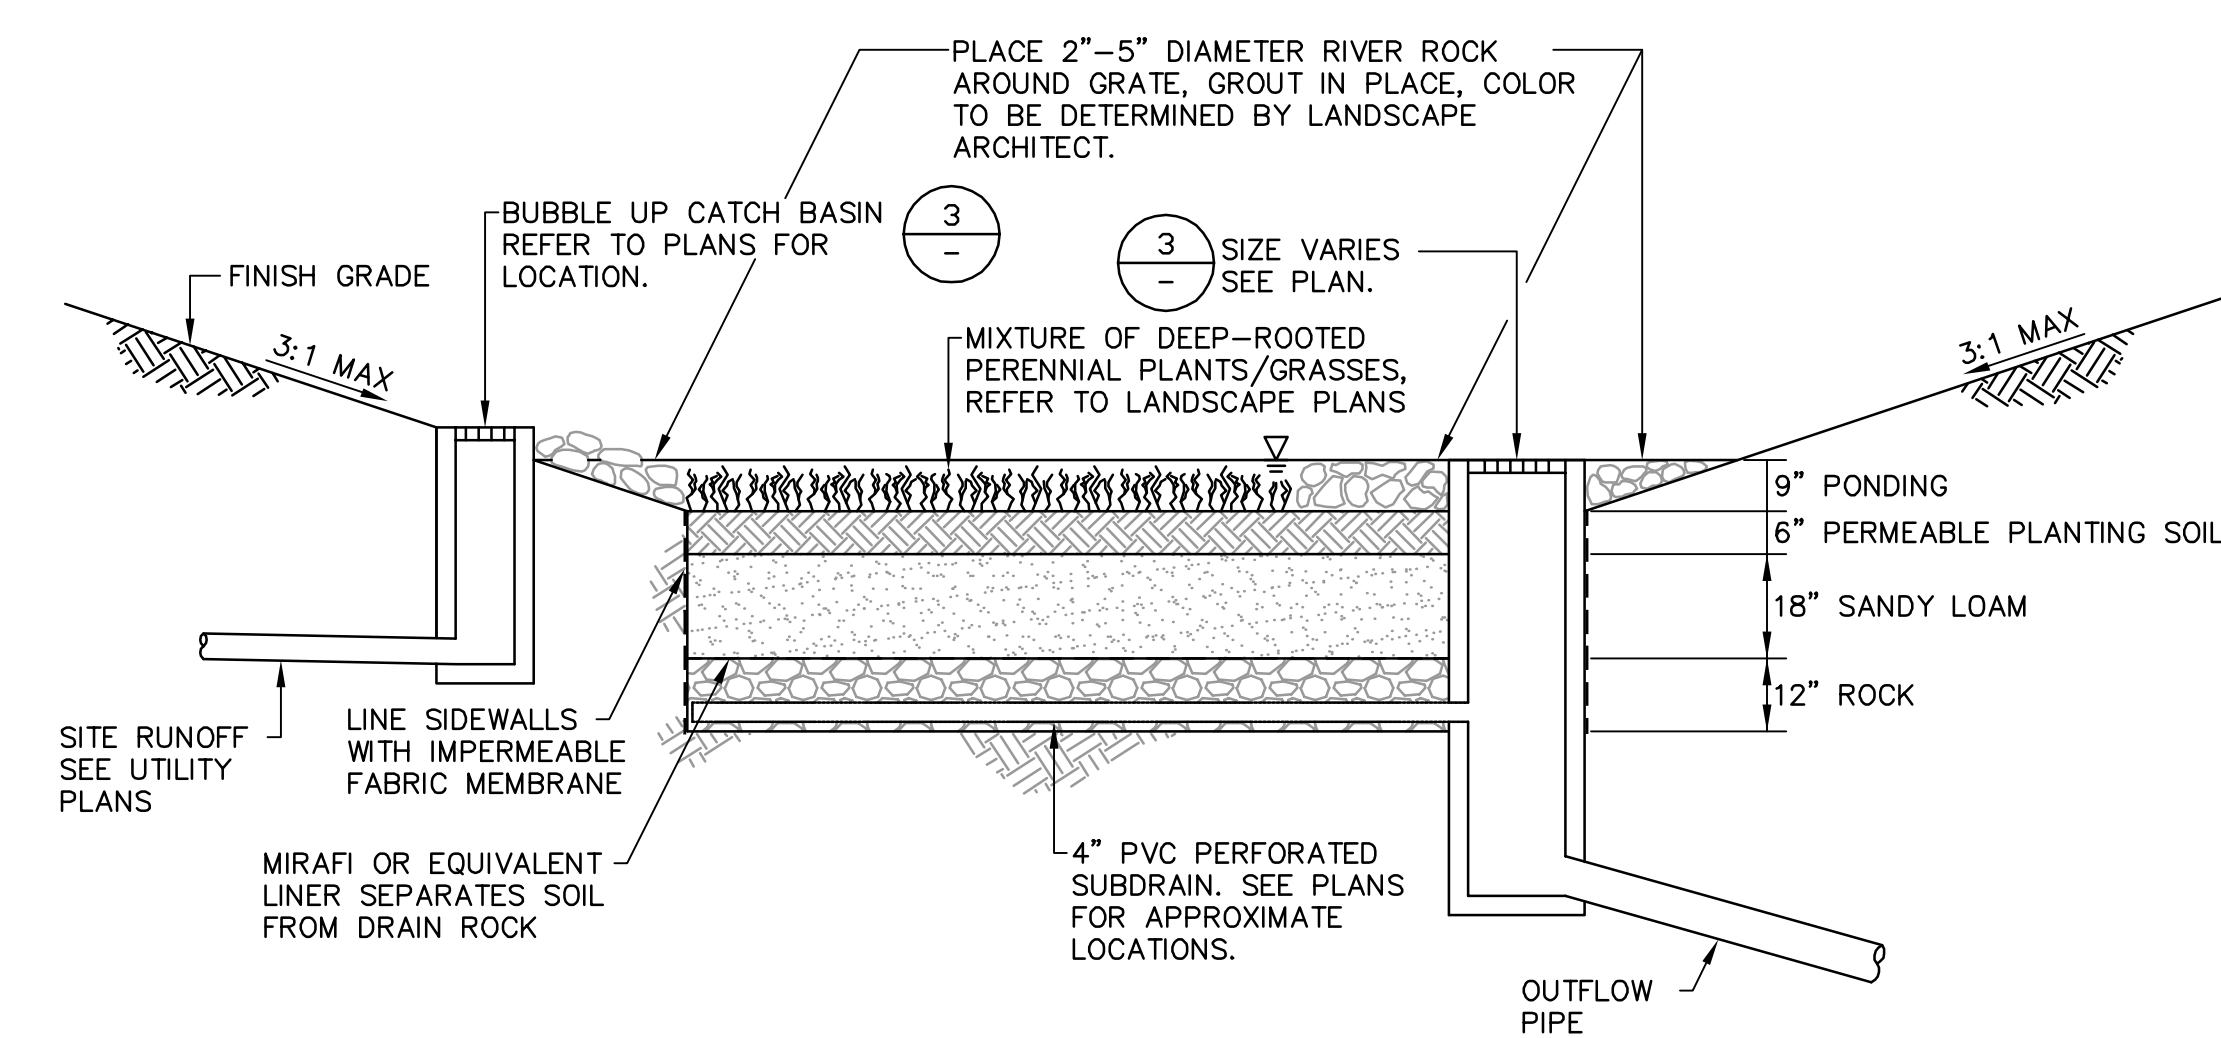

**7** BIO-RETENTION BASIN  
NTS

**RECORD DRAWINGS**  
THESE RECORD DOCUMENTS HAVE BEEN PREPARED BASED ON INFORMATION PROVIDED BY OTHERS. BKF ENGINEERS HAS NOT VERIFIED THE ACCURACY AND/OR COMPLETENESS OF THIS INFORMATION AND SHALL NOT BE RESPONSIBLE FOR ANY ERRORS OR OMISSIONS THAT MAY BE INCORPORATED HEREIN AS A RESULT. BKF ENGINEERS DOES NOT ASSUME ANY RESPONSIBILITY FOR THE FIELD MODIFICATIONS TO THE PLANS.  
BY: BKF ENGINEERS DATE: JUNE 2011

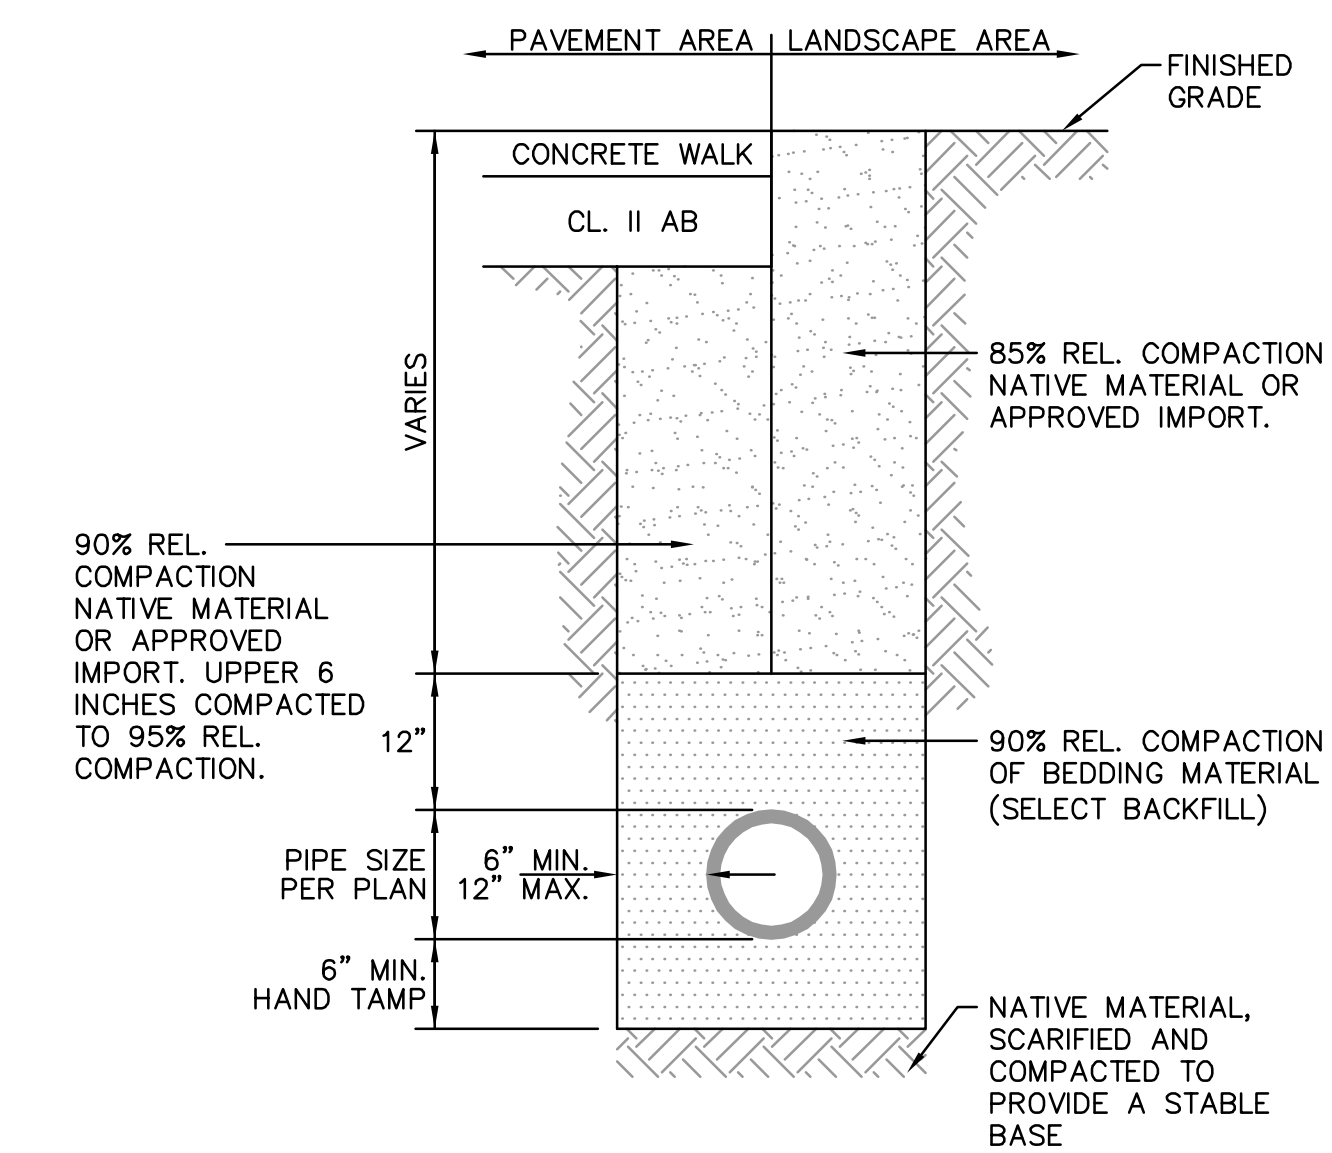

**8** TRENCH DETAIL  
NTS

Revision	Description	Date

Revision	Description	Date

Job No.	27082.30
Date	02 APRIL 2009
Drawn by	MD, JT
Checked by	RH
Scale	AS SHOWN