

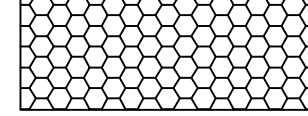
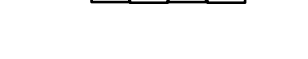
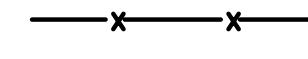


NOTES:

1. SEE SHEET C9.04 FOR EROSION CONTROL NOTES AND DETAILS.
2. PLACE EROSION CONTROL FABRIC ALONG BOTTOM EDGE OF ALL CHAIN LINK FENCING, SEE DETAIL 5 ON SHEET 9.04.
3. PROTECT ALL EXISTING INLETS PER DETAIL 1 ON SHEET C9.04.
4. PROTECT ALL STOCKPILES IN ACCORDANCE WITH THE SWPPP APPENDIX Q, SECTION WM-3. STOCKPILE PILES SHALL HAVE A FIBER ROLL AROUND ENTIRE PERIMETER.
5. PROVIDE AN ENTRANCE/OUTLET TIRE WASH IN COORDINATION WITH THE DESIGNATED CONSTRUCTION ENTRANCE/EXITS. CONSULT WITH THE SWPPP APPENDIX Q, SECTION TC-3 FOR ALL APPLICABLE REQUIREMENTS.

LEGEND:

-  FIBER ROLL
SEE DETAIL 3 ON SHEET C9.04
-  INLET PROTECTION
SEE DETAIL 1 ON SHEET C9.04
-  STABILIZED CONSTRUCTION ENTRANCE
SEE DETAIL 2 ON SHEET C9.04
-  GRAVEL FILLED BAG CHECK DAMS
SEE DETAIL 4 ON SHEET C9.04
-  CHAIN LINK FENCE WITH SILT FENCE ALONG BOTTOM EDGE
SEE DETAIL 5 ON SHEET C9.04

RECORD DRAWINGS

THESE RECORD DOCUMENTS HAVE BEEN PREPARED BASED ON INFORMATION PROVIDED BY OTHERS. BKF ENGINEERS HAS NOT VERIFIED THE ACCURACY AND/OR COMPLETENESS OF THIS INFORMATION AND SHALL NOT BE RESPONSIBLE FOR ANY ERRORS OR OMISSIONS THAT MAY BE INCORPORATED HEREIN AS A RESULT. BKF ENGINEERS DOES NOT ASSUME ANY RESPONSIBILITY FOR THE FIELD MODIFICATIONS TO THE PLANS.

BY: BKF ENGINEERS DATE: JUNE 2011



McCarthy Building Companies, Inc.
343 Sansome Street, 14th Floor
San Francisco, California 94104
P 415 | 364-1339
F 415 | 397-5999



BKF ENGINEERS / SURVEYORS / PLANNERS
255 SHORELINE DRIVE, SUITE 200
REDWOOD CITY, CA 94065
PHONE: (650) 482-6300
FAX: (650) 482-6399



IDENTIFICATION STAMP
DIV. OF THE STATE ARCHITECT
OFFICE OF REGULATION SERVICE

APPL. # 01-110097

AC: _____ FLS: _____ SS: _____

DATE: _____

FILE NUMBER: _____

This and all other project documents are the property of BKF Engineers, Inc. (BKF) and shall be held in confidence and not be used for any other project without the written consent of BKF Engineers, Inc. No part of this document may be reproduced or transmitted in any form or by any means, electronic, mechanical, photocopying, recording, or by any information storage and retrieval system, without the prior written permission of BKF Engineers, Inc. BKF Engineers, Inc. is not responsible for any errors or omissions in this document. BKF Engineers, Inc. is not responsible for any errors or omissions in this document. BKF Engineers, Inc. is not responsible for any errors or omissions in this document. BKF Engineers, Inc. is not responsible for any errors or omissions in this document.

© Copyright 2008

College of San Mateo
Site Package
San Mateo, CA

Developed for
San Mateo County Community College District

Revision	Description	Date
1	PROJECT RECORD DRAWING	JUNE 2011
2	PROJECT RECORD DRAWING	APRIL 2009
3	PROJECT RECORD DRAWING	SEPT 2008

Job No.	27082.30
Date	02 APRIL 2009
Drawn by	MD, JT
Checked by	RH
Scale	1"=40'

EROSION CONTROL PLAN

C9.02