<u>CERTIFICATE O</u>			
	NIZATION - BUILDING 16, 17, 1	8 RENOVATION	DATE
4200 FARM HILL BOULEVA	ARD, REDWOOD CITY, CA 94061	- 1099	
PPINCS AL DESIGNER LIGHTING		TREFROM	Bussing Pennis
YEI ENGINEERS INC.		510-383-1050	
DEN DEN AUTEON AUTEON METHOD OF COMPLIANCE DEN	NIS DIAS	510-383-1050	Checkes by Cain Erden en Arresy Use
GENERAL INFORMATION			
DATE OF PLANS	BUILDING CONDITIONED FLOOR A	AEA 4,995 SQ FT	OLAMATE ZOME 3
Burding Type	X NOVRESIDENTIAL CHRONICE	ie residential	HOTELAKOTEL GUES
💹 coromoned spaces	🔯 unconditioned spaces 🚨	I INDOCR / OUTDOOR SIGNS	e Tainibilitähäistikset in intoksiulut inisiää kohissa olikkaassa näivaksiatohiatitaikaituutain ovi neuvenen m
PHASE OF CONSTRUCTION	D NEW D ADDITE	المراجعة ال	
METHOD OF COMPLANCE	A Secretary Company of the Control o		
	1975)[************************************	Succession of the second secon
	iplete building 🛮 🗴 Area Categoi		II common lightneg
STATEMENT OF COMPLIANCE This Conflictor of Commission Sets the	building features and performance epecificat	ions used to envolve with Tilla 25	Paris 1 and 6 of the Collinsia
Gode of Regulations. This certificate a	pplies only to building righting requirements.		
The documentation propares hereby of INCLESSINTATION AUTHOR	vities that the documentation is accurate and	i scancibio. Também	ritimatat perioden repretina en republika este reduce periode architectur. OATE
DENNIS DIAS	Same is wrone that the is law this lattice of		
wilding has been designed to meet lig	sts, with the specifications, and with any oth philing requirements contained in applicable (arts of Sections 110, 119,156-13	2, 146, 149, & 149 of Title: 34,
building has been designed to meet by 5. X The plans & specifications meet Part 6 (12-103a 3). The operation & maintenance into Piease check one: (These exclusion in the I am eligible responsible for its preparation; and I after the I am eligible under I document as the person responsition of work described as exempt pure PRECIPAL LIGHTING DESCRETARAGE DENNIS DIAS	philing requirements contained in applicable (the requirements of Part 6 (Sections 10-1 emailton meet the requirements of Part 6 (10- ns of the Business and Professions Code are under the provisions of Division 3 of the Bu- d that I am licensed in the State of California the provisions of Division 3 of the Business ble for its preparation, and that I am a license lyiston 3 of the Business and Professions Code Sect (15) BUSINETURE	ents of Sections 110, 119, 150–13 (03a). The Installation central (03a). (2, 146, 146, & 149 of Tale 34, pains meet the requirements. I Manual.) sign this document as the papineer, or I am a Scarced with a 5537.2 or 5737.3 to sign the content of the papineer.
building has been designed to meet by 5. IX The plans & specifications meet by Part 6 (10-503e 3). II The operation & meintenence into Piegos of each one: (These section I hereby silling that I am eligible inspronsible for its preparation; and I affirm that I am eligible under I document as the person responsible for the person responsible of work described as exempt runs PRACIPAL LIGHTING DESCRERAGAIE DENNIS DIAS LEGHTING MANDATORY MEASURES	philing requirements contained in applicable (the requirements of Part 6 (Sections 10-1) emailton meet the requirements of Part 6 (10- ns of the Business and Professions Code are under the provisions of Division 3 of the Bu d that I am licensed in the State of California the provisions of Division 3 of the Business ble for its preparation, and that I am a license lyision 3 of the Business and Professions Code Sect usent to Business and Professions Code Sect	serts of Sections 110, 119, 150–13 (03a). **Little Installation central (03a). **Little Installation central (03a). **Different Code in the Normasideation (sineses and Professions Code to as a civit engineer or electrical engineer or electrical engineer or electrical engineer or electrical engineer of electrical engineers of the sign shis document because ions 5537, 5339 and 6737.1. [CATE]	2. 146, 149, & 149 of Title 34, salve meat the requirements I Manual.) sign this document as the polymer, or I am a scarced with a 5037.2 or 6737.3 to sign if the portains to a structure or type LIC. 8
building has been designed to meet by 5. IX The plans & specifications meet Part 6 (10-103a 3). If the operation & maintenance into Piease check one: (These section I hereby affirm that I am eligible mapponeithe for its preparation; and the document as the person responsit I defirm that I am eligible under I document as the person responsit I defirm that I am eligible under Diet work described as exempt pure Protection I I defirm that I am eligible under Diet work described as exempt pure Protection I I defirm that I am eligible under Diet work described as exempt pure Protection I I defirm that I am eligible under Diet work described as exempt pure Protection I I defirm that I am eligible under Diet I am eligible under Diet I defirm that I am eligible under Diet I am eligible under Diet I defirm that I am eligible under Diet I defirm that I am eligible under Diet I defirm that I am eligible under Diet I am eligib	philing requirements contained in applicable (the requirements of Part 6 (Sections 10-1) rematice meet the requirements of Part 6 (10- ns of the Business and Professions Code are under the provisions of Division 3 of the Bu- d that I am licensed in the State of California- the provisions of Division 3 of the Business ble for its preparation; and that I am a focuse vision 3 of the Business and Professions Code Sect SIGNATURE	ents of Sections 110, 119, 150–13 (03a). The Installation central (03a). printed in full in the Normsideedia usiness and Professions Code to as a civil engineer or electrical engineer or electrical engineer of electrical engineers of electrical electrical engineers of ele	2. 146, 146, & 149 of Talic 34, pains meet the requirements I Manual.) sign this document as the polymen, or Lam a Scansod archit n 5037.2 or 6737.3 to sign the transitions to a structure or type LIC.8
building has been designed to meet by S. IX The plans & specifications meet by Peri 6 (10-103e 3). II The operation & maintenance into Please of eck one: (These section II hereby effirm that I am eligible under I document as the person responsition at the person responsition of the person responsition of very described as exempt pure DENNIS DIAS LIGHTING MANDATORY MEASURES I Indicate location on plant LIGHTING COMPLANCE FORMS & I	philing requirements contained in applicable parties requirements of Part 6 (Sections 10-1) If the requirements of Part 6 (Sections 10-1) If the requirements of Part 6 (10-1) If the Business and Professions Code are under the provisions of Division 3 of the Business of Division 3 of the Business are provisions of Division 3 of the Business are professions Code Sectivision 3 of the Business and Professions Code Sectivision 10 Business and Professions Code Sectivision 10 Business and Professions Code Sectivision (Section Section Section Section (Section Section Secti	ents of Sections 110, 119, 150–13 (03a). Charley in the Installation central (103c). printed in full in the Normacideatia usiness and Professions Code to as a cyd engineer or electrical engineer of electrical engineers of the sign shis document because ions 5537, 5339 and 5737.1. DATE DRAWING DRAWING	2. 148, 148, & 149 of Tale 34, satas meet the requirements I Manual.) sign this document as the political of Local and Scansed with a 5037.2 or 5737.3 to sign the portains to a structure or type I Local and I L
building has been designed to meet by 5. IX The plans & specifications meet Part 6 (10-103a 3). II The operation & maintenance into Please check one: (These section I hereby sillion that I am eligible mapponeithe for its preparation; and I aftern that I am eligible under I decurrent as the person responsit I define that I am eligible under Died work described as exempt pure PRINCIPAL LIGHTING DESCREEN MALE DENNIS DIAS LIGHTING MANDATORY MEASURES Y Indicate location on plant LIGHTING COMPLANCE PORMS & A	philing requirements contained in applicable (the requirements of Part 6 (Sections 10-1) remation meet the requirements of Part 6 (10- his of the Sushness and Professions Code are under the provisions of Division 3 of the Bu d that I am licensed in the State of California the provisions of Division 3 of the Business ble for its preparation, and that I am a focuse vision 3 of the Business and Professions Code Sect licent to Business and Professions Code Sect SIGNATURE VORKSHEETS (pheck box if worksheet is VORKSHEETS (pheck box if worksheet is	serts of Sections 110, 119, 150–13 (03a). **D** The Inefallation central 103c). printed in full in the Normscidentia usiness and Professions Code to as a civil engineer or electrical engineer or electrical engineer of electrical engineers of the sign shis document becomes ions 5537, 5339 and 6737.1. DRAWING Included) 2 of 4 are required for all submitts	2. 146, 146, & 149 of Tale 34, paiss meet the requirements. I Manual.) Sign this document as the politices, or Lam a Scarced archite 5637.2 or 6737.3 to sign if the partitions to a structure or type. LIC. 8 EO.21
building has been designed to meet by 3. IN The plans & specifications meet by Part 6 (10-503a 3). If The operation & maintenance into Please of each one: (These section I hereby affirm that I am eligible under I document as the person responsible for its preparation; and I affirm that I am eligible under I document as the person responsible leaffing that I am eligible under I of very described as exempt sum PRACIPAL LIGHTING DESCRERAVANE DENNIS DIAS LIGHTING MANDATORY MEASURES I Indicate location on plant LIGHTING COMPLANCE PORMS & VERTICAL COMPLANCE	philing requirements contained in applicable (the requirements of Part 6 (Sections 10-1 rmatica meet the requirements of Part 6 (10- ns of the Business and Professions Code are under the provisions of Division 3 of the Business the provisions of Division 3 of the Business the provisions of Division 3 of the Business tile for its preparation, and that I am a focus triston 3 of the Business and Professions Code Sect triston 3 of the Business and Professions Code Sect SIGNATURE IS OF Note Block for Mandatory Meas WORKSHEETS (speck box if worksheet is Contilicate of Compliance. Part 1 of 4 and Certificate of Compliance. Part 3 of 4 auto-	serts of Sections 110, 119, 150–13 (03a). The Installation central (03a). Printed in full in the Normsideatia usiness and Professions Code to as a civil engineer or electrical eng and Professions Code by seotio d contractor performing this work. ds to sign this document because ions 5537, 5339 and 6737.1. CATE DRAWING included) 2 of 4 are required for all submitta rittel is required only if Control Cre	2. 146, 146, & 149 of Tale 34, salas meet the requirements. I Manual.) sign this document as the politices, or I am a document as the politices, or I am a document as the politices. Or 5707.3 to sign if it partains to a structure or type. EC. 8 EO.21
building has been designed to meet by 5. IX The plans & specifications meet by Peri 6 (10-103a 3). II The operation & maintenance into Piegase check one: (These section I hereby affirm that I am eligible mapponeithe for its preparation; and I affirm that I am eligible under I document as the person responsit I refirm that I am eligible under Di of work described as exempt pure PRACIPAL LIGHTING DESCREEN VALLE DENNIS DIAS LIGHTING MANDATORY MEASURES Y Indicate location on plant Denting Complantor Posts of A and 2 of 4 II LTG-1-C, Part 1 of 4 and 2 of 4 II LTG-1-C, Part 1 of 4 and 2 of 4 II LTG-1-C, Part 1 of 4	the requirements cordened in applicable of the requirements of Part 6 (Sections 10-1) emailton meet the requirements of Part 6 (10-ns of the Spainess and Professions Code are under the provisions of Division 3 of the Bud that I am trouvelous divide State of California the provisions of Division 3 of the Budiness the for its preparation; and that I am a ficense vision 3 of the Business and Professions Code Section to Business and Professions Code Section to Business and Professions Code Section of Note Block for Mandatory Meas Workshieters (check box if workshieters (compliance, Part 1 of 4 and Certificate of Compliance, Part 1 of 4 auto Contificate of Compliance, Part 1 of 4 auto Contificate of Compliance, Part 1 of 4 auto	serts of Sections 110, 119, 150–13 (03a). The Installation central (03a). Printed in full in the Normsideatia usiness and Professions Code to as a civil engineer or electrical eng and Professions Code by seotio d contractor performing this work. ds to sign this document because ions 5537, 5339 and 6737.1. CATE DRAWING included) 2 of 4 are required for all submitta rittel is required only if Control Cre	2. 146, 146, & 149 of Tale 34, salas meet the requirements. I Manual.) sign this document as the politices, or I am a document as the politices, or I am a document as the politices. Or 5707.3 to sign if it partains to a structure or type. EC. 8 EO.21
building has been designed to meet by 5. X The plans & specifications meet Part 6 (10-103a 3). The operation & maintenance into Piease check one: (These sector II inevelby affirm that I am eligible responsible for its preparation; and I affirm that I am eligible under I decument as the person responsible to decument as the person deciment. LIGHTING COMPLAINCE PORMS & 1 I LTG-1-C, Part 1 of 1 and 2 of 4 I LTG-1-C, Part 4 of 4 III LTG-1-C, Part 4 III LTG-1-C, Part 4 of 4 III LTG-1-C, Part 4	the requirements contained in applicable of the requirements of Part 6 (Sections 10-1 emailton meet the requirements of Part 6 (10-ns of the Business and Professions Code are under the provisions of Division 3 of the Business of the Business of Division 3 of the Business like for its preparation, and that I am a focus let for its preparation, and that I am a focus let for its preparation, and that I am a focus let for its preparation, and that I am a focus let for its preparation, and that I am a focus let for its preparation, and that I am a focus let for its preparation, and that I am a focus let for its preparation of Professions Code Sectional States of General Professions Code Sectional States of Compliance. Part 1 of 4 and Certificate of Compliance. Part 3 of 4 automatical Lighting Schedule	serts of Sections 110, 119, 150–13 (03a). The Installation central (03a). Printed in full in the Normsideatia usiness and Professions Code to as a civil engineer or electrical eng and Professions Code by seotio d contractor performing this work. ds to sign this document because ions 5537, 5339 and 6737.1. CATE DRAWING included) 2 of 4 are required for all submitta rittel is required only if Control Cre	2. 146, 148, & 149 of Tale 34, salas meet the requirements. I Manual.) sign this document as the politices, or Lam a scansed archita 5037.2 or 5737.3 to sign the transition of type the control of the
building has been designed to meet by 5. IX The plans & specifications meet by Part 6 (10-103a 3). II The operation & meintenence into Pisque of each one: (These section I hereby efficin that I am eligible under I document as the person responsition and the decument as the person responsition of work described as exempt pure Person responsition DESCREAMED LIGHTING DESCREAMED DENNIS DIAS LIGHTING MANDATORY MEASURES IN LTG-1-C, Part 1 of 1 and 2 of 4 IX LTG-1-C, Part 4 of 4 IX LTG-1-C, Part 4 of 4 IX LTG-2-C	the requirements corrieries in applicable of the requirements of Part 6 (Sections 10-1) creation meet the requirements of Part 6 (10-ns of the Business and Professions Code are under the provisions of Division 3 of the Business and Professions of California the provisions of Division 3 of the Business and Professions Code Sectivision 3 of the Business and Professions Code Sectivision 3 of the Business and Professions Code Section to Business and Professions Code Section 1 of the Business and Professions Code Section 1 of More Block for Mandatory Meas WORKSHEETS (check box if worksheet is Conflicate of Compliance. Part 1 of 4 and Certificate of Compliance. Part 1 of 4 automatical Lighting Scheckule	serts of Sections 110, 119, 150–13 (03a). The Installation central (03a). Printed in full in the Normsideatia usiness and Professions Code to as a civil engineer or electrical eng and Professions Code by seotio d contractor performing this work. ds to sign this document because ions 5537, 5339 and 6737.1. CATE DRAWING included) 2 of 4 are required for all submitta rittel is required only if Control Cre	2. 146, 148, & 149 of Tale 34, salas meet the requirements. I Manual.) sign this document as the politices, or Lam a scansed archita 5037.2 or 5737.3 to sign the transition of type the control of the
building has been designed to meet by 6. IX The plans & specifications meet Part 6 (10-103e 3). II The operation & maintenance into Please check one: (These section I hereby affirm that I am eligible neoponsible for its preparation; and I affirm that I am eligible under I document as the person responsible for the	the requirements contained in applicable of the requirements of Part 6 (Sections 10-1 emailton meet the requirements of Part 6 (10-ns of the Business and Professions Code are under the provisions of Division 3 of the Business of the Business of Division 3 of the Business like for its preparation, and that I am a focus let for its preparation, and that I am a focus let for its preparation, and that I am a focus let for its preparation, and that I am a focus let for its preparation, and that I am a focus let for its preparation, and that I am a focus let for its preparation, and that I am a focus let for its preparation of Professions Code Sectional States of General Professions Code Sectional States of Compliance. Part 1 of 4 and Certificate of Compliance. Part 3 of 4 automatical Lighting Schedule	serts of Sections 110, 119, 150–13 (03a). The Installation central (03a). Printed in full in the Normsideatia usiness and Professions Code to as a civil engineer or electrical eng and Professions Code by seotio d contractor performing this work. ds to sign this document because ions 5537, 5339 and 6737.1. CATE DRAWING included) 2 of 4 are required for all submitta rittel is required only if Control Cre	2. 146, 148, & 149 of Tale 34, salas meet the requirements. I Manual.) sign this document as the politices, or Lam a scansed archita 5037.2 or 5737.3 to sign the transition of type the control of the
building has been designed to meet by 6. IX The plans & specifications meet Part 6 (10-103a 3). If the operation & maintenance into Please check one: (These sector of the please check one: (These sector of the proposition for its preparation; and I affirm that I am eligible under I document as the person responsible for its preparation; and I affirm that I am eligible under I document as the person responsible I affirm that I am eligible under I of work described as exempt pure PRINCIPAL LIGHTING DESCRETAMANE DENNIS DIAS LEGHTING MANDATORY MEASURES I Indicate location on plant LIGHTING COMPLANCE PORMS & 1 I LTG-1-C, Part 1 of J and 2 of 4 I LTG-1-C, Part 3 of 4 I LTG-1-C, Part 4 of 4 I LTG-1-C, Part 4 of 4 I LTG-1-C, Part 4 of 4 I LTG-1-C, Part 5 of 5 and 2 of 6 I LTG-4-C I LTG-4-C I LTG-4-C	the requirements cordened in applicable of the requirements of Part 6 (Sections 10-1) emails meet the requirements of Part 6 (10-ns of the Business and Professions Code are under the provisions of Division 3 of the Business the provisions of Division 3 of the Business the provisions of Division 3 of the Business the for its preparation, and that I am a ficense vision 3 of the Business and Professions Code Section 15 of the Business and Professions Code Section 16 Divisions and Professions Code Section 17 Office Business and Professions Code Section 18 Office Business and Professions Code Section 19 Office Business Individual	serts of Sections 110, 119, 150–13 (03a). The Installation central (03a). Printed in full in the Normsideatia usiness and Professions Code to as a civil engineer or electrical eng and Professions Code by seotio d contractor performing this work. ds to sign this document because ions 5537, 5339 and 6737.1. CATE DRAWING included) 2 of 4 are required for all submitta rittel is required only if Control Cre	2. 146, 148, & 149 of Tale 34, salas meet the requirements. I Manual.) sign this document as the politices, or Lam a scansed archita 5037.2 or 5737.3 to sign the transition of type the control of the
building has been designed to meet by 5. IX The plans & specifications meet by Part 6 (10-103e 3). If the operation is maintenance into Please of each one: (These section responsible for its preparation, and it am eligible under the document as the person responsible for its preparation, and it am eligible under the of work described as exempt pure Philocopy of described as exempt pure Philocopy Measures. If effice Mandatory Measures. If Indicate location on plant Destroacy of the person of of	the requirements corriened in applicable (the requirements of Part 6 (Sections 10-1) rmatice meet the requirements of Part 6 (10- ns of the Business and Professions Code are under the provisions of Division 3 of the Business de that I am licensed in the State of California the provisions of Division 3 of the Business like for its preparation, and that I am a license livision 3 of the Business and Professions Code Sect livision 3 of the Business and Professions Code Sect SIGNATURE Contificate of Compliance. Part 1 of 4 and Contificate of Compliance. Part 1 of 4 and Contificate of Compliance. Part 4 of 4 substitution Lighting Schedule Portable Lighting Worksheet Lighting Controls Gradit Worksheet Indoor Lighting Power Allowance	serts of Sections 110, 119, 150–13 (03a). The Installation central (03a). Printed in full in the Normsideatia usiness and Professions Code to as a civil engineer or electrical eng and Professions Code by seotio d contractor performing this work. ds to sign this document because ions 5537, 5339 and 6737.1. CATE DRAWING included) 2 of 4 are required for all submitta rittel is required only if Control Cre	2. 146, 148, & 149 of Tale 34, salas meet the requirements. I Manual.) sign this document as the politices, or Lam a scansed archita 5037.2 or 5737.3 to sign the transition of type the control of the
building has been designed to meet by 5. IX The plans & specifications meet by Pari 6 (12-103a 3). II The operation & maintenance into Please check one: (These section II hereby affirm that I am eligible magnerable for its preparation; and I affirm that I am eligible under I document as the person responsible for its preparation; and I affirm that I am eligible under II of work described as exempt pure PRINCIPAL LIGHTING DESCREEN WASE DENNIS DIAS LIGHTING MANDATORY MEASURES Y Indicate location on plant Denting Complantor Points & A LTG-1-C, Part 4 of 4 X LTG-1-C, Part 4 of 4 X LTG-2-C X LTG-3-C I LTG-3-C I LTG-3-C I LTG-3-C	the requirements contained in applicable of the requirements of Part 6 (Sections 10-1) rmatice meet the requirements of Part 6 (10- ns of the Business and Professions Code are under the provisions of Division 3 of the Business the provisions of Division 3 of the Business the provisions of Division 3 of the Business the for its preparation, and that I am a focus triston 3 of the Business and Professions Code Sectivision 3 of the Business and Professions Code Section to Business and Profession Code Section Code Section to Business and Profession Code Section Code Section Co	carts of Sections 110, 119, 150–13 (03a). **Little Installation continuous.** 103c). physical in full in the Normacideatia usiness and Professions Code to as a civil engineer or electrical engineer or electrical engineer or electrical engineer of the sign shis document becomes inches 5537, 5538 and 6737.1. **DRAWING** DRAWING** DRAWING** Included:) 2 of 4 are required for all submitts of tall is required when lighting continuous.**	2. 146, 148, & 149 of Talic 34, salas most the requirements. I Manual.) sign this document as the perimens or I am a scansed ordin to 5037.2 or 5757.3 to sign the treatment or type. LC. 8 EO.21
building him been designed to meet by 5. IX The plans & specifications meet by 7-rife (10-103a 3). C) The operation & maintenance into Phases of each one: (These section I hereby affirm that I am eligible magneration; and document as the person responsible for its preparation; and document as the person responsible under I document as the person responsible under DI affirm that I am eligible unde	In the requirements corriened in applicable of the requirements of Part 6 (Sections 10-1) creation meet the requirements of Part 6 (10-ns of the Suchress and Professions Code are under the provisions of Division 3 of the Business and Professions of California the provisions of Division 3 of the Business and Professions Code Sectivision 3 of the Business and Professions Code Sectivision 3 of the Business and Professions Code Section to Business and Professions Code Section 1 of Mode Black for Mandatory Measurement to Business and Professions Code Section Carlifosia of Compliance. Part 1 of 4 and Certificate of Compliance. Part 1 of 4 automatical Engintees (Pomerical Credit Worksheet) Indoor Lighting Schedule Portable Lighting Power Allowance Tallored Method Worksheet Foom Cavity Ratio Worksheet Foom Cavity Ratio Worksheet	carts of Sections 115, 119, 150–13 (03a). C. The Installation continuous. (03a). C. The Installation Code to a continuous. (03a). C. The Installation Code to sign shis document becomes ions 5537, 5538 and 6737.1. (03a). C. The Installation Code to sign shis document becomes ions 5537, 5538 and 6737.1. (03a). C. The Installation Code to sign ship of continuous. (03a). C. The Installation Code to sign ship of code to sign ship in	2. 146, 148, & 149 of Talk 34, mice most fine regularization as the period of the peri

CANADA COLLEGE M					************************
MSTALLED INDOOR LIGHTS					
					HGTALLED
		installed licht	TING, CONDITIONED SPACES ()	From LTG-241	5422
			PORTABLE LIGHTING (4.	÷ 0
			EDIT, CONDITIONED SPACES (F	. *	
		CONDITIONED SPAC	E ADJUSTED INSTALLED LIGH	TING POWER	= 5422
•		Watalled Lighting	3, UNCOMDITIONED SPACES (F	2mm (.716-245)	640
	. \$		T, LANGONDITHOMED SPACES (F		
a n a second dimensi na romanika secilika di kumba cambia k	ر من الله الله الله الله الله الله الله الل		E ACQUETED INSTALLED LIGH	I I WAS POWER	640
altowed indoow tyghtim		mmen enward			
COMPLETE BUILDING MI	ETHOD (from LTG-5-C)				
Z area category methi	DD (mom LTG-5-C)				ALLOWED
TAILORED METHOD (from	n LTG-8-C)				WATTS Procession
LIERNATE COMPLIANCE			ALLOWED LIGH	TB83 POWER	6677.1
2					
I performance method)				
COMMON LIGHTING SYS	7		. Note that the second section of the section of th	the state of the section of the sect	
LLOWED WOOOR UGHTSVG	POWER FOR UNCOND	TIONED SPACES (From LI	Control of the second of the s		Notes
ampatory lighting mea	LEURES FOR INDOOR L	eshting and daylit are			T-SELECTION PROPERTY SECURITY CONTRACTOR AND A
AANDATORY INDOOR AND I	DAYLIGHTING AUTOKA	- Proposition and the American and the Secretary and American account of the Secretary accoun			
CORTROLLOCATION		CONTROL TYPE (Auto Time Gallots,	STACE CONTROLLED	V Control is	NOTE TO
(Ploom F. Area F. Sr Description l	CONTROL IDENTIFICATION	Dimmins). Photosonsor, ctc.)	Lists the location of controlled lights	for Daylighting	• University
IDIVIDUAL ROOMS	OS International international international international international international international international	OCCUPANCY SENSOR	ALL INDIVIDUAL ROOMS		
	formstage dated farmstage of the state of the state and the state of the state of the state of the state of the		en en jan ja kindenn tende alla lilla omfore e jären vuon et kada sattam tämbeten tembennet estitennete vuosem		
edinasti esti, ati kasa tulan dasat tilandiran etilangia tulangia nyangian periodi gerada pengangi	ert von Train Verlagen Hillerin von Sterne Verlagen von Sterne von Hillerin von Sterne von Hillerin von der St		and the second s		
					para alectronical and a constraint
\$1.56mg call of \$16.00 to the transfer that the	antiquation of granted and interpretability for the state of the state		the Park and America of Colonia action and America Researce and discount actions and attended the Park action and actions are actions as a second action and actions are actions as a second action action as a second action action as a second action		
and engineering the description that the latest the second principle representatives the trapped in	ann go reighn tha air tha ghlinnig tha bhailt air tha tha ann air tha tha an airt air air airt an airt ann air				
·····································	enne et en	and the state of t	Egi Alle (S. S. S		S. Say of the control
		PHANCE			100000 2008
2005 Nonresidential Con		PLIANCE	(Part 4 of		
CERTIFICAT CANADA COLLEGE MO	E OF COM			(4) L	
CERTIFICAT CANADA COLLEGE MO Designer:	E OF COM	BUILDING 16, 17, 18	RENOVATION	F 4) L 1	TO-1-C
CERTIFICAT PROJECT NAME CANADA COLLEGE MO Designer: This form is to be used by the designer is required to che	E OF COM DERNIZATION — E	BUILDING 16, 17, 18 The plane. Listed to option the plane.	RENOVATION Slow are all the accepturice to add as all equipment that requi	F 4) L. T	C-1-C
CERTIFICAT CANADA COLLEGE MO Designer: This form is to be used by the designer is required to che equipment of a certain type and number designates the	E OF COM DDERNIZATION — B the designer and attach ck the boxes by all and a requires a test, list the Section in the Appendi	BUILDING 16, 17, 18 Hed to the plane. Listed to eptance tests that apply a requipment description are a of the Monresidenties AC	RENOVATION Sow are all the acceptance tend that requirement that requirement that required the number of systems to both Manual that describes the	F4) L [*] Sta for lighting to an acceptant to tested in particular to the stad in particular to st. Also indi	Systems. The tree test. If all entheads. The calculus this
CERTIFICAT PROJECT AME CANADA COLLEGE MO Designer: This form is to be used by the designer is required to che equipment of a certain type in a number designates the person responsible for part Since this form will be part	E OF COM DERNIZATION — E the designer and attact ck the boxes by all acc e requires a test, list the Section in the Appendit forming the tests (i.e. th	BUILDING 16, 17, 18 Hed to the plane. Listed be eptance tests that apply a codipment description at a of the Nonrecidenties AL to installing contractor, de-	RENOVATION Show are all the acceptance to district all equipment that required the number of systems to be	Ed) L'	systems. The tree test. If all enthreads. The cate this tree toward.
CERTIFICAT PROJECT AME CANADA COLLEGE MO Designer: This form is to be used by the designer is required to che aquicoment of a certain type (A) number designates the person responsible for part spreopriately.	EOF COM DERNIZATION — B the designer and attach ck the boxes by all acce a requires a test, list the Section in the Appandi coming the tests (i.e. the of the plans, completion	BUILDING 16, 17, 18 Hed to the plane. Listed be eptance tests that apply a codipment description at a of the Nonrecidenties AL to installing contractor, de-	RENOVATION Slow are all the acceptance to not like the comparent that required the number of systems to both Manual that describes the sign professional or an agent.	Ed) L'	systems. The tree test. If all enthreads. The cate this tree toward.
CERTIFICAT PROJECT NAME CANADA COLLEGE MO Designer: This form is to be used by the designer is required to che acustoment of a certain type in a certain type in a certain type in a certain type in a certain the part appropriately. Building Depa Systems Acceptance, Bar	DERNIZATION — Be the designer and attack the boxes by all and a requires a test, list the Section in the Appenditioning the leads (i.e. the of the plans, completion in the plans are th	BUILDING 16, 17, 18 red to the plane. Listed is eptance tests that apply a codemic for the Norresidential AC to installing contractor, denote this section will allow till is granted for a newly contract.	RENOVATION Show are sliftly acceptance to an dist all equipment that required the number of systems to be the manual trait describes the sign professional or an agent the responsible party to budge the responsible party the responsible party to budge the responsible party to bu	Sta for lightling are an acceptance tested in partected by the story the sto	systems. The toe test. If all entheads. The cate the country. If all entheads are the country.
CERTIFICAT PROJECT NAME CANADA COLLEGE MO Designer: This form is to be used by the designer is required to che aquipment of a certain type in a certain ty	DERNIZATION — Be the designer and attact ck the boxes by all and a requires a test, list the Section in the Appenditioning the leats (i.e. the of the plans, completion in the plans are	BUILDING 16, 17, 18 red to the plane. Listed be eptance tests that apply a contraction at a cittle blance tests that apply a cittle blanceidenties AC to installing contractor, do not this section will show this section will show the prometure, all control de normal use, all control de	RENOVATION Slow are all the acceptance tered last all equipment that required the number of systems to build the number of systems to build the number of systems to build the responsible party to budge	Sta for lightling to an acceptance start the scope or a new specipace shall be	systems. The noe lest. If all entheases. The cate the course), a of work
CERTIFICAT PROJECT NAME CANADA COLLEGE MO Designer: This form is to be used by to designer is required to cho equipment of a certain type person responsible for part since this form will be part appropriately. Building Depa Systems Acceptance. Be system serving a building de submitted to the building de	DOERNIZATION — Be the designer and attact ck the boxes by all and a requires a test, list the Section in the Appenditioning the tests (i.e. the of the plans, completion in the plans of the plans	BUILDING 16, 17, 18 red to the plane. Listed be eptance tests that apply a requirement description at a of the Norresidential AC installing contractor, demonstrate section will show this section will show the promesuse, all control de compliance, in addition a	RENOVATION Slow are all the acceptance tend fat all equipment that required the number of systems to build the number of systems to build manual that describes the sign professional or an agent the responsible party to budge the responsible party to budge constructed building or space, reces serving the building or a Certificate of Acceptance, ME	Sta for lighting to an acceptance shall be scope or a new specipace shall be SCH-1-A, Form	systems. The noe test. If all entheads. If all entheads of work occurrently and the sahall be
CERTIFICAT PROJECT NAME CANADA COLLEGE MO Designer: This form is to be used by to designer is required to cho equipment of a certain type person responsible for part since this form will be part appropriately. Building Depa Systems Acceptance. Be system serving a building de submitted to the building de	DDERNIZATION — Be the designer and attact ck the boxes by all acces requires a test, liet the Section in the Appenditioning the tests (i.e. the of the plans, completion of the plans, completion of the plans, completion of the plans are completed for a space is operated for equirements for Code (spartment that:	BUILDING 16, 17, 18 red to the plane. Listed be eptance tests that apply a requirement description at a of the Norresidential AC installing contractor, demonstrate section will show this section will show the promesuse, all control de compliance, in addition a	RENOVATION Slow are all the acceptance tend last all equipment that required the number of systems to build the number of systems to build the number of systems to build the professional or an agent of a responsible party to budge what responsible party to budge what responsible party to budge what responsible party to budge whether the professional or space.	Sta for lighting to an acceptance shall be scope or a new specipace shall be SCH-1-A, Form	systems. The noe test. If all entheads. The control entheads of work occurrence occurrence and the sentitle of sentitle of sentitle occurrence
CERTIFICAT CANADA COLLEGE MO Designer: This form is to be used by the designer is required to che aquipment of a certain type has number designates the parson responsible for part appropriately. Building Depa Systems Acceptance for systems Acceptance for subtring the Acceptance for submitted to the building default of the building defau	DDERNIZATION — Be the designer and attact ck the boxes by all acces requires a test, liet the Section in the Appenditioning the tests (i.e. the of the plans, completion of the plans, completion of the plans, completion of the plans are completed for a space is operated for equirements for Code (spartment that:	BUILDING 16, 17, 18 red to the plane. Listed be eptance tests that apply a requirement description at a of the Norresidential AC installing contractor, demonstrate section will show this section will show the promesuse, all control de compliance, in addition a	RENOVATION Slow are all the acceptance tend fat all equipment that required the number of systems to build the number of systems to build manual that describes the sign professional or an agent the responsible party to budge the responsible party to budge constructed building or space, reces serving the building or a Certificate of Acceptance, ME	sta for lighting to an acceptant test. Also indicated by the story the story of the	eyslems. The roe lest, if all extrees. The cate the council council continues of the council con
CERTIFICAT PROJECT NAME CANADA COLLEGE MO Designer: This form is to be used by the designer is required to che equipment of a certain type of the person responsible for part Since this form will be part appropriately. Building Depa Systems Acceptance. Besystem serving a building of meeting the Acceptance Resultmitted to the building department of the building departm	EOF COM DERNIZATION — E the designer and attact ck the boxes by all acc e requires a test, list the Section in the Appendi forming the tests (i.e. th of the plans, completio riments: fore an occupancy per- in space is operated for equirements for Code (apparaments that: sectifications, installation tile 24 Fact 6.	BUILDING 16, 17, 18 Hed to the plane. Listed by eptance tests that apply a configurant description at a of the Norresidentie. As the Norresidenties As the installing confractor, denote this section will allow this section will allow the properties. In addition a certificates, and operating certificates, and operating	RENOVATION Slow are all the acceptance tend fat all equipment that required the number of systems to build the number of systems to build manual that describes the sign professional or an agent the responsible party to budge the responsible party to budge constructed building or space, reces serving the building or a Certificate of Acceptance, ME	sta for lighting to an acceptant test. Also indicated by the story the story of the	eystems. The roe test. If all extrees. The cate the cover). It is all work.
CERTIFICAT TOULD TAME CANADA COLLEGE MO Designer: This form is to be used by the equipment of a certain type in particular to the equipment of a certain type in particular period from will be part appropriately. Building Depa Systems Acceptance. Because the form serving a building of meeting the Acceptance Resubmitted to the building department of the building dep	DOERNIZATION — Ethe designer and attact ck the boxes by all and the requires a test, liet the Section in the Appoint the of the plans, complette interests for Gode (epistement that recifications, installation ties 24 Fact 6. Control Acceptance sor Acceptance	BUILDING 16, 17, 18 and to the plane. Listed be eptance tests that apoly a equipment description at a ci the Horresidential AL in installing contractor, due not this section will silow the installing contractor will silow the prometuse, all control de Complance, in addition a certificates, and operating certificates, and operating Control de Complance.	RENOVATION Slow are all the acceptance tend fat all equipment that required the number of systems to build the number of systems to build manual that describes the sign professional or an agent the responsible party to budge the responsible party to budge constructed building or space, reces serving the building or a Certificate of Acceptance, ME	sta for lighting to an acceptance test. Also indicated by the strong or a new specipace shall be CH-1-A. Form meet the rec	eystems. The roce test. If all entheress. The cate the cover). It of work to conditioning certified as a shall be cuirements of enformed By
CERTIFICAT CANADA COLLEGE MC Designer: This form is to be used by the designer is required to che aquipreed to fix designates the person responsible for performable form will be performed by the person responsible for performable form will be performed by the form of the pulliding of the form of the building of the form of the form of the building of the form of t	EOF COM DERNIZATION — B the designer and attact ck the boxes by all acces a requires a test, list the Section in the Appendi forming the tests (i.e. the of the plane, completion riments: fore an occupancy per- or space is operated for equirements for Gode (equirement that; sectifications, installation (ite 24 Fart 6.) Control Acceptance sor Acceptance t Controls Acceptance Switch Control Acceptance	BUILDING 16, 17, 18 red to the plane. Listed to eptance tests that apply a equipment description at a of the Norresidential Africa installing contractor, denoting for a newly of this section will allow mit is granted for a newly of normal use, all control de Compilance, in addition a certificates, and operating certificates, and operating the ptance	RENOVATION Sow are all the acceptance tered list all equipment that required the number of systems to be the manual trait describes the sign professional or an agent the responsible party to budge the continue of the continue	sta for lighting to an acceptance test. Also indicated by the strong or a new specipace shall be CH-1-A. Form meet the rec	eyelems. The toe test. If all extremes the country, a of work conditioning certified as a shall be unicements of correct by
CERTIFICAT REDECT NAME CANADA COLLEGE MO Designer: This form is to be used by the designer is required to che aquaprised to fa certain type NJ number designates the person responsible for performable form will be performed by the submitted by the building of the Acceptance Resident serving a building of the building distributed to th	DERNIZATION — Be the designer and attact ck the boxes by all and a requires a test, list the Section in the Appenditioning the tests (i.e. the of the plans, completion of the plans of the plans, completion of the plans of the plans, installation tile 24 Fart 6. The control of the plans of the plan	BUILDING 16, 17, 18 red to the plane. Listed to eptance tests that apply a equipment description at a of the Norresidential Africa installing contractor, denoting for a newly of this section will allow mit is granted for a newly of normal use, all control de Compilance, in addition a certificates, and operating certificates, and operating the ptance	RENOVATION Sow are all the acceptance tered list all equipment that required the number of systems to be the manual trait describes the sign professional or an agent the responsible party to budge the continue of the continue	sta for lighting to an acceptance test. Also indicated by the strong or a new specipace shall be CH-1-A. Form meet the rec	aystems. The roe test. If all entheses, if all entheses, if all entheses of work. c-conditioning certified as a shall be unirements of entheses.
CERTIFICAT CANADA COLLEGE MC Designer: This form is to be used by the designer is required to che aquipreed to fix designates the person responsible for performable form will be performed by the person responsible for performable form will be performed by the form of the pulliding of the form of the building of the form of the form of the building of the form of t	DERNIZATION — Be the designer and attact ck the boxes by all and a requires a test, list the Section in the Appenditioning the tests (i.e. the of the plans, completion of the plans of the plans, completion of the plans of the plans, installation tile 24 Fart 6. The control of the plans of the plan	BUILDING 16, 17, 18 and to the plane. Listed be eplance tests that apply a requirement description at a of the Norresidential AC is installing contractor, demonstrated for a newly of normal use, all control de Compliance, in addition a certificates, and operating Document Document e ptance 6.2 OCCUPANCY SENS	RENOVATION Sow are all the acceptance tered list all equipment that required the number of systems to be the manual trait describes the sign professional or an agent the responsible party to budge the continue of the continue	sta for lighting to an acceptance test. Also indicated by the strong or a new specipace shall be CH-1-A. Form meet the rec	aystems. The roe test. If all entheses, if all entheses, if all entheses of work. c-conditioning certified as a shall be unirements of entheses.
CERTIFICAT **ROJECT NAME CANADA COLLEGE MO Designer: This form is to be used by the aquipment of a certain type of the properties of the publishing of the Acceptance Resident of the building of the Acceptance Resident of the Buil	E OF CONI DDERNIZATION — E the designer and attach ck the boxes by all and ck the boxes at lest, let the Section in the Appoint. It of the plans, complettle intiments: fore an occupancy per- in space is operated for equivements for Code (epartment that: ledifications, installation ite 24 Fact 6. Control Acceptance is Controls Acceptance sor Acceptance is Controls Acceptance sor Acceptance sor Acceptance sor Acceptance control Acceptance sor Acceptance	BUILDING 16, 17, 18 and to the plane. Listed be eptance tests that apoly a equipment description at a of the Horresidential AL installing contractor, denor this section will allow mit is granted for a newly a normal use, all control de Compliance, in addition a certificates, and operating certificates, and operating plance 6.2 OCCUPANCY SENS, INDIVIDUAL ROOMS	RENOVATION Stow are stillne acceptance to and sat all equipment that required the number of systems to be the manual that describes the sign professional or an agent the responsible party to budge constructed building or space, wices serving the building or a Certificate of Acceptance, ME g and maintenance information.	sta for lighting to an acceptance test. Also indicated by the strong or a new specipace shall be CH-1-A. Form meet the rec	aystems. The roe test. If all entheses, if all entheses, if all entheses of work. c-conditioning certified as a shall be unirements of entheses.
CERTIFICAT REDECT NAME CANADA COLLEGE MC Designer: This form is to be used by it designer is required to che aquipment of a certain type of the person responsible for performable form will be performed by the person responsible for performable form will be performed by the person acceptance. Bet a petern serving a building of meeting the Acceptance Resultmitted to the building description A. Certifical plans, ap § 10-103(a) and Till Test Description VILTG-2-A: Lighting and Development Person acceptance Serving a building of the building description. Test Description A. Certifical plans, ap § 10-103(a) and Till Test Description Focupancy Serving a building of the building of the building description. Test Description Cocupancy Serving a building of the building description and the building description. Test Description Focupancy Serving a building of the building description and the building description.	E OF COM DERNIZATION — B the designer and attack ck the boxes by all acce e requires a test, list the Section in the Appendi forming the tests (i.e. the of the plane, completion rimerits: fore an occupancy person space is operated for egarements for Gode (epartment that; recifications, installation (i.e. ZA Fart 6.) Control Acceptance sor Acceptance t Controls Acceptance sor Acceptance t Controls Acceptance sor Acceptance t Controls Acceptance t Controls Acceptance septance testing NJ. ALL is Daylighting Control	RUILDING 16, 17, 18 red to the plane. Listed by eptance tests that apoly a requipment description at a of the Norresidentie. At the Norresidenties At the installing contractor, denot this section will allow milt is granted for a newly of normal use, all control de Compliance, in addition a certificates, and operating the plance. Document Document e plance 6.2 OCCUPANCY SENS INDIVIDUAL ROOMS	RENOVATION Sow are all the acceptance tend list all equipment that required the number of systems to build the number of systems to build the number of systems to build the responsible party to build the responsible	sta for lighting to an acceptance test. Also indicated by the strong or a new specipace shall be CH-1-A. Form meet the rec	eystems. The roce test. If all entheress. The cate the cover). It of work to conditioning certified as a shall be cuirements of enformed By
CERTIFICAT REDECT NAME CANADA COLLEGE MC Designer: This form is to be used by it designer is required to che aquipment of a certain type of the person responsible for performable form will be performed by the person responsible for performable form will be performed by the person acceptance. Bet a petern serving a building of meeting the Acceptance Resultmitted to the building description A. Certifical plans, ap § 10-103(a) and Till Test Description VILTG-2-A: Lighting and Development Person acceptance Serving a building of the building description. Test Description A. Certifical plans, ap § 10-103(a) and Till Test Description Focupancy Serving a building of the building of the building description. Test Description Cocupancy Serving a building of the building description and the building description. Test Description Focupancy Serving a building of the building description and the building description.	E OF COM DERNIZATION — B the designer and attack ck the boxes by all acce e requires a test, list the Section in the Appendi forming the tests (i.e. the of the plane, completion rimerits: fore an occupancy person space is operated for egarements for Gode (epartment that; recifications, installation (i.e. ZA Fart 6.) Control Acceptance sor Acceptance t Controls Acceptance sor Acceptance t Controls Acceptance sor Acceptance t Controls Acceptance t Controls Acceptance septance testing NJ. ALL is Daylighting Control	RUILDING 16, 17, 18 red to the plane. Listed by eptance tests that apoly a requipment description at a of the Norresidentie. At the Norresidenties At the installing contractor, denot this section will allow milt is granted for a newly of normal use, all control de Compliance, in addition a certificates, and operating the plance. Document Document e plance 6.2 OCCUPANCY SENS INDIVIDUAL ROOMS	RENOVATION Sow are all the acceptance tend list all equipment that required the number of systems to build the number of systems to build the number of systems to build the responsible party to build the responsible	sta for lighting to an acceptance test. Also indicated by the strong or a new specipace shall be CH-1-A. Form meet the rec	eystems. The roce test. If all entheress. The cate the cover). It of work to conditioning certified as a shall be cuirements of enformed By
CERTIFICAT CANADA COLLEGE MC Designer: This form is to be used by the designer is required to che aquipment of a certain type of the person responsible for performable form will be performablely. Building Depa Systems Acceptance. Be systems Acceptance. Be system earning a building of meeting the Acceptance Russimpled to the building design for the building desi	E OF COM DERNIZATION — B the designer and attack ck the boxes by all acce e requires a test, list the Section in the Appendi forming the tests (i.e. the of the plane, completion rimerits: fore an occupancy person space is operated for egarements for Gode (epartment that; recifications, installation (i.e. ZA Fart 6.) Control Acceptance sor Acceptance t Controls Acceptance sor Acceptance t Controls Acceptance sor Acceptance t Controls Acceptance t Controls Acceptance septance testing NJ. ALL is Daylighting Control	RUILDING 16, 17, 18 red to the plane. Listed by eptance tests that apoly a requipment description at a of the Norresidentie. At the Norresidenties At the installing contractor, denot this section will allow milt is granted for a newly of normal use, all control de Compliance, in addition a certificates, and operating the plance. Document Document e plance 6.2 OCCUPANCY SENS INDIVIDUAL ROOMS	RENOVATION Sow are all the acceptance tend list all equipment that required the number of systems to build the number of systems to build the number of systems to build the responsible party to build the responsible	sta for lighting to an acceptance test. Also indicated by the strong or a new specipace shall be CH-1-A. Form meet the rec	eystems. The roce test. If all entheress. The cate the cover). It of work to conditioning certified as a shall be cuirements of enformed By
CERTIFICAT REDECT NAME CANADA COLLEGE MC Designer: This form is to be used by it designer is required to che aquipment of a certain type of the person responsible for performable form will be performed by the person responsible for performable form will be performed by the person acceptance. Bet a petern serving a building of meeting the Acceptance Resultmitted to the building description A. Certifical plans, ap § 10-103(a) and Till Test Description VILTG-2-A: Lighting and Development Person acceptance Serving a building of the building description. Test Description A. Certifical plans, ap § 10-103(a) and Till Test Description Focupancy Serving a building of the building of the building description. Test Description Cocupancy Serving a building of the building description and the building description. Test Description Focupancy Serving a building of the building description and the building description.	E OF COM DERNIZATION — B the designer and attack ck the boxes by all acce e requires a test, list the Section in the Appendi forming the tests (i.e. the of the plane, completion rimerits: fore an occupancy person space is operated for egarements for Gode (epartment that; recifications, installation (i.e. ZA Fart 6.) Control Acceptance sor Acceptance t Controls Acceptance sor Acceptance t Controls Acceptance sor Acceptance t Controls Acceptance t Controls Acceptance septance testing NJ. ALL is Daylighting Control	RUILDING 16, 17, 18 red to the plane. Listed by eptance tests that apoly a requipment description at a of the Norresidentie. At the Norresidenties At the installing contractor, denot this section will allow milt is granted for a newly of normal use, all control de Compliance, in addition a certificates, and operating the plance. Document Document e plance 6.2 OCCUPANCY SENS INDIVIDUAL ROOMS	RENOVATION Sow are all the acceptance tend list all equipment that required the number of systems to build the number of systems to build the number of systems to build the responsible party to build the responsible	sta for lighting to an acceptance test. Also indicated by the strong or a new specipace shall be CH-1-A. Form meet the rec	eystems. The roce test. If all entheress. The cate the cover). It of work to conditioning certified as a shall be cuirements of enformed By
CERTIFICAT REDECT NAME CANADA COLLEGE MC Designer: This form is to be used by it designer is required to che aquipment of a certain type of the person responsible for performable form will be performed by the person responsible for performable form will be performed by the person acceptance. Bet a petern serving a building of meeting the Acceptance Resultmitted to the building description A. Certifical plans, ap § 10-103(a) and Till Test Description VILTG-2-A: Lighting and Development Person acceptance Serving a building of the building description. Test Description A. Certifical plans, ap § 10-103(a) and Till Test Description Focupancy Serving a building of the building of the building description. Test Description Cocupancy Serving a building of the building description and the building description. Test Description Focupancy Serving a building of the building description and the building description.	E OF COM DERNIZATION — B the designer and attack ck the boxes by all acce e requires a test, list the Section in the Appendi forming the tests (i.e. the of the plane, completion rimerits: fore an occupancy person space is operated for egarements for Gode (epartment that; recifications, installation (i.e. ZA Fart 6.) Control Acceptance sor Acceptance t Controls Acceptance sor Acceptance t Controls Acceptance sor Acceptance t Controls Acceptance t Controls Acceptance septance testing NJ. ALL is Daylighting Control	RUILDING 16, 17, 18 red to the plane. Listed by eptance tests that apoly a requipment description at a of the Norresidentie. At the Norresidenties At the installing contractor, denot this section will allow milt is granted for a newly of normal use, all control de Compliance, in addition a certificates, and operating the plance. Document Document e plance 6.2 OCCUPANCY SENS INDIVIDUAL ROOMS	RENOVATION Sow are all the acceptance tend list all equipment that required the number of systems to build the number of systems to build the number of systems to build the responsible party to build the responsible	sta for lighting to an acceptance test. Also indicated by the strong or a new specipace shall be CH-1-A. Form meet the rec	eystems. The roce test. If all entheress. The cate the cover). It of work to conditioning certified as a shall be cuirements of enformed By
CERTIFICAT CANADA COLLEGE MC Designer: This form is to be used by the designer is required to che aquipment of a certain type of the person responsible for performable form will be performablely. Building Depa Systems Acceptance. Be systems Acceptance. Be system earning a building of meeting the Acceptance Russimpled to the building design for the building desi	E OF COM DERNIZATION — B the designer and attack ck the boxes by all acce e requires a test, list the Section in the Appendi forming the tests (i.e. the of the plane, completion rimerits: fore an occupancy person space is operated for egarements for Gode (epartment that; recifications, installation (i.e. ZA Fart 6.) Control Acceptance sor Acceptance t Controls Acceptance sor Acceptance t Controls Acceptance sor Acceptance t Controls Acceptance t Controls Acceptance septance testing NJ. ALL is Daylighting Control	RUILDING 16, 17, 18 red to the plane. Listed by eptance tests that apoly a requipment description at a of the Norresidentie. At the Norresidenties At the installing contractor, denot this section will allow milt is granted for a newly of normal use, all control de Compliance, in addition a certificates, and operating the plance. Document Document e plance 6.2 OCCUPANCY SENS INDIVIDUAL ROOMS	RENOVATION Sow are all the acceptance tend list all equipment that required the number of systems to build the number of systems to build the number of systems to build the responsible party to build the responsible	sta for lighting to an acceptance test. Also indicated by the strong or a new specipace shall be CH-1-A. Form meet the rec	eystems. The roce test. If all entheress. The cate the cover). It of work to conditioning certified as a shall be cuirements of enformed By
CERTIFICAT CANADA COLLEGE MO Designer: This form is to be used by the designer is required to che equopment of a certain type of the person responsible for part specially. Building Department form will be part appropriately. Building Department Acceptance. Be system serving a bailding of the building of the buil	E OF COM DERNIZATION — B the designer and attack ck the boxes by all acce e requires a test, list the Section in the Appendi forming the tests (i.e. the of the plane, completion rimerits: fore an occupancy person space is operated for egarements for Gode (epartment that; recifications, installation (i.e. ZA Fart 6.) Control Acceptance sor Acceptance t Controls Acceptance sor Acceptance t Controls Acceptance sor Acceptance t Controls Acceptance t Controls Acceptance septance testing NJ. ALL is Daylighting Control	RUILDING 16, 17, 18 red to the plane. Listed by eptance tests that apoly a requipment description at a of the Norresidentie. At the Norresidenties At the installing contractor, denot this section will allow milt is granted for a newly of normal use, all control de Compliance, in addition a certificates, and operating the plance. Document Document e plance 6.2 OCCUPANCY SENS INDIVIDUAL ROOMS	RENOVATION Sow are all the acceptance tend list all equipment that required the number of systems to build the number of systems to build the number of systems to build the responsible party to build the responsible	sta for lighting to an acceptance test. Also indicated by the strong or a new specipace shall be CH-1-A. Form meet the rec	eystems. The roce test. If all entheress. The cate the cover). It of work to conditioning certified as a shall be cuirements of enformed By
CERTIFICAT CANADA COLLEGE MC Designer: This form is to be used by the designer is required to che aquipment of a certain type of the person responsible for performable form will be performablely. Building Depa Systems Acceptance. Be systems Acceptance. Be system earning a building of meeting the Acceptance Russimpled to the building design for the building desi	E OF COM DERNIZATION — B the designer and attack ck the boxes by all acce e requires a test, list the Section in the Appendi forming the tests (i.e. the of the plane, completion rimerits: fore an occupancy person space is operated for egarements for Gode (epartment that; recifications, installation (i.e. ZA Fart 6.) Control Acceptance sor Acceptance t Controls Acceptance sor Acceptance t Controls Acceptance sor Acceptance t Controls Acceptance t Controls Acceptance septance testing NJ. ALL is Daylighting Control	RUILDING 16, 17, 18 red to the plane. Listed by eptance tests that apoly a requipment description at a of the Norresidentie. At the Norresidenties At the installing contractor, denot this section will allow milt is granted for a newly of normal use, all control de Compliance, in addition a certificates, and operating the plance. Document Document e plance 6.2 OCCUPANCY SENS INDIVIDUAL ROOMS	RENOVATION Sow are all the acceptance tend list all equipment that required the number of systems to build the number of systems to build the number of systems to build the responsible party to build the responsible	sta for lighting to an acceptance test. Also indicated by the strong or a new specipace shall be CH-1-A. Form meet the rec	eystems. The roce test. If all entheress. The cate the cover). It of work to conditioning certified as a shall be cuirements of enformed By
CERTIFICAT CANADA COLLEGE MO Designer: This form is to be used by the designer is required to che equopment of a certain type of the person responsible for part specially. Building Department form will be part appropriately. Building Department Acceptance. Be system serving a bailding of the building of the buil	E OF COM DERNIZATION — B the designer and attack ck the boxes by all acce e requires a test, list the Section in the Appendi forming the tests (i.e. the of the plane, completion rimerits: fore an occupancy person space is operated for egarements for Gode (epartment that; recifications, installation (i.e. ZA Fart 6.) Control Acceptance sor Acceptance t Controls Acceptance sor Acceptance t Controls Acceptance sor Acceptance t Controls Acceptance t Controls Acceptance septance testing NJ. ALL is Daylighting Control	RUILDING 16, 17, 18 red to the plane. Listed by eptance tests that apoly a requipment description at a of the Norresidentie. At the Norresidenties At the installing contractor, denot this section will allow milt is granted for a newly of normal use, all control de Compliance, in addition a certificates, and operating the plance. Document Document e plance 6.2 OCCUPANCY SENS INDIVIDUAL ROOMS	RENOVATION Sow are all the acceptance tend list all equipment that required the number of systems to build the number of systems to build the number of systems to build the responsible party to build the responsible	sta for lighting to an acceptance test. Also indicated by the strong or a new specipace shall be CH-1-A. Form meet the rec	eystems. The roce test. If all entheress. The cate the cover). It of work to conditioning certified as a shall be cuirements of enformed By
CERTIFICAT CANADA COLLEGE MO Designer: This form is to be used by the equipment of a certain type of the person responsible for perform will be performed by the person responsible for performed by the person responsible for performed by the performance of the form will be performed by the performance of the perfo	E OF COM DERNIZATION — B the designer and attack ck the boxes by all acce e requires a test, list the Section in the Appendi forming the tests (i.e. the of the plane, completion rimerits: fore an occupancy person space is operated for egarements for Gode (epartment that; recifications, installation (i.e. ZA Fart 6.) Control Acceptance sor Acceptance t Controls Acceptance sor Acceptance t Controls Acceptance sor Acceptance t Controls Acceptance t Controls Acceptance septance testing NJ. ALL is Daylighting Control	RUILDING 16, 17, 18 red to the plane. Listed by eptance tests that apoly a requipment description at a of the Norresidentie. At the Norresidenties At the installing contractor, denot this section will allow milt is granted for a newly of normal use, all control de Compliance, in addition a certificates, and operating the plance. Document Document e plance 6.2 OCCUPANCY SENS INDIVIDUAL ROOMS	RENOVATION Sow are all the acceptance tend list all equipment that required the number of systems to build the number of systems to build the number of systems to build the responsible party to build the responsible	sta for lighting to an acceptance test. Also indicated by the strong or a new specipace shall be CH-1-A. Form meet the rec	eystems. The roce test. If all entheress. The cate the cover). It of work to conditioning certified as a shall be cuirements of enformed By
CERTIFICAT CANADA COLLEGE MO Designer: This form is to be used by the designer is required to che equopment of a certain type of the person responsible for part specially. Building Department form will be part appropriately. Building Department Acceptance. Be system serving a bailding of the building of the buil	E OF COM DERNIZATION — B the designer and attack ck the boxes by all acce e requires a test, list the Section in the Appendi forming the tests (i.e. the of the plane, completion rimerits: fore an occupancy person space is operated for egarements for Gode (epartment that; recifications, installation (i.e. ZA Fart 6.) Control Acceptance sor Acceptance t Controls Acceptance sor Acceptance t Controls Acceptance sor Acceptance t Controls Acceptance t Controls Acceptance septance testing NJ. ALL is Daylighting Control	RUILDING 16, 17, 18 red to the plane. Listed by eptance tests that apoly a requipment description at a of the Norresidentie. At the Norresidenties At the installing contractor, denot this section will allow milt is granted for a newly of normal use, all control de Compliance, in addition a certificates, and operating the plance. Document Document e plance 6.2 OCCUPANCY SENS INDIVIDUAL ROOMS	RENOVATION Sow are all the acceptance tend list all equipment that required the number of systems to build the number of systems to build the number of systems to build the responsible party to build the responsible	sta for lighting to an acceptance test. Also indicated by the strong or a new specipace shall be CH-1-A. Form meet the rec	eystems. The roce test. If all entheress. The cate the cover). It of work to conditioning certified as a shall be cuirements of enformed By
CERTIFICAT CANADA COLLEGE MC Designer: This form is to be used by the designer is required to che aquipment of a certain type of the person responsible for performable form will be performablely. Building Depa Systems Acceptance. Be systems Acceptance. Be system earning a building of meeting the Acceptance Russimpled to the building design for the building desi	E OF COM DERNIZATION — B the designer and attack ck the boxes by all acce e requires a test, list the Section in the Appendi forming the tests (i.e. the of the plane, completion rimerits: fore an occupancy person space is operated for egarements for Gode (epartment that; recifications, installation (i.e. ZA Fart 6.) Control Acceptance sor Acceptance t Controls Acceptance sor Acceptance t Controls Acceptance sor Acceptance t Controls Acceptance t Controls Acceptance septance testing NJ. ALL is Daylighting Control	RUILDING 16, 17, 18 red to the plane. Listed by eptance tests that apoly a requipment description at a of the Norresidentie. At the Norresidenties At the installing contractor, denot this section will allow milt is granted for a newly of normal use, all control de Compliance, in addition a certificates, and operating the plance. Document Document e plance 6.2 OCCUPANCY SENS INDIVIDUAL ROOMS	RENOVATION Sow are all the acceptance tend list all equipment that required the number of systems to build the number of systems to build the number of systems to build the responsible party to build the responsible	sta for lighting to an acceptance test. Also indicated by the strong or a new specipace shall be CH-1-A. Form meet the rec	eystems. The roce test. If all entheress. The cate the cover). It of work to conditioning certified as a shall be cuirements of enformed By
CERTIFICAT CANADA COLLEGE MC Designer: This form is to be used by the designer is required to che aquipment of a certain type of the person responsible for performable form will be performablely. Building Depa Systems Acceptance. Be systems Acceptance. Be system earning a building of meeting the Acceptance Russimpled to the building design for the building desi	E OF COM DERNIZATION — B the designer and attack ck the boxes by all acce e requires a test, list the Section in the Appendi forming the tests (i.e. the of the plane, completion rimerits: fore an occupancy person space is operated for egarements for Gode (epartment that; recifications, installation (i.e. ZA Fart 6.) Control Acceptance sor Acceptance t Controls Acceptance sor Acceptance t Controls Acceptance sor Acceptance t Controls Acceptance t Controls Acceptance septance testing NJ. ALL is Daylighting Control	RUILDING 16, 17, 18 red to the plane. Listed by eptance tests that apoly a requipment description at a of the Norresidentie. At the Norresidenties At the installing contractor, denot this section will allow milt is granted for a newly of normal use, all control de Compliance, in addition a certificates, and operating the plance. Document Document e plance 6.2 OCCUPANCY SENS INDIVIDUAL ROOMS	RENOVATION Sow are all the acceptance tend list all equipment that required the number of systems to build the number of systems to build the number of systems to build the responsible party to build the responsible	sta for lighting to an acceptance test. Also indicated by the strong or a new specipace shall be CH-1-A. Form meet the rec	eystems. The roce test. If all entheress. The cate the cover). It of work to conditioning certified as a shall be cuirements of enformed By

MANDATORY MEASURES

		WANDATORT WEASURES
N/	A 🗆	BUILDING LIGHTING SHUT-OFF THE BUILDING LIGHTING SHUT-OFF SYSTEM CONSISTS OF AN AUTOMATIC TIME SWITCH, WITH A ZONE FOR EACH FLOOR; OR THE BUILDING IS SEPARATELY METERED AND EXEMPT FROM THE SHUT-OFF REQUIREMENT.
N/	A 🗆	OVERRIDE FOR BUILDING LIGHTING SHUT-OFF THE AUTOMATIC BUILDING SHUT-OFF SYSTEM IS PROVIDED WITH A MANUAL, ACCESSIBLE OVERRIDE SWITCH IN SIGHT OF THE LIGHTS. THE AREA OF OVERRIDE NOT TO EXCEED 5,000 SF.
		AUTOMATIC CONTROL DEVICES CERTIFIED ALL AUTOMATIC CONTROL DEVICES SPECIFIED ARE CERTIFIED; ALL ALTERNATE EQUIPMENT SHALL BE CERTIFIED AND INSTALLED AS DIRECTED BY THE MANUFACTURER.
		CERTIFIED BALLAST AND LUMINARIES ALL FLUORESCENT FIXTURES SUBJECT TO CERTIFICATION AND SPECIFIED FOR THE PROJECT ARE CERTIFIED.
		INDIVIDUAL ROOM/AREA CONTROLS EACH ROOM AND AREA IN THIS BUILDING IS EQUIPPED WITH A SEPARATE SWITCH OR OCCUPANCY SENSOR DEVICE FOR EACH AREA WITH FLOOR-TO-CEILING WALLS.
	K2	LINIEODA DEDUCTION FOR INDIVIDUAL DOCAGO

UNIFORM REDUCTION FOR INDIVIDUAL ROOMS ALL ROOMS AND AREAS GREATER THAN 100 SQUARE FEET AND MORE THAN 0.8 WATTS PER SQUARE FOOT OF LIGHTING LOAD SHALL BE CONTROLLED WITH MULTI-LEVEL SWITCHING

OF THE LAMPS IN EACH DAYLIT AREA CONTROLLED BY A

DAYLIT AREA CONTROL ALL ROOMS THAT ARE GREATER THAN 250 SQUARE FEET AND CONTAIN WINDOWS AND SKYLIGHTS, THAT ALLOW FOR THE EFFECTIVE USE OF DAYLIGHT IN THE AREA SHALL HAVE 50%

SEPARATE SWITCH.

FOR UNIFORM REDUCTION OF LIGHTING WITHIN THE ROOM.

CAÑADA COLLEGE

BUILDING 16, 17, 18 RENOVATION

SMCCCD 3401 CSM Drive San Mateo, CA 94402 Cañada College 4200 FarmHills Blvd. Redwood City, CA 94061

SHEET TITLE


ELECTRICAL TITLE 24 — SHEET 1 OF 2 BUILDING 17

A REVISIONS NO. DATE DESCRIPTION

PROJECT RECORD DOCUMENT BID: 86519 DATED 2-7-07

PREPARED BY:

ELECTRICAL CONTRACTOR • LICENSE #399195 1052 Commercial Street, San Carlos, Ca. 94070 Bus: (650) 595-1091 • Fax: (650) 595-5489

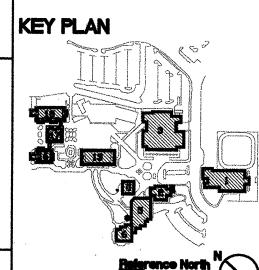

DATE DRAWN K. SCHWARTZ CHECKED D. DIAS SCALE NONE N&T JOB NO.: SHEET NUMBER

E0.21