


DUCT PENETRATION DETAIL

NO SCALE

2
M5.03

NOTES:


1. ALL BLOCKING AROUND ROOF OPENING IS TO TAKE PLACE ABOVE THE ROOF. SEE STRUCTURAL DRAWINGS FOR REQUIRED MODIFICATIONS.
2. FILL ALL CORNERS. ALL JOINTS AND SEAMS IN FLASHING AND COUNTERFLASHING ARE TO BE SOLDERED WATERTIGHT.

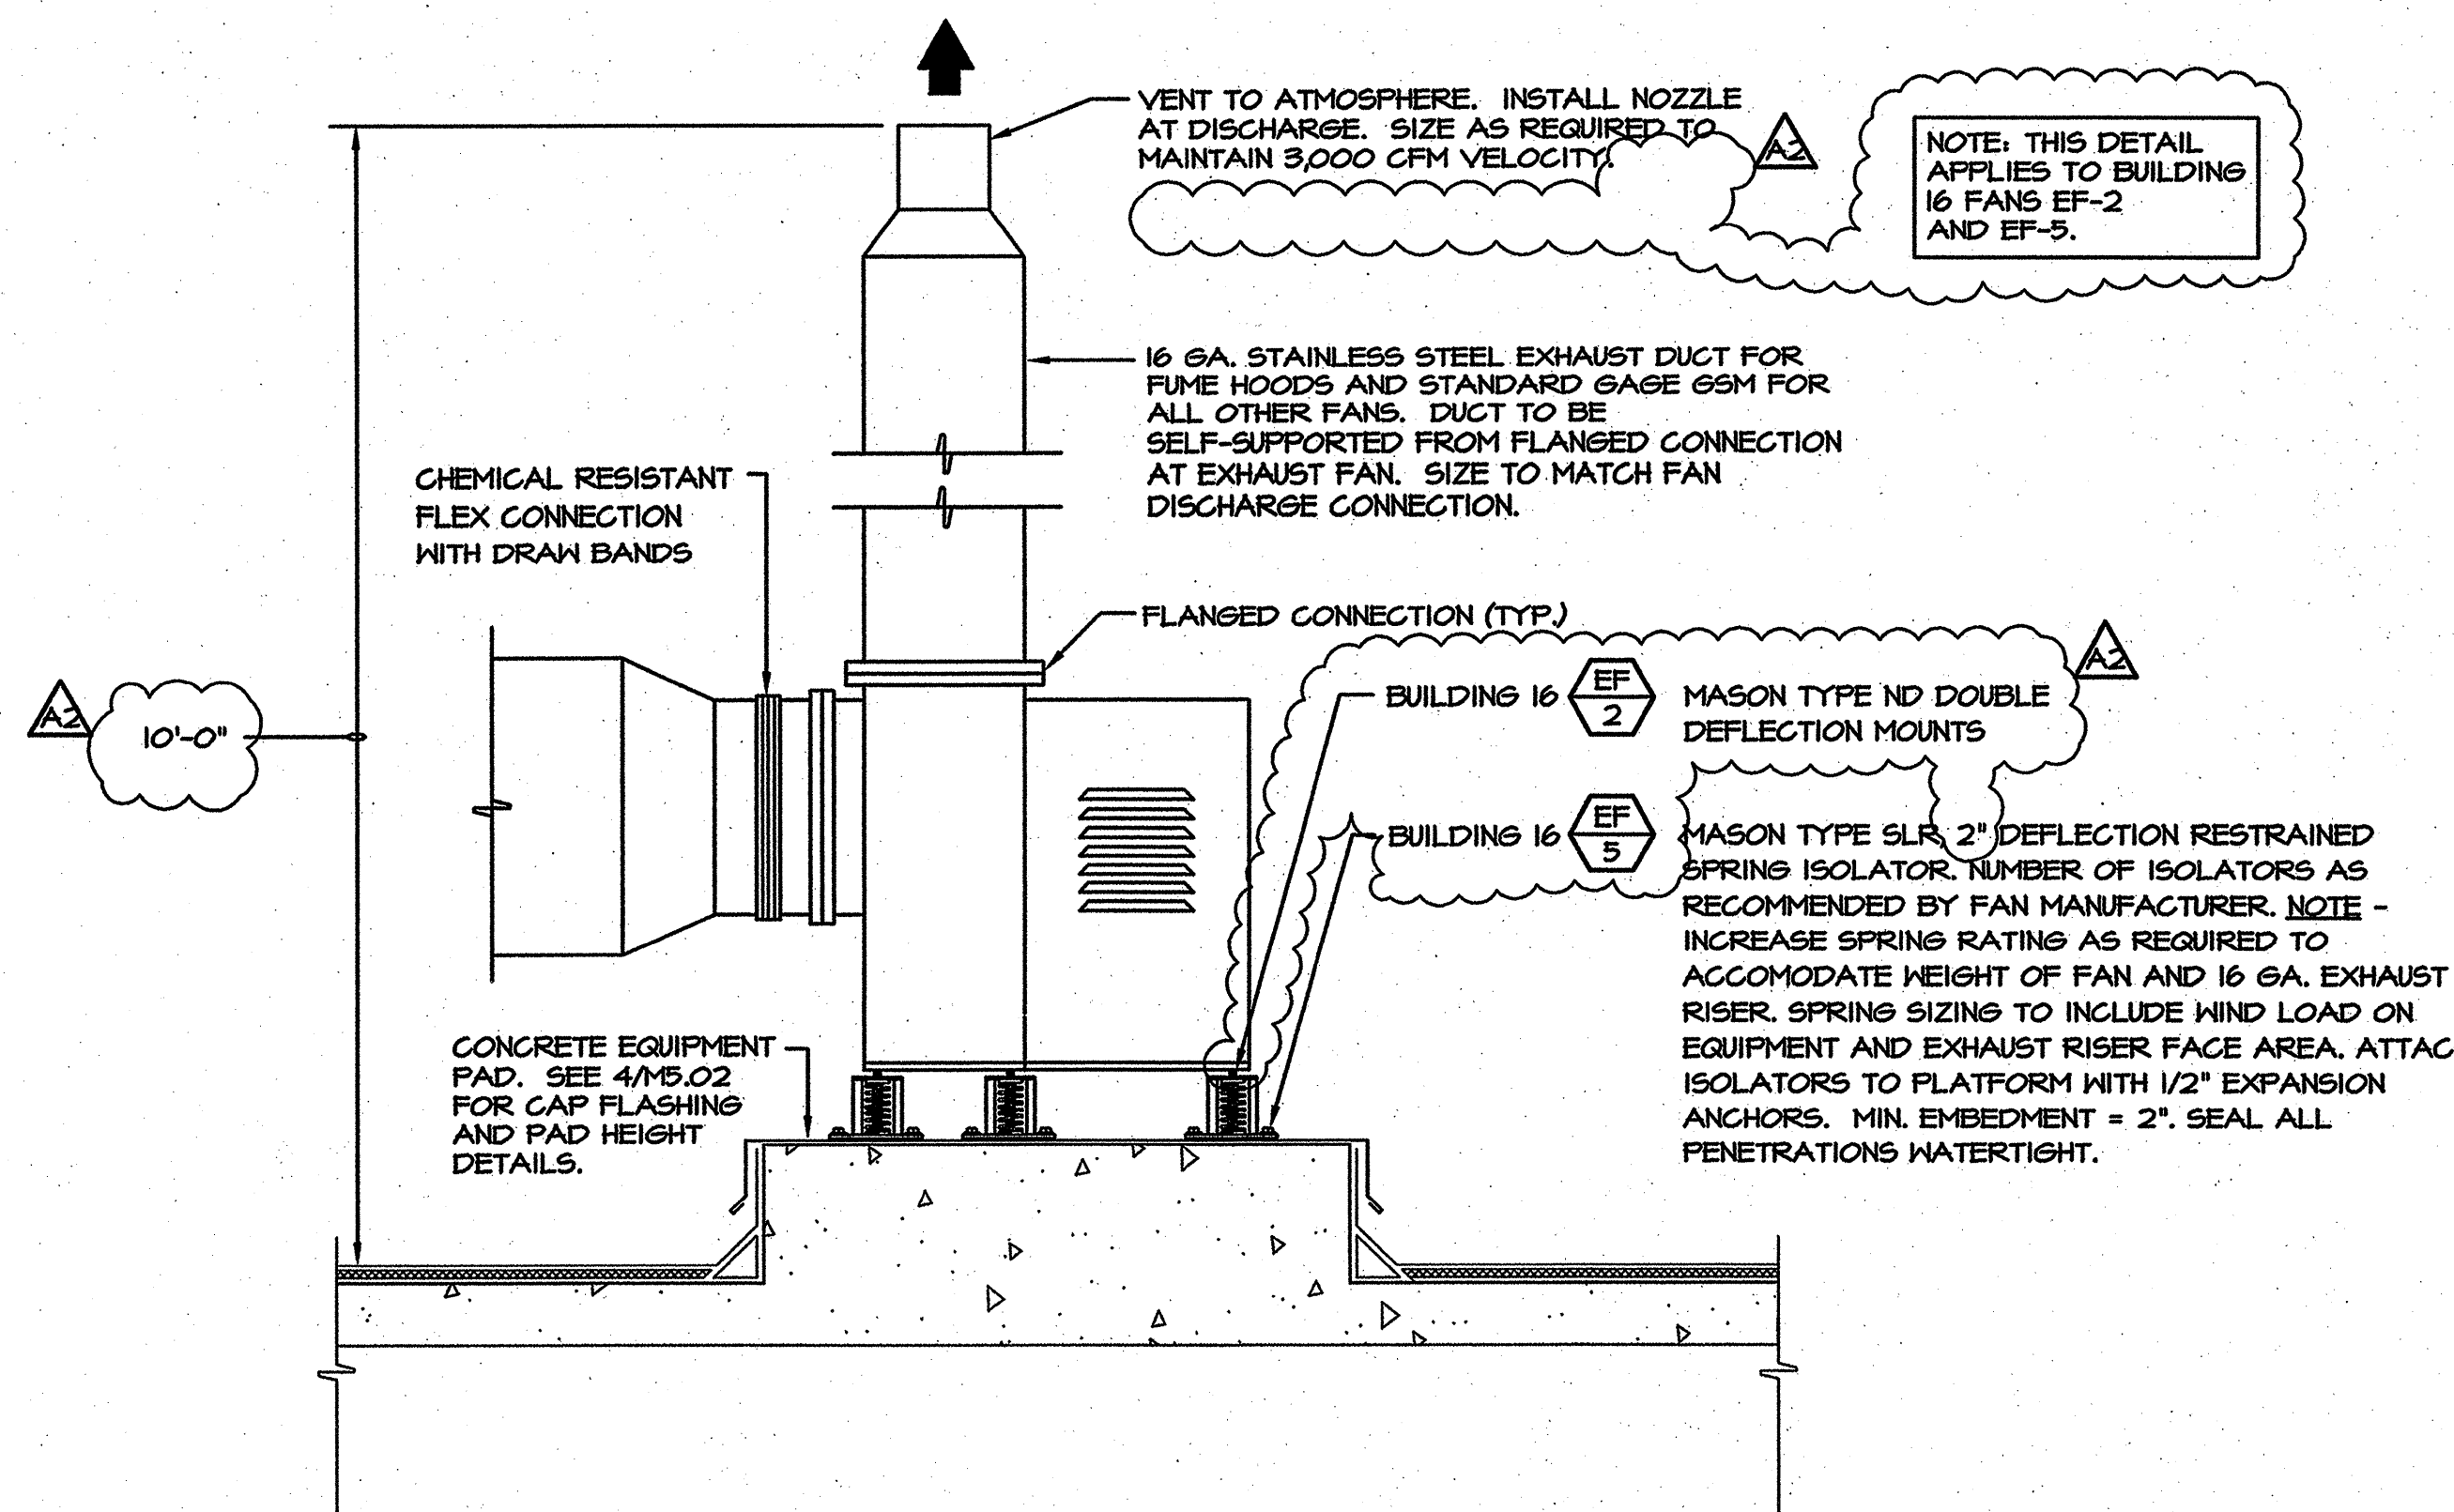

EXHAUST FAN MOUNTING DETAIL

NO SCALE

1
M5.03

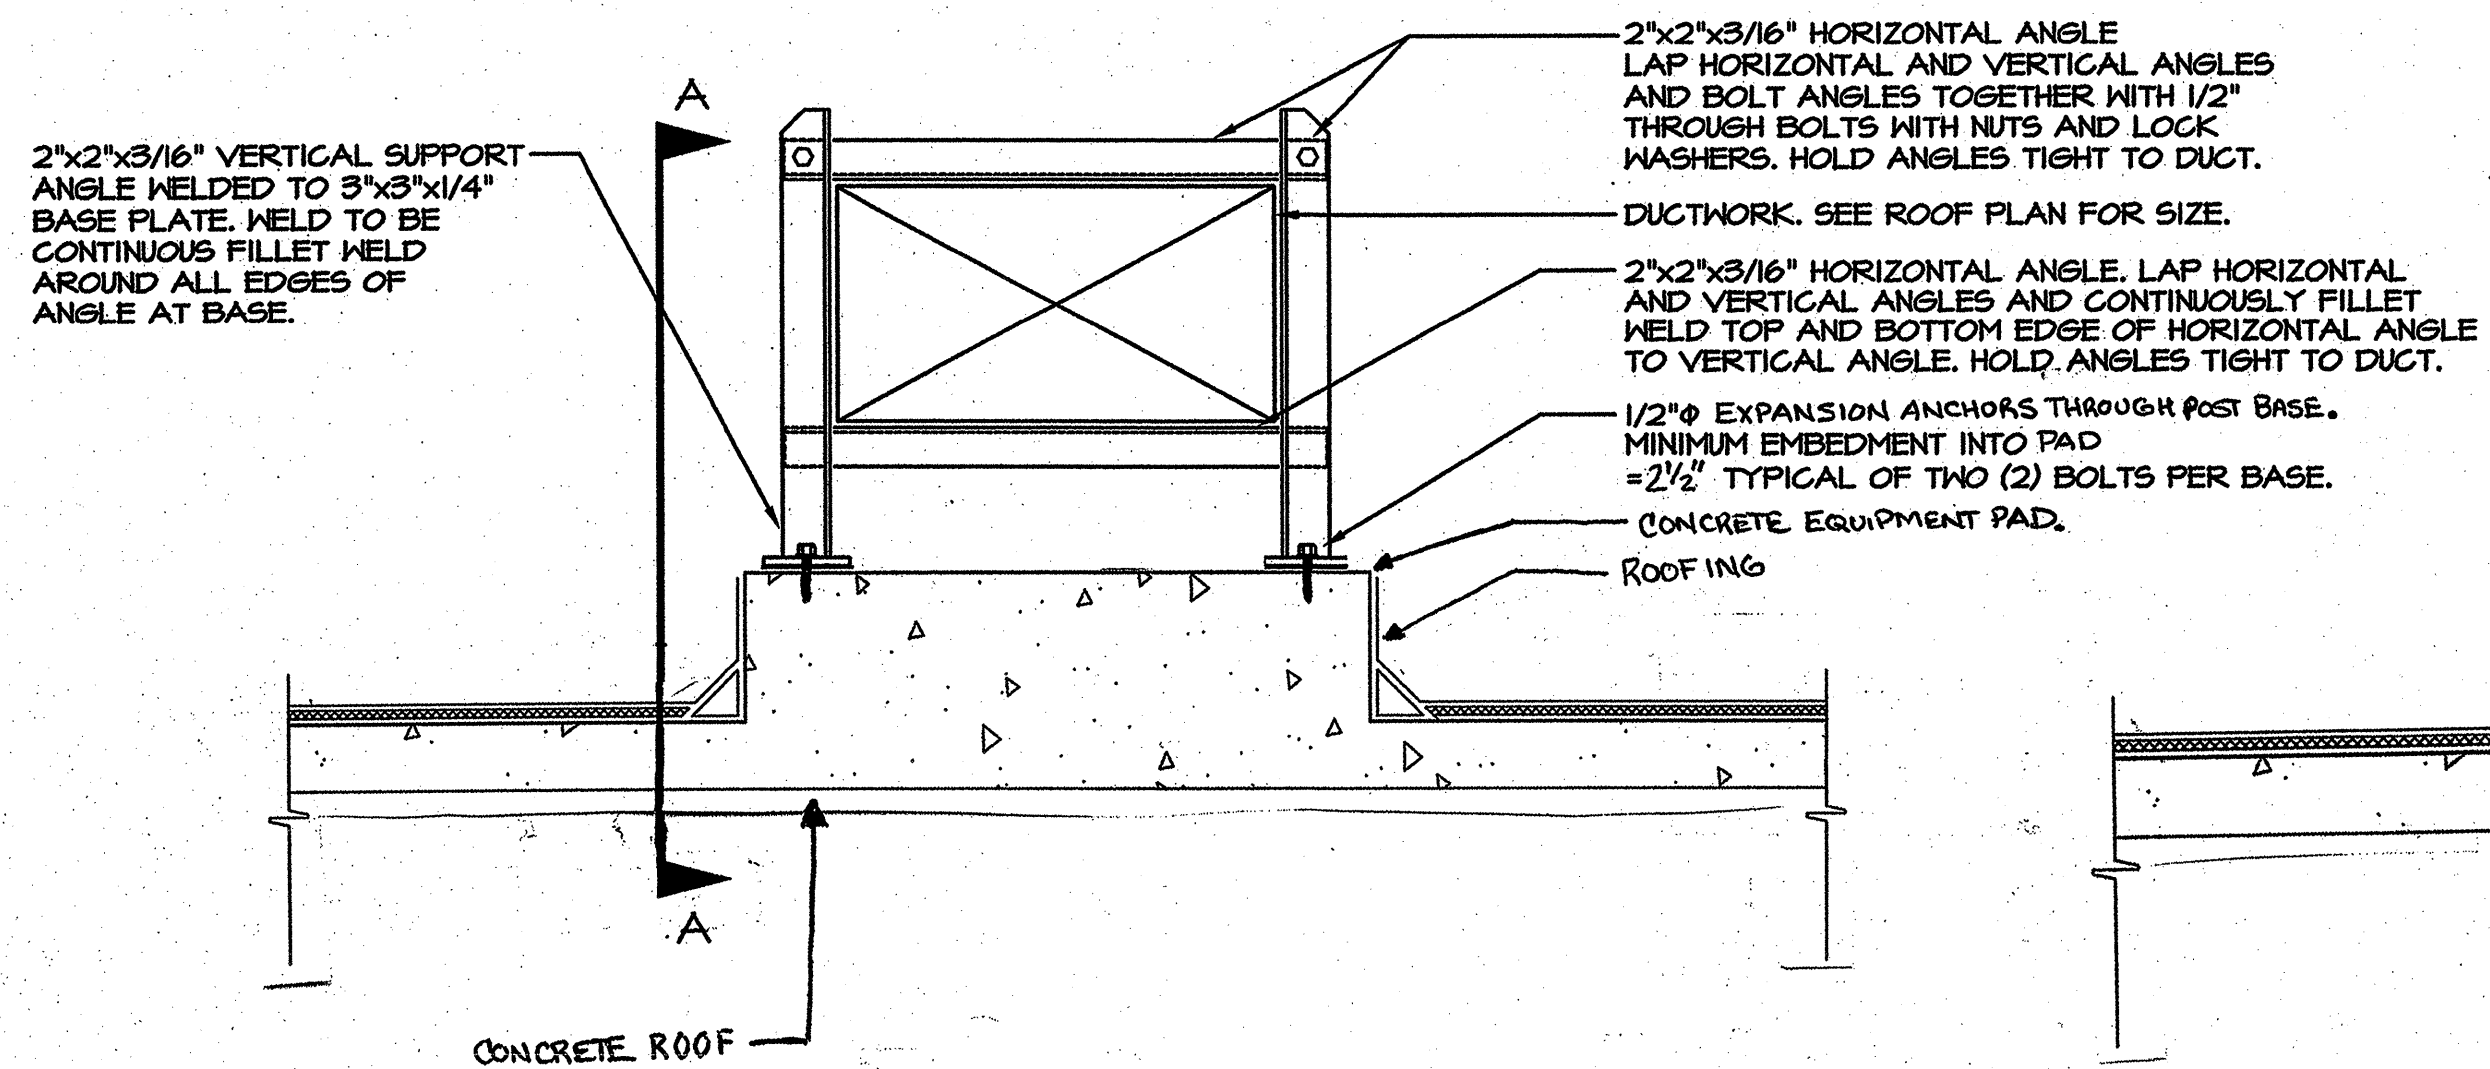


RECTANGULAR DUCT SUPPORT DETAIL

NO SCALE

NOTES:

1. SUPPORT FRAMES ARE SPACED 8'-0" MAX. C.C.
2. ROUND DUCT SUPPORT IS SIMILAR.

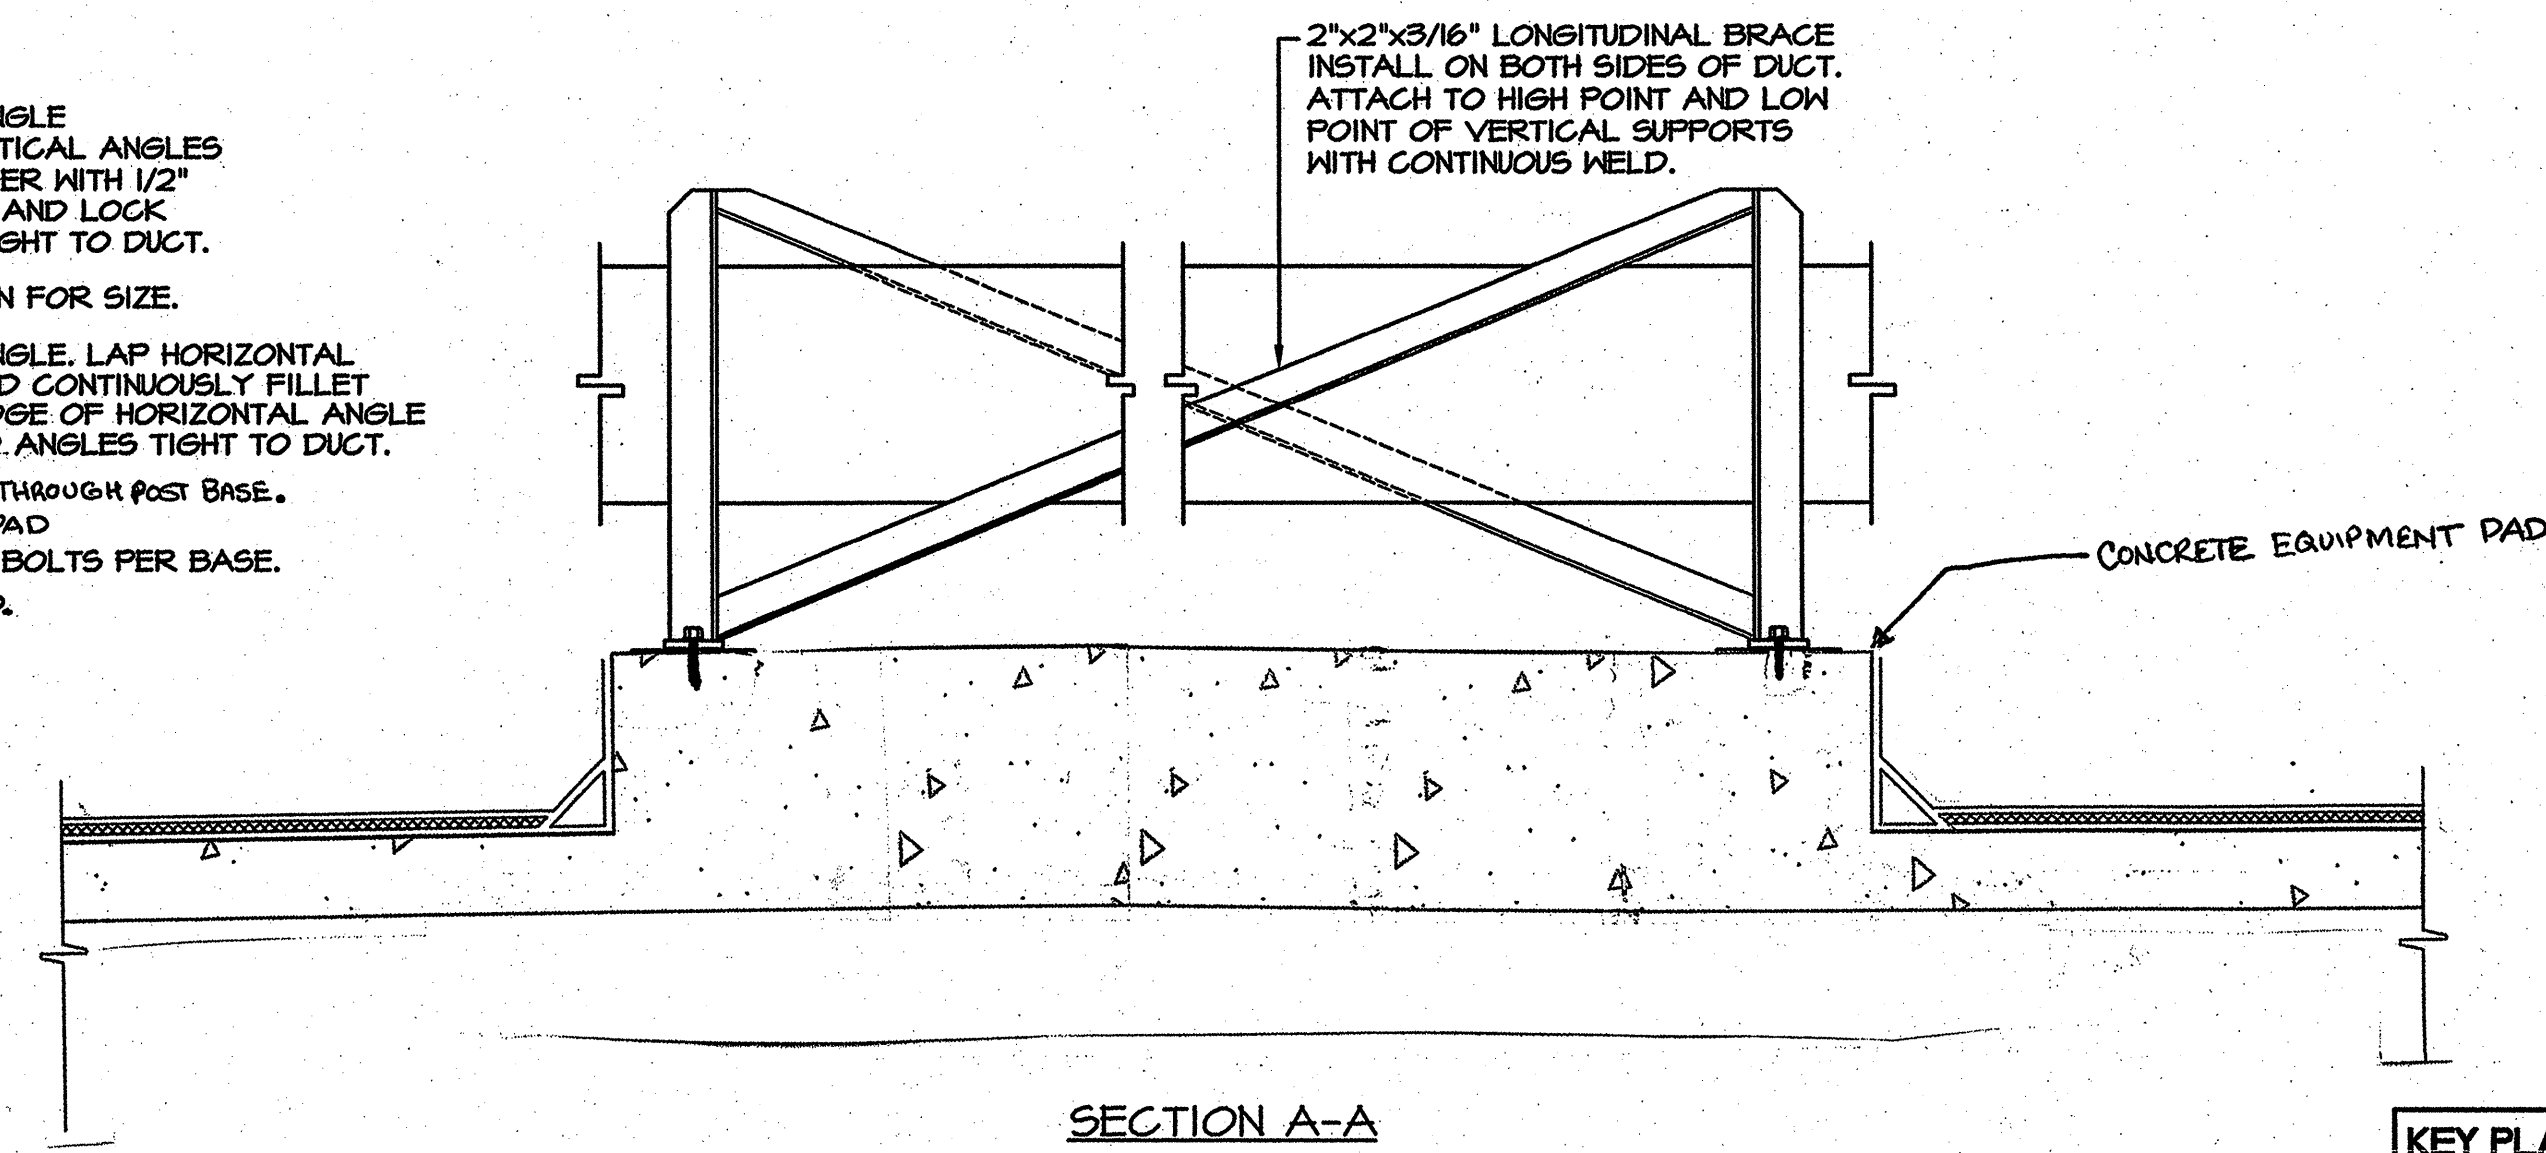


SECTION A-A

NOTE: INSTALL LONGITUDINAL BRACE ON ALTERNATING PAIRS OF SUPPORTS. LONGITUDINAL BRACE TO EXTEND FROM HIGHEST LOCATION OF BRACE DOWN TO LOWEST LOCATION.

3
M5.03

KEY PLAN

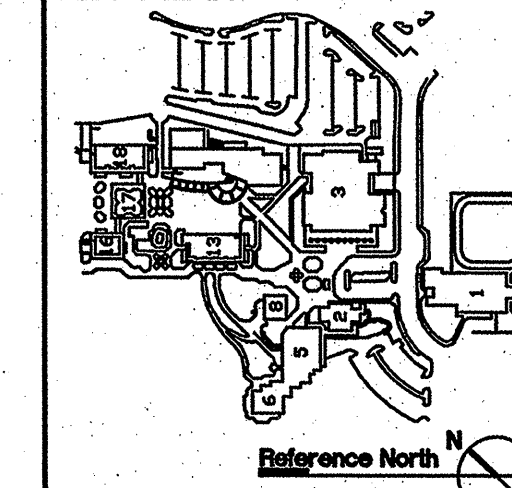


ARCHITECT OF RECORD
noll&tam
architects and planners

729 Heinz Avenue
Berkeley, CA 94710
510.649.8295
fax 510.649.3006

CONSULTANTS

McCracken & Woodman
INCORPORATED
Consulting Mechanical Engineers
355 Grand Avenue, Oakland, California 94610
Telephone (510) 763-4891 Fax (510) 763-0619

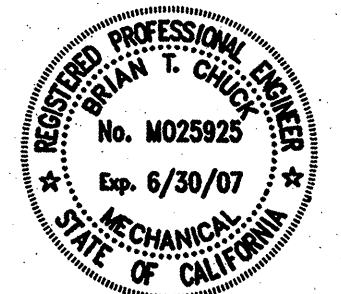

IDENTIFICATION STAMP
DIVISION OF THE STATE ARCHITECT
FILE NUMBER: 41-C1
APPLICATION NUMBER: 01-109611
AS _____ FS _____ SS _____
DATE _____

BID DOCUMENTS

CAÑADA COLLEGE
BUILDING 16, 17, 18
RENOVATION
SMCCCD
3401 CSM Drive
San Mateo, CA 94402
Cañada College
4200 Farm Hills Blvd.
Redwood City, CA 94061

SHEET TITLE
**MECHANICAL
DETAILS**

REVISIONS		
NO.	DATE	DESCRIPTION
▲	08/11/08	APPENDIX NO. 1
▲	08/18/08	APPENDIX NO. 2
▲	02/01/07	RECORD SET

DATE	MARCH 1, 2006
DRAWN	JP
CHECKED	BC
SCALE	AS NOTED
N&T JOB NO.:	2220.07

SHEET NUMBER

M5.03

acco engineered systems
1133 ALADDIN AVE
SAN LEANDRO, CALIFORNIA 94577
(510) 348-4300

626403 M0.01.DWG RC RISSE
Job Number Filename Drawn By Project Mgr
88519

RECORD DRAWING District Contract #
DATE: 02-01-07 Contractor's Signature