


# SAN MATEO COUNTY COMMUNITY COLLEGE DISTRICT COLLEGE OF SAN MATEO FINE ARTS COMPLEX BUILDINGS 2 & 4 RENOVATIONS

344 CSM DRIVE, SAN MATEO CA 94402  
CONSTRUCTION DOCUMENTS  
INCREMENT 2

DSA FILE No. 41-C1  
DSA APPLICATION No. 01-109243



222 SUTTER STREET, 9TH FLOOR  
SAN FRANCISCO, CALIFORNIA 94108  
phone 415.777.9422 fax 415.777.2755 24/7 [bparch.com](http://bparch.com)  
architect/engineer seals

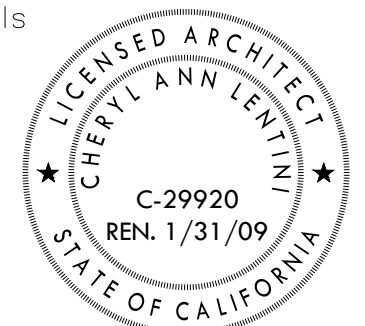

consultant



project title  
**SMCCCD  
COLLEGE OF SAN MATEO  
FINE ARTS COMPLEX  
BUILDINGS 2 & 4  
RENOVATIONS  
INCREMENT 2**  
344 CSM DRIVE  
SAN MATEO, CA 94402

agency/approvals  
IDENTIFICATION STAMP  
DIVISION OF THE STATE  
ARCHITECT

APPL. No. 01 - 109243

AC \_\_\_\_\_ FLS \_\_\_\_\_ SS \_\_\_\_\_  
DATE \_\_\_\_\_

| date       | description   |
|------------|---------------|
| 03.13.2008 | PRICING SET   |
| 05.08.2008 | DSA SUBMITTAL |
| 10.14.2008 | DSA BACKCHECK |
| 10.26.2008 | AS BUILT      |

sheet title  
**COVER SHEET**

project no. 2707.01

sheet no.

# A-004

©Beverly Prior Architects, Inc. 2007 | All Rights Reserved

OWNER:  
SAN MATEO COUNTY COMMUNITY COLLEGE DISTRICT  
344 CSM DRIVE  
SAN MATEO, CA 94402  
(650) 358-6787  
(650) 358-6764

ARCHITECT:  
BEVERLY PRIOR ARCHITECTS, INC.  
222 SUTTER STREET, 9TH FLOOR  
SAN FRANCISCO, CALIFORNIA 94108  
(415) 777-9422  
(415) 777-2755



MECHANICAL, ELECTRICAL & PLUMBING ENGINEERS:  
GAYNER ENGINEERS  
1133 POST STREET  
SAN FRANCISCO, CALIFORNIA 94107  
(415) 474-9500  
(415) 474-1363

STRUCTURAL ENGINEER:  
CORNERSTONE STRUCTURAL ENGINEERING GROUP  
40 FEDERAL STREET  
SAN FRANCISCO, CA 94107  
(415) 505-4875  
(415) 369-9101



SECURITY/TELECOM/AV:  
ON LINE CONSULTING SERVICES  
388 17TH STREET, STE. 230  
OAKLAND, CA 94612  
(510) 269-1531  
(510) 839-4791

CIVIL ENGINEER:  
SANDIS ENGINEERS  
605 CASTRO STREET  
MOUNTAIN VIEW, CA 94041  
(650) 969-6900  
(650) 969-6472



## B1 PROJECT TEAM

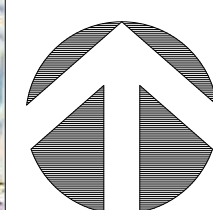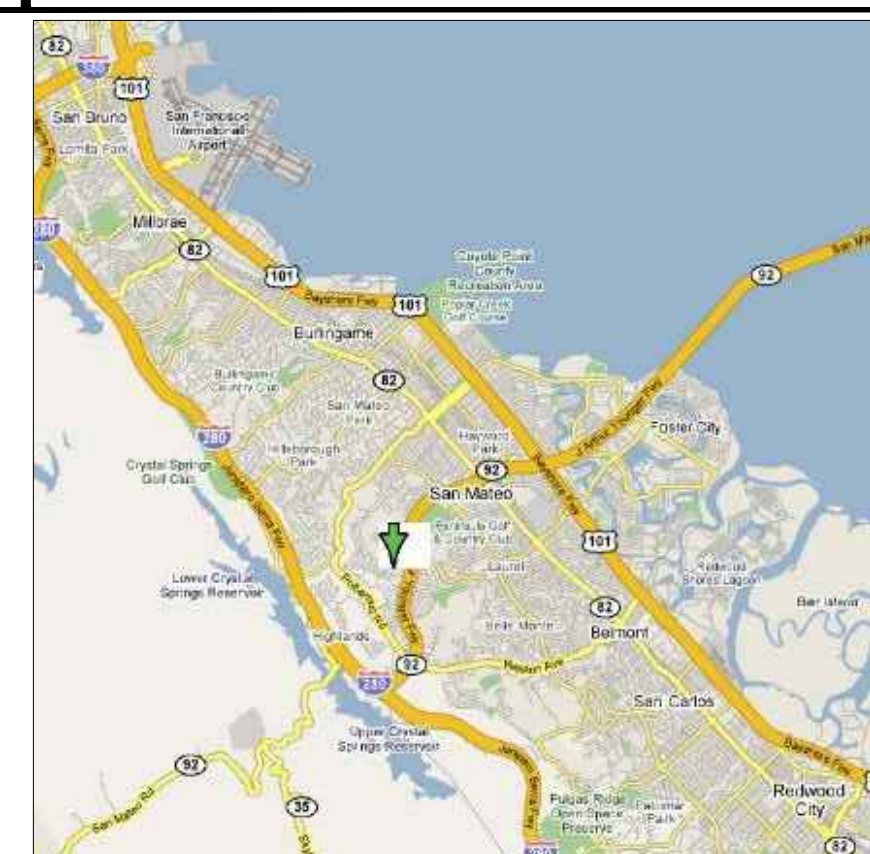



A1 VICINITY MAP

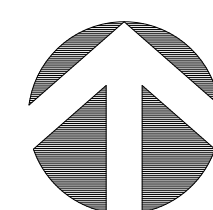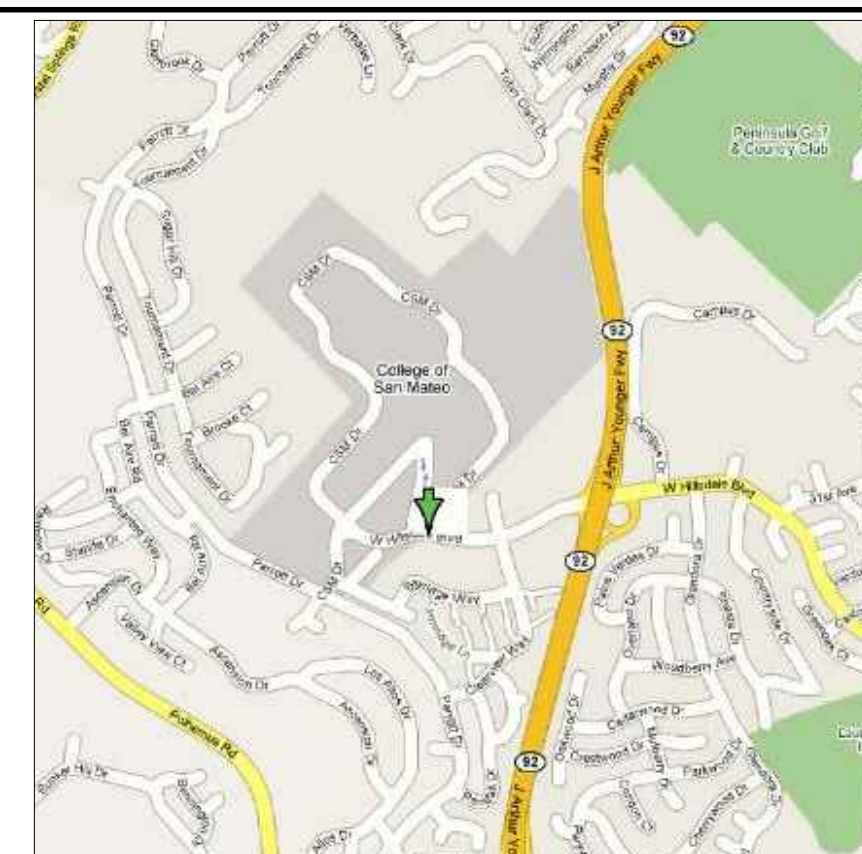

A2 AREA MAP

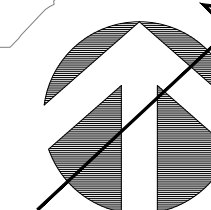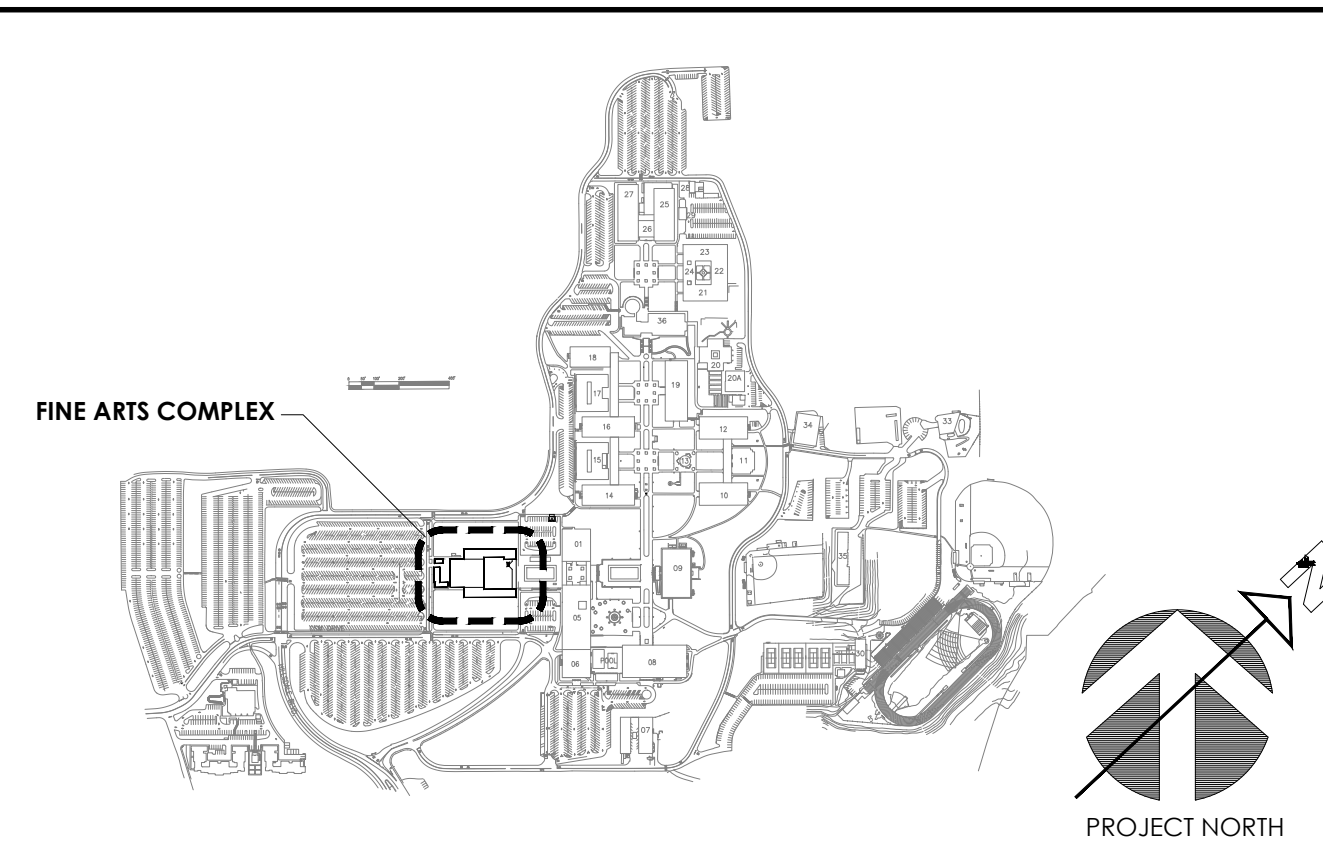

A3 CAMPUS PLAN

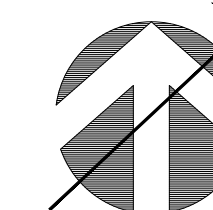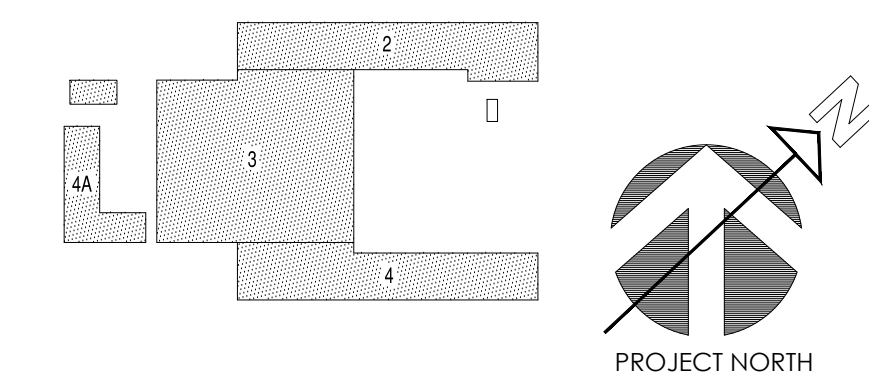

A4 KEY PLAN