

222 SUTTER STREET, 9TH FLOOR
SAN FRANCISCO, CALIFORNIA 94108
phone 415.777.9422 fax 415.777.2755 24/7 bparch.com
architect/engineer seals



consultant

project title
**SMCCCD
COLLEGE OF SAN MATEO
FINE ARTS COMPLEX
BUILDINGS 2 & 4
RENOVATIONS
INCREMENT 2**

344 CSM DRIVE
SAN MATEO, CA 94402

agency/approvals
IDENTIFICATION STAMP
DIVISION OF THE STATE ARCHITECT
APPL. No. 01 - 109243
AC _____ FLS _____ SS _____
DATE _____

date	description
03.13.2008	PRICING SET
05.08.2008	DSA SUBMITTAL
10.14.2008	DSA BACKCHECK
10.26.2008	AS BUILT

sheet title
SITE PLAN

project no. 2707.01
sheet no.

A-101


©Beverly Prior Architects, Inc. 2007 | All Rights Reserved

B1 SITE PLAN

B4 LOCAL FIRE AUTHORITY REVIEW

ACCESSIBLE PATH OF TRAVEL (P.O.T.): -----
WHERE INDICATED IS A BARRIER-FREE ACCESS WITHOUT ANY ABRUPT VERTICAL CHANGES EXCEEDING 1/2" AT 1:2 MAXIMUM SLOPE, EXCEPT THAT LEVEL CHANGES DO NOT EXCEED 1/4" VERTICAL. MAXIMUM CROSS SLOPE OF 2%. ARCHITECT & CONTRACTOR TO VERIFY THAT ALL BARRIERS (PER C.B.C. SECTION 1133B.7) IN THE PATH OF TRAVEL HAVE BEEN REMOVED. 1:20 MAX. LONGITUDINAL SLOPE.

ACCESSIBLE ENTRANCES:
ALL ENTRY/EXITS TO BE ACCESSIBLE PER C.B.C. 1133B.1.1.1.1 AND 1133B.2.4.2. ACCESSIBLE ENTRY/EXITS TO HAVE 24" STRIKE-SIDE CLEARANCE AT EXTERIOR SIDE OF DOOR; HAVE 60" MIN. LEVEL AREA (2% MAX SLOPE) PERPENDICULAR TO DOOR AT EXTERIOR; AND HAVE A LEVEL LANDING AREA CONNECTED TO THE ACCESSIBLE ROUTE THROUGHOUT THE SITE.

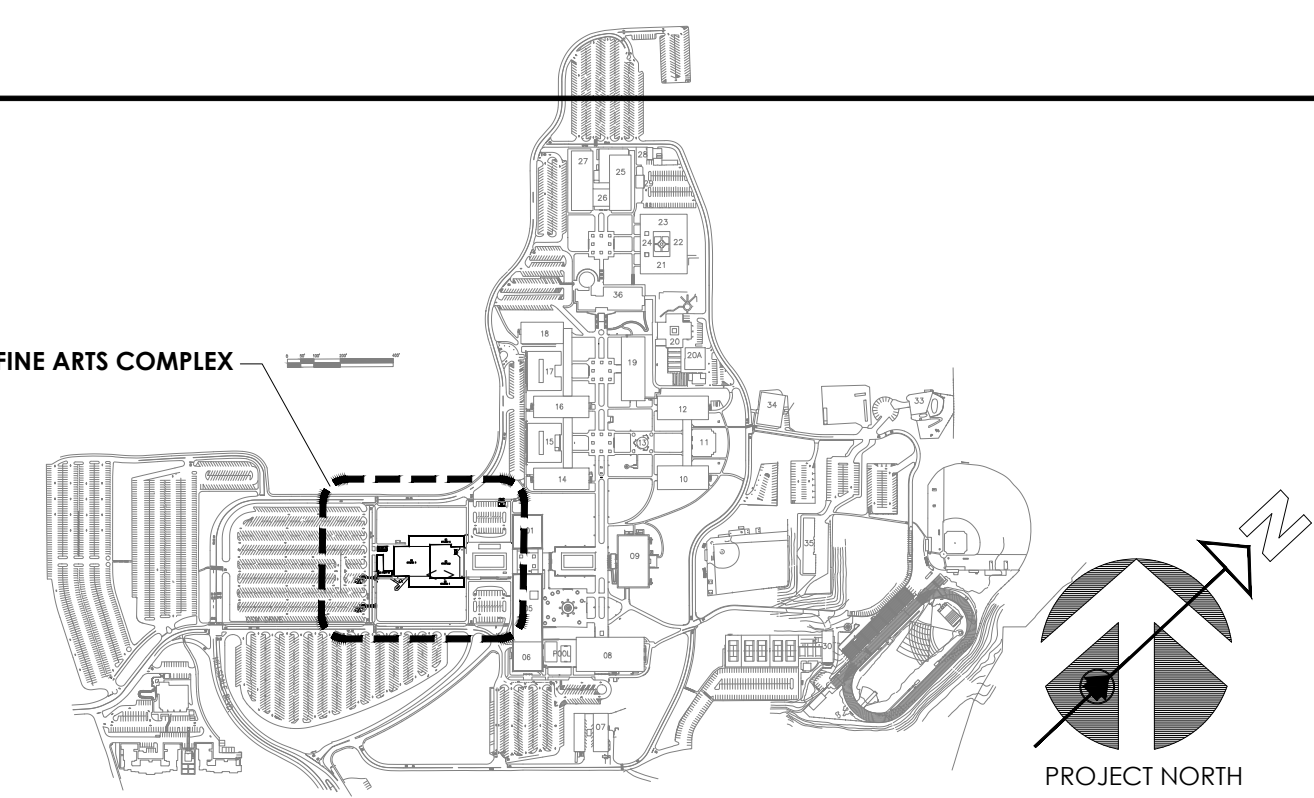

- 1 THIS WORK ORIGINALLY SHOWN AS PART OF INCREMENT 1, NOW SHOWN FOR REFERENCE ONLY. SELECT SITE WORK TO BE COMPLETED UNDER CSM DESIGN/ BUILD PROJECT APPL. # 01-110097.
 - 2 ACCESSIBLE ROUTE SIGN #2. SEE C2/A555 FOR DETAILS. PROVIDE 2 PANELS, ONE EACH SIDE OF POST
 - 3 ACCESSIBLE ROUTE SIGN #1. SEE C2/A555 FOR DETAILS. SEE A-136 FOR EXACT LOCATION AND MOUNTING
- FH FIRE HYDRANT

- ACCESSIBLE FACILITIES LEGEND**
FOR DSA REFERENCE ONLY. SEE SHEET A-581 (INCREMENT 1) FOR SIGN DETAILS. EXISTING CONDITIONS ARE INDICATED AS (E). SEE A002 FOR EXISTING DSA APPLICATION NUMBERS.
- (DA) DRINKING FOUNTAIN/ ACCESSIBLE
 - (MA) MEN'S TOILET/ ACCESSIBLE
 - (WA) WOMEN'S TOILET/ ACCESSIBLE
 - (AP) PARKING SPACE AND SIGN/ ACCESSIBLE
 - (AV) VAN PARKING SPACE AND SIGN/ ACCESSIBLE
 - (EA) ELEVATOR/ ACCESSIBLE
 - (RA) RAMP/ ACCESSIBLE
 - (UA) UNAUTHORIZED VEHICLES SIGN

A1 DSA / ADA COMPLIANCE

A3 CAMPUS PLAN

A3 KEY NOTES/ LEGEND

A4 ACCESS COMPONENT KEY