


BUILDING 3




NOTE:
 1. CONTRACTOR SHALL ADJUST EX. UTILITIES AS NECESSARY TO REMOVE PIPE CONFLICTS.
 2. CONTRACTOR WILL NOTIFY ENGINEER IF SS LATERALS ARE NOT IN COMPLIANCE WITH THE SLOPE SHOWN, NO CONSTRUCTION WILL START PRIOR TO THE ENGINEERS RECOMMENDATION.

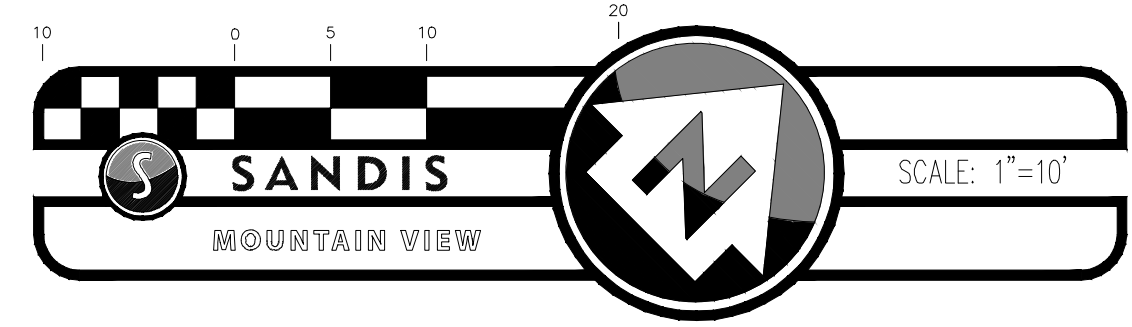

222 SUTTER STREET, 9TH FLOOR
 SAN FRANCISCO, CALIFORNIA 94108
 phone 415.777.9422 fax 415.777.2755 bparch.com

architect/engineer seals
 DATE _____
 KENNETH N. OLCOTT
 R.C.E. NO. 51079, EXPIRES 9-30-09

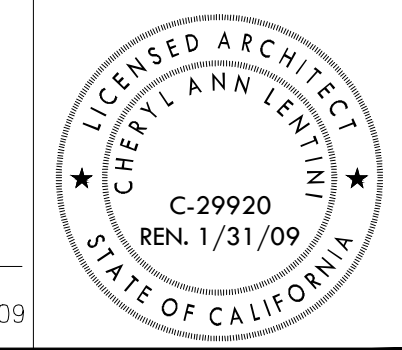

consultant
SANDIS CIVIL ENGINEERS SURVEYORS PLANNERS
 www.sandis.net
 605 Castro Street | Mountain View, CA 94041 | P. 650.969.6900 | F. 650.969.6472
 MOUNTAIN VIEW ROSEVILLE OAKLAND

project title
SMCCCD COLLEGE OF SAN MATEO FINE ARTS COMPLEX BUILDINGS 2 & 4 RENOVATIONS INCREMENT 2
 344 CSM DRIVE
 SAN MATEO, CA 94402

agency/approvals
 IDENTIFICATION STAMP
 DIVISION OF THE STATE ARCHITECT
 APPL. No. 01 - 109243
 AC _____ FL _____ SS _____
 DATE _____

date	description
03.13.2008	PRICING SET
05.08.2008	DSA SUBMITTAL
10.14.2008	DSA BACK CHECK
10.26.2010	AS BUILT

sheet title
UTILITY PLAN

project no. 2707.01 207302
 sheet no.

C-4.0

© Beverly Prior Architects, Inc. 2007 | All Rights Reserved