


222 SUTTER STREET, 9TH FLOOR
SAN FRANCISCO, CALIFORNIA 94108
phone 415.777.9422 fax 415.777.2755 247/ bparch.com

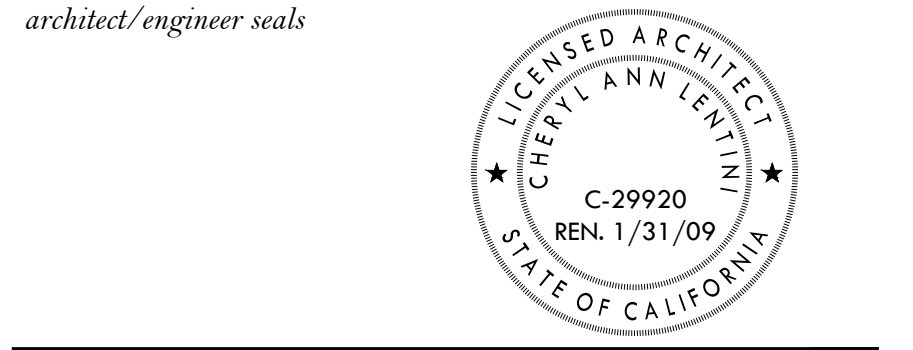

project title
SMCCCD
COLLEGE OF SAN MATEO
FINE ARTS COMPLEX
BUILDINGS 2 & 4
RENOVATIONS
INCREMENT 2
344 CSM DRIVE
SAN MATEO, CA 94402

agency/approvals

IDENTIFICATION STAMP	DATE	FLS	SS
DIVISION OF THE STATE ARCHITECT			
APPL. No. 01-109243			

date description

03.13.2008	PRICING SET
05.08.2008	INCREMENT 2 DSA SUBMITTAL
10.14.2008	DSA RESPONSE
11.04.2010	RECORD DRAWINGS

project no. 2707.01
sheet no. **S3.4**
© Beverly Prior Architects, Inc. 2007 | All Rights Reserved