

SLAB PLAN
SCALE: 1/4" = 1'-0"

- ① REFRIDGERATOR (NIC)
- ② POPCORN MACHINE (NIC)
- ③ ICE MAKER (NIC)
- ④ FOUNTAIN DRINK MACHINE (NIC)
- ⑤ HOT DOG MACHINE (NIC)
- ⑥ COFFEE MAKER (NIC)

SHEET NOTES:

1. STUCCO FINISH SHALL BE maxit 690. maxit 690 IS A PRE-BLENDED CEMENT-BASED PLASTER MIX.
THE COMPONENTS ARE:
TYPE I-H PORTLAND CEMENT 1 PART ASTM C-150
TYPE S HYDRATED LIME UP TO 20% ASTM C-206
SAND 4 PARTS ASTM C-897
maxit 690'S COMPONENT PROPORTIONS ARE IN ACCORDANCE WITH ASTM C926-98a. maxit 690 SIMULTANEOUSLY PLACES THE SCRATCH AND BROWN COATS PER 2000 UBC SECTION 2508 TABLE 25-F AND 2508.6 OF PORTLAND CEMENT-LIME PLASTER.
2. THE maxit 690 PRE-BLENDED CEMENT PLASTER IS APPLIED OVER PAPER AND METAL LATH. FASTEN METAL LATH TO STUDS WITH #8 x 1 1/4" LONG WAFFER HEAD SCREWS SPACED AT 6" O.C. AT PERIMETER VERTICAL & 3" O.C. AT PERIMETER HORIZONTAL AND 12" O.C. AT EACH VERTICAL STUD IN FIELD. SEE DETAIL (S-5).
3. EXTERIOR STUCCO MESH SHALL BE 17GA x 1 1/4" GALVANIZED SELF FURRING NETTING WITH DOUBLE BLACK KRAFT PAPER PER FS-UJ-5-790, TYPE I, GRADE D, STYLE 2, AND U.S.C. STANDARD 14-1.
4. INSTALL WESTERN #1A GALVANIZED METAL CORNER BEAD AT ALL OUTSIDE CORNERS.
5. INSTALL WESTERN #15 GALVANIZED M-SHAPED METAL CONTROL JOINTS, AS SHOWN ON EXTERIOR ELEVATIONS.
6. INSTALL WESTERN #66 METAL CASING BEADS AROUND DOORS.
7. INSTALL WESTERN #7 FOUNDATION SILL SCREED AT BOTTOM OF CEMENT PLASTER.
NOTE: SEE SHEETS A-00 & SS-1 FOR ALTERNATE UPGRADED STUCCO LATH NOTES & DETAILS.
8. EXTERIOR OPENING SIZES MAY VARY IN HEIGHT AND WIDTH, WITH A MAXIMUM HEIGHT OF 8/0 AND A MAXIMUM ALLOWABLE WIDTH. PER DETAIL ADD ALTERNATE HEADER DESIGN. SEE (S-10) & (S-10).
9. CABINETS AND CASEWORK (N.I.C.) TO BE DETAILED BY ARCHITECT OF RECORD PER PROJECT SPECIFIC REQUIREMENTS.
10. SEE SPECIFICATIONS A-00
11. SPECIAL LITE SL-17 FRP DOOR (STORE FRONT) SPECIAL LITE ALUMINUM TUBE FRAME 2"x6" IN TUBE FRAME. SL-11 CONTINUOUS HINGE INTERIOR DOORS: HOLLOW METAL DOOR WITH LCN OF NORTON CLOSURES AND DOOR STOPS WITH ALUM FINISH.
12. FOR ALL SIGNAGE SEE SHEET C-1.1

DOOR SCHEDULE					SM	
BUILDING 'A'						
#	NUMBER	JAMB DEPTH	DOOR TYPE	SIZE	SWING	COMMENTS
1	1	9"	Z	6070 x 1 3/4"	PAIR	ND-70 SCHLAGE
2	2	7"	L1	3070 x 1 3/4"	L/HR	ND-70 SCHLAGE
3	3	9"	Z	6070 x 1 3/4"	PAIR	ND-70 SCHLAGE
4	4	9"	A3	3070 x 1 3/4"	L/HR	VON DUPPRIN PANIC HARDWARE
5	5	9"	L11	3070 x 1 3/4"	R/HR	ND-85 SCHLAGE
6	6	9"	L11	3070 x 1 3/4"	L/HR	ND-85 SCHLAGE
7	7	7"	L1	3070 x 1 3/4"	RH	ND-70 SCHLAGE
8	8	7"	D1	3070 x 1 3/4"	L/HR	ND-70 SCHLAGE NL
9	9	5 1/2"	F	3068 x 1 3/4"	RH	ND-70 SCHLAGE
10	10	5	F	3068 x 1 3/4"	RH	ND-70 SCHLAGE

ALL EXTERIOR DOORS - FRP
ALL INTERIOR DOORS - SOLID CORE P-LAM

SEE SHEET C-1.1 FOR ALL SIGNAGE.


WINDOW SCHEDULE					
NO.	SIZE	STYLE	FRAME FINISH	COMMENTS	ROUGH OPENING
A	6/0 x 2/0	FIXED	DISTRICT TO VERIFY	DOUBLE GLAZED OBSCURE	72" x 24"
B	8/0 x 4/3	ROLL UP DOOR BY ATLAS ROLL-LITE OR EQUAL	DISTRICT TO VERIFY		96" x 53"

ROOM FINISH SCHEDULE			
ROOM	FLOOR FINISH	WALL FINISH	CEILING TYPE
EQUIPMENT ROOM 1	SEALED CONCRETE W/ 4" RUBBER BASE	3/4" CDX PLYWOOD	OPEN
ELECTRICAL ROOM	SEALED CONCRETE W/ 4" RUBBER BASE	5/8" SHEETROCK SMOOTH	OPEN
EQUIPMENT ROOM 2	SEALED CONCRETE W/ 4" RUBBER BASE	3/4" CDX PLYWOOD	OPEN
LOCKER ROOM	RUBBER MAT SPORTS FLOOR W/ 4" RUBBER BASE	5/8" SHEETROCK SMOOTH	FLAT T-BAR @ 8'-10"
TRAINER ROOM	RUBBER MAT SPORTS FLOOR W/ 4" RUBBER BASE	5/8" SHEETROCK SMOOTH	FLAT T-BAR @ 8'-10"
CONCESSIONS	SHEET VINYL W/ 6" CONTINUOUS COVE	5/8" SHEETROCK SMOOTH	FLAT T-BAR @ 8'-10"
IDF ROOM	SEALED CONCRETE W/ 4" RUBBER BASE	5/8" SHEETROCK SMOOTH	OPEN
JANITOR'S ROOM	SHEET VINYL W/ 6" CONTINUOUS COVE	5/8" SHEETROCK SMOOTH	OPEN
MEN'S ROOM	SHEET VINYL W/ 6" CONTINUOUS COVE	FRP OVER 1/2" PLYWOOD	FLAT T-BAR @ 8'-10"
WOMEN'S ROOM	SHEET VINYL W/ 6" CONTINUOUS COVE	FRP OVER 1/2" PLYWOOD	FLAT T-BAR @ 8'-10"

LEGEND:

- FLOOR DRAIN
- FIRE EXTINGUISHER
- FLOOR SINK
- WATER HEATER BELOW COUNTER

NOTE: FOR COMPLETE SIGNAGE INFORMATION SEE SHEET C-1.1

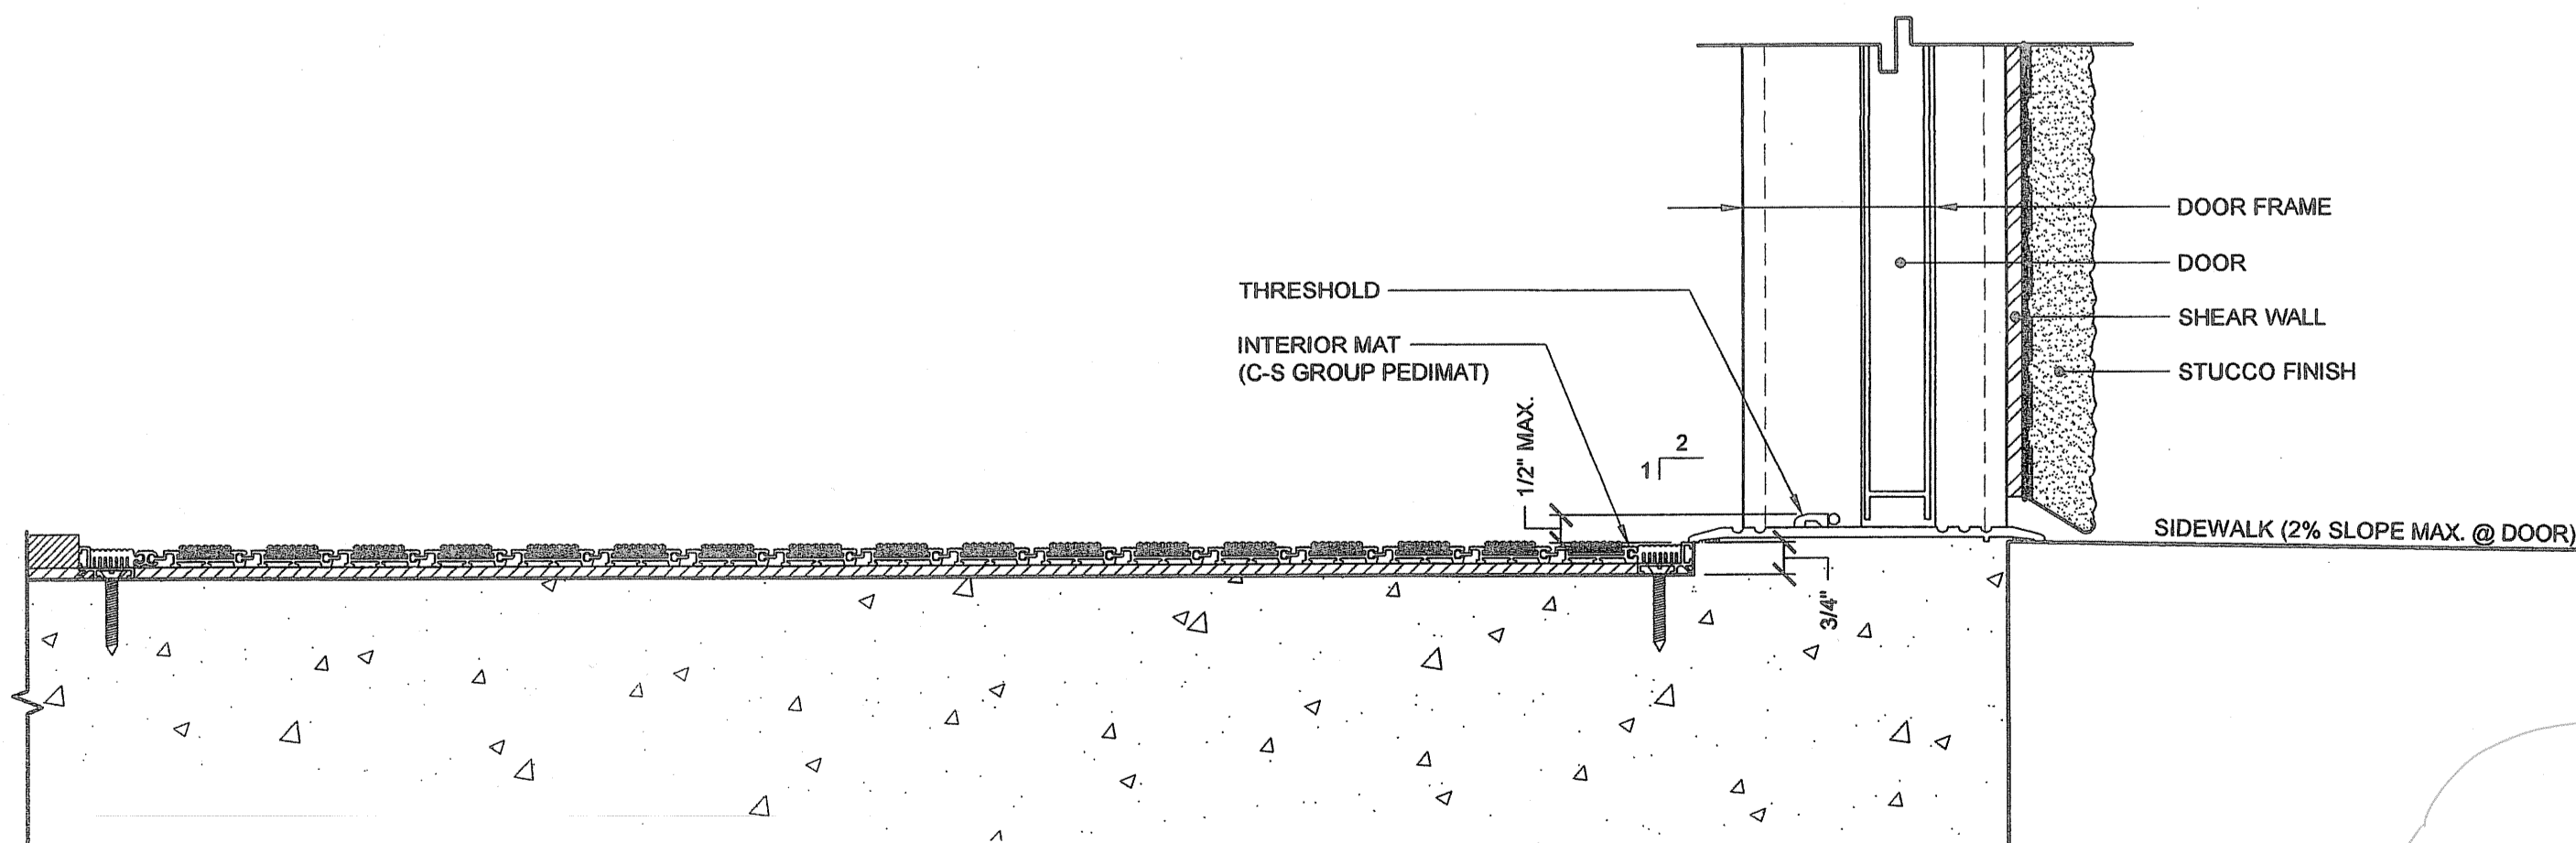

THRESHOLD MAT @ ENTRY
SCALE: 3" = 1'-0"

REVISIONS	
1	
2	
3	
4	
5	
6	

COPYRIGHT © 2003
SARAMARK, INCORPORATED
THESE PLAN DRAWINGS ARE PROPRIETARY DOCUMENTS OF SARAMARK, INCORPORATED & ARE NOT TO BE DISTRIBUTED, PUBLISHED OR REPRODUCED WITHOUT THE WRITTEN CONSENT OF SARAMARK INCORPORATED.

EC CONSULTING GROUP

1250 AVIATION AVE
SUITE 200-1
SAN JOSE, CA 95110
TEL: (408) 294-8513


COLLEGE of SAN MATEO
SAN MATEO UNIFIED SCHOOL DISTRICT

SARAMARK INCORPORATED
SERIES

4024AX
PC 01-105106

P.O. BOX 24369
SAN JOSE, CALIFORNIA 95114
TEL: (408) 871-3881
FAX: (408) 971-3834

BUILDING A TEAM ROOM FLOOR PLAN AND SLAB PLAN

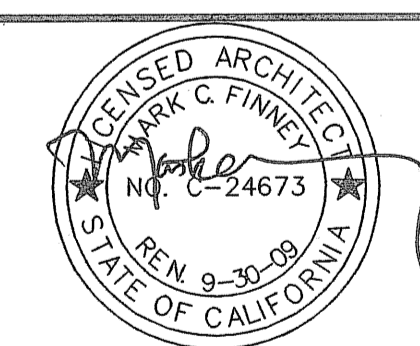

IDENTIFICATION STAMP
DIV. OF THE STATE ARCHITECT
OFFICE OF REGULATION SERVICES
01-108848
AC. [Signature] FLS. [Signature] SS. [Signature]
DATE OCT 10 2007

DRAWN: [Signature]
DATE: 4.11.07
CHECKED: FAV
SCALE: 1/4" = 1'-0"
PROJECT: 1615

A-A-1
PC 01-105106