


drawings\PROJECTS\OPEN PROJECTS\San Mateo Community College\Drawing Set\A-A_1a.dwg, 10/19/2007 3:25:11 PM, 6050- Bond-24.pc3




1 NORTH EXTERIOR ELEVATION TEAM ROOM
SCALE: 1/4" = 1'-0"

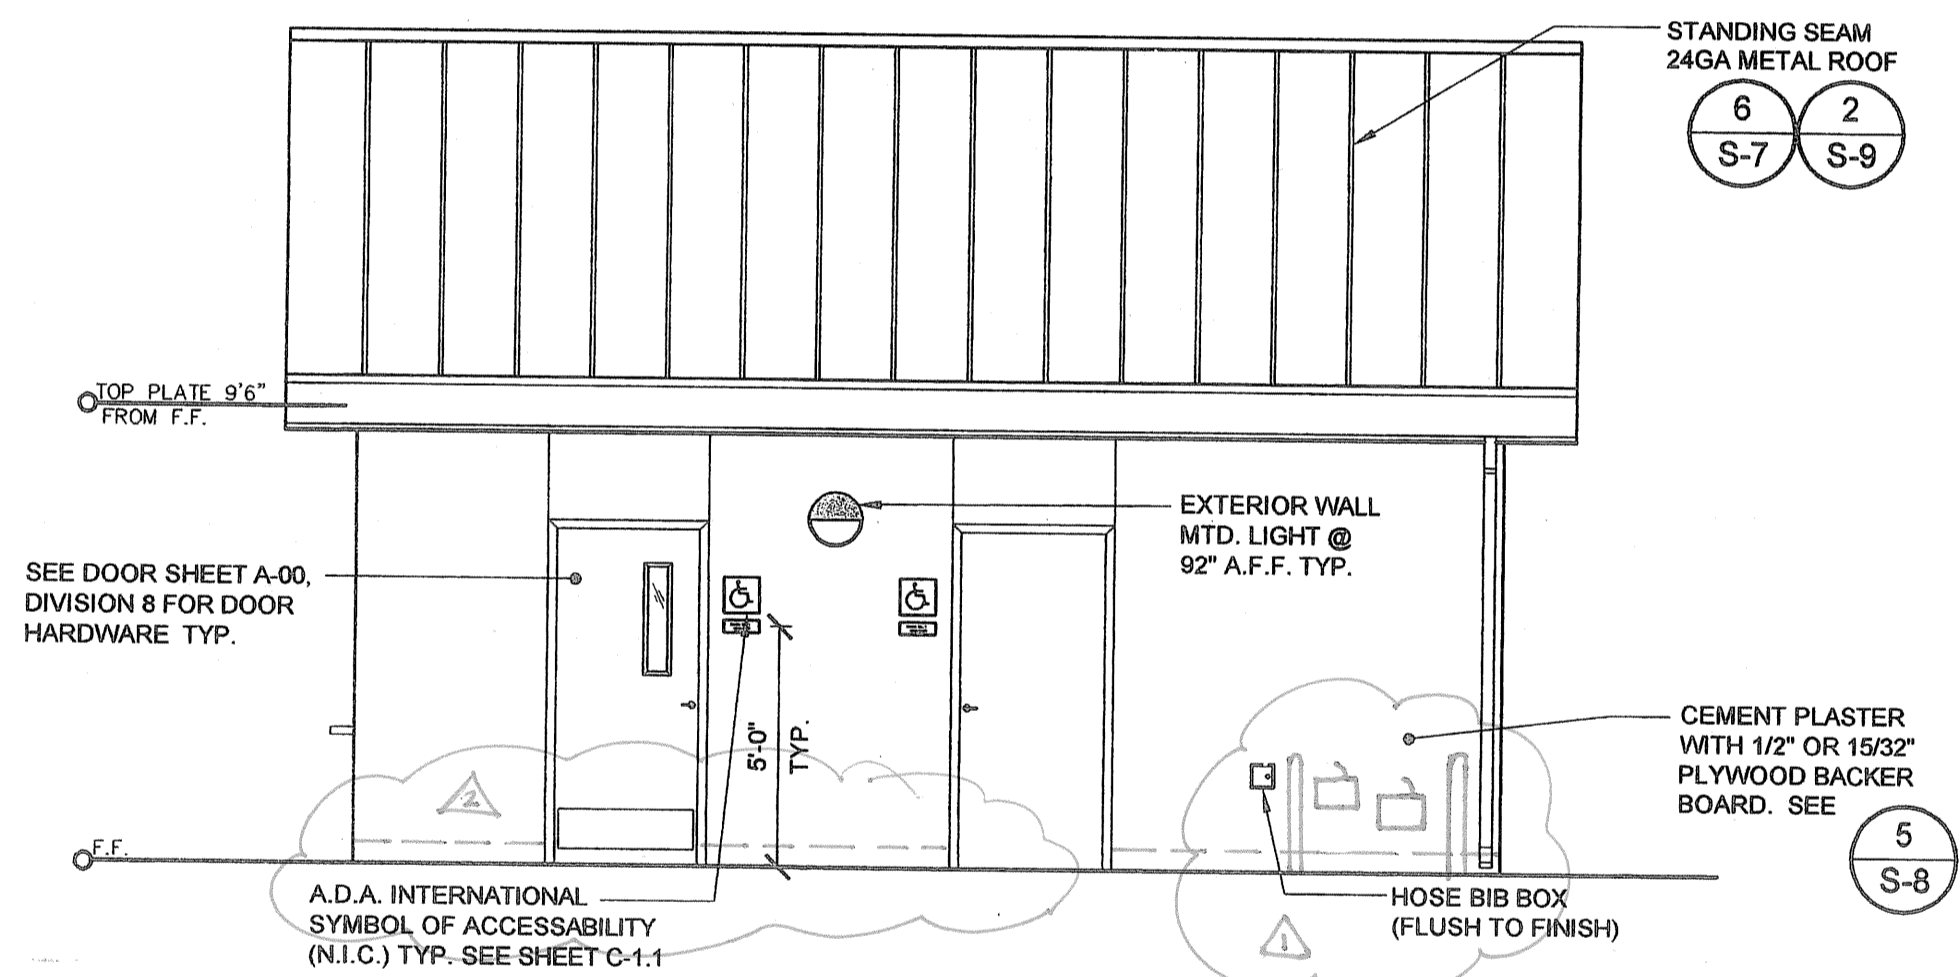


3 SOUTH EXTERIOR ELEVATION TEAM ROOM
SCALE: 1/4" = 1'-0"

NOTE: FOR COMPLETE SIGNAGE INFORMATION SEE SHEET C-1.1

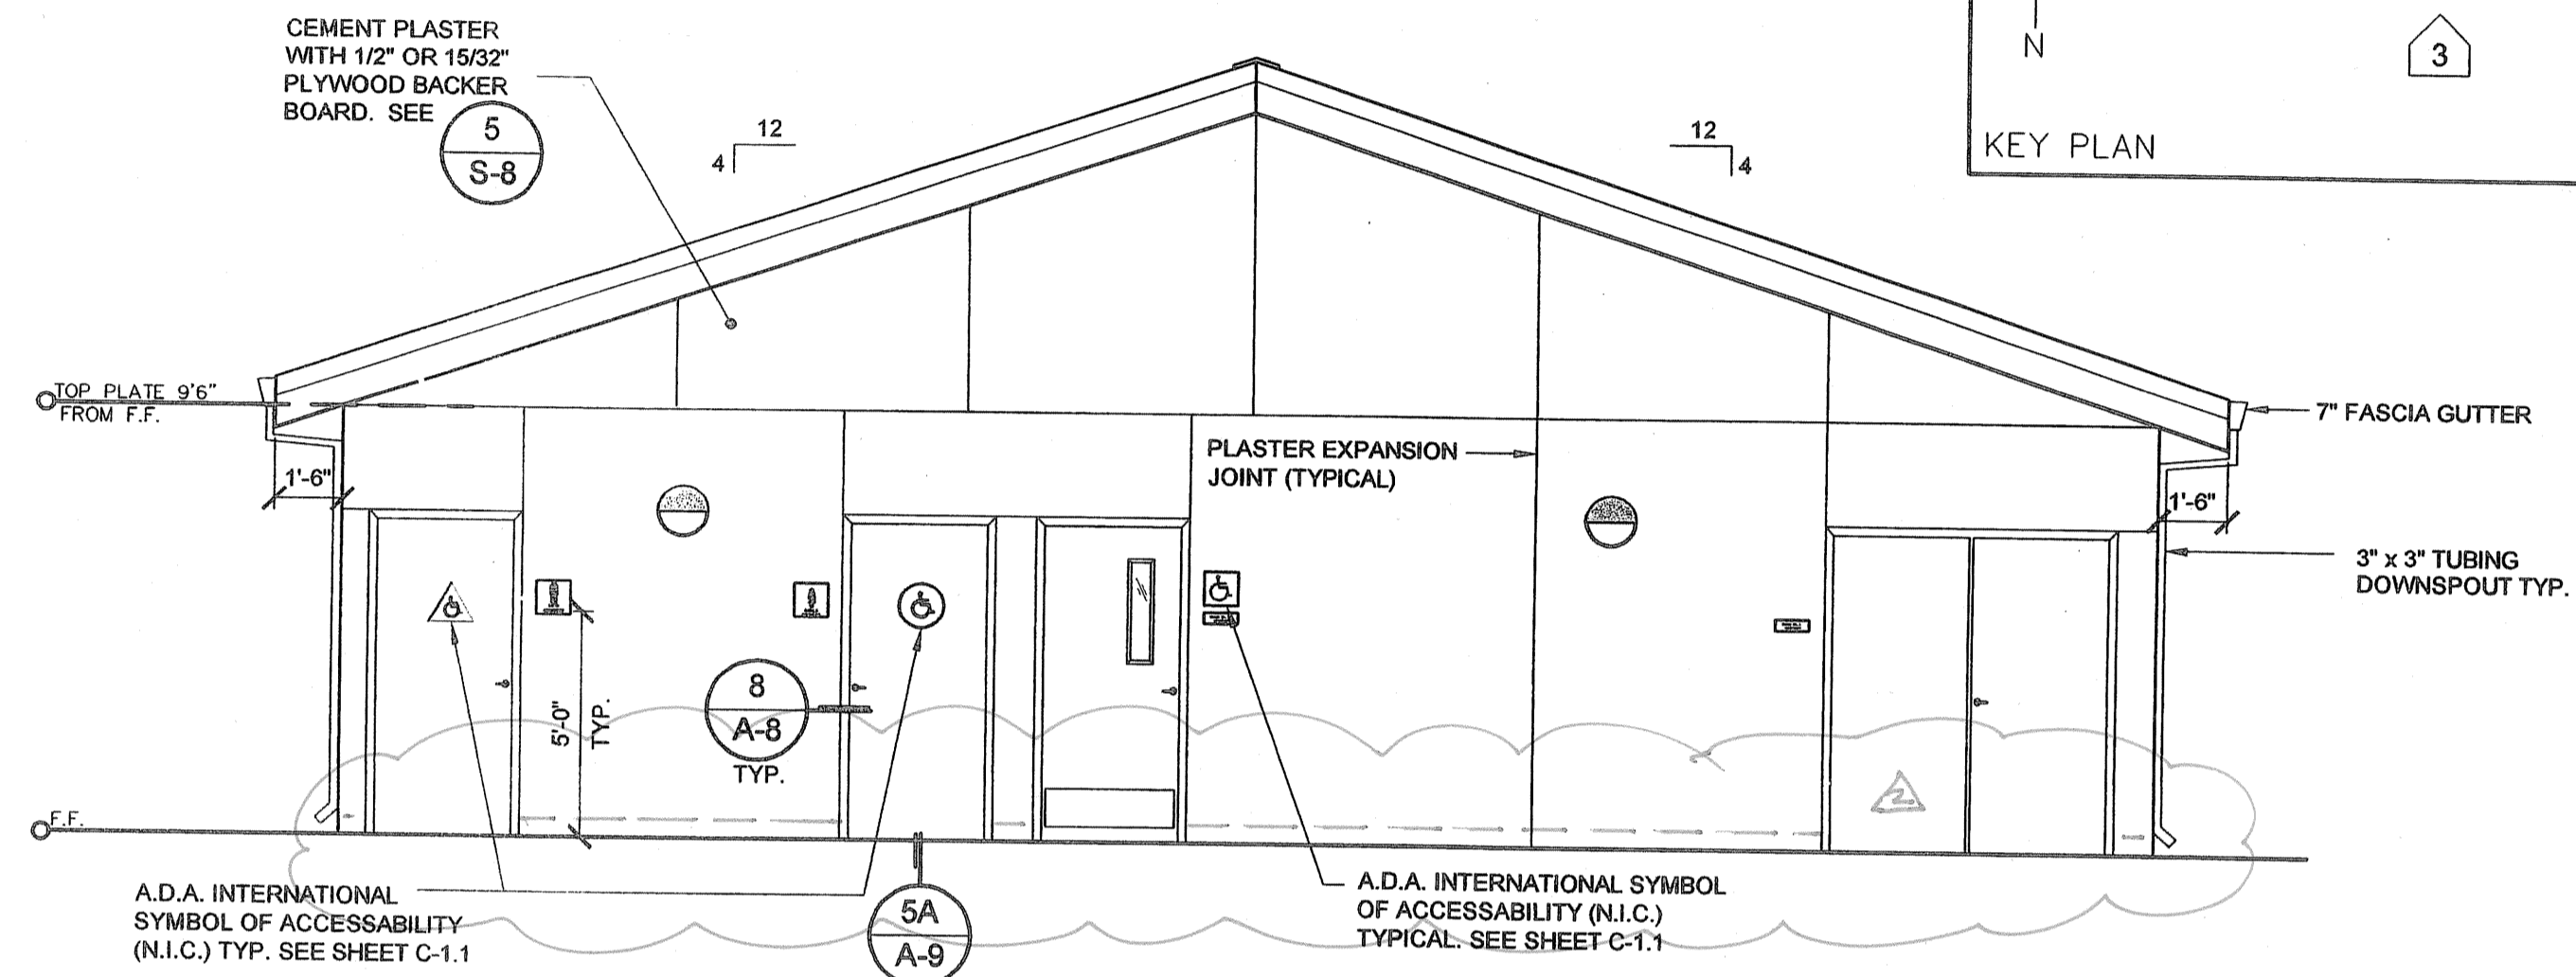


2 EAST EXTERIOR ELEVATION TEAM ROOM
SCALE: 1/4" = 1'-0"

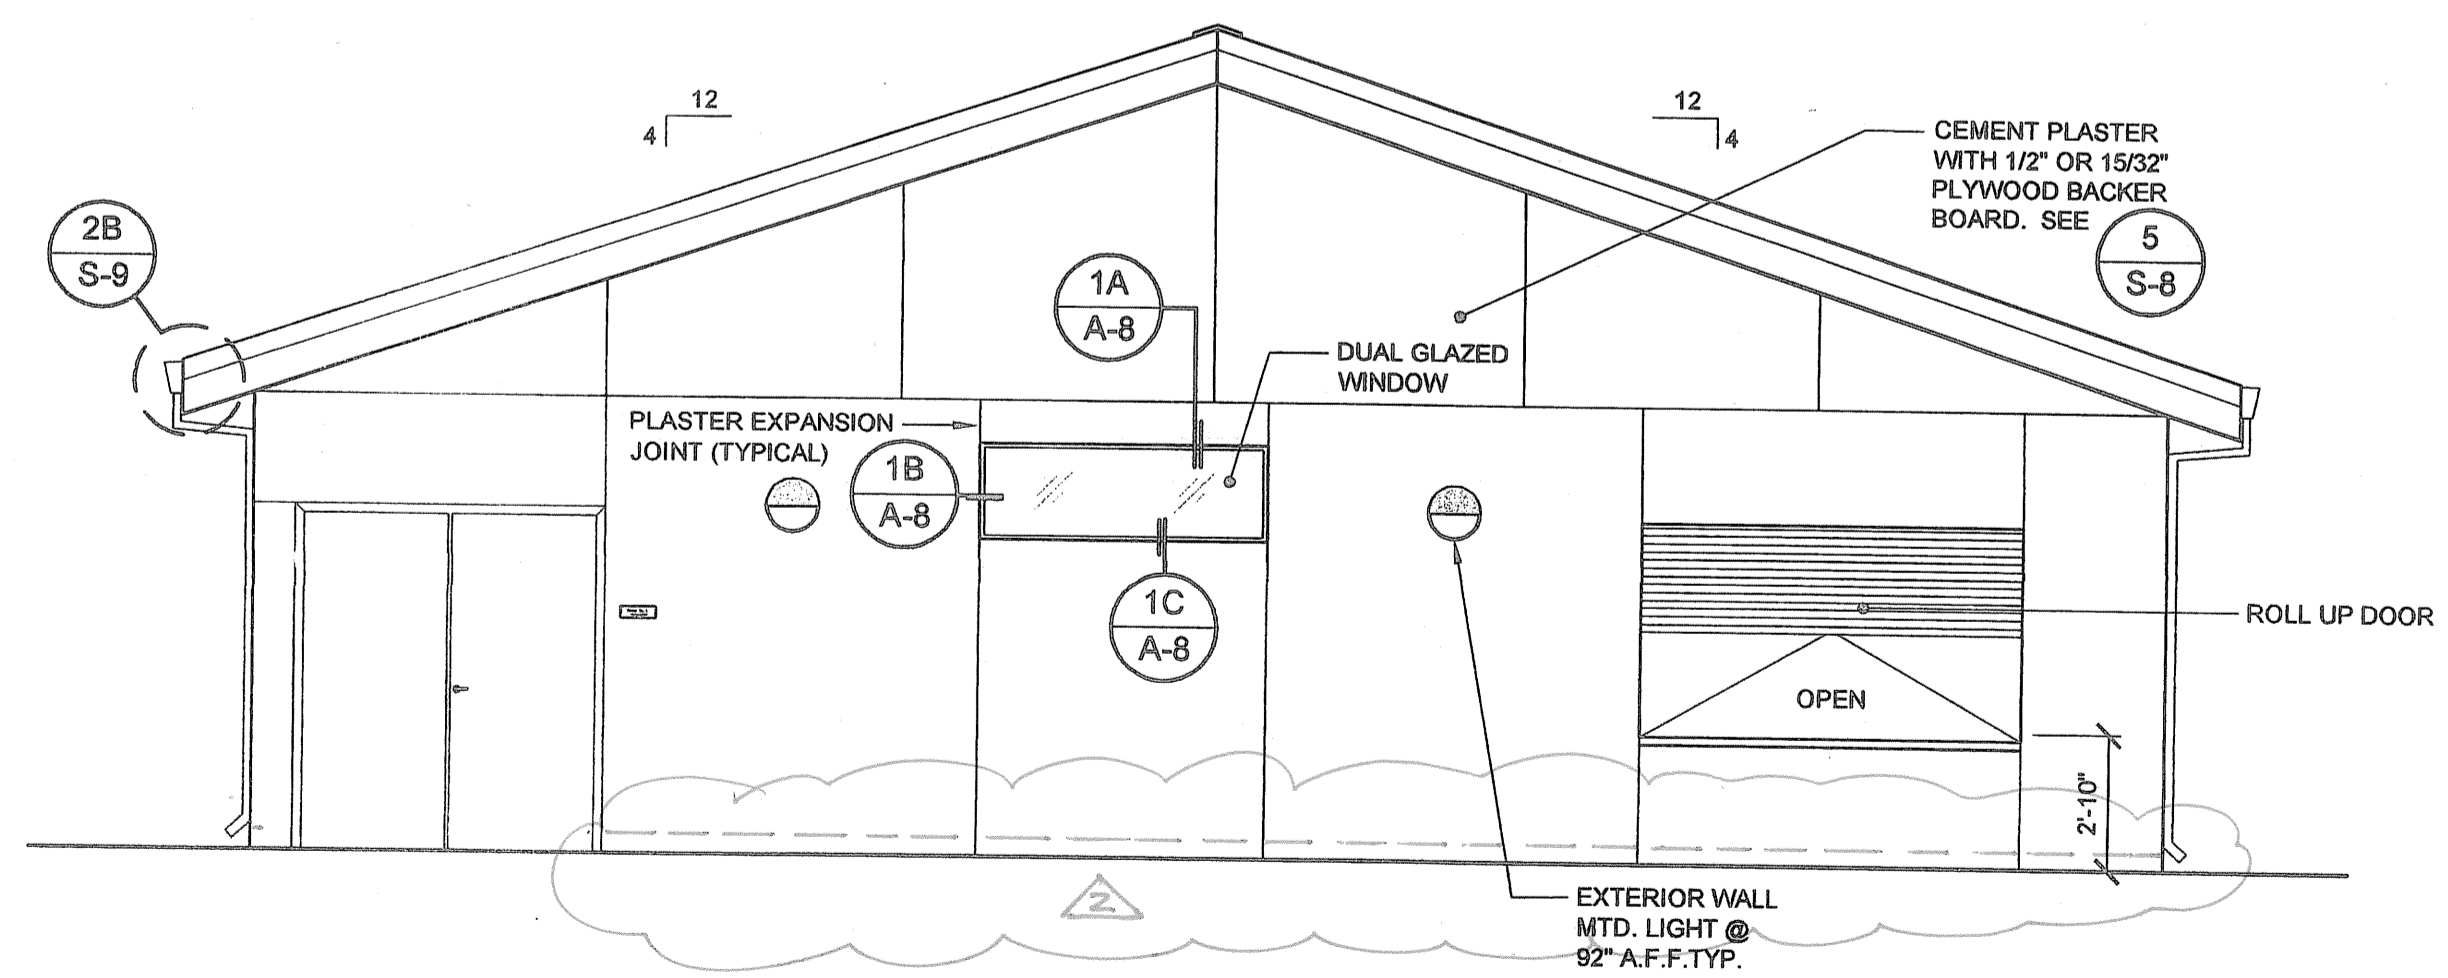

4 WEST EXTERIOR ELEVATION TEAM ROOM
SCALE: 1/4" = 1'-0"

▲ ADDED DRINKING FOUNTAINS W/ PROTECTION RAILS
▲ DASHED LINE INDICATES WEEP @ 2" A.F.F.

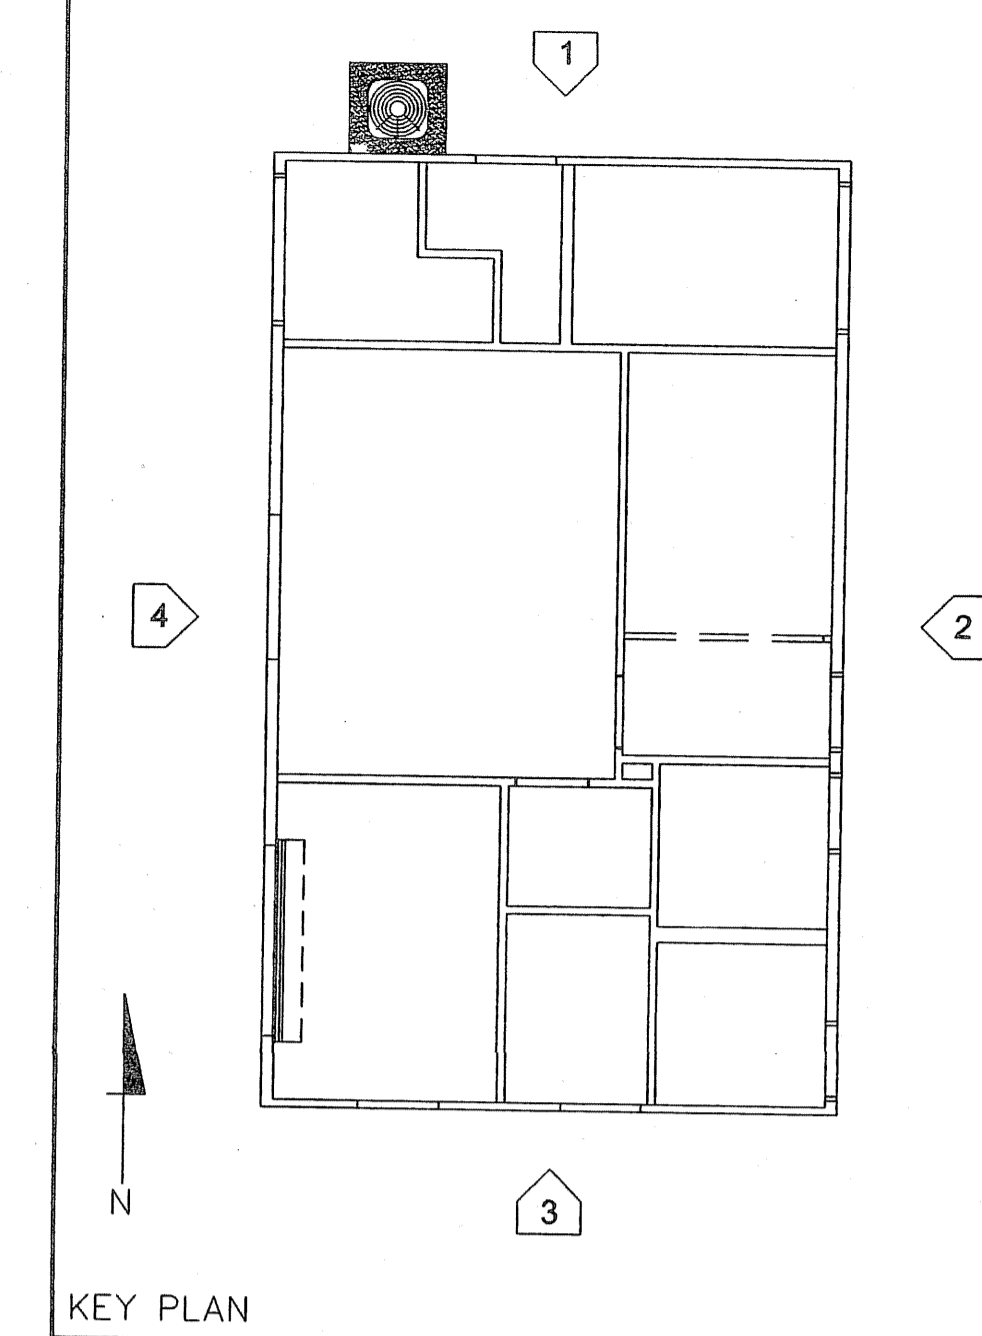

REVISIONS	
1	
2	
3	
4	
5	
6	


COPYRIGHT © 2003
SARAMARK, INCORPORATED
THESE PLAN DRAWINGS ARE PROPRIETARY DOCUMENTS OF SARAMARK, INCORPORATED & ARE NOT TO BE DISTRIBUTED, PUBLISHED OR REPRODUCED WITHOUT THE WRITTEN CONSENT OF SARAMARK INCORPORATED.

EC CONSULTING GROUP
1250 AVIATION AVE
SUITE 200-P
SAN JOSE, CA 95131
TEL: (408) 254-3513

COLLEGE of SAN MATEO
SAN MATEO UNIFIED SCHOOL DISTRICT

SARAMARK INCORPORATED
SERIES
4024AX
PC 01-108106
P.O. BOX 24369
SAN JOSE, CALIFORNIA 95154
TEL: (408) 671-3851
FAX: (408) 971-3534

BUILDING A TEAM ROOM EXTERIOR ELEVATIONS

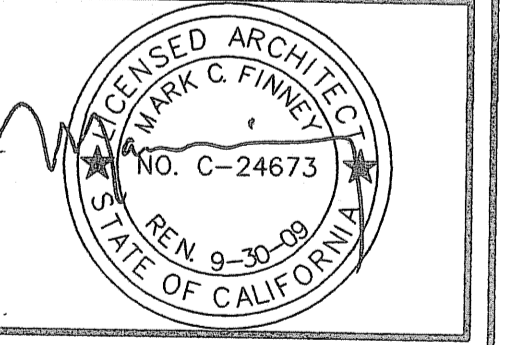

IDENTIFICATION STAMP
DIV. OF THE STATE ARCHITECT
OFFICE OF REGULATION SERVICES
01-108848
AC: [Signature] FLS: [Signature] SS: [Signature]
DATE: OCT 10 2007

DRAWN: [Signature]
DATE: 4.11.07
CHECKED: FAV
SCALE: 1/4" = 1'-0"
PROJECT: 1615

A-A-1a
PC 01-108106