




PANEL 1
SCALE: 1/4" = 1'-0"

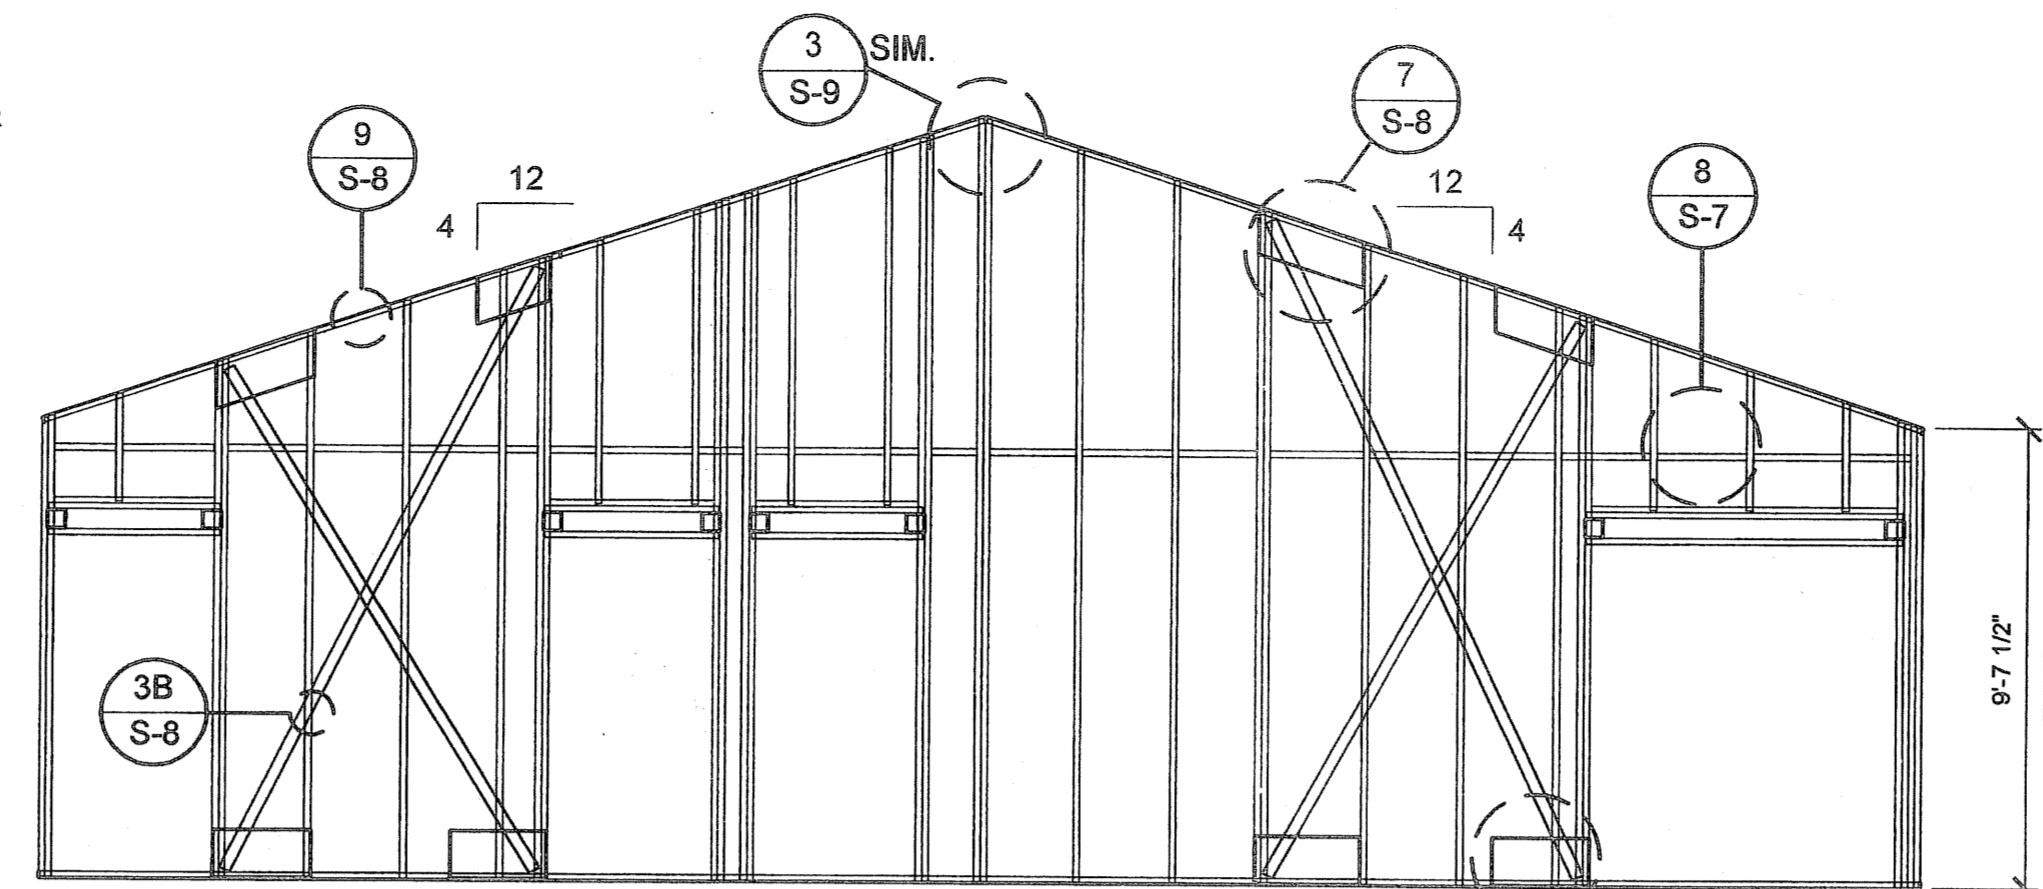


PANEL 2
SCALE: 1/4" = 1'-0"

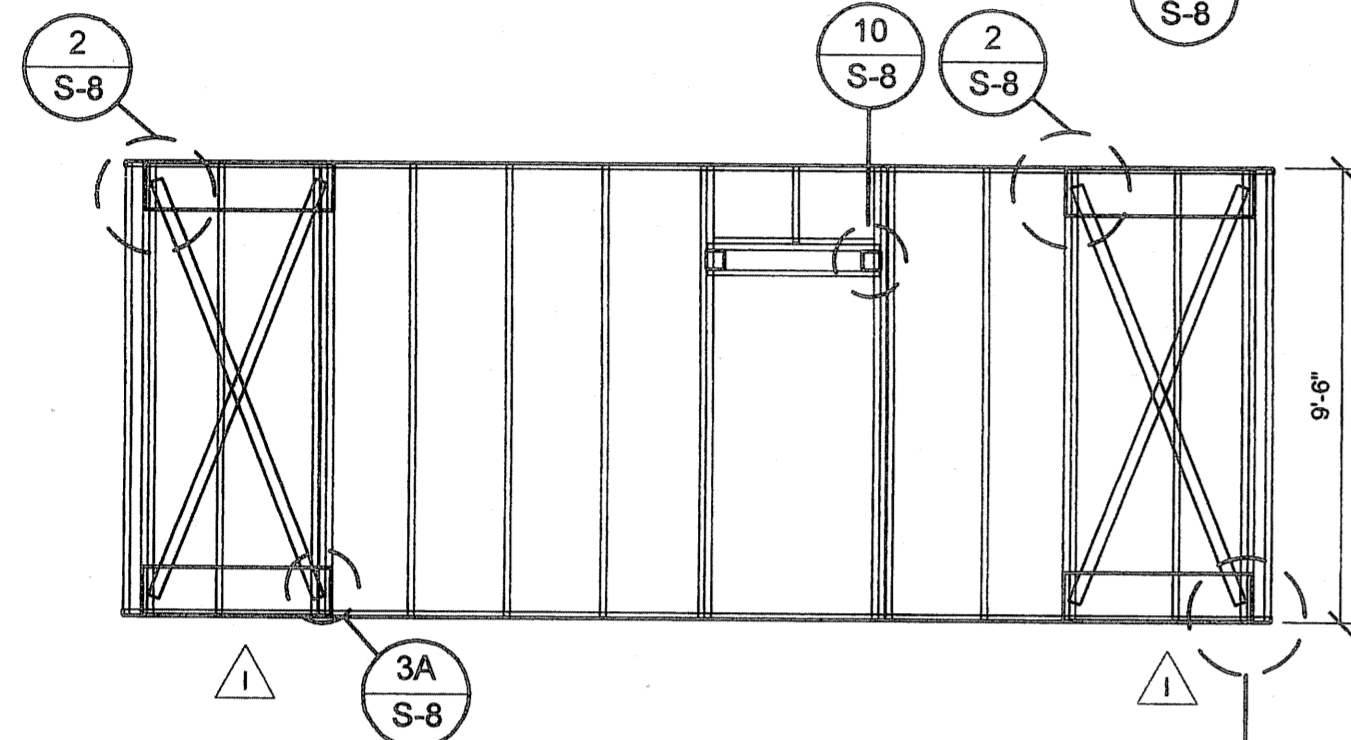


PANEL 3
SCALE: 1/4" = 1'-0"

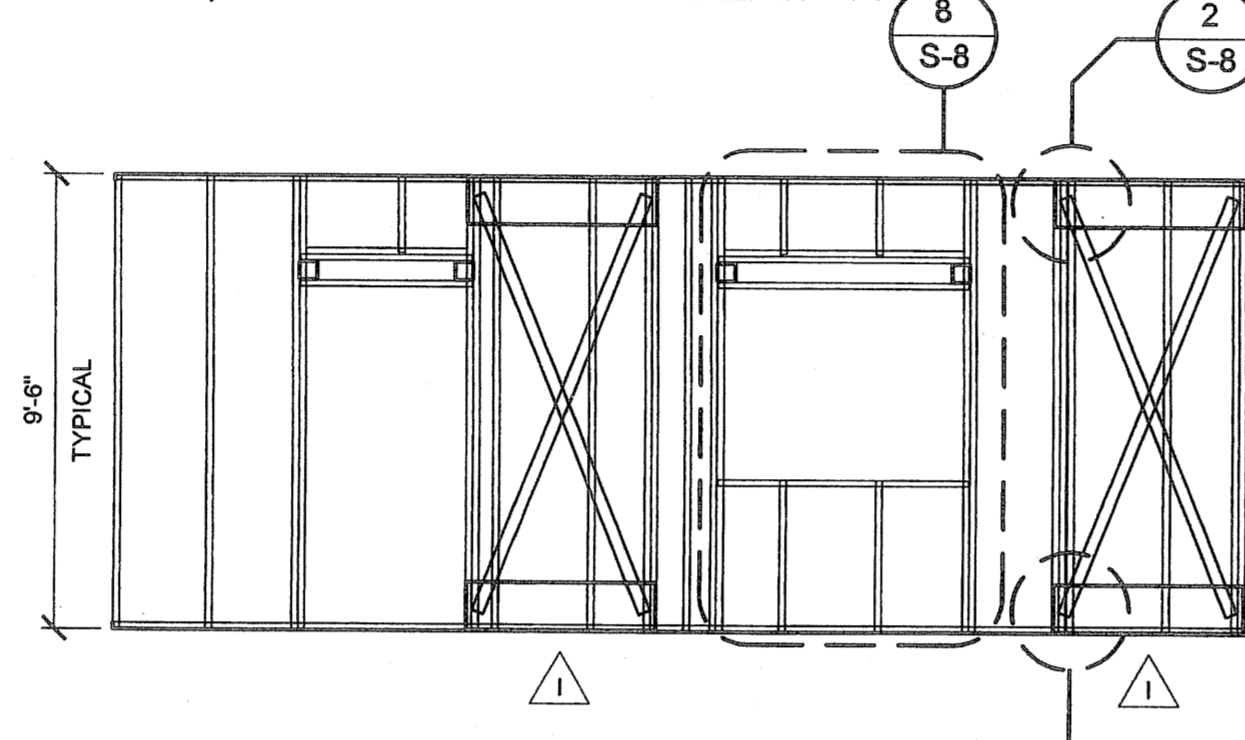


PANEL 4
SCALE: 1/4" = 1'-0"

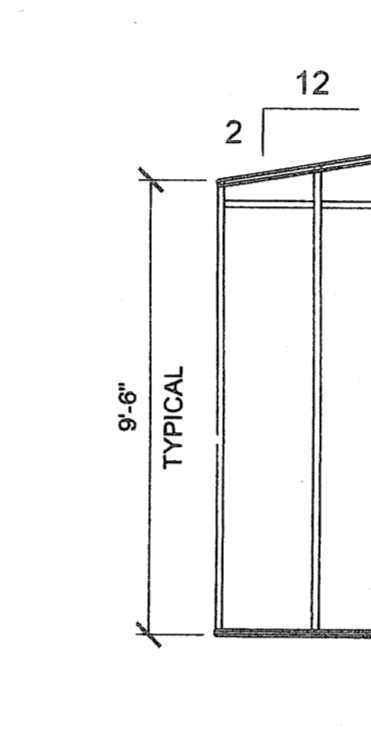


PANEL 5
SCALE: 1/4" = 1'-0"

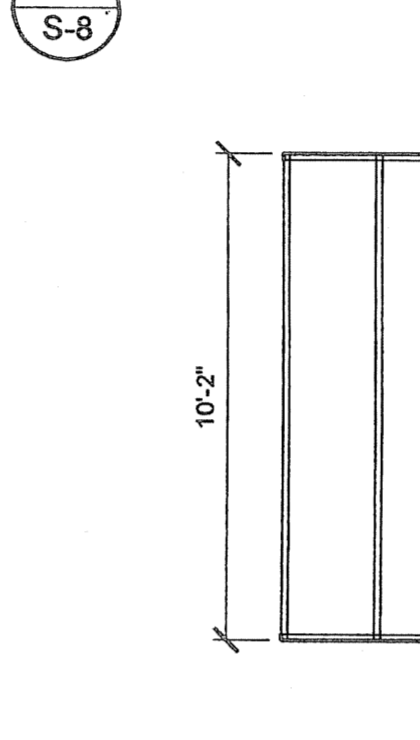


PANEL 6
SCALE: 1/4" = 1'-0"

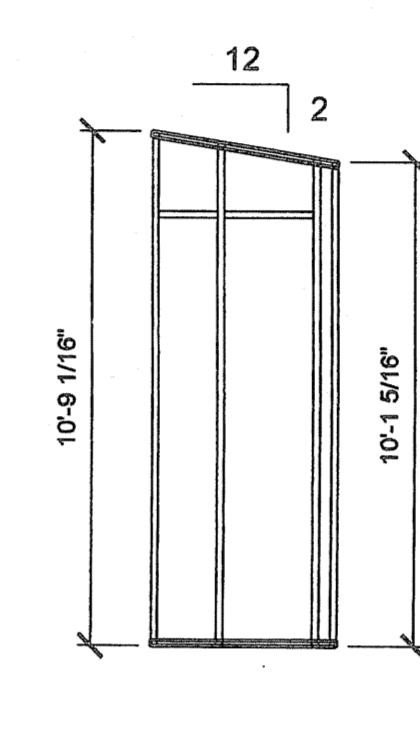


PANEL 7
SCALE: 1/4" = 1'-0"

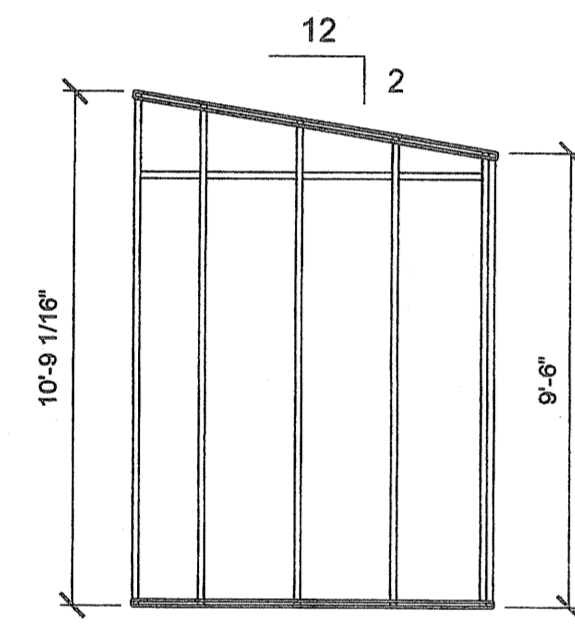


PANEL 8
SCALE: 1/4" = 1'-0"

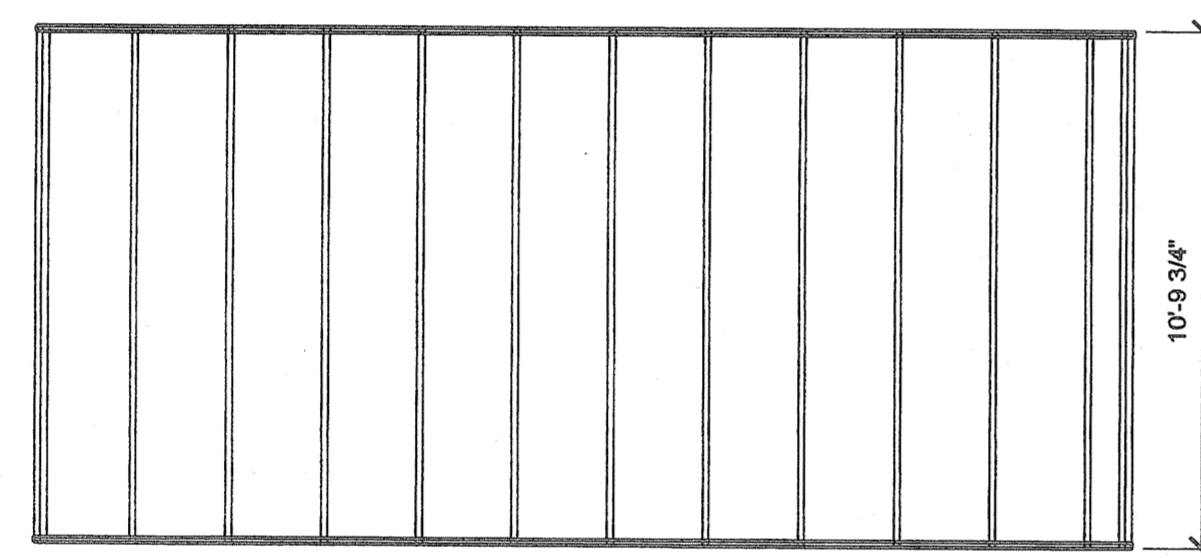


PANEL 9
SCALE: 1/4" = 1'-0"

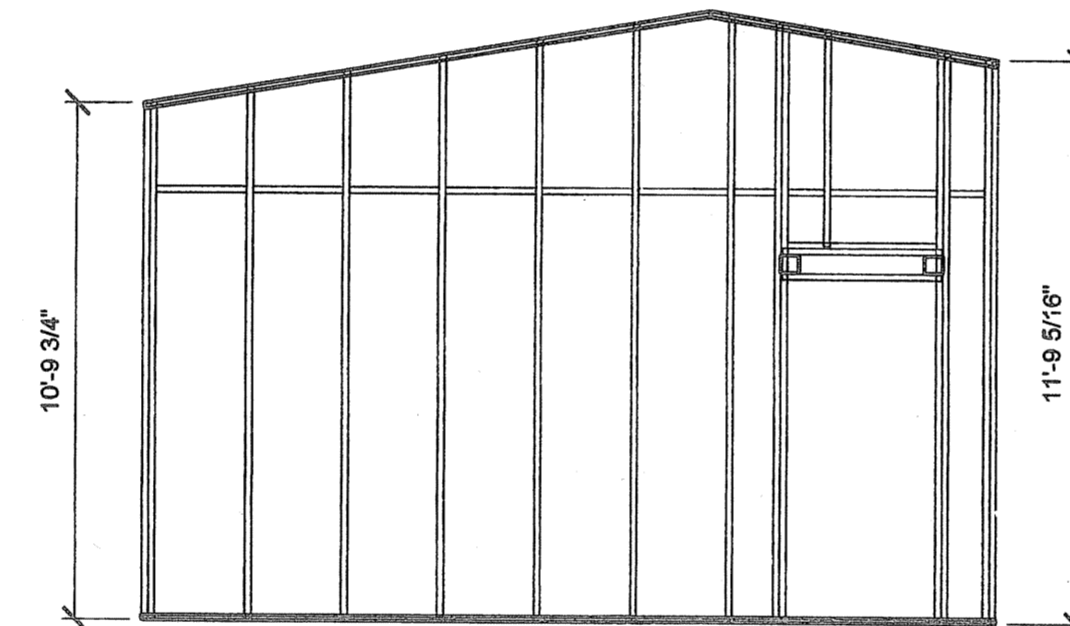


PANEL 10
SCALE: 1/4" = 1'-0"

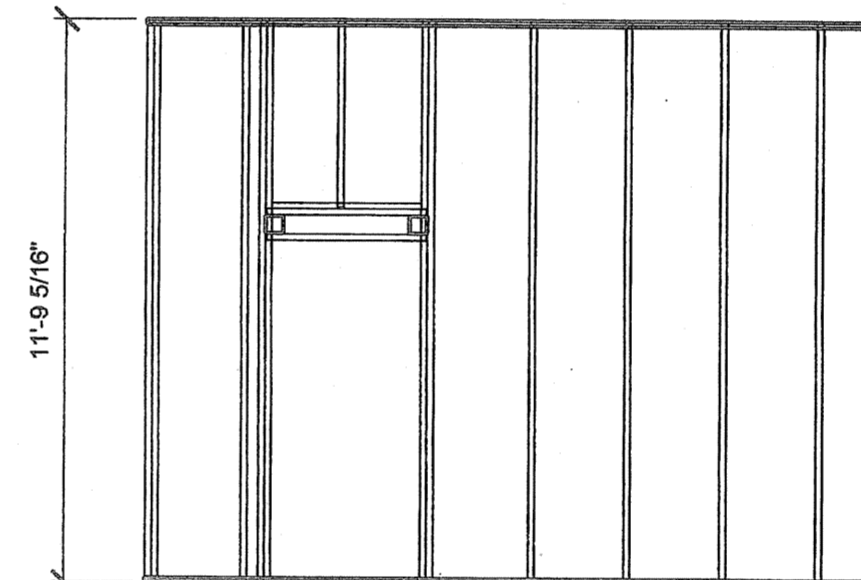


PANEL 11
SCALE: 1/4" = 1'-0"

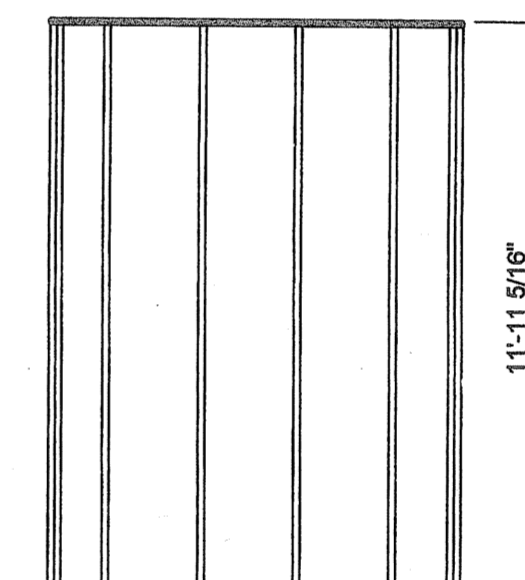


PANEL 12
SCALE: 1/4" = 1'-0"

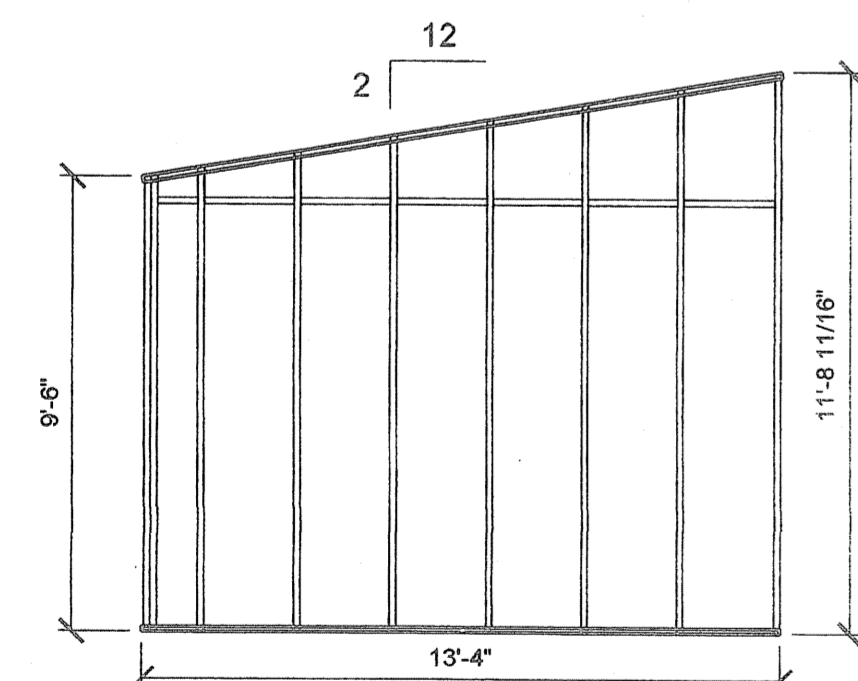


PANEL 13
SCALE: 1/4" = 1'-0"

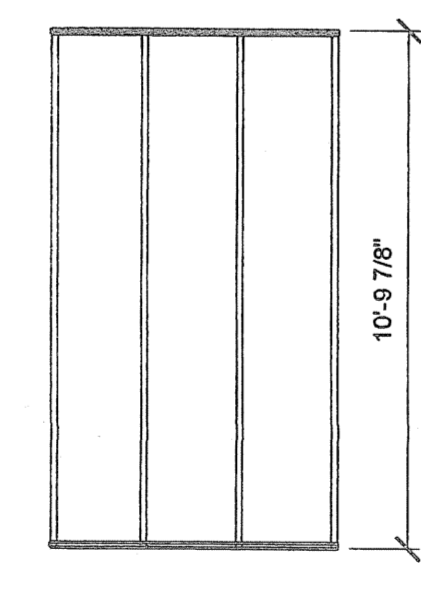


PANEL 14
SCALE: 1/4" = 1'-0"

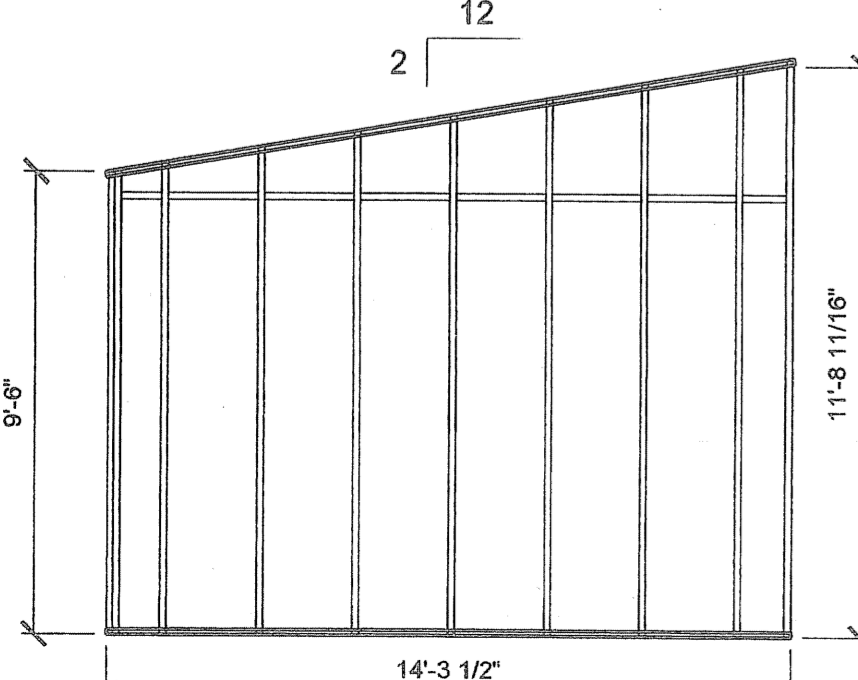

PANEL 15

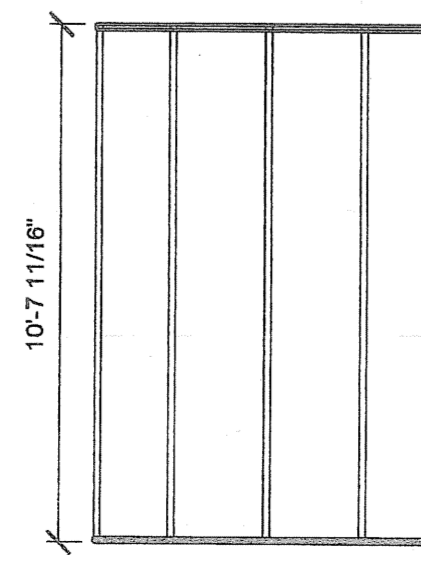

PANEL 16

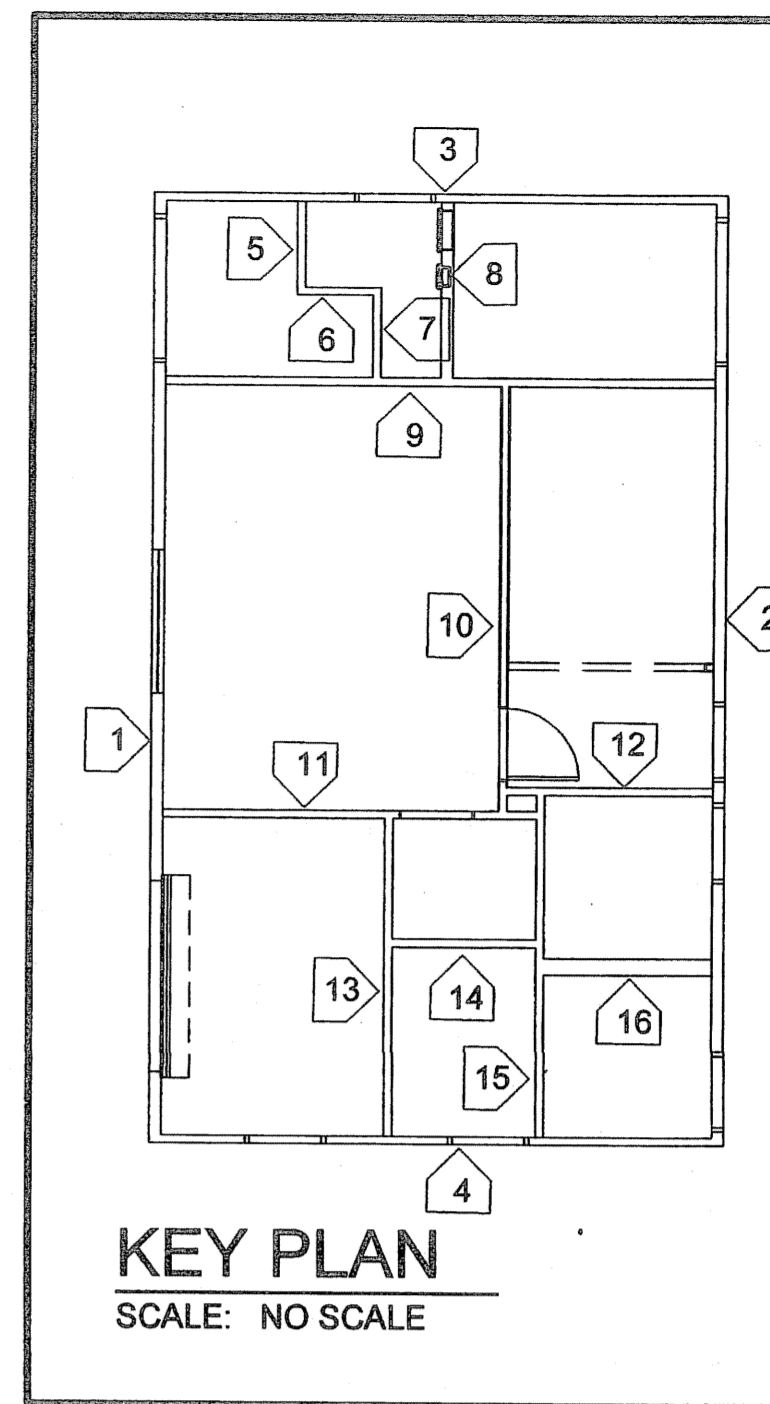

KEY PLAN
SCALE: NO SCALE

REVISIONS	
1	
2	
3	
4	
5	
6	

COPYRIGHT © 2003
SARAMARK, INCORPORATED
THESE PLAN DRAWINGS ARE
PROPRIETARY DOCUMENTS
OF SARAMARK, INCORPORATED
& ARE NOT TO BE DISTRIBUTED
& REPRODUCED WITHOUT THE WRITTEN
CONSENT OF SARAMARK
INCORPORATED.

**EC
CONSULTING
GROUP**

1250 AVIATION AVE
SUITE 200-2
SAN JOSE, CA 95110
TEL: (408) 294-8910
FAX: (408) 294-8910

**COLLEGE
of
SAN MATEO**

SAN MATEO
UNIFIED SCHOOL
DISTRICT

**SARAMARK
INCORPORATED**
SERIES

4024AX

P.O. BOX 24389
SAN JOSE, CALIFORNIA 95154
TEL: (408) 971-3881
FAX: (408) 971-3534

**BUILDING A
TEAM ROOM
WALL FRAMING
PLAN**



IDENTIFICATION STAMP
DIV. OF THE STATE ARCHITECT
OFFICE OF REGULATION SERVICES

01-108848
ACJC FL. SS
DATE OCT 10 2007

DRAWN:
DATE: 4.11.07
CHECKED: FAV
SCALE: 1/4" = 1'-0"
PROJECT: 1615

A-S-1.1

SPECIES	PANEL															
	1	2	3	4	5	6	7	8	9	10	11	12	13	14	15	16
TOP TRACK	600WT14	600WT14	400WT14	400WT14	400WT14	400WT14	400WT14	600WT14	400WT14	400WT14	400WT14	400WT14	400WT14	400WT14	400WT14	800WT14
BOTTOM TRACK	600WT14	600WT14	400WT14	400WT14	400WT14	400WT14	400WT14	600WT14	400WT14	400WT14	400WT14	400WT14	400WT14	400WT14	400WT14	800WT14
STUDS 24" O.C. TYP	800XC18	800XC18	400XC18	400XC18	400XC18	400XC18	400XC18	800XC18	400XC18	400XC18	400XC18	400XC18	400XC18	400XC18	400XC18	800XC18
DBL STUD @ HLD	(2)800XC14	(2)800XC14	(2)400XC18	(2)400XC18	N/A	N/A	N/A	N/A	N/A	N/A	N/A	N/A	N/A	N/A	N/A	N/A
KING STUDS	(2)800XC18	(2)800XC18	(2)400XC18	(2)400XC18	N/A	N/A	N/A	N/A	N/A	(2)400XC18	(2)400XC18	N/A	N/A	N/A	N/A	N/A
* HEADERS	(2)800WJ18	(2)800WJ18	(2)800EJ18	(2)800EJ18	N/A	N/A	N/A	N/A	N/A	(2)800EJ18	(2)800EJ18	N/A	N/A	N/A	N/A	N/A
* HEADER WRAP	(2)800WT18	(2)800WT18	(2)400WT18	(2)400WT18	N/A	N/A	N/A	N/A	N/A	(2)400WT18	(2)400WT18	N/A	N/A	N/A	N/A	N/A
* CRIPPLE SEAT	600WT18	600WT18	400WT18	400WT18	N/A	N/A	N/A	N/A	N/A	400WT18	400WT18	N/A	N/A	N/A	N/A	N/A
CRIPPLES	600XC18	600XC18	400XC18	400XC18	N/A	N/A	N/A	N/A	N/A	400XC18	400XC18	N/A	N/A	N/A	N/A	N/A
SILLS	600WT18	N/A	N/A	400WT18	N/A	N/A	N/A	N/A	N/A	N/A	N/A	N/A	N/A	N/A	N/A	N/A
RAKE SILLS	N/A	N/A	N/A	N/A	N/A	N/A	N/A	N/A	N/A	N/A	N/A	N/A	N/A	N/A	N/A	N/A
JAMB COVERS	600WT18	600WT18	400WT18	400WT18	N/A	N/A	N/A	N/A	N/A	400WT18	400WT18	N/A	N/A	N/A	N/A	N/A
BLOCKING	600XC18	600XC18	N/A	N/A	400XC18	N/A	400XC18	600XC18	N/A	400XC18	N/A	400XC18	N/A	N/A	400XC18	N/A
** GUSSETS	20"x 16GA.	20"x 16GA.	14"x 16GA.	14"x 16GA.	N/A	N/A	N/A	N/A	N/A	N/A	N/A	N/A	N/A	N/A	N/A	N/A
** "X" BRACING	3"x 16GA.	3"x 16GA.	3"x 16GA.	3"x 16GA.	N/A	N/A	N/A	N/A	N/A	N/A	N/A	N/A	N/A	N/A	N/A	N/A

NOTE
INSPECTOR OF RECORD TO VERIFY STRAPPING TENSION AT
TIME OF INSTALLATION