

GENERAL NOTE:

1. NO PLYWOOD WILL BE RIPPED LESS THAN 2'-0" WIDE.

ROOF FRAMING PLAN

SCALE: 1/4" = 1'-0"

REVISIONS

COPYRIGHT © 2003
SARAMARK, INCORPORATED
THESE PLAN DRAWINGS ARE PROPRIETARY DOCUMENTS OF SARAMARK, INCORPORATED & ARE NOT TO BE DISTRIBUTED, PUBLISHED OR REPRODUCED WITHOUT THE WRITTEN CONSENT OF SARAMARK INCORPORATED.

EC CONSULTING GROUP

1250 AVIATION AVE
SUITE 200-F
SAN JOSE, CA 95110
TEL: (408) 294-8513

COLLEGE of SAN MATEO


SAN MATEO UNIFIED SCHOOL DISTRICT

SARAMARK INCORPORATED

SERIES 4024AX
PC 01-105108

P.O. BOX 24399
SAN JOSE, CALIFORNIA 95114
TEL: (408) 971-3881
FAX: (408) 971-3834

BUILDING A TEAM ROOM ROOF FRAMING PLAN

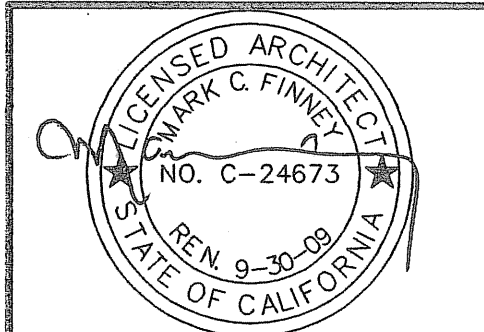

IDENTIFICATION STAMP
DIV. OF THE STATE ARCHITECT
OFFICE OF REGULATION SERVICES

01-108848
AG. J. FLS. L. SS.
DATE 11/14/2007

DRAWN: [Signature]
DATE: 4.11.07
CHECKED: FAV
SCALE: AS SHOWN
PROJECT: 1615

A-S-1.2