




ELECTRICAL SITE PLAN - BUILDING A
 SCALE: 1" = 5'-0"

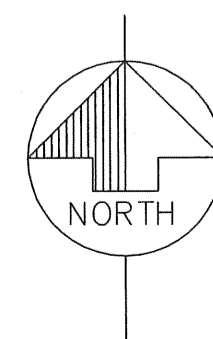

REVISIONS		
FIELD ORDER #3		
1	JC	10.31.07
2		
3		
4		
5		

COPYRIGHT © 2007
 SARAFARK, INCORPORATED
 THESE PLAN DRAWINGS ARE
 PROPRIETARY DOCUMENTS
 OF SARAFARK, INCORPORATED
 & ARE NOT TO BE DISTRIBUTED,
 PUBLISHED OR REPRODUCED
 WITHOUT THE WRITTEN
 CONSENT OF SARAFARK
 INCORPORATED.

**EC
 CONSULTING
 GROUP**

1250 AVIATION AVE
 SUITE 200-F
 SAN JOSE, CA 95110
 TEL: (408) 264-6313

**COLLEGE
 of
 SAN MATEO**

SAN MATEO
 UNIFIED SCHOOL
 DISTRICT


**BRUNS
 BELMONT
 CONSTRUCTION**

SERIES
 4024AX

P.O. BOX 812707
 SAN JOSE, CALIFORNIA 95181
 TEL: (408) 971-1708
 FAX: (408) 971-3534

**BUILDING 'A'
 TEAM ROOM**

**UNDERSLAB
 SHOP
 DRAWINGS**

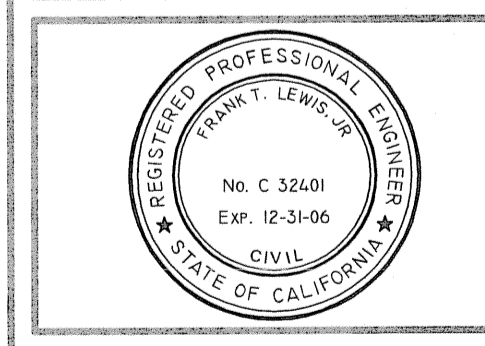

DRAWN: JC
 DATE: 10.31.07
 CHECKED: FAV/FTL
 SCALE: AS SHOWN
 PROJECT: 1615

SHEET 1
**ELECTRICAL
 SITE PLAN**
 F.O. #1

R:\drawings\PROJECTS\OPEN PROJECTS\San Mateo Community College\Drawing Set\FIELD ORDERS\Field Order #3 - Site Electrical Conduit Layout.dwg, 2/28/2008 2:53:31 PM, 6050 - Bona-24.p3

AS-BUILTS