

REVISIONS		
FIELD ORDER #1		
△	JC	11.6.07
△		
△		
△		
△		

COPYRIGHT © 2007  
 SARAMARK, INCORPORATED  
 THESE PLAN DRAWINGS ARE  
 PROPRIETARY DOCUMENTS  
 OF SARAMARK, INCORPORATED  
 & ARE NOT TO BE DISTRIBUTED,  
 PUBLISHED OR REPRODUCED  
 WITHOUT THE WRITTEN  
 CONSENT OF SARAMARK  
 INCORPORATED.

**EC CONSULTING GROUP**

1250 AVIATION AVE  
 SUITE 200-4  
 SAN JOSE, CA 95110  
 TEL: (408) 294-5313

**COLLEGE of SAN MATEO**

SAN MATEO UNIFIED SCHOOL DISTRICT

**BRUNS BELMONT CONSTRUCTION**

SERIES 4024AX

P.O. BOX 612707  
 SAN JOSE, CALIFORNIA 95161  
 TEL: (408) 971-1708  
 FAX: (408) 971-3534


**BUILDING 'A' TEAM ROOM**

**UNDERSLAB SHOP DRAWINGS**



DRAWN: JC  
 DATE: 11.6.07  
 CHECKED: FAV/FTL  
 SCALE: AS SHOWN  
 PROJECT: 1615


**SHEET 1a**  
 CENTERLINE PULL PLAN  
 FIXTURES, WALLS  
 & PANELS  
 F.O. #1

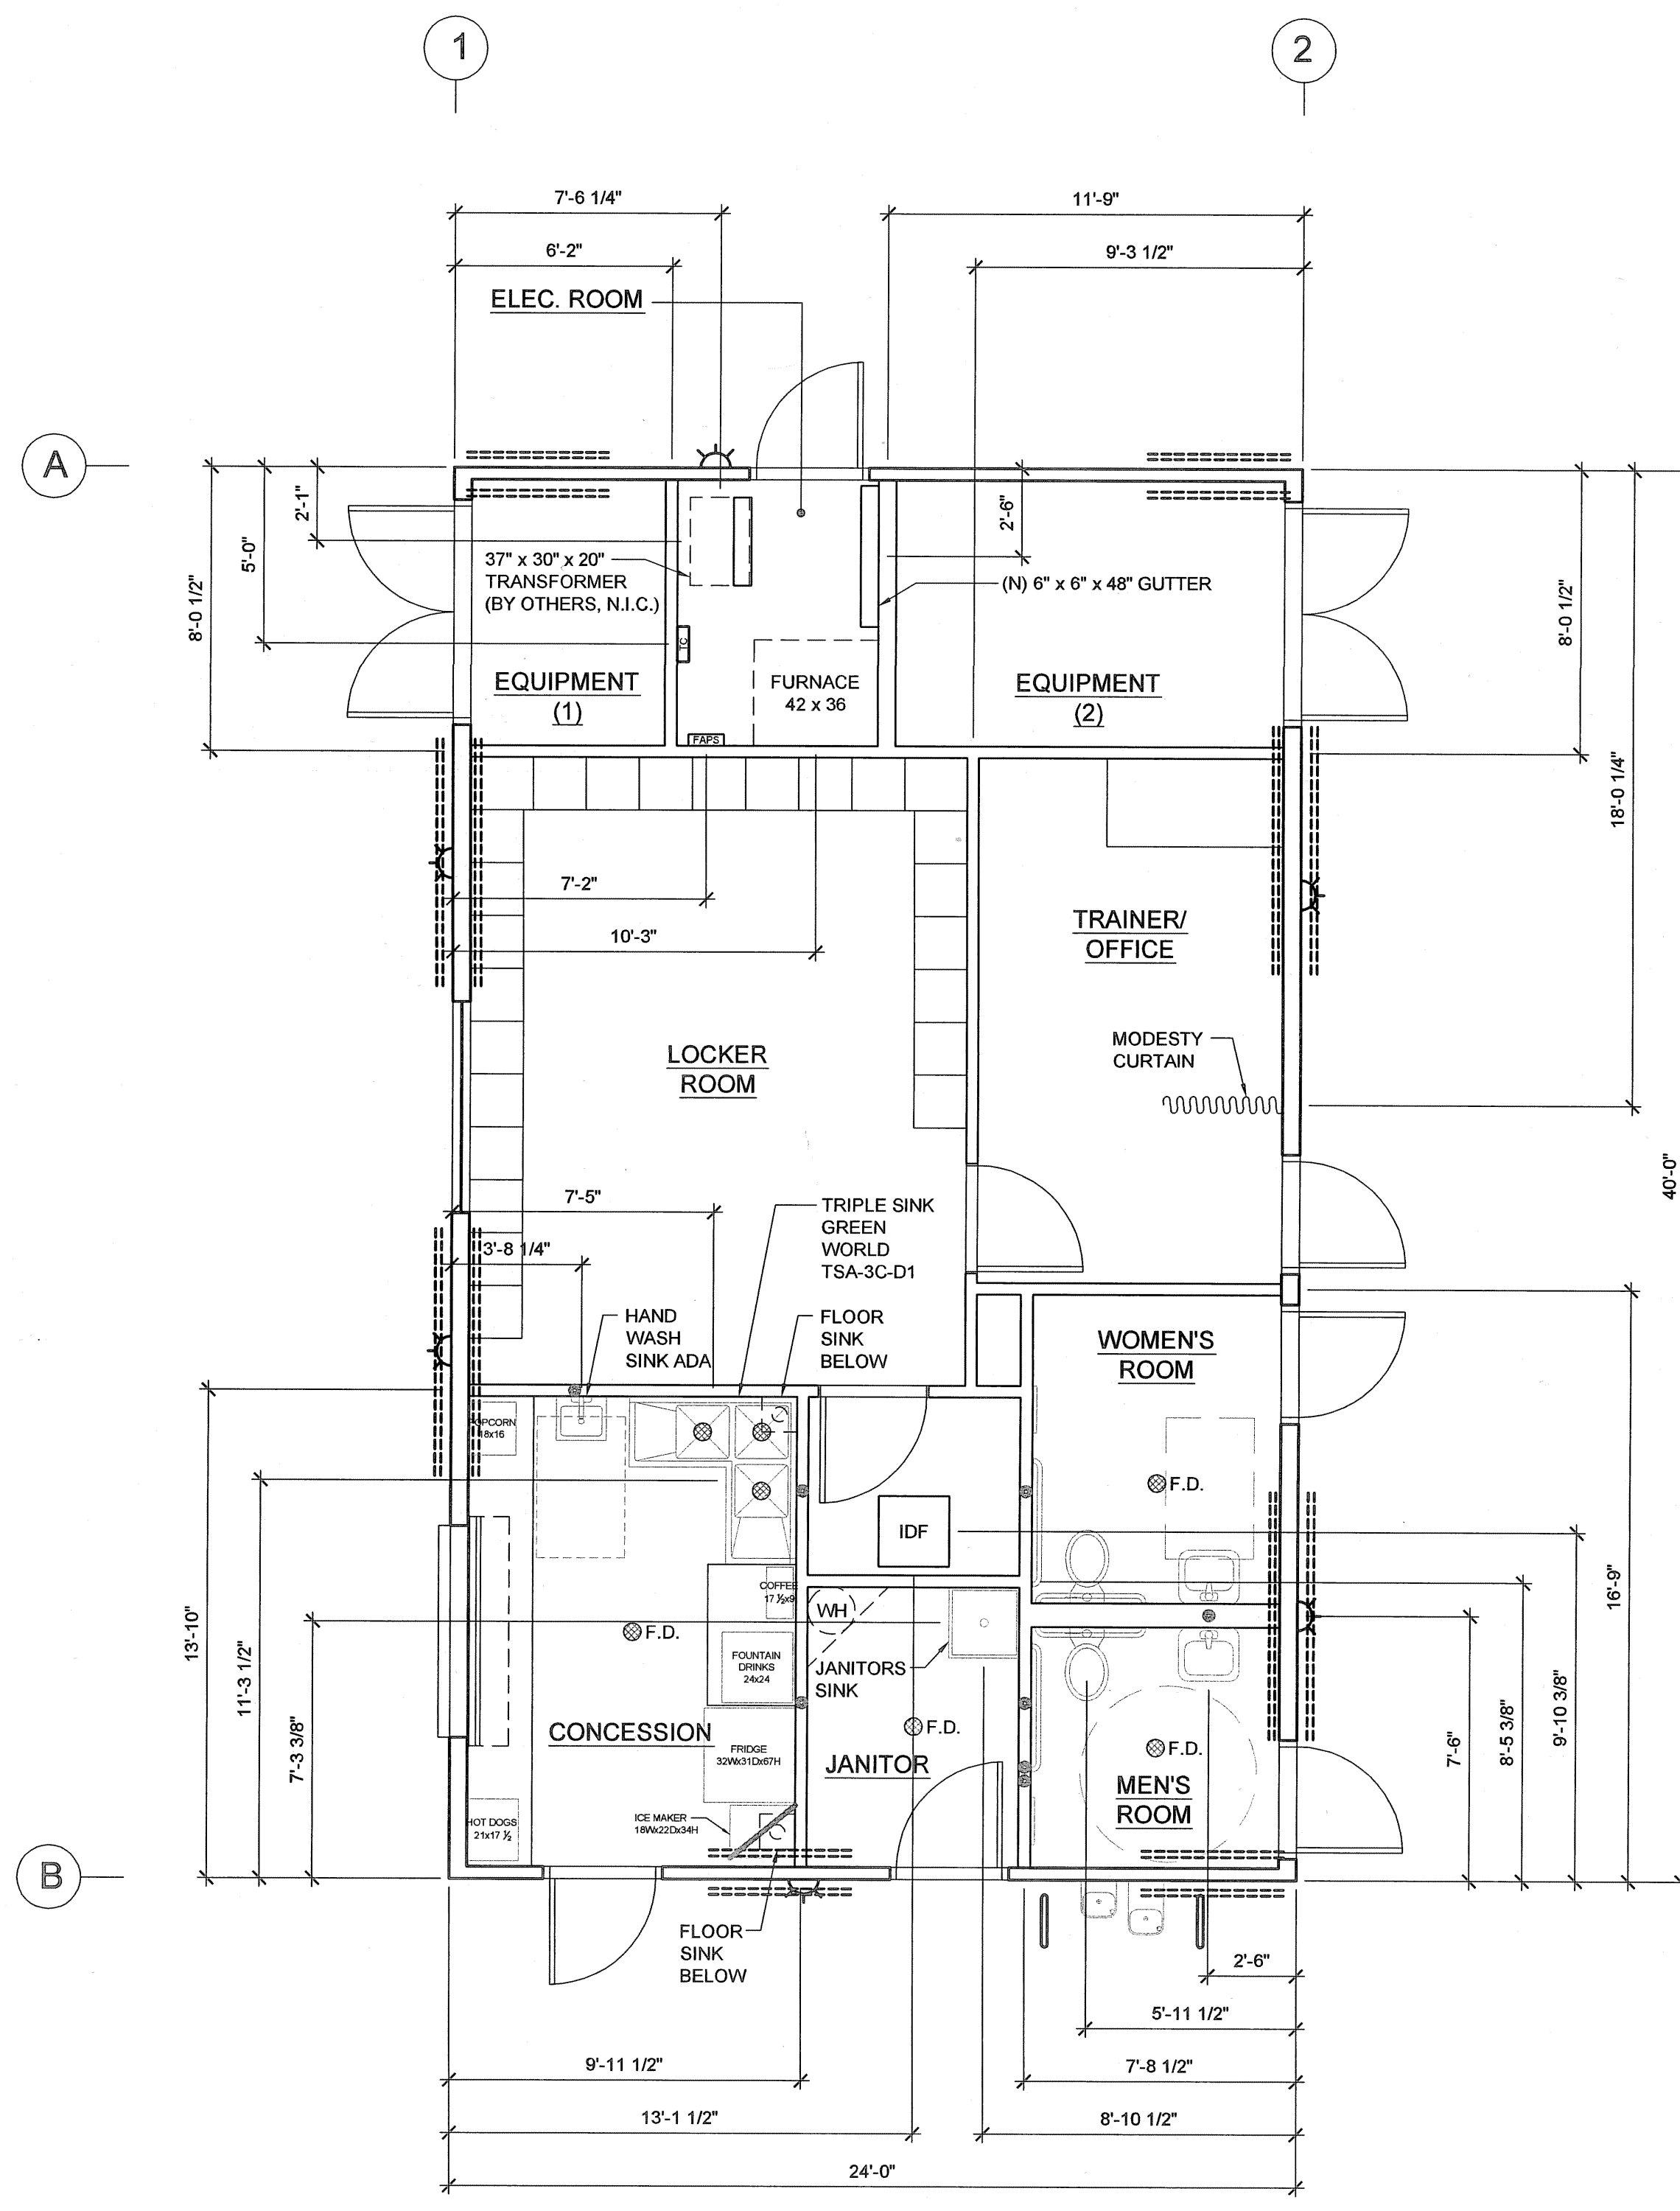

**LEGEND**

- (N) 6" x 6" x 48" GUTTER
- TC - TIMECLOCK FOR RELAY EXTERIOR LIGHTS
- IDF CABINET (DATA/TV)
- TRANSFORMER (BY OTHERS NIC)
- FIRE ALARM POWER SUPPLY
- F.D. FLOOR DRAIN (F.D.)
- FLOOR SINK
- JANITOR'S SINK
- WH WATER HEATER
- PLUMBING PIPE IN WALL
- C.O. CLEAN-OUT

**CENTERLINE PULL PLAN -  
 FIXTURES, WALLS AND PANELS - BUILDING A**  
 SCALE: 1/4" = 1'-0"

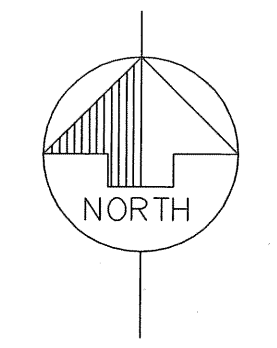

**NOTE:**  
 NO ENLARGEMENT PLAN IS  
 PROVIDED FOR THIS BUILDING.