
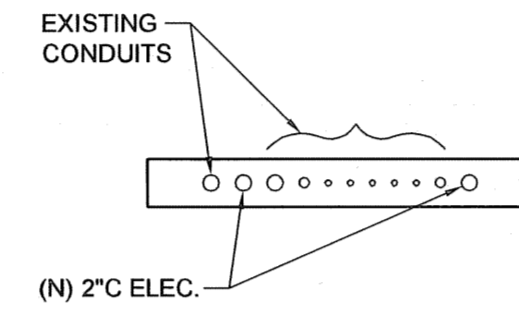


R:\drawings\PROJECTS\OPEN PROJECTS\San Mateo Community College\Drawing Set\FIELD ORDERS\Field Order #1 - Underslab1.rvt - Underslab1.rvt - Bldg A Underslab & Trenching.dwg, 2/26/2008 3:29:29 PM, 6050 - Bond-24.pc3

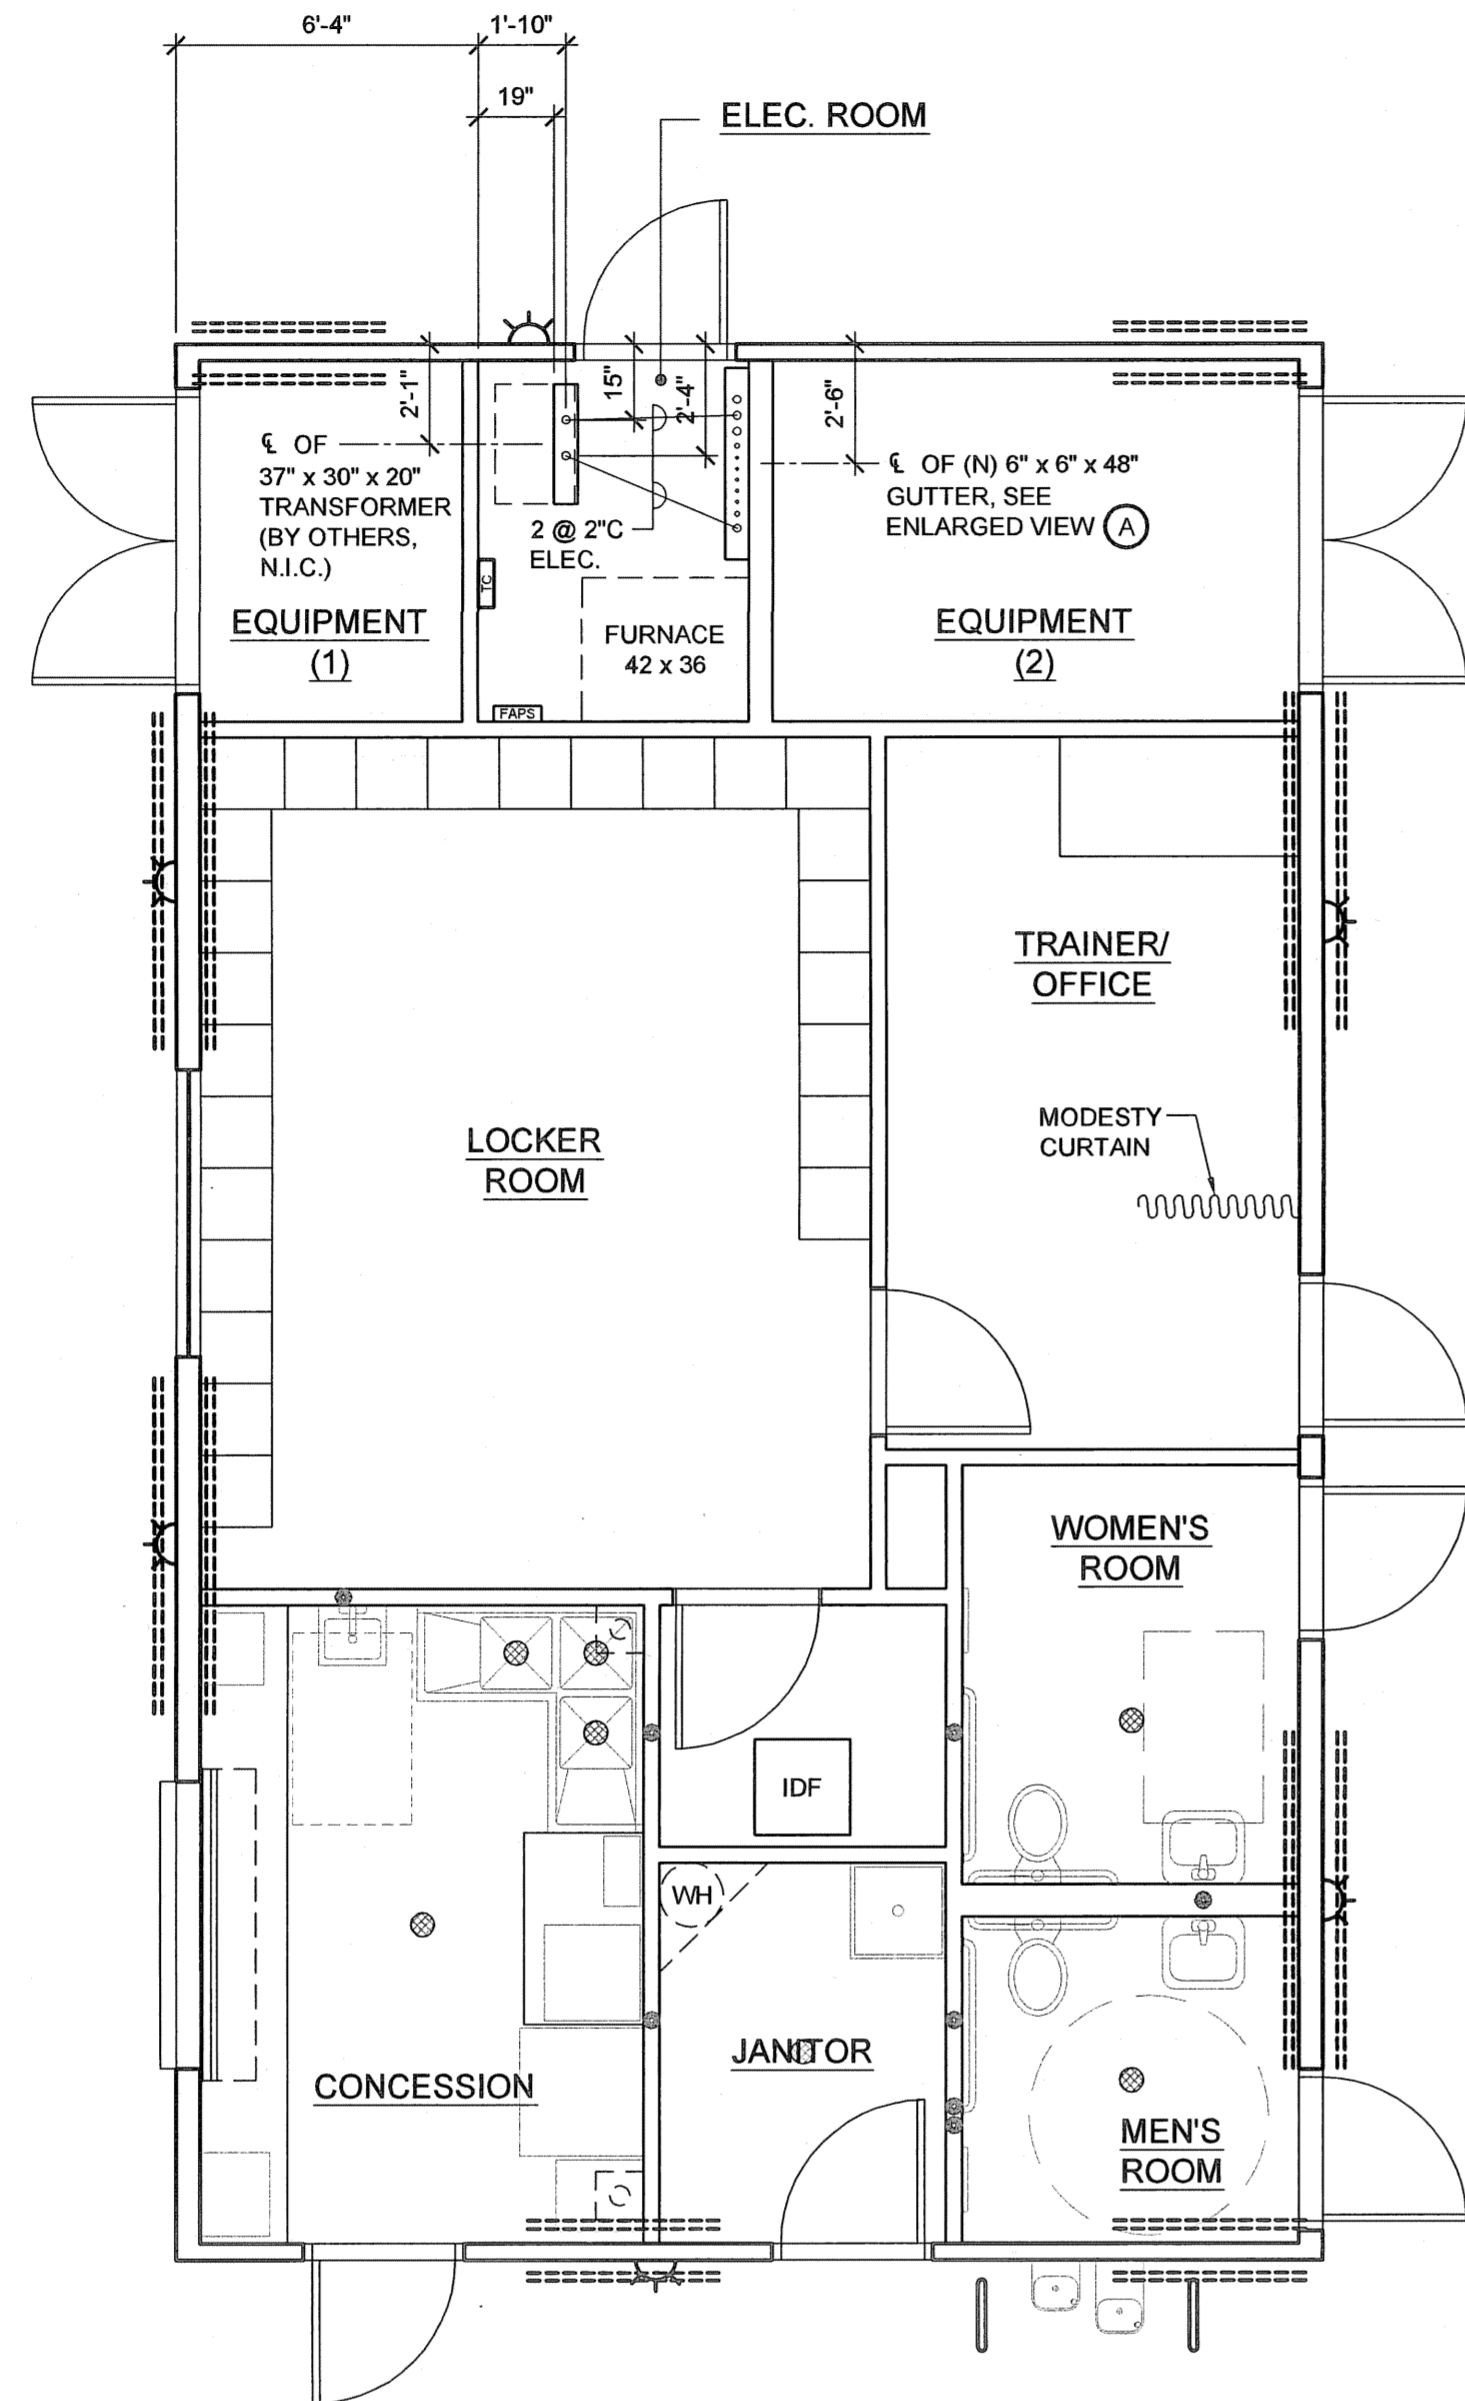

ENLARGED VIEW - GUTTER & CONDUIT
SCALE: 1/2" = 1'-0" (A)

LEGEND

- (RED) ——— 2" ELECTRIC
- (N) 6" x 6" x 48" GUTTER
- TC - TIMECLOCK FOR RELAY EXTERIOR LIGHTS
- IDF IDF CABINET (DATA/TV)
- TRANSFORMER (BY OTHERS NIC)
- FIRE ALARM POWER SUPPLY
- 13" ROUND WALL MOUNTED EXTERIOR FLUORESCENT LIGHT FIXTURE, MOUNTED @ 92" TO CENTER A.F.F. MOUNTING DETAIL PER MANUFACTURER'S RECOMMENDATION
- PLUMBING PIPE IN WALL

ELECTRICAL & LOW VOLTAGE UNDERSLAB CONDUITS - BUILDING A
SCALE: 1/4" = 1'-0"



REVISIONS		
FIELD ORDER #1		
1	JC	11.6.07
2		
3		
4		
5		

COPYRIGHT © 2007
SARAMARK, INCORPORATED
THESE PLAN DRAWINGS ARE
PROPRIETARY DOCUMENTS
OF SARAMARK, INCORPORATED
& ARE NOT TO BE DISTRIBUTED,
PUBLISHED OR REPRODUCED
WITHOUT THE WRITTEN
CONSENT OF SARAMARK
INCORPORATED.

EC CONSULTING GROUP

1280 AVIATION AVE
SUITE 200-F
SAN JOSE, CA 95110
TEL: (408) 254-8319

COLLEGE of SAN MATEO

SAN MATEO UNIFIED SCHOOL DISTRICT

BRUNS BELMONT CONSTRUCTION

SERIES 4024AX

P.O. BOX 812707
SAN JOSE, CALIFORNIA 95181
TEL: (408) 971-1708
FAX: (408) 971-3534

BUILDING 'A' TEAM ROOM

UNDERSLAB SHOP DRAWINGS



DRAWN: JC
DATE: 11.6.07
CHECKED: FAV/FTL
SCALE: AS SHOWN
PROJECT: 1615

NOTE:
NO ENLARGEMENT PLAN IS PROVIDED FOR THIS BUILDING.

SHEET 1b
ELECTRICAL & LOW VOLTAGE UNDERSLAB CONDUITS
F.O. #1