


- ① REFRIDGERATOR (NIC)
- ② POPCORN MACHINE (NIC)
- ③ ICE MAKER (NIC)
- ④ FOUNTAIN DRINK MACHINE (NIC)
- ⑤ HOT DOG MACHINE (NIC)
- ⑥ COFFEE MAKER (NIC)

CENTERLINE PULL PLAN - FIXTURES, WALLS AND PANELS - BUILDING B
SCALE: 1/4" = 1'-0"

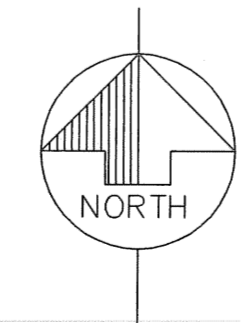

LEGEND:

- EP-B - ELECTRICAL PANEL
- TC - TIMECLOCK FOR RELAY EXTERIOR LIGHTS
- 13" ROUND WALL MOUNTED EXTERIOR FLUORESCENT LIGHT FIXTURE, MOUNTED @ 92" TO CENTER A.F.F. MOUNTING DETAIL PER MANUFACTURER'S RECOMMENDATION
- F.D. - FLOOR DRAIN (F.D.)
- FLOOR SINK
- PLUMBING PIPE IN WALL
- C.O. - CLEAN-OUT

REVISIONS		
FIELD ORDER #1		
	JC	11.6.07

COPYRIGHT © 2007
SARAMARK, INCORPORATED
THESE PLAN DRAWINGS ARE PROPRIETARY DOCUMENTS OF SARAMARK, INCORPORATED & ARE NOT TO BE DISTRIBUTED, PUBLISHED OR REPRODUCED WITHOUT THE WRITTEN CONSENT OF SARAMARK INCORPORATED.

EC CONSULTING GROUP

1250 AVIATION AVE
SUITE 200-F
SAN JOSE, CA 95110
TEL: (408) 284-8313

COLLEGE of SAN MATEO

SAN MATEO UNIFIED SCHOOL DISTRICT

BRUNS BELMONT CONSTRUCTION

SERIES NEW

P.O. BOX 812707
SAN JOSE, CALIFORNIA 95181
TEL: (408) 971-1708
FAX: (408) 971-3534

BUILDING 'B' HALL OF FAME

UNDERSLAB SHOP DRAWINGS



DRAWN:	JC
DATE:	11.6.07
CHECKED:	FAV/FTL
SCALE:	AS SHOWN
PROJECT:	1615

SHEET 2a
CENTERLINE PULL PLAN FIXTURES, WALLS & PANELS

F.O. #1

NOTE:
NO ENLARGEMENT PLAN IS PROVIDED FOR THIS BUILDING.