

REVISIONS		
FIELD ORDER #1		
1	JC	11.6.07
2		
3		
4		
5		

COPYRIGHT ©2007  
 SARAMARK, INCORPORATED  
 THESE PLAN DRAWINGS ARE  
 PROPRIETARY DOCUMENTS  
 OF SARAMARK, INCORPORATED  
 & ARE NOT TO BE DISTRIBUTED,  
 PUBLISHED OR REPRODUCED  
 WITHOUT THE WRITTEN  
 CONSENT OF SARAMARK  
 INCORPORATED.

**EC  
 CONSULTING  
 GROUP**

1250 AVIATION AVE  
 SUITE 200-4  
 SAN JOSE, CA 95110  
 TEL: (408) 294-5313

**COLLEGE  
 of  
 SAN MATEO**

**SAN MATEO  
 UNIFIED SCHOOL  
 DISTRICT**


**BRUNS  
 BELMONT  
 CONSTRUCTION**

**SERIES  
 4024AX**

P.O. BOX 812707  
 SAN JOSE, CALIFORNIA 95181  
 TEL: (408) 971-1708  
 FAX: (408) 971-3534

**BUILDING 'B'  
 HALL OF FAME**


**UNDERSLAB  
 SHOP  
 DRAWINGS**

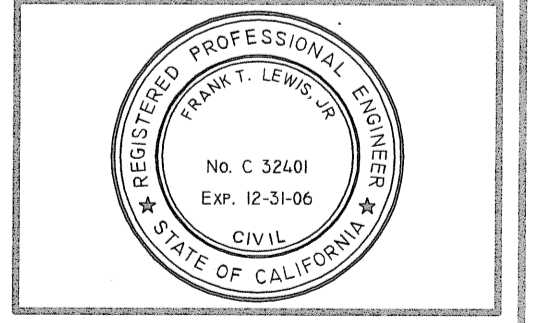

DRAWN: JC  
 DATE: 11.6.07  
 CHECKED: FAV/FTL  
 SCALE: AS SHOWN  
 PROJECT: 1615

**SHEET 2b**  
**ELECTRICAL &  
 LOW VOLTAGE  
 UNDERSLAB  
 CONDUITS**

**F.O. #1**

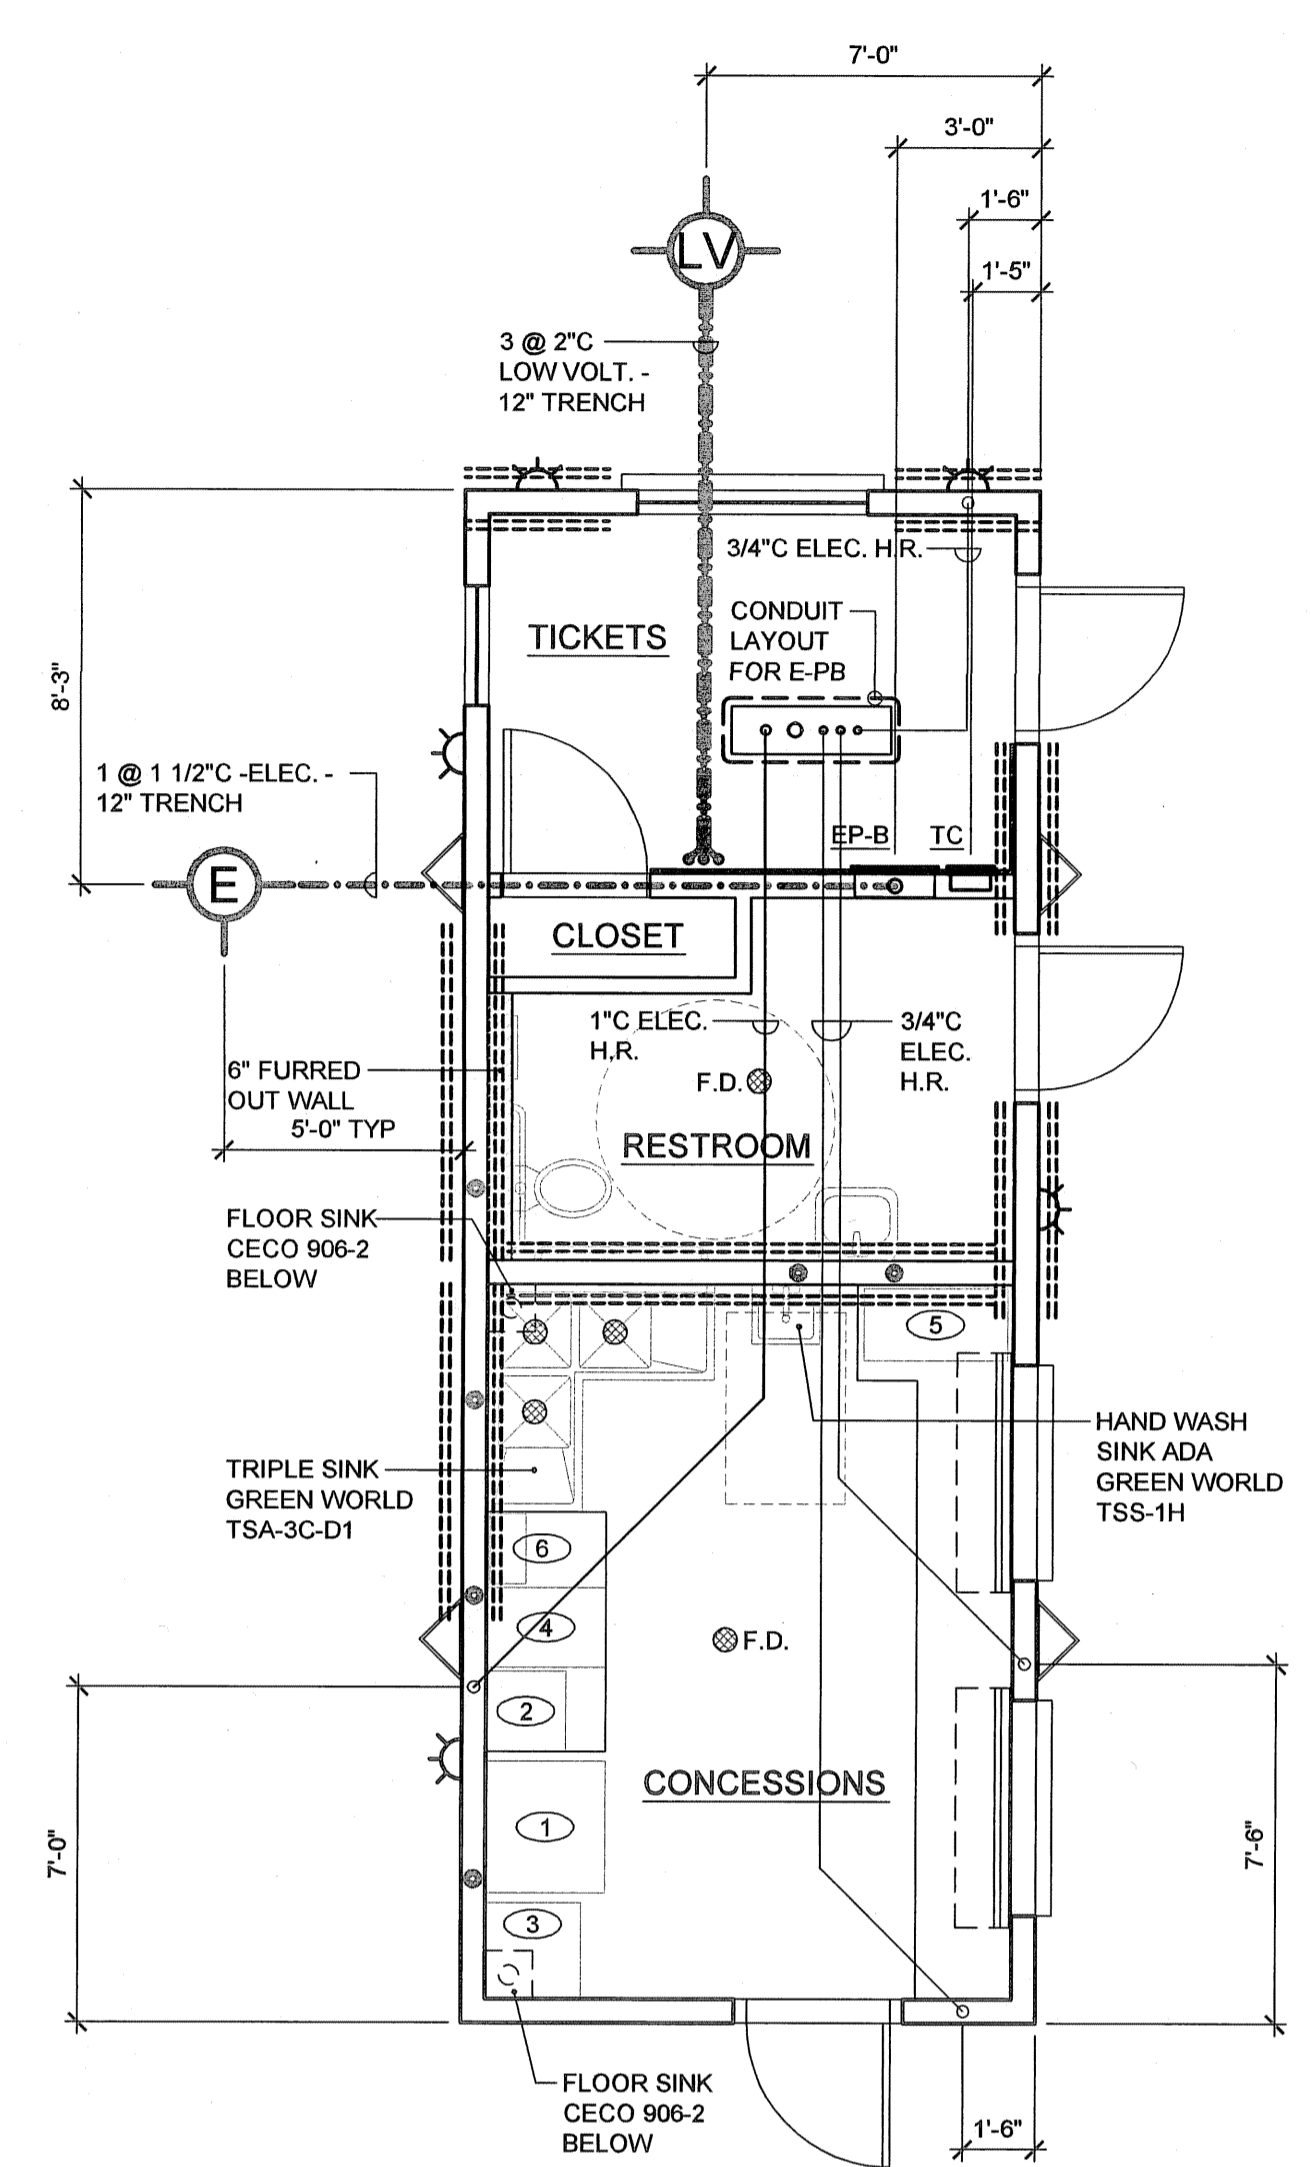


- ① REFRIDGERATOR (NIC)
- ② POPCORN MACHINE (NIC)
- ③ ICE MAKER (NIC)
- ④ FOUNTAIN DRINK MACHINE (NIC)
- ⑤ HOT DOG MACHINE (NIC)
- ⑥ COFFEE MAKER (NIC)

**LEGEND**

- (RED) ——— 3/4" ELECTRIC H.R.
- (BLUE) ——— 1" ELECTRIC H.R.
- (MAGENTA) - - - - - ELEC. FEED - AS NOTED (24" RAD. SWEEPS)
- (YELLOW) - - - - - LOW VOLT. FEED - AS NOTED (48" RAD. SWEEPS)
- ELECTRICAL (POWER) - POINT OF CONNECTION
- LOW VOLTAGE - POINT OF CONNECTION
- EP-B - ELECTRICAL PANEL
- TC - TIMECLOCK FOR RELAY EXTERIOR LIGHTS
- 13" ROUND WALL MOUNTED EXTERIOR FLUORESCENT LIGHT FIXTURE, MOUNTED @ 92" TO CENTER A.F.F. MOUNTING DETAIL PER MANUFACTURER'S RECOMMENDATION
- PLUMBING PIPE IN WALL

**ELECTRICAL & LOW VOLTAGE  
 UNDERSLAB CONDUITS - BUILDING B**  
 SCALE: 1/4" = 1'-0"

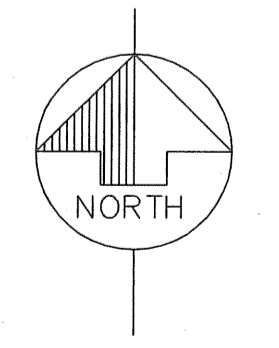

**NOTE:**  
 NO ENLARGEMENT PLAN IS  
 PROVIDED FOR THIS BUILDING.