


- THE DRAWINGS, DETAILS, AND SPECIFICATIONS 5. DOORWAYS LEADING TO MEN'S SANITARY SHALL COMPLY WITH ADAAG (AMERICAN DISABILITIES ACT ACCESSIBILITY GUIDELINES) AND CALIFORNIA BUILDING CODE TITLE 24.
- CONTENT OF DETAILS CONTAINED HEREIN ARE STANDARD AND ARE MINIMUMS ONLY. DETAILS APPLY TO ACTUAL PROJECT AS OCCURS. SEE ARCHITECTURAL DRAWINGS FOR SPECIFIC DETAILS WHERE THEY MAY DIFFER FROM THAT SHOWN ON THESE STANDARDS.
- 3. WHERE PERMANENT IDENTIFICATION IS PROVIDED FOR ROOMS AND SPACES, RAISED LETTERS SHALL BE PROVIDED AND SHALL BE ACCOMPANIED BY BRAILLE, SIGNS SHALL BE INSTALLED ON THE WALL ADJACENT TO THE LATCH OUTSIDE OF THE DOOR. WHERE THERE IS NO WALL SPACE ON THE LATCH SIDE, SIGNS SHALL BE PLACED ON THE NEAREST ADJACENT WALL, PREFERABLY ON THE RIGHT MOUNTING HEIGHT SHALL BE 60 INCHES (1524 MM) ABOVE THE FINISHED FLOOR TO GHE CENTERLINE OF THE SIGN. MOUNTING LOCATION SHALL BE DETERMINED SO THAT A PERSON MAY APPROACH WITHIN 3 INCHES (76 MM) OF SIGNAGE WITHOUT ENCOUNTERING PROTRUDING OBJECTS OR STANDING WITHIN
- THE SWING OF THE DOOR. 4. SWITCHES, CONTROLS, ETC. USED TO OPERATE LIGHTS, HEATING, COOLING AND VENTILATION SHALL BE CENTERED NOT MORE THAN 48 INCHES A.F.F. RECEPTACLE OUTLETS SHALL BE CENTERED NOT LESS THAN 18 INCHES
- FACILITIES SHALL BE IDENTIFIED BY AN EQUILATERAL TRIANGLE 1/4 INCH THICK (6.4 MM) WITH EDGES 12 INCHES LONG (305 MM) AND A VERTEX POINTING UPWARD. WOMEN'S SANITARY FACILITIES SHALL BE IDENTIFIED BY A CIRCLE 1/4 INCH THICK (6.4 MM) AND 12 INCHES (305 MM) IN DIAMETER. THERE ARE NO UNISEX SANITARY FACILITY IN THIS PROJECT. THESE GEOMETRIC SYMBOLS SHALL BE CENTERED ON THE DOOR AT A HEIGHT OF 60 INCHES (1524 MM) AND THEIR COLOR AND CONTRAST SHALL BE DISTINCTLY DIFFERENT FROM THE COLOR AND CONTRAST OF THE DOOR. ALL GEOMETRIC SYMBOLS SHALL BE ACCOMPANIED WITH EQUIVALENT VERBAL AND BRAILLE DESCRIPTION. LETTERS SHALL BE RAISED 1/32" THICK UPPER CASE SANS SERIF OR SIMPLE SERIF TYPE. BRAILLE SHALL BE GRADE 2. RAISED CHARACTERS SHALL BE AT LEAST 5/8" HIGH BUT MOUNTED ALONG THE CLOSEST ADJACENT WALL ON THE STRIKE SIDE OF THE DOOR CENTERED AT 60° A.F.F. 6. VERIFY COLORS WITH ARCHITECT.

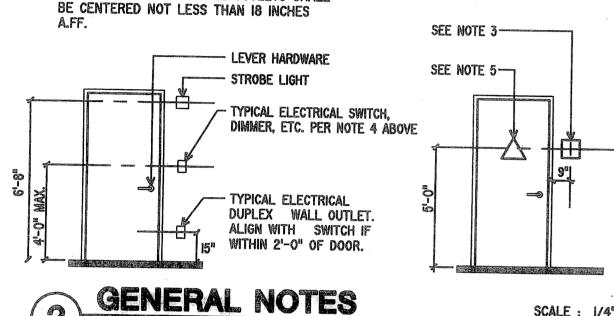

FOR ACCESSIBILITY

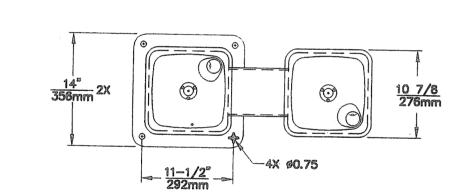


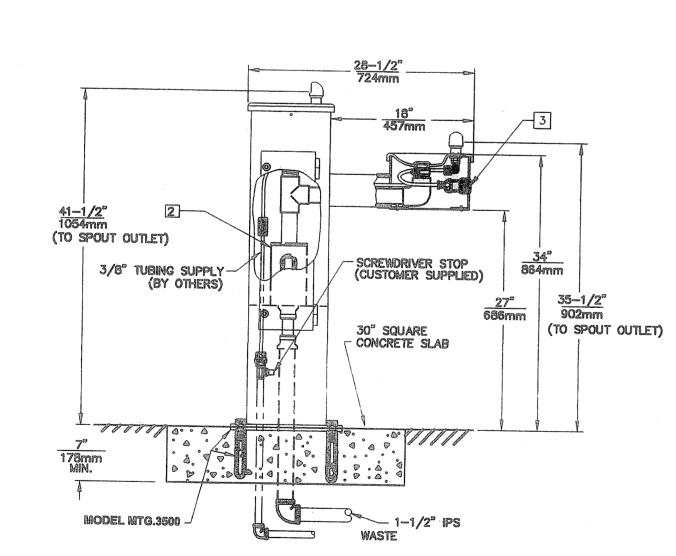


SCALE : 1/4" = 1'-0"


7026.34 -07.18.97 - 048 - IOHA_05B


- 2. SAND TRAP MODEL 6635 W/ MOUNTING PLATE (OPTIONAL). SEE MODEL FOR INSTALLATION INSTRUCTIONS.
- 3. REFER TO 5874/VRK5874 OPERATION AND MAINTENANCE MANUAL FOR PUSH BUTTON AND VALVE INSTALLATION/MAINTENANCE INSTRUCTIONS.
- 4. ACCESS DOOR SPECIFIED BY CUSTOMER AND SHIPPED SEPARATELY UNDER THE FOLLOWING MODEL NUMBERS: 6236LD

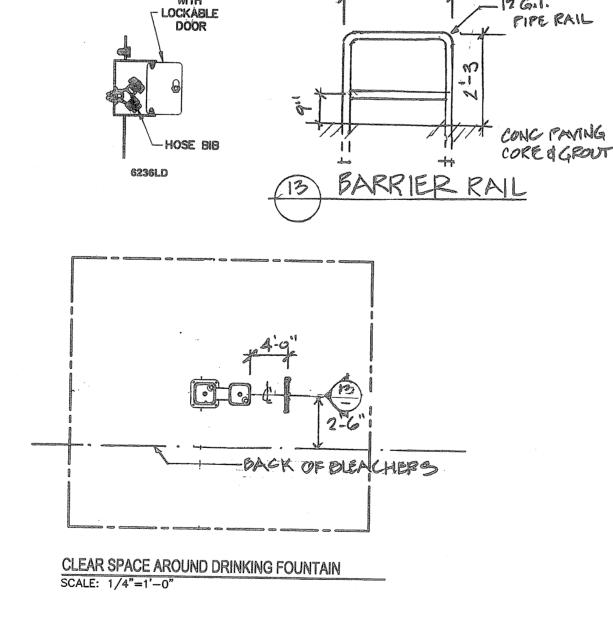

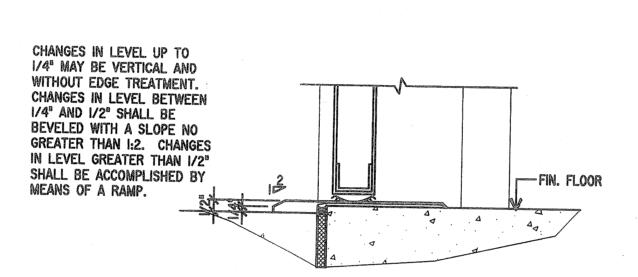



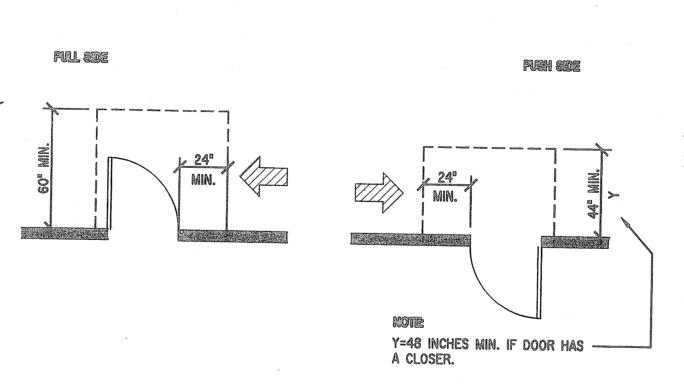

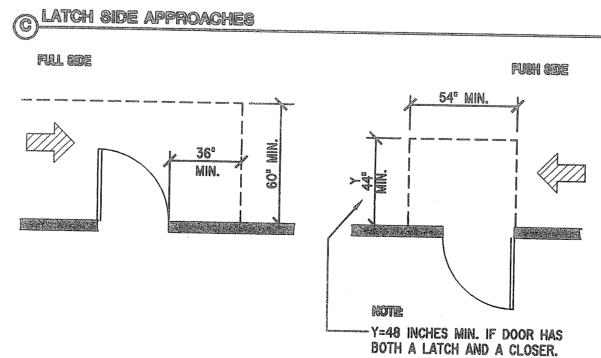

D HINGE SIDE APPROACHES

ACCESSIBLE CLEAR SPACE

NOTES:


I. RECESSED DOORMAT TO BE ANCHORED AT CORNERS TO PREVENT INTERFERENCE WITH WHEELCHAIRS.

> 2.THE BOTTOM 10 INCHES OF DOOR EXCEPT AUTOMATIC AND SLIDING DOORS, ARE REQUIRED TO HAVE A SMOOTH SURFACE AT BOTTOM OF DOOR.

3.THE MAXIMUM EFFORT TO OPERATE DOORS SHALL NOT EXCEED 5 POUNDS PER EXTERIOR DOORS AND 5 LBS. FOR INTERIOR DOORS.


4.THE SWEEP PERIOD OF A DOOR EQUIPPED WITH A CLOSER SHALL BE SO THAT FROM AN OPEN POSITION OF 70 DEGREES. THE DOOR WILL TAKE AT LEAST 3 SECONDS TO MOVE TO A POINT 3" FROM THE LATCH, MEASURED TO THE LEADING EDGE OF THE

5.THRESHOLDS SHALL BE NO MORE THAN 1/2 INCH HIGH BEVEL OR SLOPE THE EXPOSED EDGE AT AN ANGLE NOT EXCEEDING 45 DEGREES SO THAT NO SINGLE VERTICAL CHANGE IN **ELEVATION EXCEEDS 1/4**

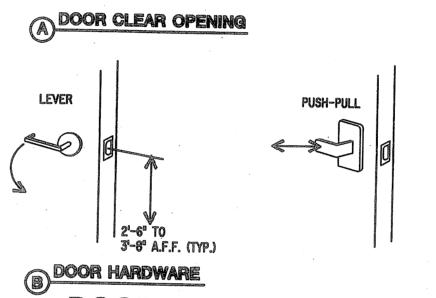


2'-8" CLR. MIN.

DOORS & DOOR HARDWARE SCALE: 1/2"=1'-0"

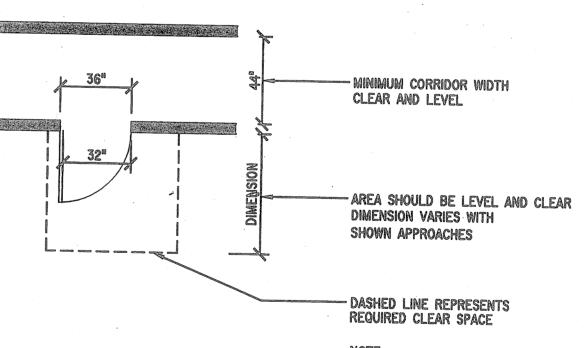

AT ALL DOORWAY LOCATIONS, REQUIRED CLEAR FLOOR SPACE SHALL General requirements HAVE A MAX. SLOPE OF 2%.

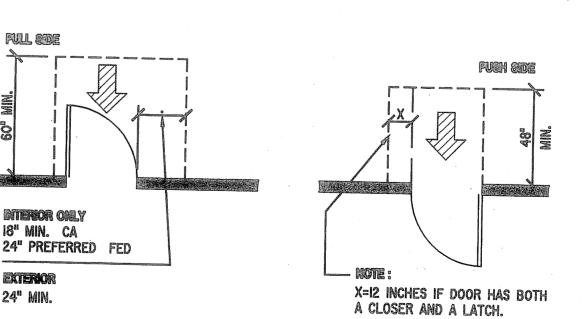

FRONT APPROACHES

ENTERIOR CALLY 18" MIN. CA

EXTENOR

24" MIN.

SCALE : 1/4"=1'-0"

ARCHITECTS ENGINEERS

399 Bradford Street Redwood City, Ca. 94063 (650) 364-6453 (650) 364-2618 www.des-ae.com

SARAMARK INCORPORATED

SAN JOSE, CALIFORNIA 95154 Ph: (408) 971-3881 Fax: (408) 971-3534

ROBERT A. BOTHMAN, INC.

General Engineering and Building Contractors

650 QUINN AVENUE **SAN JOSE, CA. 95112** Ph: (408) 279-2277 Fax: (408) 279-2281


SAN MATEO COUNTY COMMUNITY COLLEGE DISTRICT ATHLETIC FIELDS PHASE 2

COLLEGE OF SAN MATEO SOFTBALL FIELD TEAM ROOM & FOOTBALL HALL OF FAME San Mateo, Ca. 94402 1700 W. Hillsdale Blvd.

ACCESSIBILITY STANDARDS

ISSUE: DATE: DESCRIPTION: DSA 04/26/07 DSA SUBMISSION DRAWN BY: A.BAKSH V. AMRHEIN APPROVED BY: V. AMRHEIN DES PROJECT NO.: 9126.12

INDENTIFICATION STAMP DIVISION OF THE STATE ARCHITECT APPL #: 01-108848 FILE #: 41-C1 DATE: OCT 1 0 2007

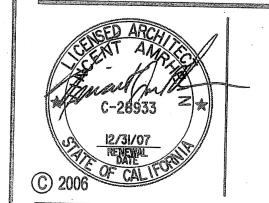

SHEET NO. G0.02

14) PLAZA DRINKING FOUNTAIN

FILE NAME: A09-16

o DOORS