

**PLAN KEY NOTES**

- ① FUTURE PRESSBOX
- ② LINE OF FUTURE BLEACHERS


**SYMBOLS/ LEGENDS**

- AREAS OF SCOPE
- ..... PEDESTRIAN ACCESSIBLE PATH OF TRAVEL
- → → → → VEHICULAR ACCESS

**BASIC BUILDING LIMITATIONS ANALYSIS**

BUILDING A	ALLOWABLE AREA AND HEIGHTS		ACTUAL	
	USE GROUP	HEIGHT / AREA	VN	VN
	B	H	2 STORIES	1 STORY
	A	A	8000 S.F.	980 S.F.

① SITE PLAN  
HRS

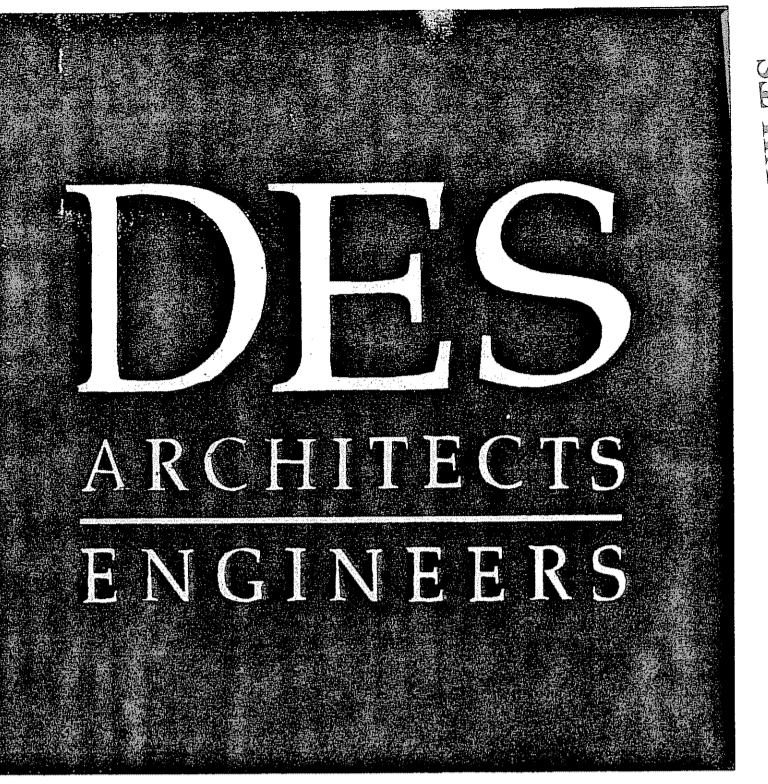

399 Bradford Street Redwood City, Ca. 94063  
 Tel: (650) 364-6453  
 Fax: (650) 364-2618  
 www.des-ae.com

**SARAMARK INCORPORATED**  
 SAN JOSE, CALIFORNIA 95154  
 Ph: (408) 971-3881  
 Fax: (408) 971-3534

**ROBERT A. BOTHMAN, INC.**  
 General Engineering and Building Contractors  
 650 QUINN AVENUE  
 SAN JOSE, CA. 95112  
 Ph: (408) 279-2277  
 Fax: (408) 279-2281


**SAN MATEO COUNTY COMMUNITY COLLEGE DISTRICT ATHLETIC FIELDS PHASE 2**  
 COLLEGE OF SAN MATEO SOFTBALL FIELD TEAM ROOM & FOOTBALL HALL OF FAME  
 San Mateo, Ca. 94402  
 1700 W. Hillsdale Blvd.

**ACCESSIBILITY PLAN AND SCOPE OF WORK**

ISSUE DATE:	DESCRIPTION:
DSA 04/26/07	DSA SUBMISSION

DRAWN BY: A.BAKSH  
 REVIEWED BY: V. AMRHEIN  
 APPROVED BY: V. AMRHEIN  
 DES PROJECT NO.: 9126.12

IDENTIFICATION STAMP  
 DIVISION OF THE STATE ARCHITECT  
 APPL # 01-108840  
 FILE # 41-C1  
 AC 2/6 FLS 2/2 SS 2/2  
 DATE OCT 10 2007

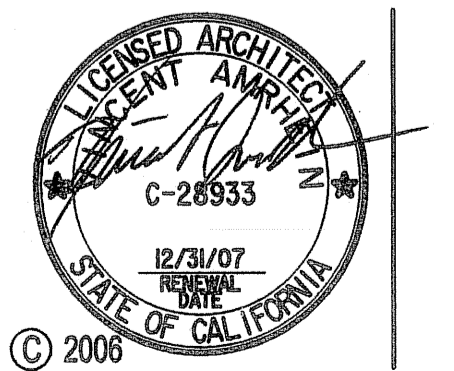

1.09, 2007 - 1:17pm A:\sketch\_P:\SUCCED\AHP2\912612\Draw\1.2 and 6.CSM\_Schball\1.2\_DSA\_SUBMISSION\2435\G1.01.dwg