
TESTING LABORATORY:DATE: NAME:CSM-ATHLETIC FIELD PHASE 2									STATE OF CALFORNIA DEPT. OF GENERAL SERVICES DIVISION OF THE STATE ARCHITECT			
DISTRICT/OWNER: CSM COLLEGE DIST.									STRUCTURAL *			
								TESTS				
DIVISION-FILE NO. APPLICATION NO.												
									AND			
ARCHITECT:								INSPECTIONS				
STRUCTURAL ENGINEER: 754 S	STRUCTURAL E	NGINE	ERS INC.					L	SSS	103–1 (R	9/94)	
The following tests and inspect	ions, as checked,	will be i	required as	deto	iiled ir	n applica	ble specifi	ications.				
COMPACTED FILL	CON-	GUNITE	GROUT	мо	RTAR							
Fill material, acceptance tests							aggregat	es for m	nix design o	nly		
Compaction control, continuous GEOT	ECH. >><								gates as del		w	
Compaction tests only as ordered							signs (
Bearing capacity of compacted fill						Continu	ious batch	plant ir	nspection (W	eight Mas	ter Cert.)	
REINFORCING STEEL - #5 OR LARGE	R					Inspect	placing					
Sample and test bar steel						Sample						
Sample and test mesh						Compre	ession test	s				
Inspect placing at job EXEPT \$1.80N GNOE						Pick u	samples	at job				
STRUCTURAL STEEL			1			Sample	s delivered	d to labo	oratory			
Sample and test as detailed below			1				sample fo					
Shop fabrication inspection *				_			and test	cement.	. Grab Samp	ole		
Field erection inspection	SUITAI	BILITY	TESTS		MATER	CRETE RIALS	GUN	ITE	MORTA	R	GROUT	
Inspection of welds — Shop		um sulpł		\neg								
Inspection of welds — Field	Struc	ctural st	rength									
Inspection of riveting or bolting - Shop	Los	Angeles	rattler		> a [.ABS [SCRET	ION				
Inspection of riveting or bolting — Field		(Hydron	neter metho	ıd)								
Sample and test high strength bolts and w	Reac	tivity tes	sts	\perp								
BRICK AND BLOCK	Volur	ne chan	ge	J								
Sample and test	MIX C	ESIGN:	S: CONCF	RETE	, GR	OUT, N	ORTAR	OR GU	INITE			
Test only (Site Prisms)		,,	MAVIMUM C	175		С	OMPRESSI\	VE STREN	NGTH, PSI, M	IINIMUM		
Inspection of placing Core drill samples		MATERIAL MAXIMUM SIZE			28 DAYS							
	CONC:F	TG	i 1"		30	000						
GLUED LAMINATED STRUCTURAL LUMB	ER											
Fabrication Inspection	CONC: S	21 10	3/4		25	00						
Sample and test steel accessories Inspect fabrication of steel accessories		DLAD	2/4		25							
UNIDENTIFIED STRUCTURAL STEEL	List of struc PER CBC 200			s to	be te	ested:						
Other Tests and Inspections, together with special instructions: EXPANSION ANCHORS PER DRAWINGS					Т	Copies of Reports to:						
						IOR DISTRICT DSA CONTRACTOR ARCHITECT SEOR						
					-							
						Ву:		AUTHOF	RIZED REPRE	SENTATIVF		

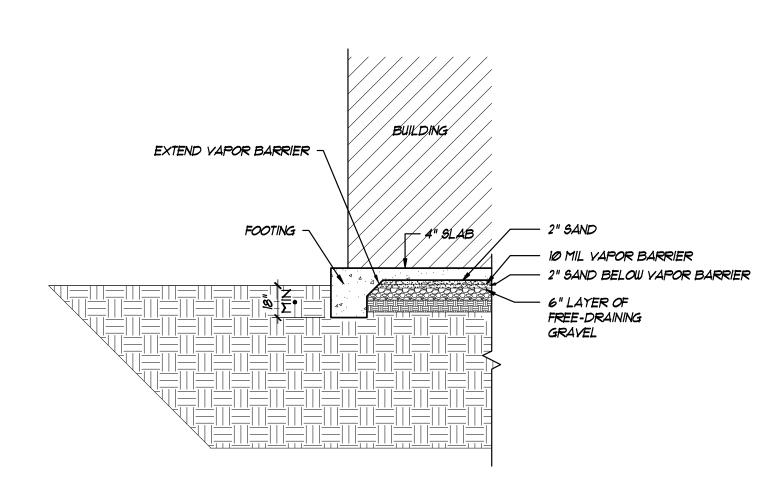

SOILS REQUIREMENT

A. GENERAL:

- I. ALL MATERIALS AND WORKMANSHIP SHALL CONFORM TO THE PROJECT DOCUMENTS, APPLICABLE REQUIREMENTS OF THE 2001 EDITION OF THE CALIFORNIA BUILDING CODE (CBC), AND ALL LOCAL ORDINANCES, CODES AND OTHER REQUIREMENTS.
- 2. THE DOCUMENTS INDICATE GENERAL AND TYPICAL DETAILS OF CONSTRUCTION. SIMILAR DETAILS APPLY TO SIMILAR CONDITIONS SUBJECT TO REVIEW BY THE ARCHITECT/ENGINEER NOTES AND DETAILS ON THE DRAWINGS TAKE PRECEDENCE OVER THE GENERAL NOTES AND TYPICAL DETAILS IN THE EVENT OF A CONFLICT.
- 3. THE CONTRACTOR SHALL BE RESPONSIBLE FOR COORDINATING THE WORK OF ALL TRADES, SHALL CHECK ALL DIMENSIONS AND ELEVATIONS, AND SHALL COORDINATE THE DOCUMENTS WITH CONDITIONS AT THE SITE PRIOR TO THE START OF ANY WORK, ANY DISCREPANCIES SHALL BE REPORTED TO THE ARCHITECT/ENGINEER AND SHALL BE RESOLVED BEFORE PROCEEDING WITH THE WORK
- 4. THE CONTRACT DRAWINGS REPRESENT THE FINISHED STRUCTURE AND DO NOT INCLUDE METHODS, PROCEDURES OR SEQUENCES OF CONSTRUCTION. THE CONTRACTOR SHALL TAKE NECESSARY PRECAUTIONS TO MAINTAIN AND ENSURE THE INTEGRITY OF THE STRUCTURE DURING CONSTRUCTION. CONTRACTOR SHALL DESIGN, CONSTRUCT AND MAINTAIN ALL SAFETY DEVICES, INCLUDING SHORING, GUYS AND BRACING. CONTRACTOR SHALL BE SOLELY RESPONSIBLE FOR CONFORMING TO ALL LOCAL, STATE AND FEDERAL SAFETY AND HEALTH STANDARDS, LAWS, REGULATIONS AND ORDINANCES.
- 5. SHOP DRAWINGS SHALL BE SUBMITTED FOR REVIEW PRIOR TO FABRICATION. PRIOR TO SUBMITTAL, THE SHOP DRAWINGS SHALL HAVE BEEN STAMPED INDICATING THAT THE CONTRACTOR HAS VERIFIED ALL QUANTITIES, DIMENSIONS, FIELD CONSTRUCTION
- CRITERIA, MATERIALS, AND SIMILAR DATA. 6. THE CONTRACTOR SHALL RESTORE AND REPAIR ADJACENT GROUNDS OR STRUCTURES THAT ARE CHANGED, MODIFIED, REMOVED OR DAMAGED DURING THE CONSTRUCTION
- SHOWN IN THESE DRAWINGS.

APPROVED PRODUCT EVALUATIONS REPORTS (ICBO REPORTS) AND A LIST OF ALL

- 1. REFER TO THE PROJECT SPECIFICATIONS FOR ADDITIONAL INFORMATION NOT NOTED. 8. REQUESTS FOR SUBSTITUTION SHALL BE ACCOMPANIED BY MANUFACTURER'S
- PROPOSED SUBSTITUTIONS TO THE ARCHITECT/ENGINEER AND ORS FOR REVIEW AND WRITTEN APPROVAL PRIOR TO FABRICATION OR USE. 9. PIPES, DUCTS, SLEEVES, CHASES, ETC. SHALL NOT BE PLACED IN SLABS, BEAMS OR WALLS UNLESS SPECIFICALLY SHOWN OR NOTED. NO STRUCTURAL MEMBER WILL BE CUT FOR PIPES, DUCTS, ETC. UNLESS SPECIFICALLY SHOWN. OBTAIN PRIOR WRITTEN
- APPROVAL FOR INSTALLATION OF ANY ADDITIONAL PIPES, DUCTS, AND GROUP OF 10. THE USE OF NEW CONSTRUCTION FOR THE SUPPORT/STORAGE OF CONSTRUCTION EQUIPMENT OR MATERIALS IS RESTRICTED TO THE DESIGN CAPACITY OF THE NEW CONSTRUCTION AT THE TIME IT IS TO BE USED FOR SUCH SUPPORT. PLACE
- II. CHANGES TO DRAWINGS ARE NOT ALLOWED WITHOUT PRIOR WRITTEN APPROVAL.

MATERIAL OR EQUIPMENT SO AS NOT TO EXCEED THE CAPACITY OF INDIVIDUAL

ELEMENTS. CONTRACTOR TO PROVIDE ADEQUATE, ENGINEERED SHORING WHERE

12. TSA STRUCTURAL ENGINEERS IS NOT RESPONSIBLE FOR ANY HAZARDOUS AND TOXIC MATERIAL SUCH AS ASBESTOS, MOLD, ETC. THE CONTRACTOR SHALL TAKE NECESSARY PRECAUTIONS TO PREVENT & ELIMINATE THE PRESENCE OF HAZARDOUS MATERIALS

B. DIMENSIONS:

DESIGN CAPACITY IS NOT SUFFICIENT.

- I. THESE DRAWINGS WERE PREPARED WITH THE INTENTION THAT ALL ELEVATIONS AND HORIZONTAL DIMENSIONS THAT ARE NOT SHOWN DIRECTLY ON THE DRAWINGS AR INFERABLE FROM THE DRAWINGS. IT IS INTENDED THAT THE CONTRACTOR USE THE ENTIRE SET OF DRAWINGS TO ESTABLISH VERTICAL AND HORIZONTAL CONTROL FOR THE PROJECT. THE DRAWINGS FOR EACH DISCIPLINE ARE TO BE CONSIDERED AS COMPLIMENTARY TO EACH OTHER, NOT SELF-SUFFICIENT. CONTRACTOR TO FIELD VERIFY EXISTING DIMENSIONS AND REPORT ANY DISCREPENCIES
- 2. THE STRUCTURAL DRAWINGS ALONE DO NOT INCLUDE ALL DIMENSIONS NECESSARY TO LOCATE STRUCTURAL MEMBERS, SLAB EDGES, SLAB OPENINGS, EMBEDDED ITEMS,
- 3. DO NOT SCALE DRAWINGS.
- 4. USING THE COMPLETE SET OF DRAWINGS, THE CONTRACTOR SHALL PREPARE A LAYOUT PLAN ESTABLISHING ELEVATIONS, HORIZONTAL DIMENSIONS, AND OTHER RELATIONSHIPS NOT SPECIFICALLY SHOWN ON THE STRUCTURAL DRAWINGS.

C. INSPECTIONS AND OBSERVATIONS:

- I. OWNER WILL EMPLOY AND PAY FOR THE SERVICES OF AN INDEPENDENT TESTING LABORATORY TO PERFORM SPECIFIED INSPECTIONS AND TESTING.
- 2. SPECIAL INSPECTOR (IOR) SHALL BE APPROVED BY THE ARCHITECT/ENGINEER AND DSA.
- 3. EMPLOYMENT OF TESTING LABORATORY SHALL NOT RELIEVE CONTRACTOR OF OBLIGATION TO PERFORM WORK IN ACCORDANCE WITH THE REQUIREMENTS OF THE CONTRACT DOCUMENTS.
- 4. CONTRACTOR SHALL COOPERATE WITH THE TESTING LABORATORY TO FACILITATE THE EXECUTION OF THE LABORATORY'S SERVICES.
- 5. TESTING LABORATORY SHALL PERFORM SPECIAL INSPECTION OF THE FOLLOWING ITEMS: PER CBC SECT 1702A: (REFER TO THE TESTING AND INSPECTION LIST)
- A. CONCRETE AND REINFORCING STEEL
 - H. EXPANSION BOLTS I. MASONRY
- E. SOILS RELATED WORK
- B. ANCHORS INSTALLED IN CONCRETE. C. WELDING OF STRUCTURAL STEEL. (FIELD & SHOP)
 - J. NAILING OF SHEAR WALLS AND ROOF DIAPHRAMS
- F. GLUE LAMINATED BEAMS.

- G. STRUCTURAL STEEL.
- DUTIES OF SPECIAL INSPECTOR FOR EACH REQUIRED SPECIAL INSPECTIONS PER CBC SECT. 106.3.5 TESTING LAB SHALL REVIEW AND APPROVE CONCRETE MIX DESIGNS.

ENGINEER, TO THE OWNER, TO ORS AND TO THE CONTRACTOR, AND I OR

- 6. TESTING LABORATORY SHALL SUBMIT COPIES OF TESTING REPORTS TO ARCHITECT/
- 1. THE ENGINEER OF RECORD WILL MAKE PERIODIC STRUCTURAL OBSERVATIONS DURING CONSTRUCTION PER SECT. 1702A. THE ENGINEER WILL SUBMIT WRITTEN VERIFICATION THAT THE STRUCTURAL SYSTEM IS IN GENERAL CONFORMANCE WITH THE INTENT OF THE STRUCTURAL DESIGN AND THE APPROVED CONTRACT DOCUMENTS. STRUCTURAL OBSERVATIONS OF THE FOLLOWING ITEMS IS REQUIRED:
- A. FOUNDATION EXCAVATION AND REINFORCING STEEL PLACEMENT. B. STRUCTURAL FRAMING AND SHEAR WALL AND ROOF NAILING.
- C. PRIOR TO PLACING CONCRETE. D. AT THE COMPLETION OF THE STRUCTURAL SYSTEMS PRIOR TO COVERING WITH FINISHES.

STRUCTURAL OBSERVATIONS DO NOT INCLUDE OR WAIVE THE RESPONSIBILITY FOR THE SPECIAL INSPECTIONS REQUIRED.

OWNER, CONTRACTOR, ORS, AND ARCHITECT/ENGINEER.

8. THE GEOTECHNICAL ENGINEER OF RECORD SHALL OBSERVE ALL FOUNDATION EXCAVATIONS AND PAD CONSTRUCTION TO VERIFY COMPLIANCE WITH THE INTENT OF THE GEOTECHNICAL REPORT. WRITTEN VERIFICATION SHALL BE SUBMITTED TO THE

E. DESIGN CRITERIA:

- I. APPLICABLE CODE: CALIFORNIA CODE OF REGULATIONS, 2001 EDITION (CCR), TITLE 24, PART 2, ALSO REFERRED TO AS CALIFORNIA BUILDING CODE (CBC) WITH DIVISION OF THE STATE ARCHITECT/STRUCTURAL SAFETY SECTION.
- 2. ALL NEW CONSTRUCTION SHALL COMPLY WITH THE REQUIREMENTS OF THE 2001 CBC.
- 3. VERTICAL LOADS: I. ROOF LIVE LOADS: 20 PSF (REDUCIBLE)
- 2. ROOF DL = 18 psf 4. LATERAL LOADS:
- 1. SEISMIC: Z = 0.3 I = 1.15
- R = 2.2 $Na = 1.5 CA = 0.44 \times 1.5$
- 901L = 9d
- 2. WIND: EXPOSURE C, BASIC WIND SPEED = 80 MPH, I = 1.15


<u>F. FOUNDATION NOTES</u>

- I. SEISMIC CRITERIA HAS BEEN ESTABLISHED BASED ON THE SOILS REPORT
- 2. ALLOWABLE SOIL BEARING PRESSURES ON SOIL ARE: DEAD + LIVE LOADS DEAD + LIVE + SEISMIC LOADS 1,330 PSF
- FOOTINGS SHALL EXTEND A MINIMUM 18" INCHES BELOW LOWEST ADJACENT GRADE AND SHALL BEAR ENTIRELY ON SOIL. DEEPER FOOTING MAY BE REQUIRED BASED ON THE FIELD CONDITION AND
- AS DIRECTED BY THE SOILS ENGINEER AFTER EXCAVATION 3. EXCAVATIONS SHALL BE MADE AS NEAR AS POSSIBLE TO THE NEAT LINES REQUIRED BY THE SIZE AND SHAPE OF THE STRUCTURE. NO MATERIAL IS
- TO BE EXCAVATED UNNECESSARILY. 4. ALL FOUNDATION EXCAVATIONS MUST BE REVIEWED AND APPROVED BY THE
- 5. VERIFY LOCATION OF UNDERGROUND UTILITIES BEFORE EXCAVATION. NOTIFY ARCHITECT PRIOR TO EXCAVATION IN THE EVENT SUCH UTILITIES ARE ENCOUNTERED.
- 6. FOR DRAINAGE DETAILS, SUMPS, PITS, DAMP PROOFING, TRENCHES, CURBS, EXTERIOR WALKS, UTILITIES, EQUIPMENT DETAILS, STEPS, ETC., SEE DRAWINGS OTHER THAN STRUCTURAL.

SOILS ENGINEER PRIOR TO PLACEMENT OF CONCRETE.

G. CONCRETE MATERIAL

- 1. REINFORCING STEEL:
- a. BARS: ASTM A615, GRADE 60. b. WELDED BARS: ASTM A106, GRADE 60.
- c. ALL CONCRETE SHALL BE REINFORCED UNLESS
- SPECIFICALLY MARKED 'NOT REINFORCED'. 2. CONCRETE CLASSES: SEE SPECIFICATIONS FOR REQUIREMENTS.

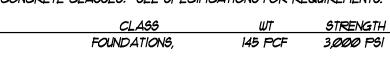

- 3. MINIMUM CONCRETE COVER FOR REINFORCING STEEL:
- a. SURFACES PLACED AGAINST EARTH b. FORMED SURFACES BELOW GRADE
- c. SURFACES EXPOSED TO WEATHER
- (*4 & *5 EXPOSED TO WEATHER ID")
- d. EXTERIOR WALL AT EXTERIOR FACE 1-1/2" e. SLABS AND WALLS NOT EXPOSED TO WEATHER
- 4. FINISH: SLABS ACI 301 "FLOATED FINISH".
- 5. EXPANSION ANCHORS SHALL BE HILTI KWIK BOLT II (KB-II) AS MANUFACTURED BY HILTI CORPORATION OR APPROVED EQUAL. INSTALL PER MANUFACTURER'S RECOMMENDATION.
- 6. EPOXY FOR DOWELS SHALL BE HS 200 SOLID BOND AS MANUFACTURED BY ANCHOR-IT FASTENING SYSTEMS, CIA-GEL AS MANUFACTURED BY COVERT OPERATIONS, HIT AS MANUFACTURED BY HILTI OR APPROVED EQUAL. INSTALL PER MANUFACTURER'S RECOMMENDATIONS.
- 1. CONCRETE MIX DESIGN SHALL BE REVIEWED AND APPROVED BY THE TESTING LAB

H. STEEL MATERIAL

- I. W SHAPES AND PLATES: ASTM A572, GRADE 50
- 2. PIPES: ASTM A53, GRADE B
- 3. MACHINE BOLTS ASTM A3ØT.
- 4. ANCHOR RODS: ASTM FI554 GRADE 36
- 5. WELDING ELECTRODES: E-10XX.
- 6. ALL STEEL EXPOSED TO WEATHER SHALL BE
- HOT DIPPED GALVANIZED (G60).
- 1. WELDED WIRE FABRIC: ASTM A185
- 8. SPIRAL TIES: ASTM A82
- 9. *16 A500 GRADE C.*

I. STRUCTURAL SPECIFICATIONS:

REFER TO STRUCTURAL SPECIFICATION SECTIONS: CONCRETE FORMWORK 03200 CONCRETE REINFORCEMENT 03300 CAST-IN-PLACE CONCRETE 03600 CONCRETE TEST AND INPECTIONS. 04200 CONCRETE MASONRY BLOCK STRUCTURAL STEEL

ROUGH CARPENTRY

GLUED-LAMINATED BEAM

J. TIMBER MATERIAL

- I. FRAMING LUMBER DOUGLAS FIR
- a. JOISTS, RAFTERS, STUDS AND PLATES: NO.1 b. POSTS, BEAMS, AND HEADERS: NO.1
- c. BLOCKS: STUD GRADE OR BETTER
- d. ALL LUMBER IN CONTACT WITH CONCRETE SHALL BE PRESERVATIVE TREATED AND STAMPED BY INSPECTION AGENCY. FIELD TREAT ALL SILLS WHERE CUT, DRILLED, OR NOTCHED, WITH PRESERVATIVE.
- 2. GLUED-LAMINATED BEAMS:
- a. 24F-V4 DF/DF FOR SIMPLE SPANS AND 24F-V8 DF/DF FOR CANTILEVERED AND CONTINUOUS BEAMS.
- b. INDUSTRIAL GRADE TYP. ARCHITECTURAL GRADE IF EXPOSED.

3. PLYWOOD SHEATHING:

- a. WALL SHEATHING: 15/32 INCH STRUCTURAL I APA RATED, EXPOSURE I, TYP. 19/32 INCH STRUCTURAL I APA RATED
- EXPOSURE I AT LOCATIONS INDICATED ON PLANS. b. ROOF SHEATHING: 15/32" C-D STRUCTURAL 1, APA RATED 32/16
- EXPOSURE 1. 3/4" EXP I, APA RATED 24/16

SHALL BE GALVANIZED

- 4. FRAMING HARDWARE: AS MANUFACTURED BY SIMPSON STRONG-TIE CO. OR APPROVED EQUIVALENT. SIMPSON
- DESIGNATIONS ARE USED ON THE DRAWINGS. 5. NAILS: COMMON WIRE GAGE. PREBORE HOLES WITH DIAMETER NOT EXCEEDING 3/4 OF THE NAIL DIAMETER WHERE NAILING TENDS TO SPLIT WOOD. PREBORE ALL HOLES IN EXISTING MEMBERS. REPLACE SPLIT MEMBERS. NAILING TO CONFORM TO CBC TABLE 23A-II-B-I

UNLESS NOTED OTHERWISE. NAILS INTO PRESSURE TREATED LUMBER

6. MACHINE APPLIED NAILS: USE OF MACHINE NAILING IS SUBJECT TO A SATISFACTORY JOB SITE DEMONSTRATION FOR EACH PROJECT AND APPROVAL BY THE STRUCTURAL ENGINEER AND THE OFFICE OF THE STATE ARCHITECT. THE APPROVAL IS SUBJECT TO CONTINUED SATISFACTORY PERFORMANCE. IF NAIL HEADS PENETRATE THE OUTER PLY MORE THAN WOULD BE NORMAL FOR A HAND HAMMER, OR IF MINIMUM ALLOWABLE EDGE DISTANCES ARE NOT MAINTAINED, THE PERFORMANCE WILL BE DEEMED UNSATISFACTORY. MACHINE NAILING WILL NOT BE APPROVED IN 5/16" PLYWOOD, NOR 16 IT APPROVED FOR USE ON

REFERENCE 2001 CALIFORNIA BUILDING CODE SECTION 2315A-3.3

T. UPSET THREATS ARE NOT ALLOWED

DOUBLE SIDED PLYWOOD SHEAR WALLS.

8. RETIGHTEN BOLTS BEFORE CLOSE-IN

ABBREVIATIONS:

ANCHOR BOLT ABOVE AIR CONDITIONING **ADJACENT** BUILDING BLOCK / BLOCKING

AMERICAN STANDARD CHANNEL CARRIAGE BOLT CENTERLINE CONTROL JOINT

CONCRETE
CONNECTION
CONTINUOUS
COMPLETE PENETRATION
CONCRETE MASONRY UNIT COUNTERSINK CUT WASHER DOUGLAS FIR DIAMETER DIAGONAL
DIMENSION
DOWEL JOINT
DEAD LOAD
DOWN
DITTO
DRAWING

EACH
EACH END
EACH FACE
ELECTRICAL
ELEVATION
EMBEDMENT
EQUAL
EQUIPMENT
EACH SIDE

FOUNDATION FERRULE LOOP INSERT FLOOR FACE NAIL FACE OF MASONRY FACE OF STUD FOOTING FAR SIDE

GAGE or GAUGE GALVANIZED GLUE LAMINATED BEAM

HANGER HORIZONTAL HIGH STRENGTH
HIGH STRENGTH BOLT
HIGH STRENGTH FRICTION BOLT
HIGH STRENGTH GROUT
HORIZONTALLY SLOTTED HOLE

INSIDE DIAMETER I SHAPED WOOD BUILT-UP TRUSS

POUND(s) LIGHT GAGE METAL FRAMING LIGHT GAGE METAL FRAMING CONTRACTOR LONG LEG HORIZONTAL LONG LEG VERTICAL MACHINE BOLT METAL BUILDING MANUFACTURER

> MISCELLANEOUS MALLEABLE IRON WASHER NOT IN CONTRACT

MECHANICAL MANUFACTURER

11SCELLANEOUS CHANNEL

OUTSIDE DIAMETER

PLATE OF PROPERTY LINE PANEL EDGE NAILING POUNDS PER LINEAR FOOT PANEL
PARTIAL PENETRATION
POUNDS PER SQUARE FOOT
POUNDS PER SQUARE INCH
PANEL TIE BAR PRESSURE TREATED DOUGLAS FIR

REFERENCE REINFORCING

SEE ARCHITECTURAL DRAWINGS SOLID BLOCKING SCHEDULE SEE ELECTRICAL DRAWINGS SHILAN BEE MECHANICAL DRAWINGS BEE OTHER DETAILS SPECIFICATION


TOP AND BOTTOM ONGUE AND GROOVE THREADED TOTAL LOAD TOE NAIL
TOP OF CONCRETE
TOP OF FRAMING
TOP OF MASONRY
TOP OF PLYWOOD TOP OF STEEL (SLAB)

STRUCTURAL TUBE STEEL

WORKING POINT OF WATERPROOF

WELDED WIRE FABRIC

UNLESS NOTED OTHERWISE VERTICAL VERTICALLY SLOTTED HOLE WIDE FLANGE STEEL BEAM

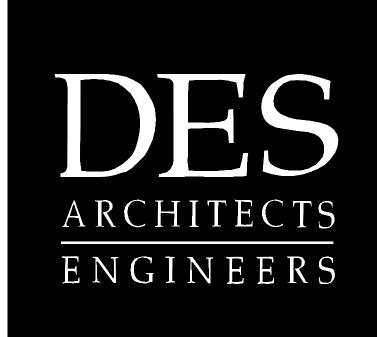

399 Bradford Street Redwood City, Ca. 94063 (650) 364-6453 (650) 364-2618 www.des-ae.com

SCMX Sports Engineers

7740 NORTH 16TH STREET SUITE 100 PHOENIX, AZ. 85020 Ph: (602) 567-1900 Fax: (602) 567-1901

ROBERT A. BOTHMAN, INC.

General Engineering and Building Contractors

650 QUINN AVENUE **SAN JOSE, CA. 95112** Ph: (408) 279-2277 Fax: (408) 279-2281

SAN MATEO COUNTY COMMUNITY COLLEGE DISTRICT ATHLETIC FIELDS PHASE 2 **INCREMENT 1A**

COLLEGE OF SAN MATEO SOFTBALL FIELD

GENERAL NOTES

San Mateo, Ca. 94402


1700 W. Hillsdale Blvd

ISSUE: DATE: DESCRIPTION: 10/23/06 DSA 01/22/07 | REVISED

DRAWN BY: **REVIEWED BY:** APPROVED BY:

SHEET NO.



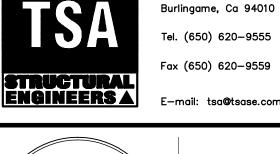

433 Airport Blvd, Ste 106E

