



**COMPETITION POOL SECTION**

1/8"=1'-0"

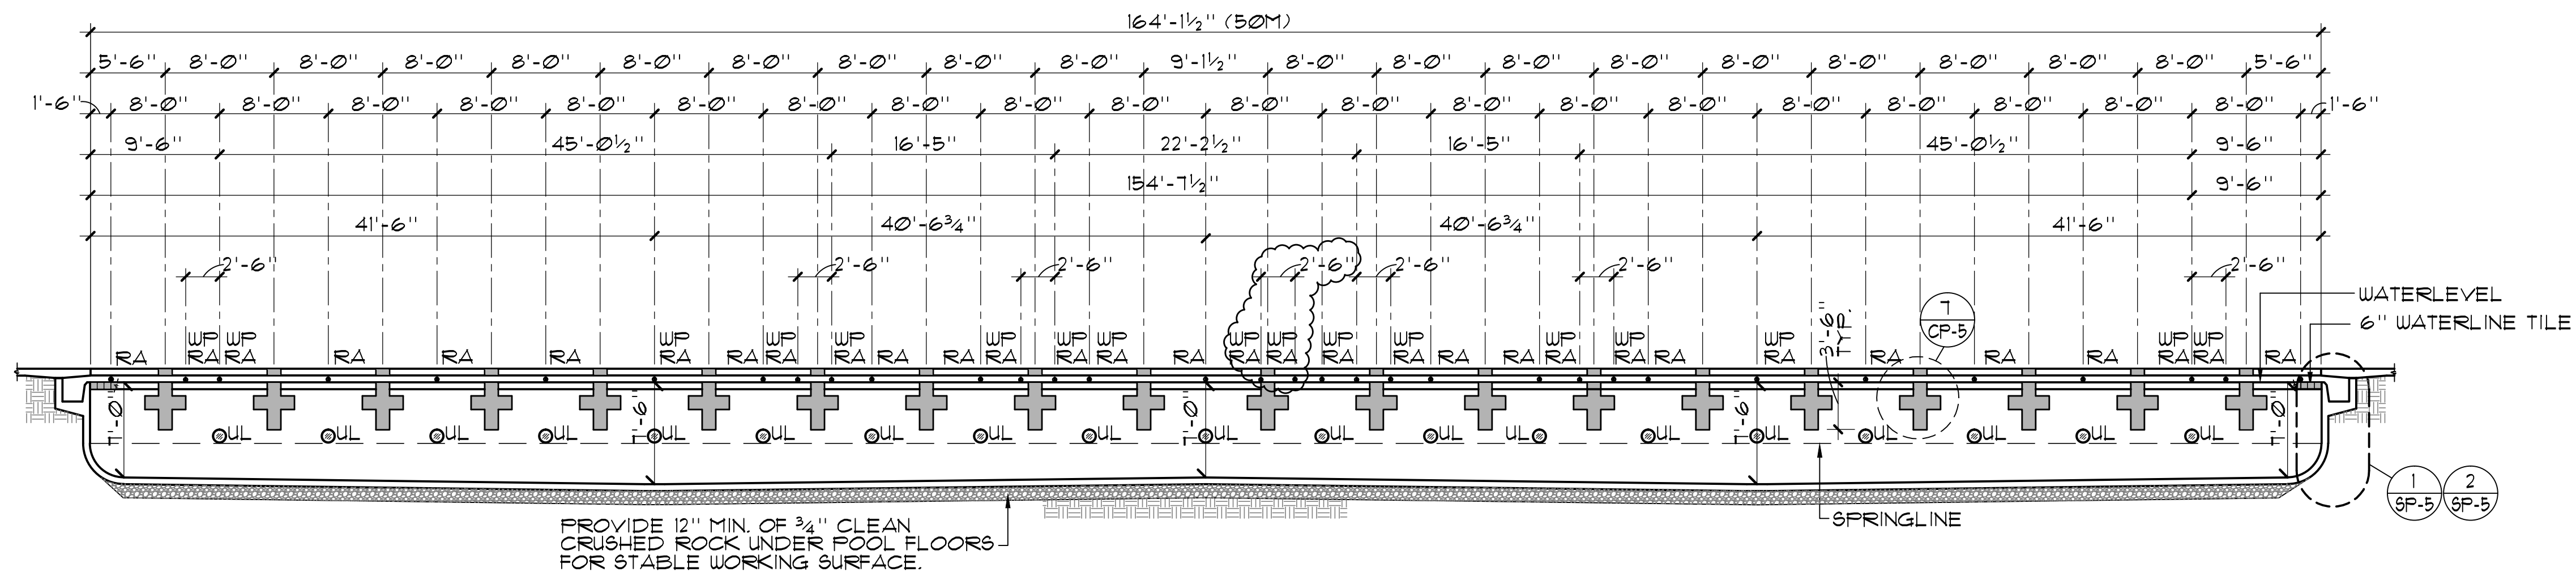


**COMPETITION POOL SECTION**

1/8"=1'-0"

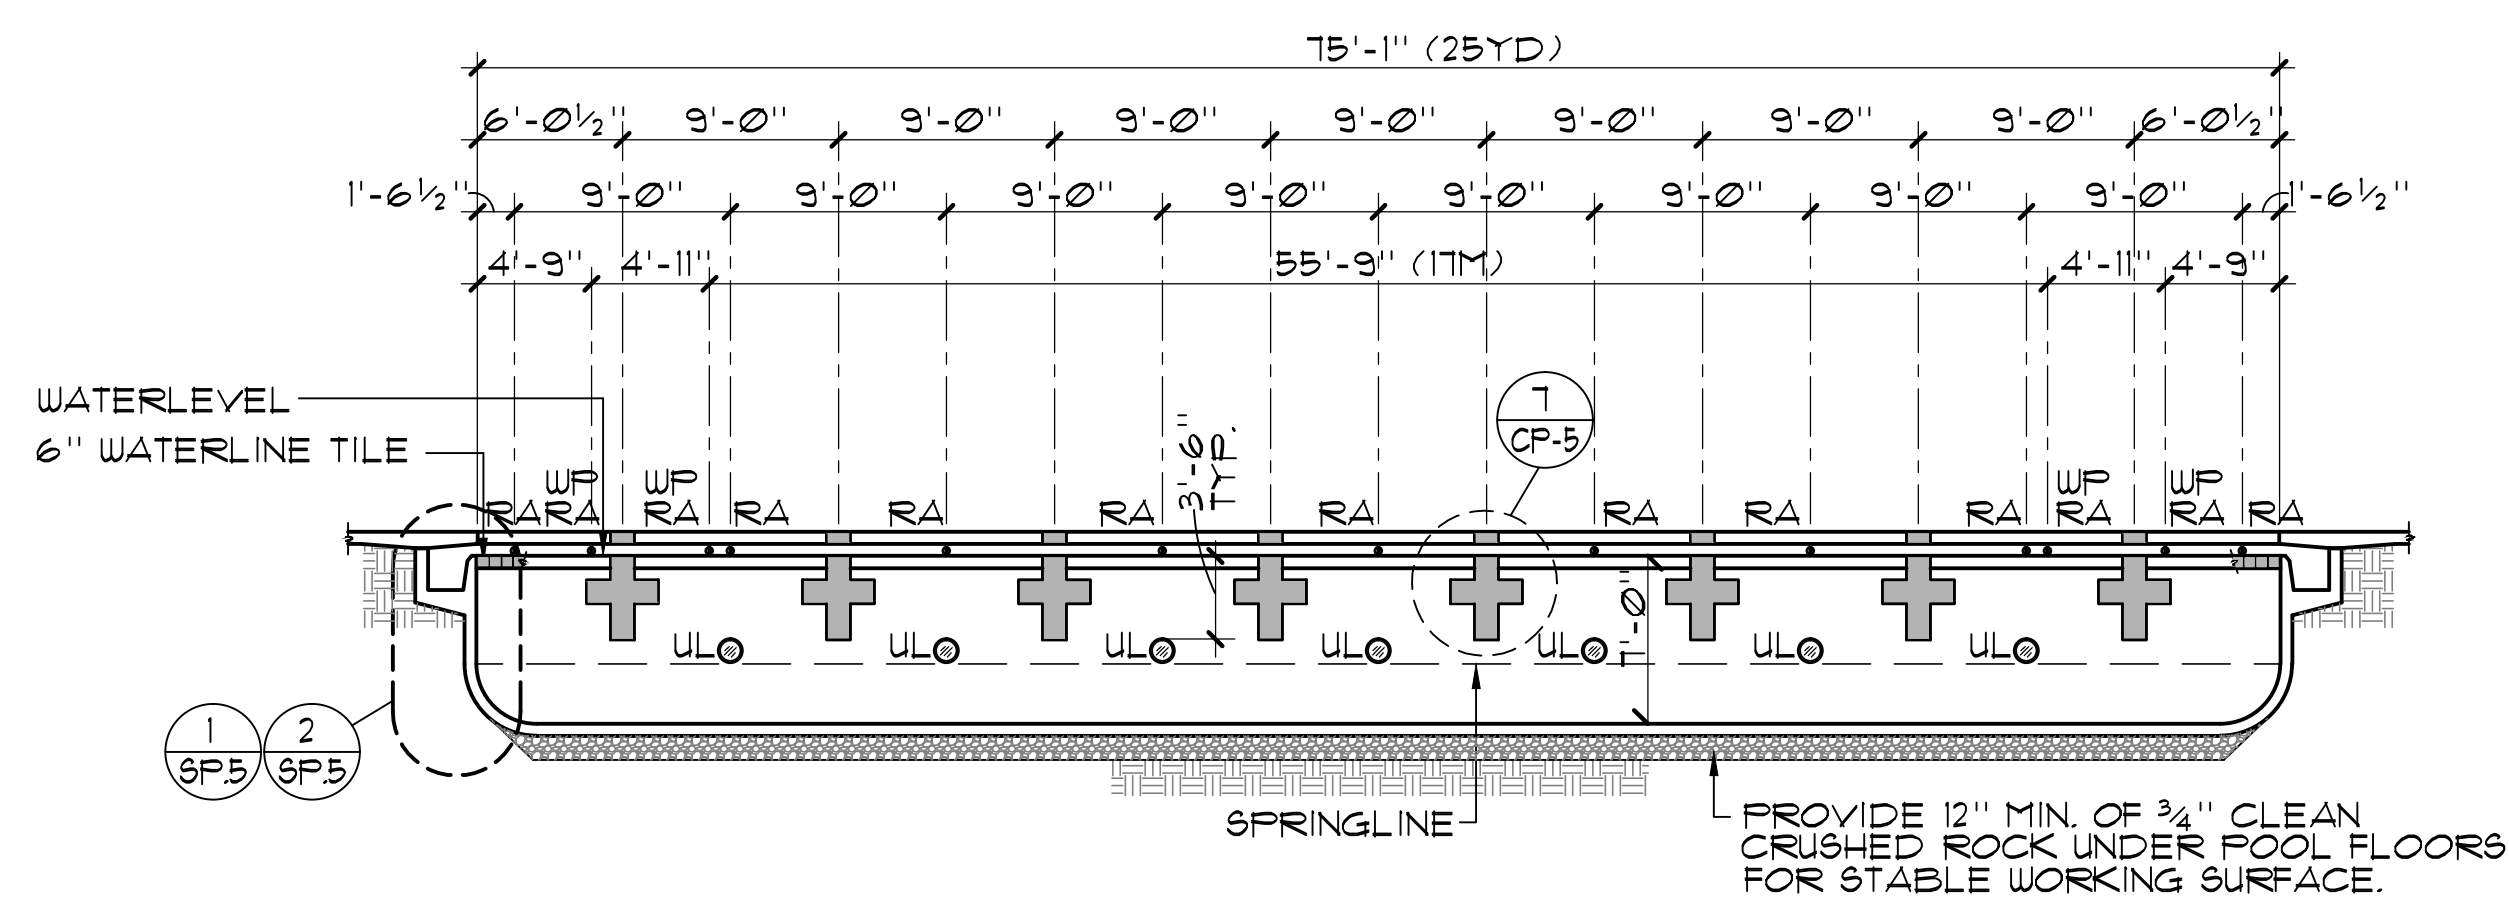



**COMPETITION POOL SECTION**

1/8"=1'-0"

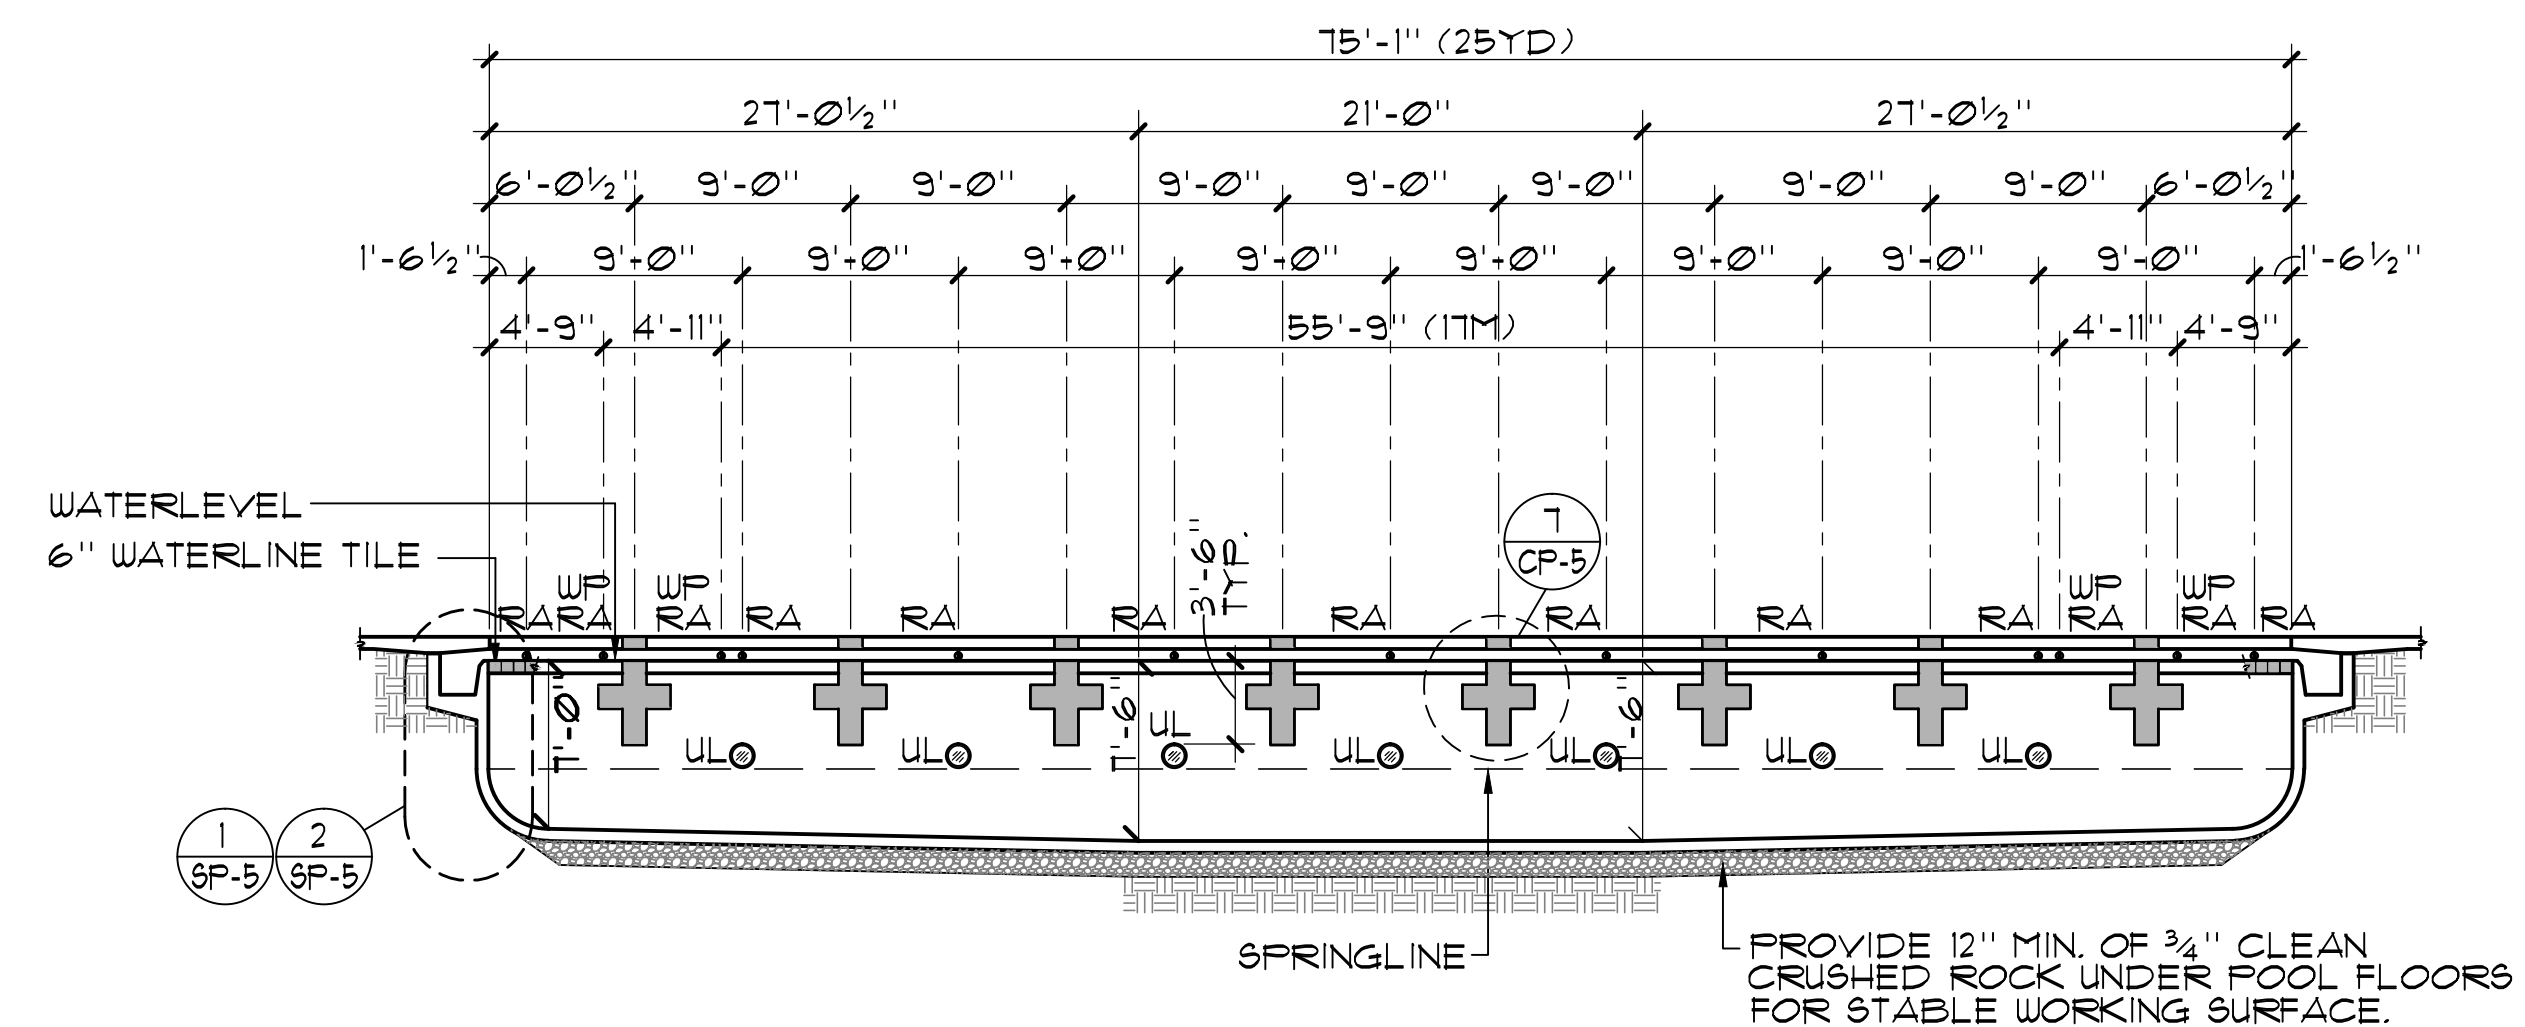

**COMPETITION POOL SECTION**

1/8"=1'-0"

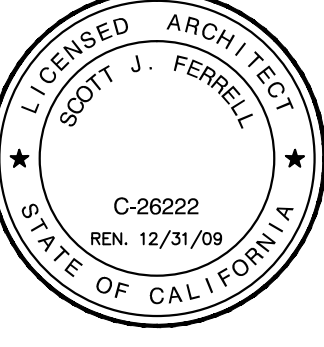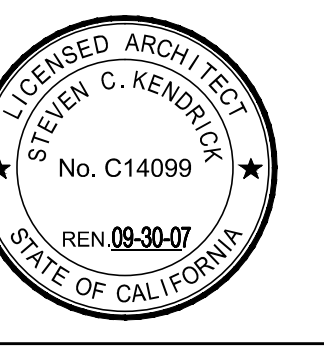

IDENTIFICATION STAMP  
 DIV. OF THE STATE ARCHITECT  
 OFFICE OF REGULATION SERVICE  
 APPL. #: 01-110987  
 AC: FLS SS  
 DATE: \_\_\_\_\_  
 FILE NUMBER: 41-C1

This and all other project documents and all their contents, methods and design developments herein are the property of LPA, Inc. All project documents are the property of LPA, Inc. LPA and KH shall not be held liable and in whole or in part for any project or design work as described in the contractual agreement between LPA and Client. LPA hereby grants license to use any project document for informational or modification purposes only. LPA and KH shall not be held liable for any project document or modification made by any third party. LPA and KH shall not be held liable for any project document or modification made by any third party. LPA and KH shall not be held liable for any project document or modification made by any third party.

© Copyright 2008

College of San Mateo  
 Site Package  
 San Mateo, CA  
 Developed for  
 San Mateo County Community College District

Revision	Description	Date

Revision	Description	Date
1	DSA SUBMITTAL	19 SEPT 2008
2	DSA FINAL	09 APRIL 2009
3	PROJECT RECORD DRAWING	JUNE 2011

Job No.	27082.301
Date	09 APRIL 2009
Drawn by	NFC
Checked by	SJF
Scale	1/8"=1'-0"

COMPETITION POOL SECTIONS

**CP-4.1**