




1 CHEMTROL FILTER RELAY OUTPUTS NO SCALE

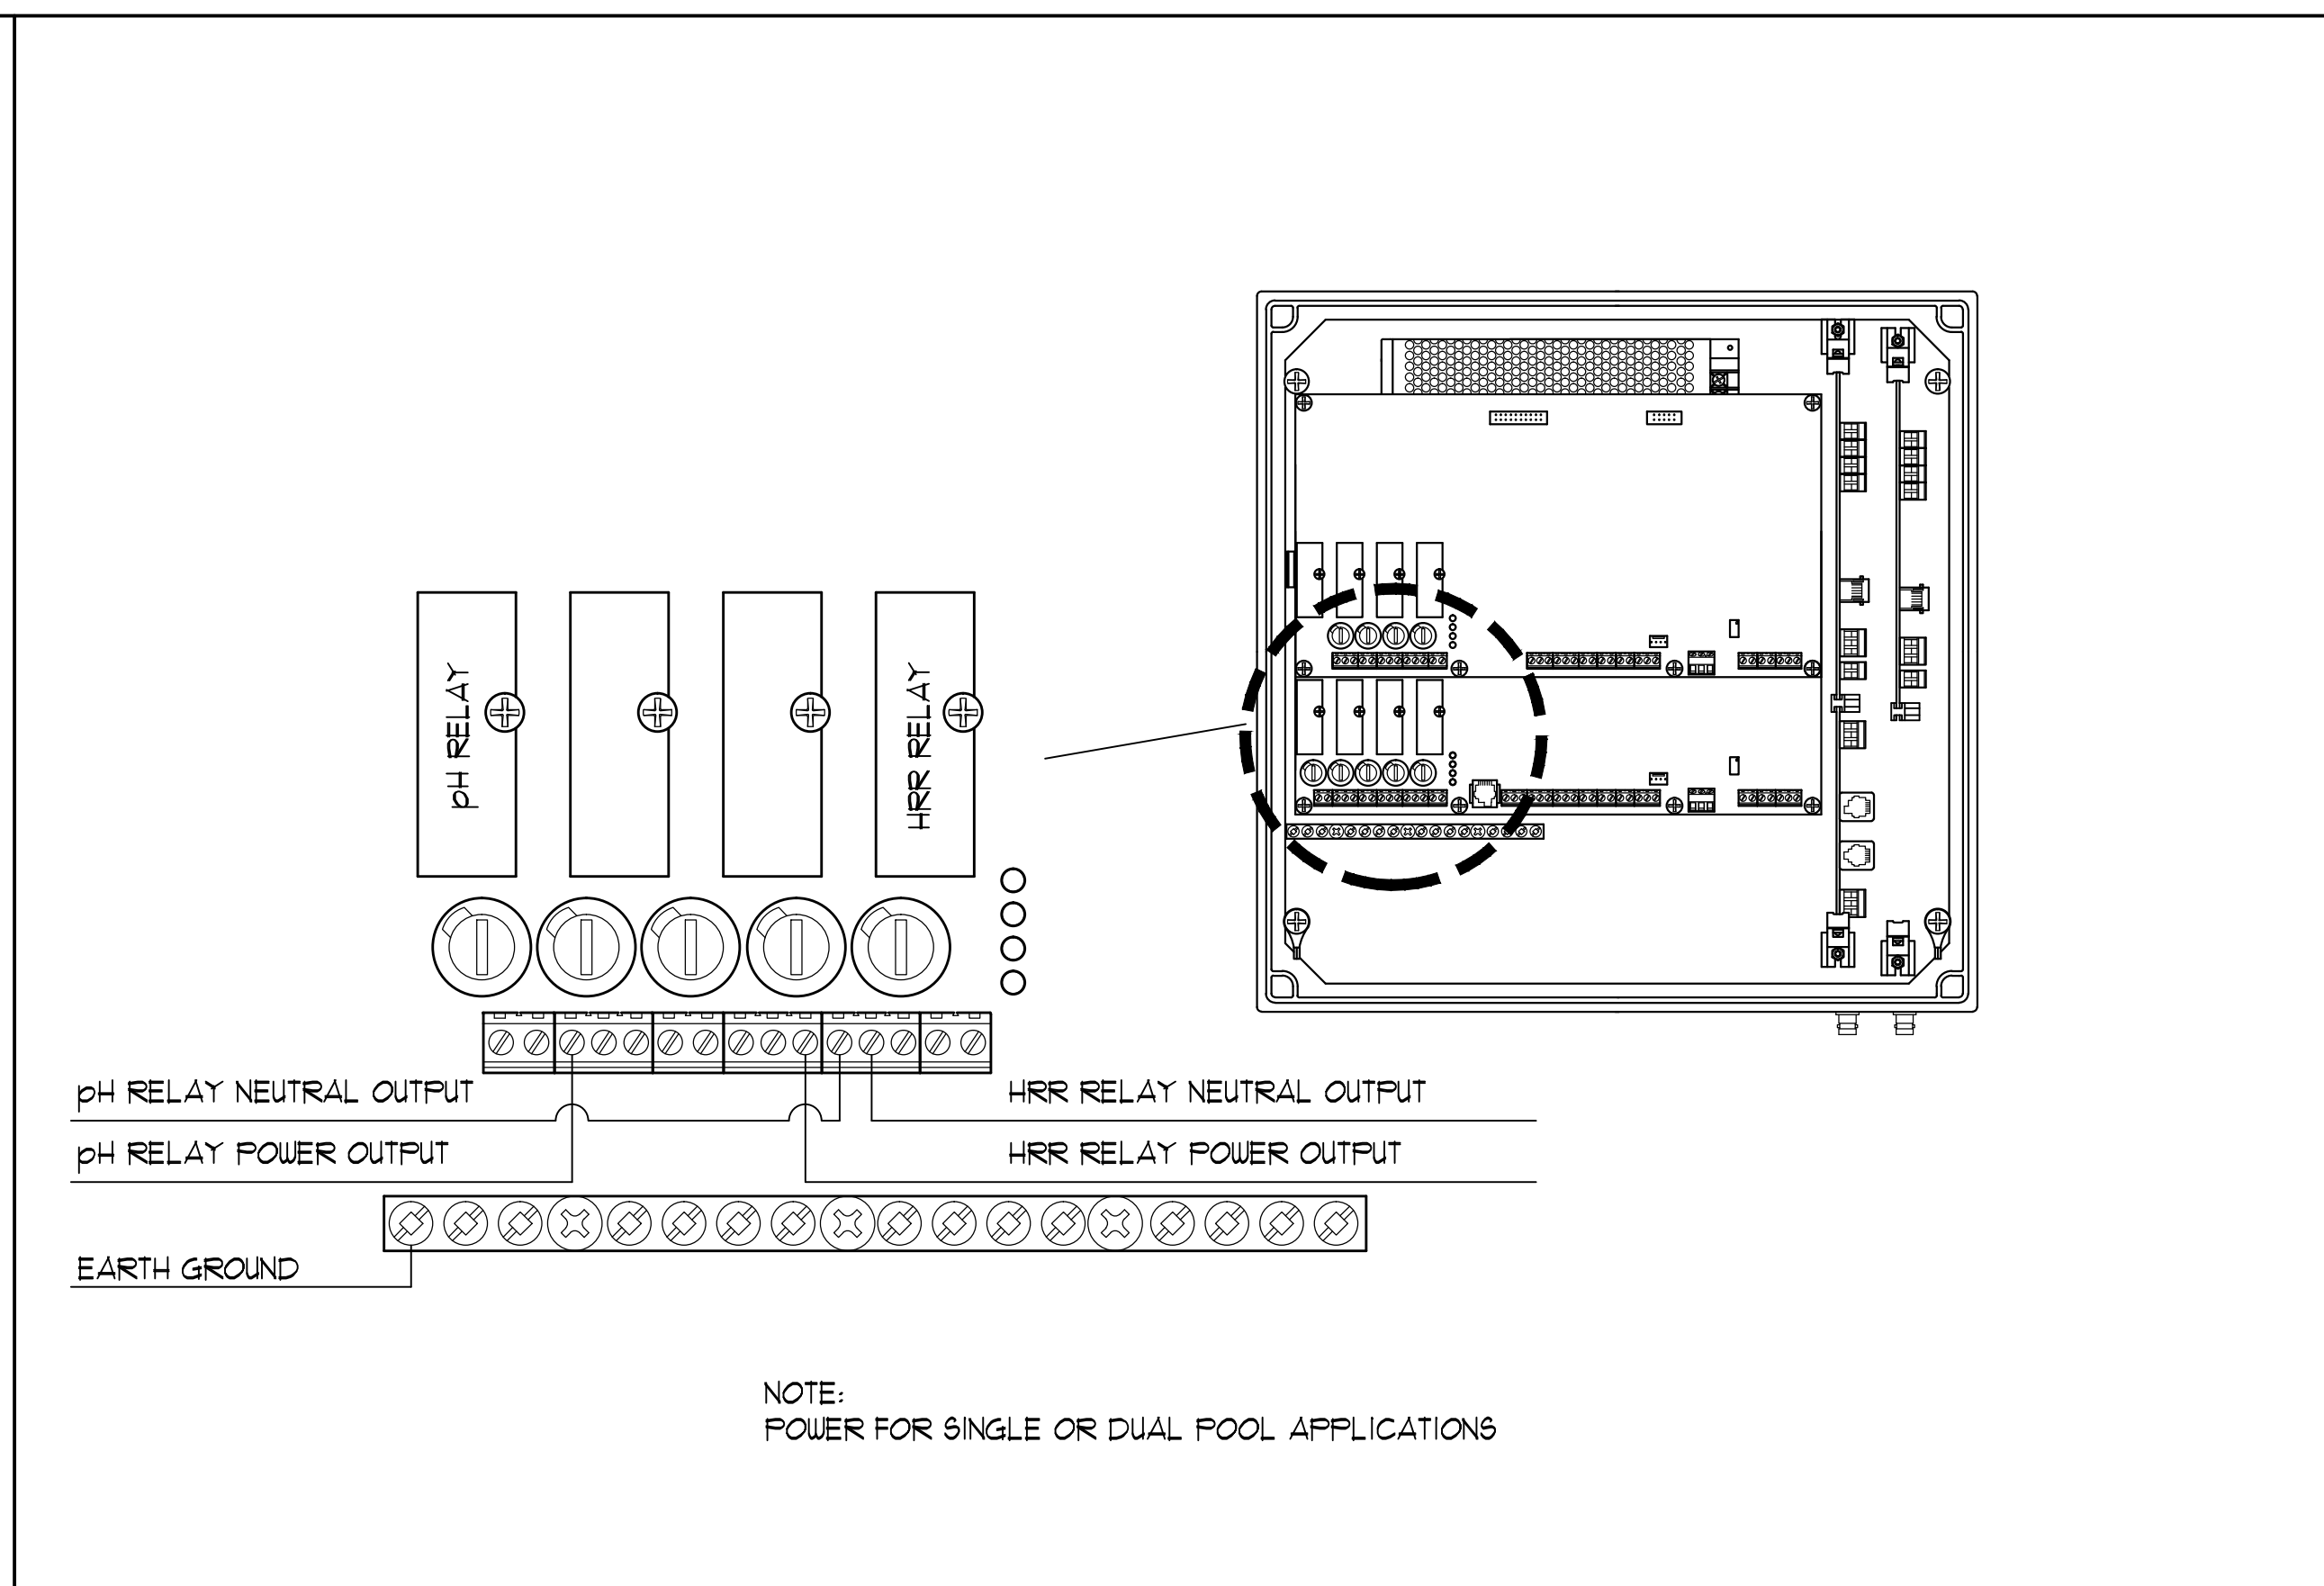


2 CHEMTROL RELAY OUTPUT NO SCALE

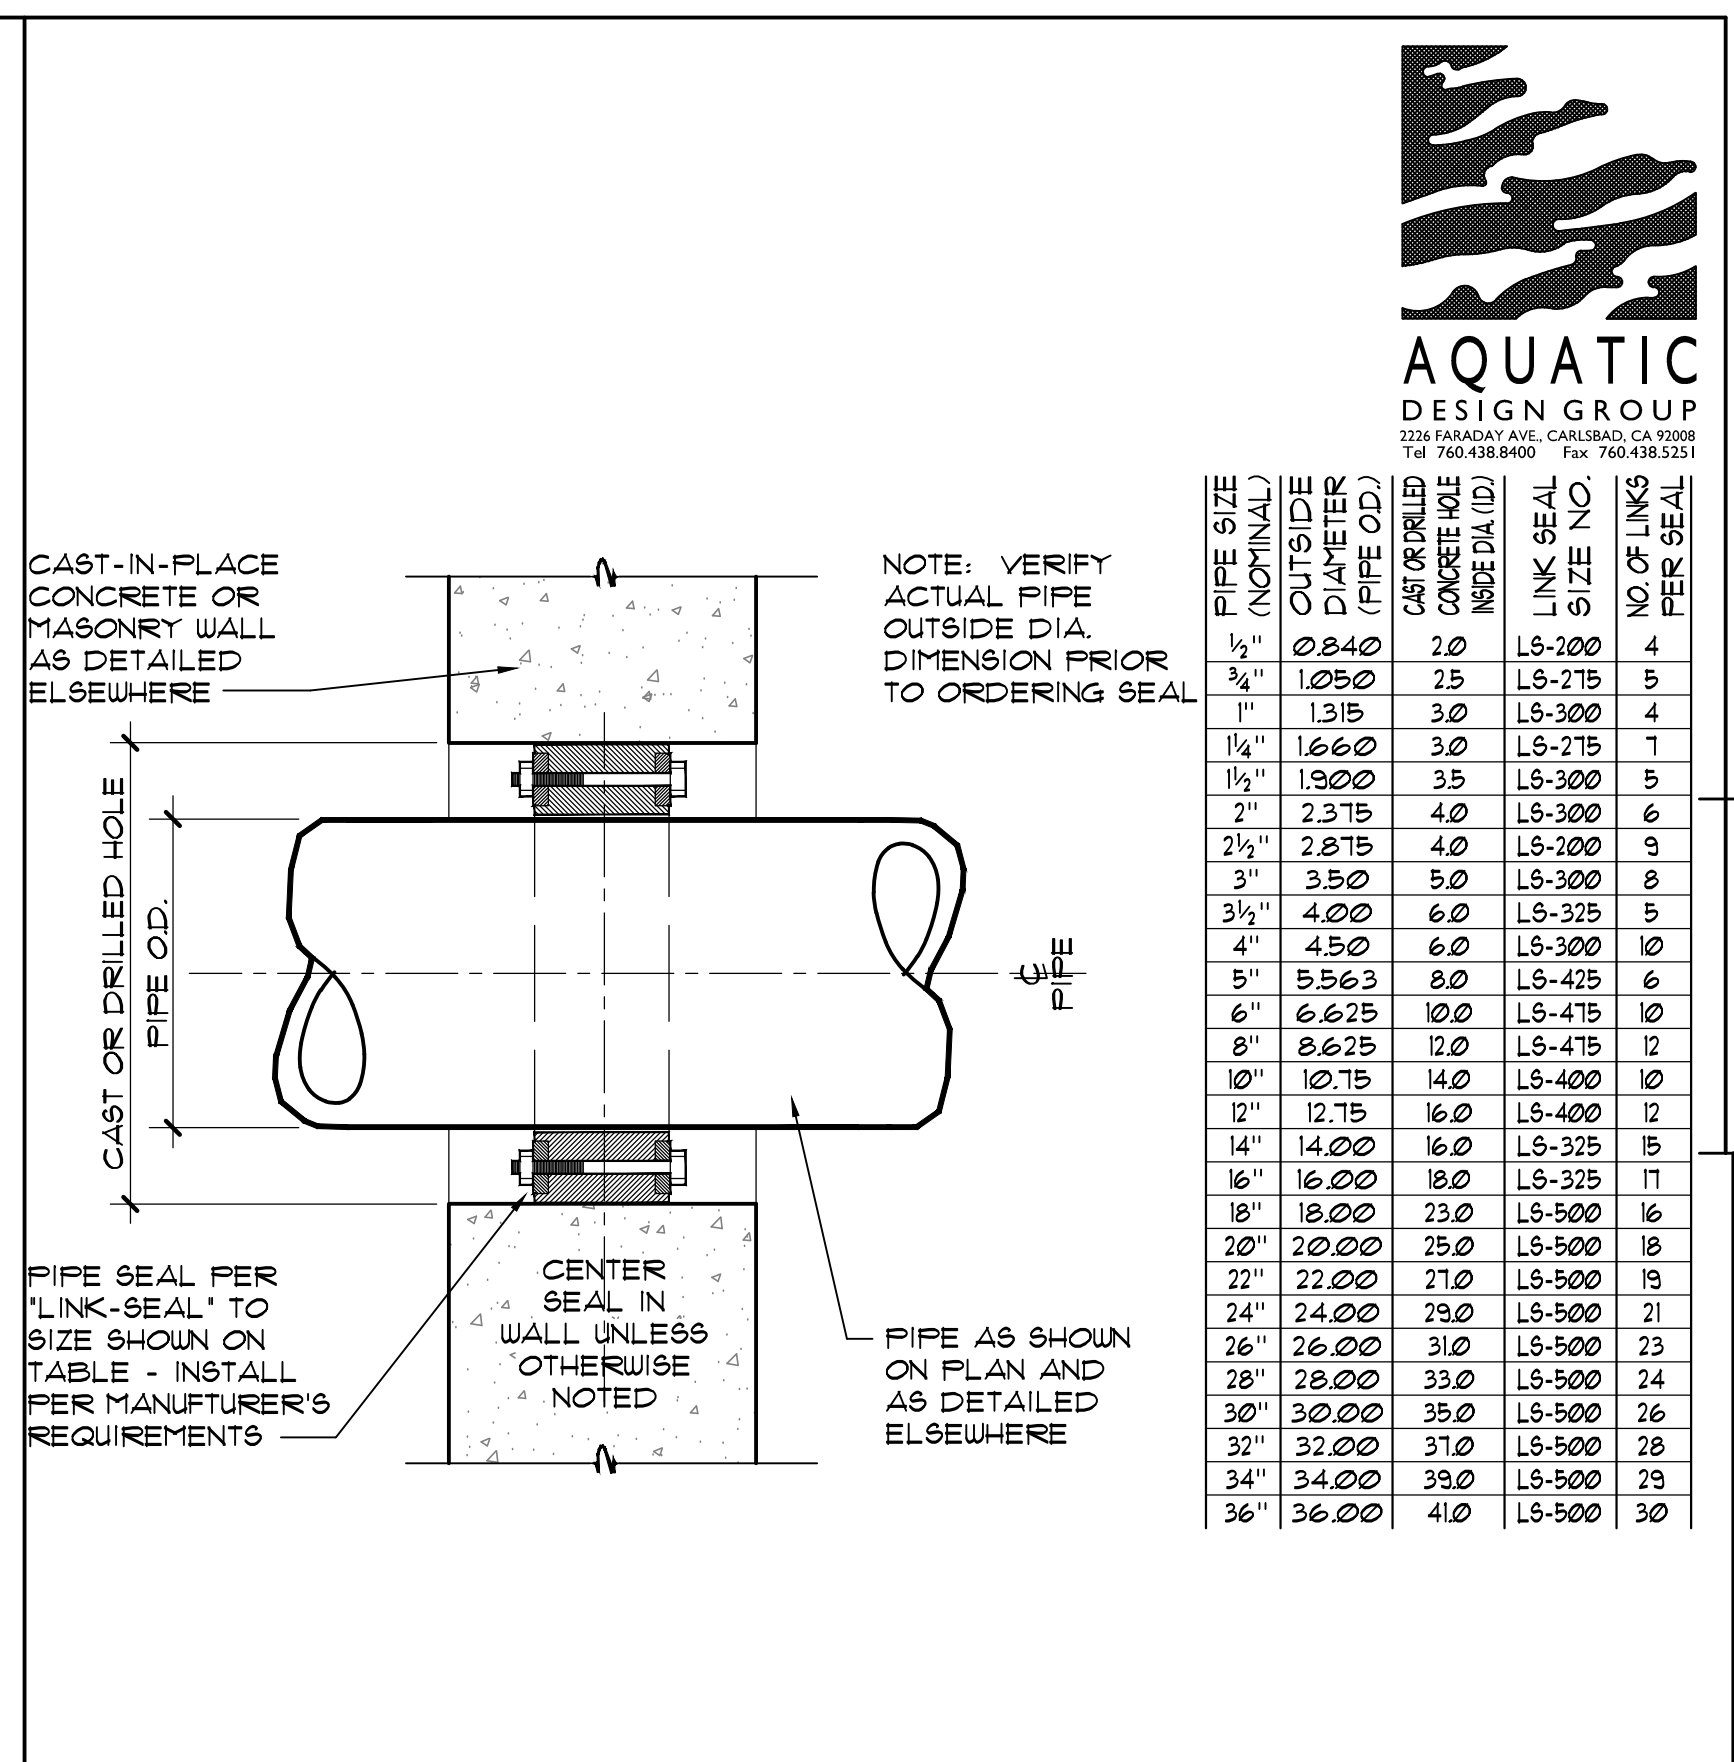


5 PIPE SEAL TO WALL / FLOOR NO SCALE

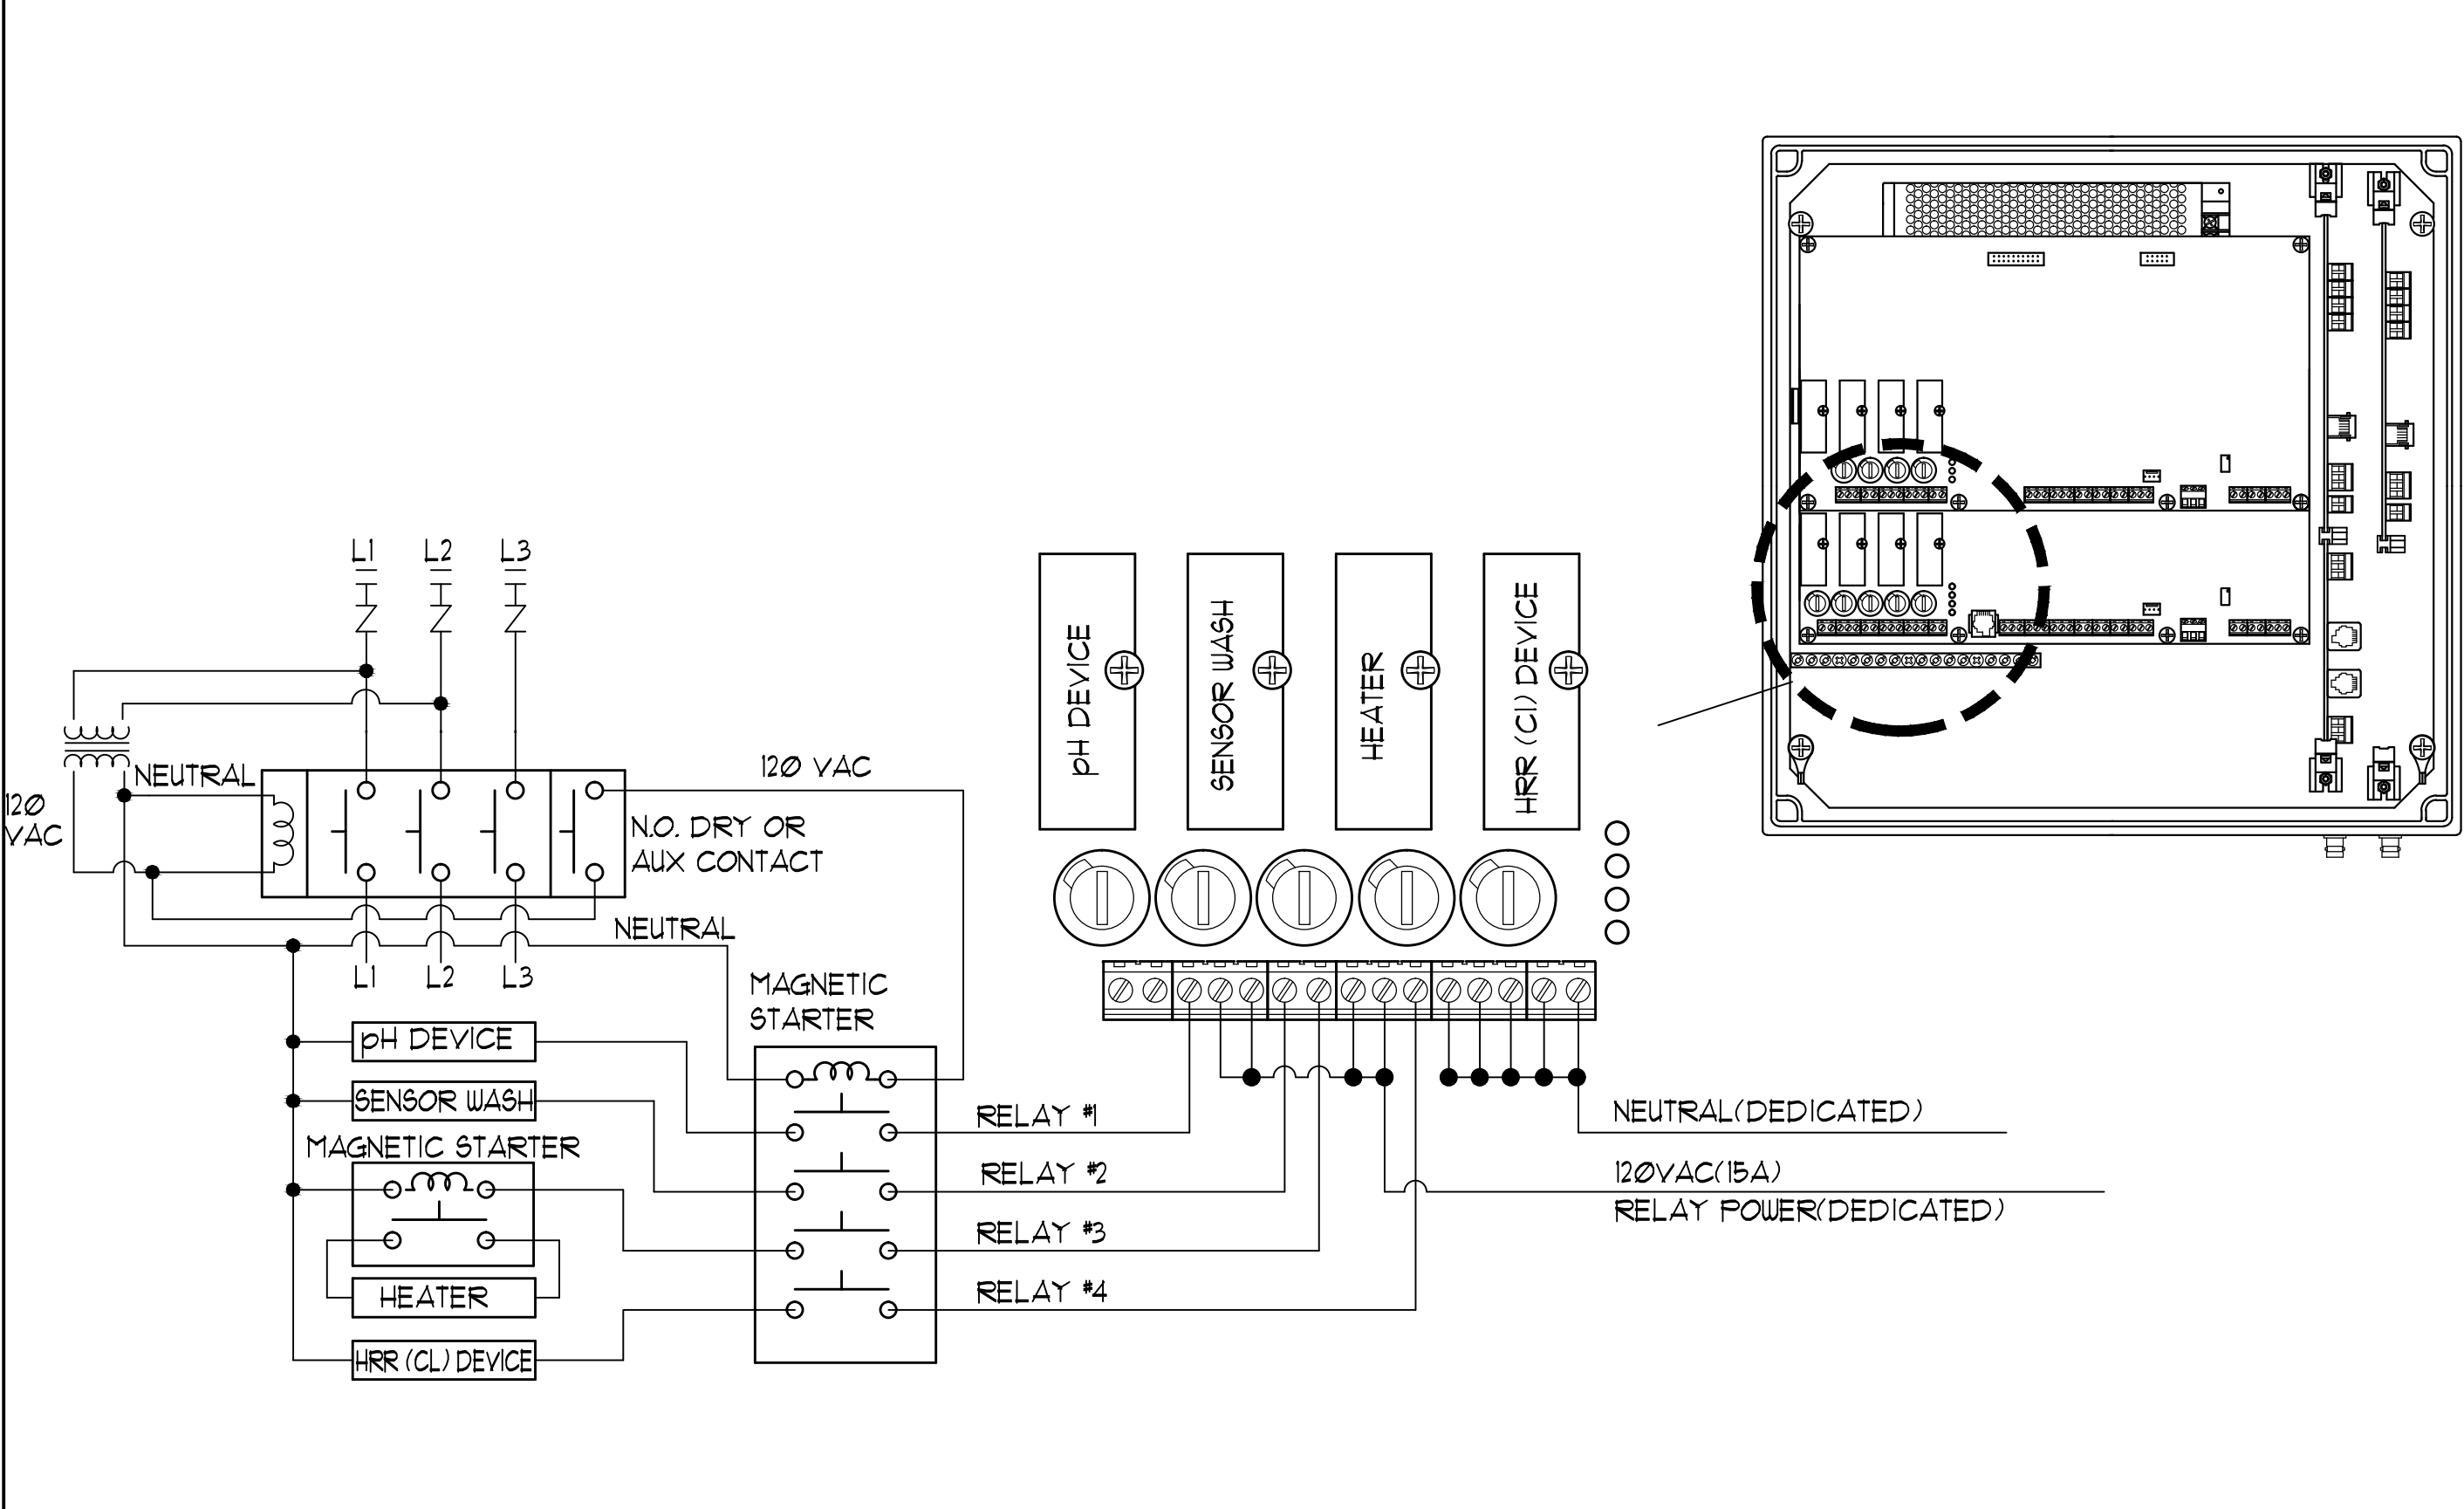


3 CHEMTROL INTERLOCK NO SCALE

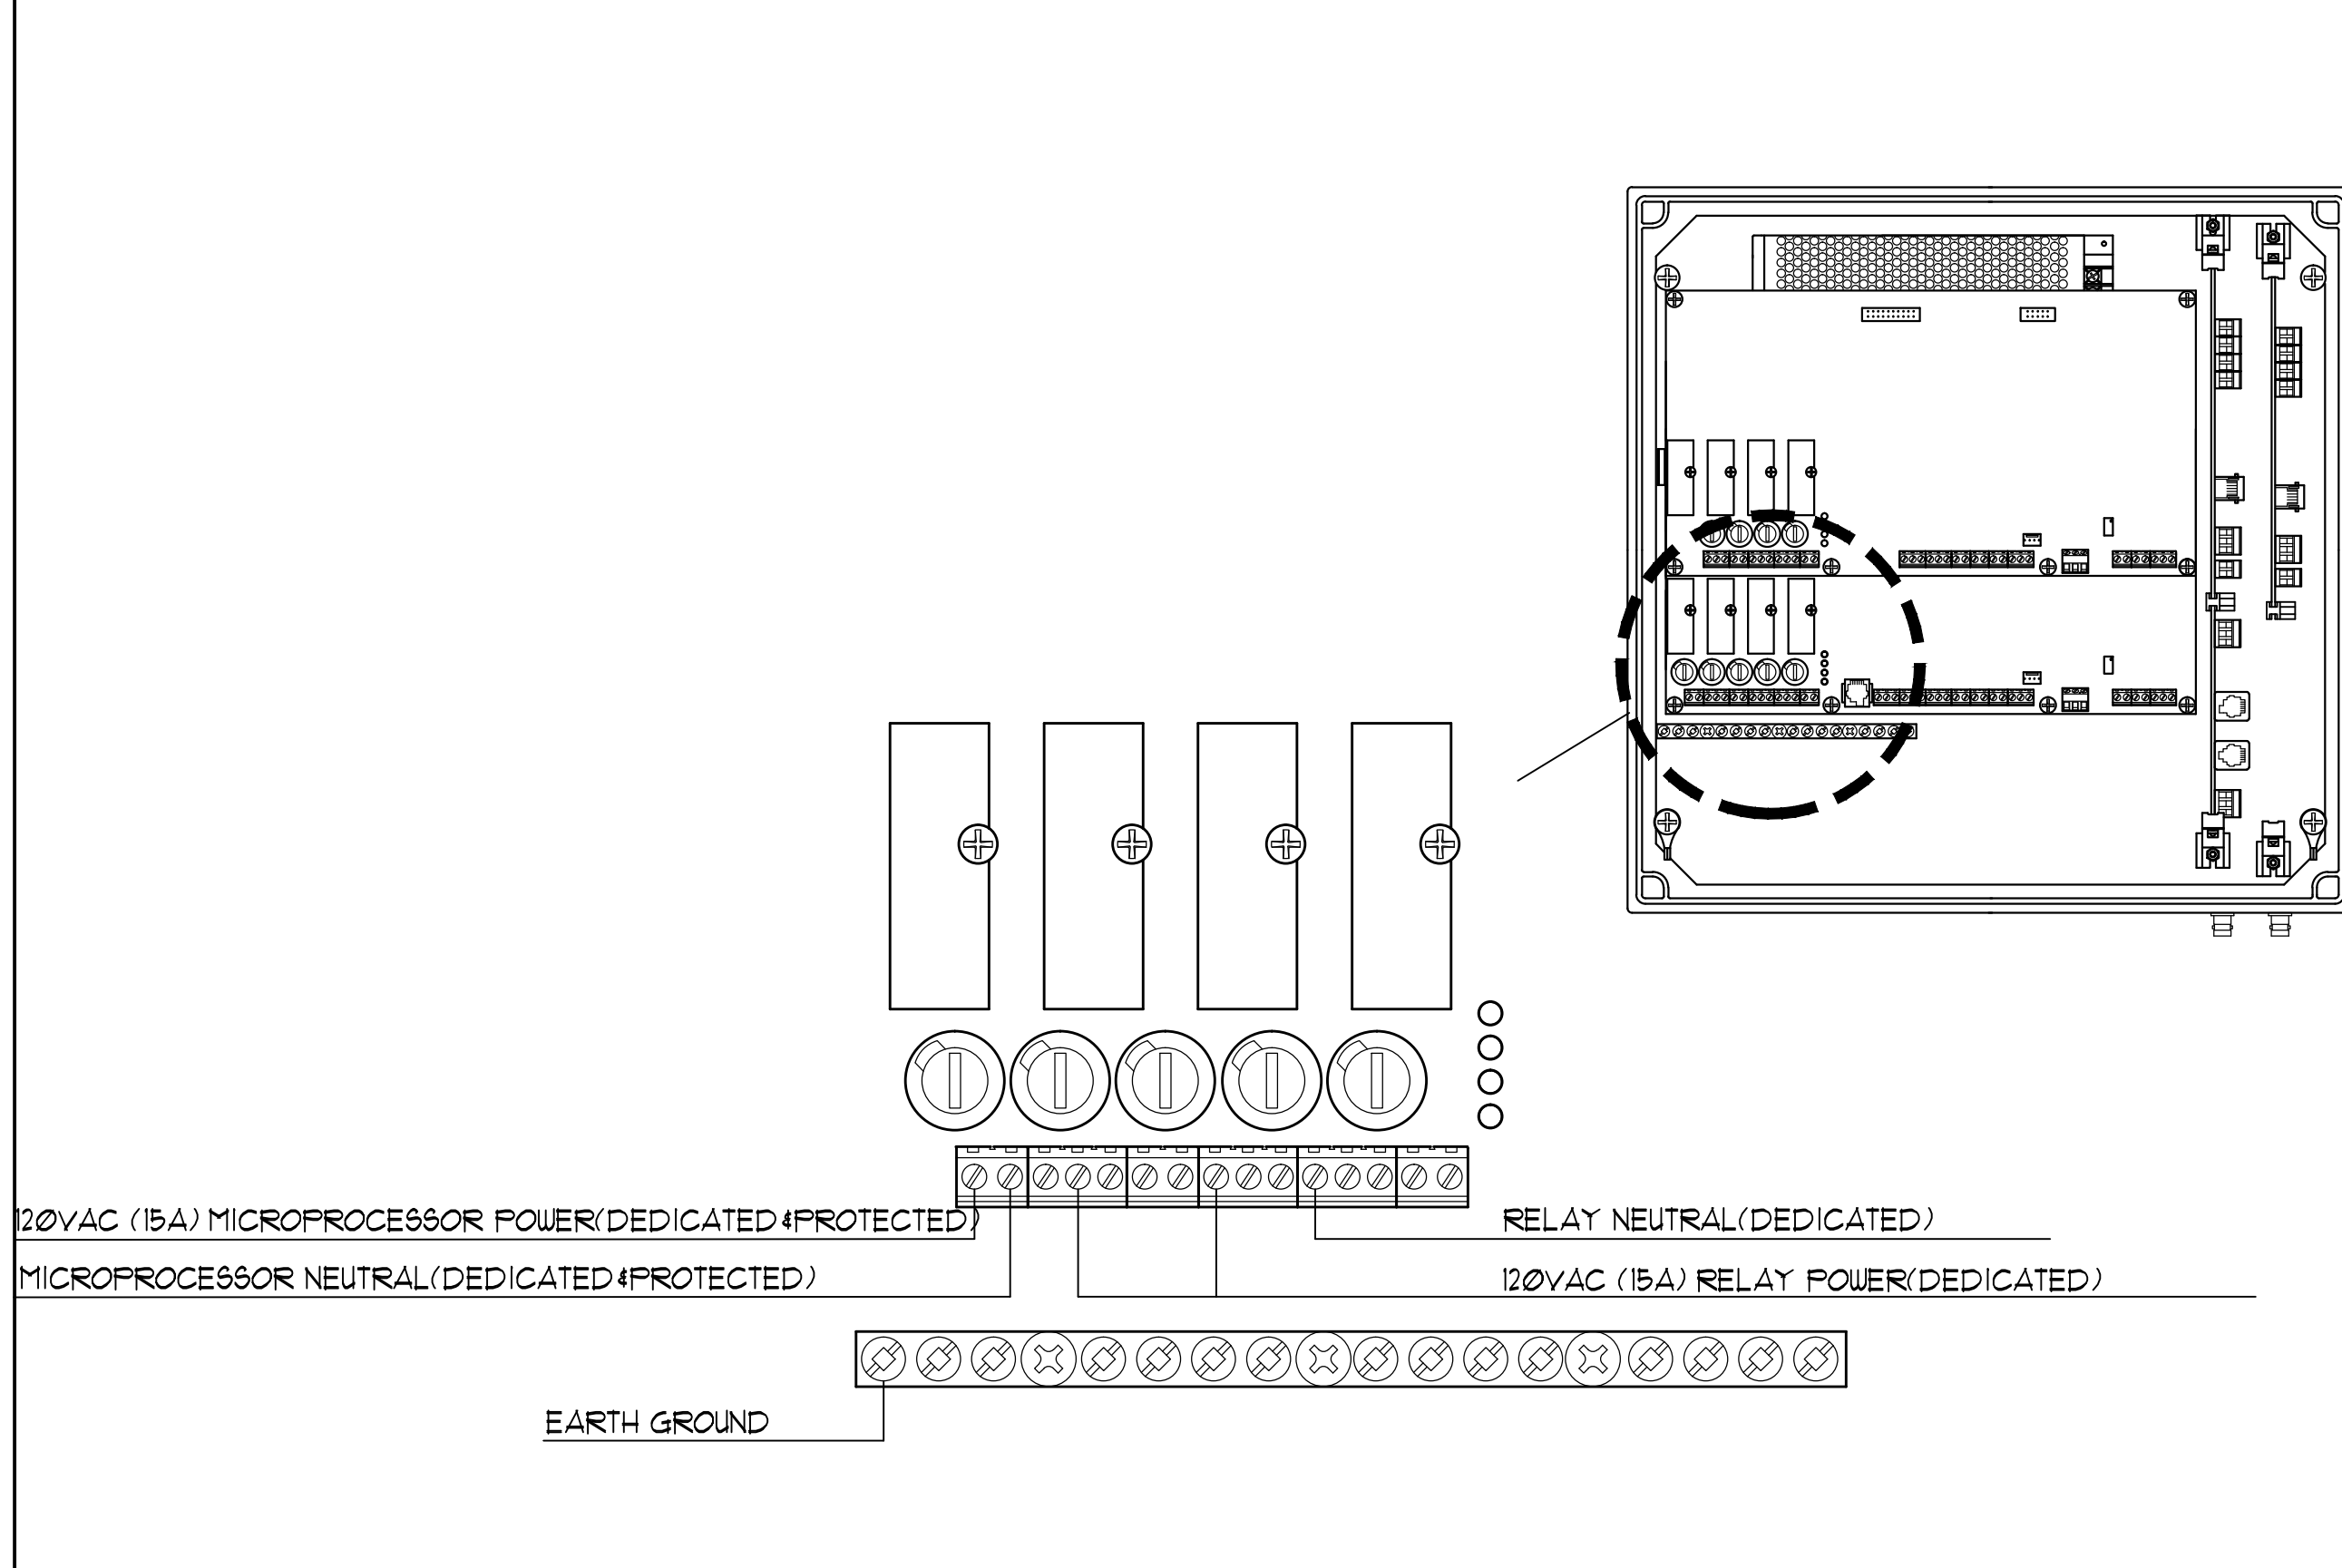


4 CHEMTROL INPUT POWER NO SCALE

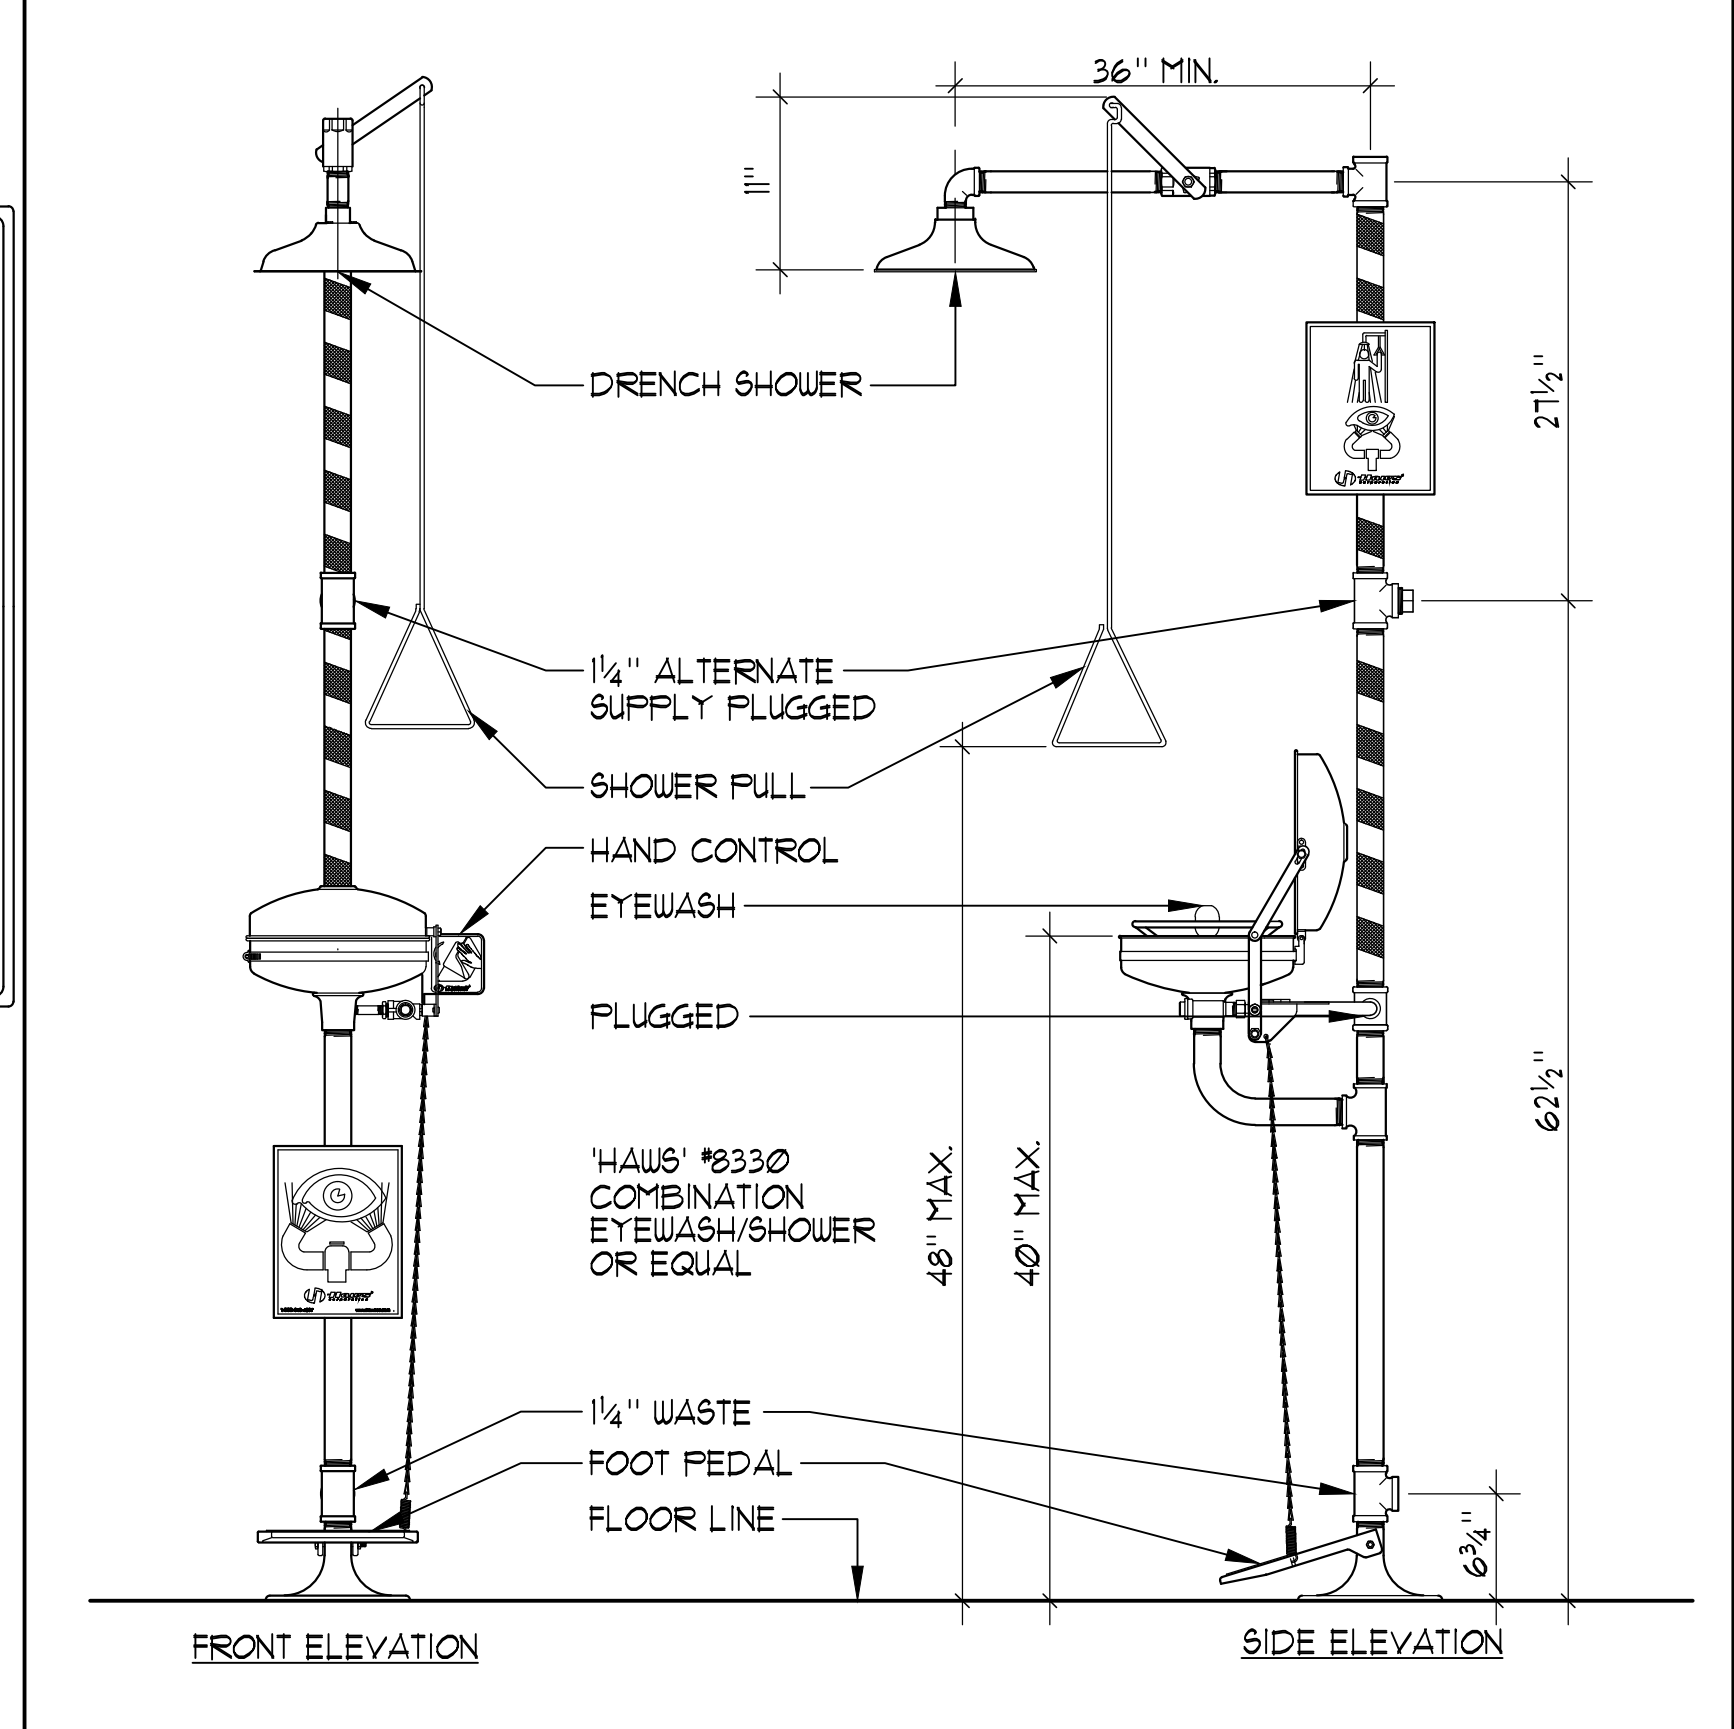

6 EMERGENCY EYEWASH/SHOWER NO SCALE

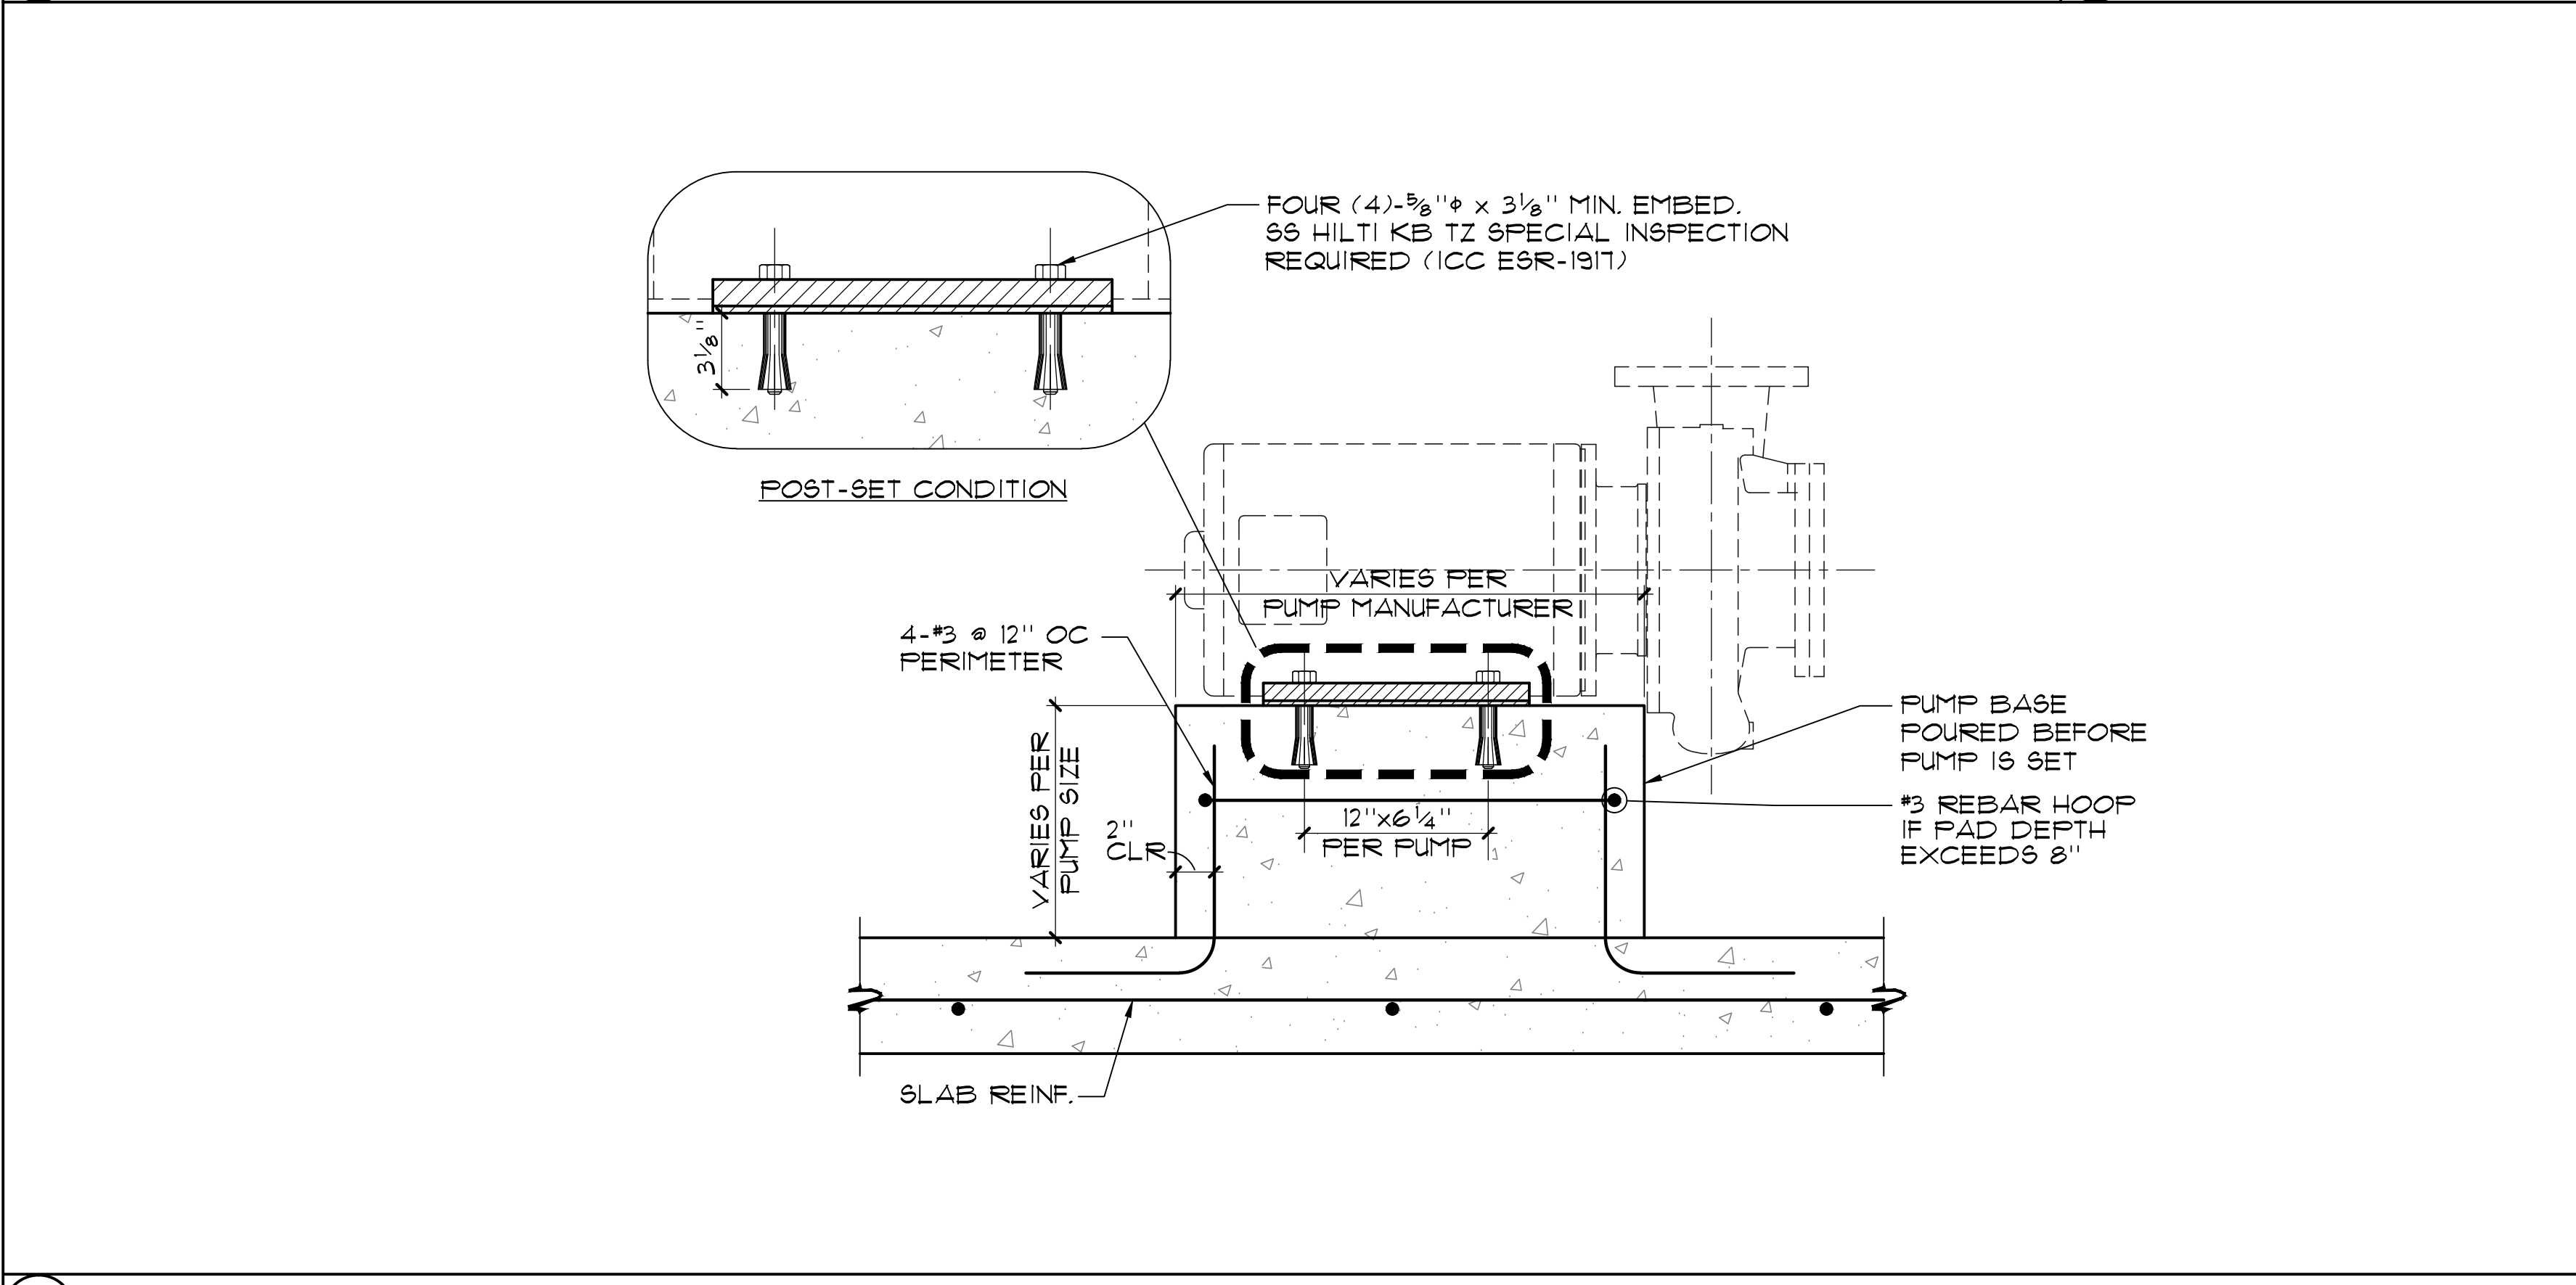

7 PUMP ANCHORAGE NO SCALE

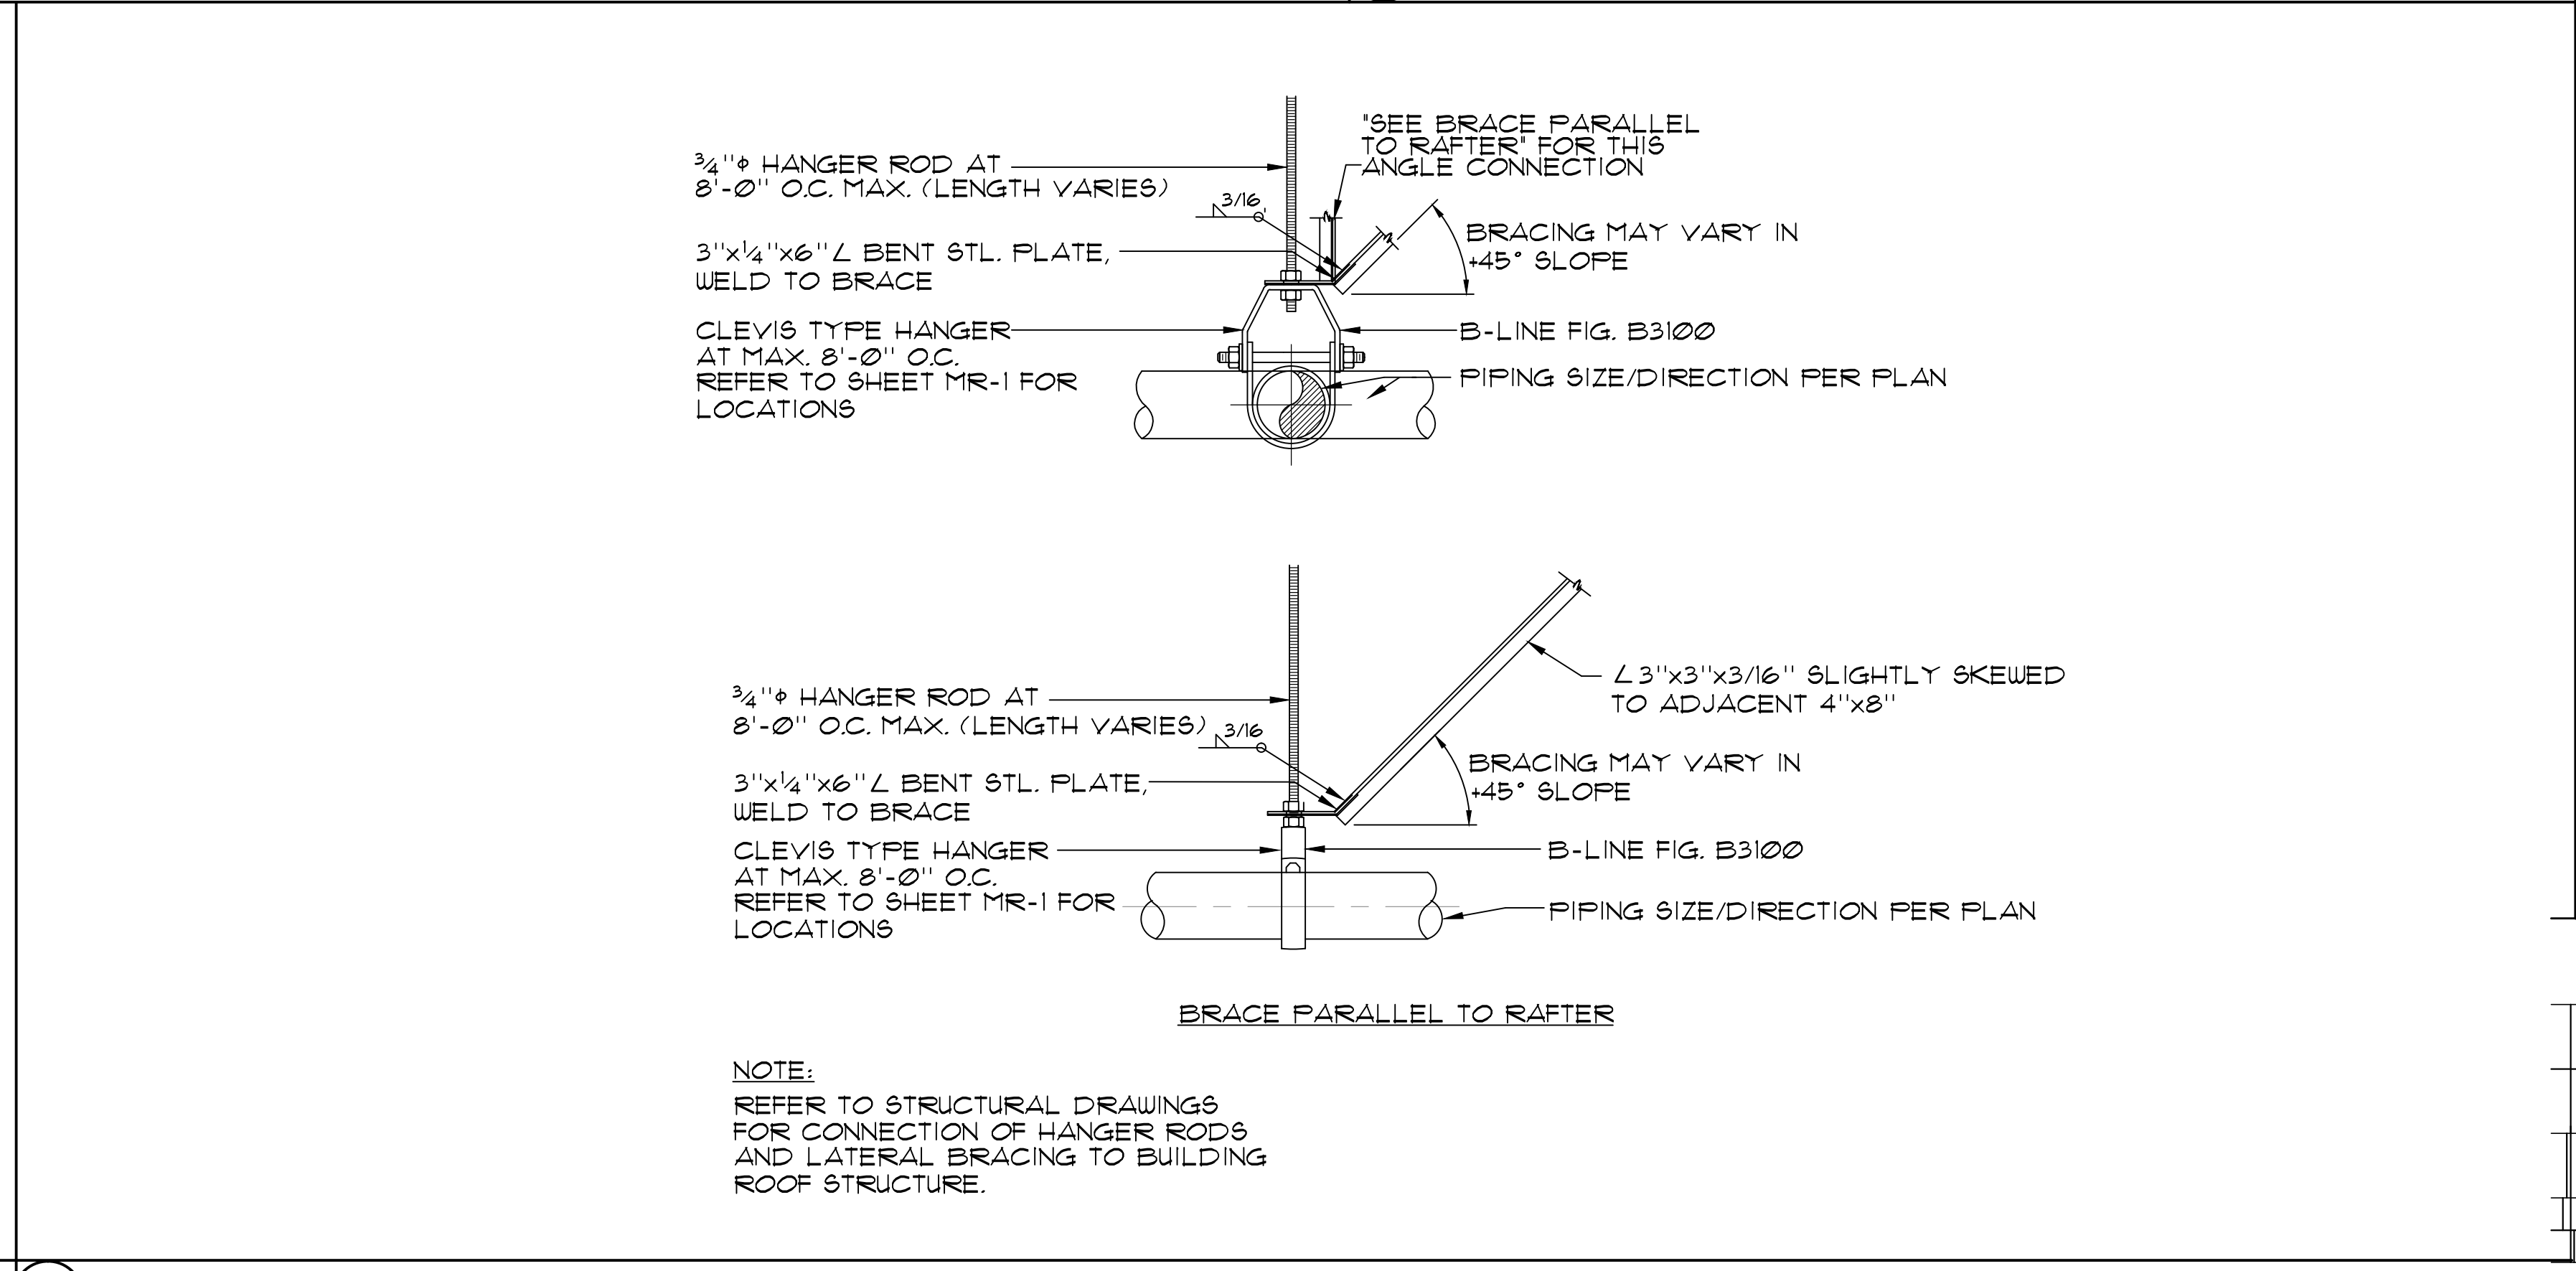

8 PIPING HANGER DETAIL NO SCALE