

Revision	Description	Date
1	PROVIDE C.A.M. RISEN	07/27/09
2	PROVIDE C.A.M. RISEN	07/27/09
Revision	Description	Date
1	100% Design Development	07/27/09
2	100% Design Development	07/27/09
3	100% Design Development	07/27/09
Job No.	Date
1000000000	March 2009
1000000000	March 2009
Job No.	Date
1000000000	March 2009
1000000000	March 2009
LEGEND: OCCUPANCY SENSORS

- ⊕ CI-200
- ⊕ DT-300
- P<sub>1</sub> PW-100
- P<sub>2</sub> PW-200
- ⊕ UT-300-1
- ⊕ UT-300-3


**GENERAL NOTES**

- A. ALL 277V, NORMAL LIGHTING DEVICES SHALL BE CIRCUITED TO PANEL "3HL1", U.O.N.
- B. ALL 277V, EMERGENCY LIGHTING DEVICES SHALL BE CIRCUITED THRU EMERGENCY LIGHTING INVERTER, TO PANEL "1EHL1", U.O.N.
- C. ALL 120V, NORMAL LIGHTING DEVICES SHALL BE CIRCUITED TO PANEL "3LN11/3LN12", U.O.N.
- D. EXTERIOR LIGHT FIXTURES SHALL BE CONTROLLED VIA LOP AND BY PHOTOCELL LOCATED ON BUILDING ROOF FACING NORTH. CONTROLS SHALL BE INTERFACED WITH BMS.

**SHEET NOTES**

- ⊕ NOT USED.
- ⊕ NORMAL POWER FEED END.

1 Lighting Plan - Level 3 - North  
E2.05 SCALE: 1/8"=1'-0"

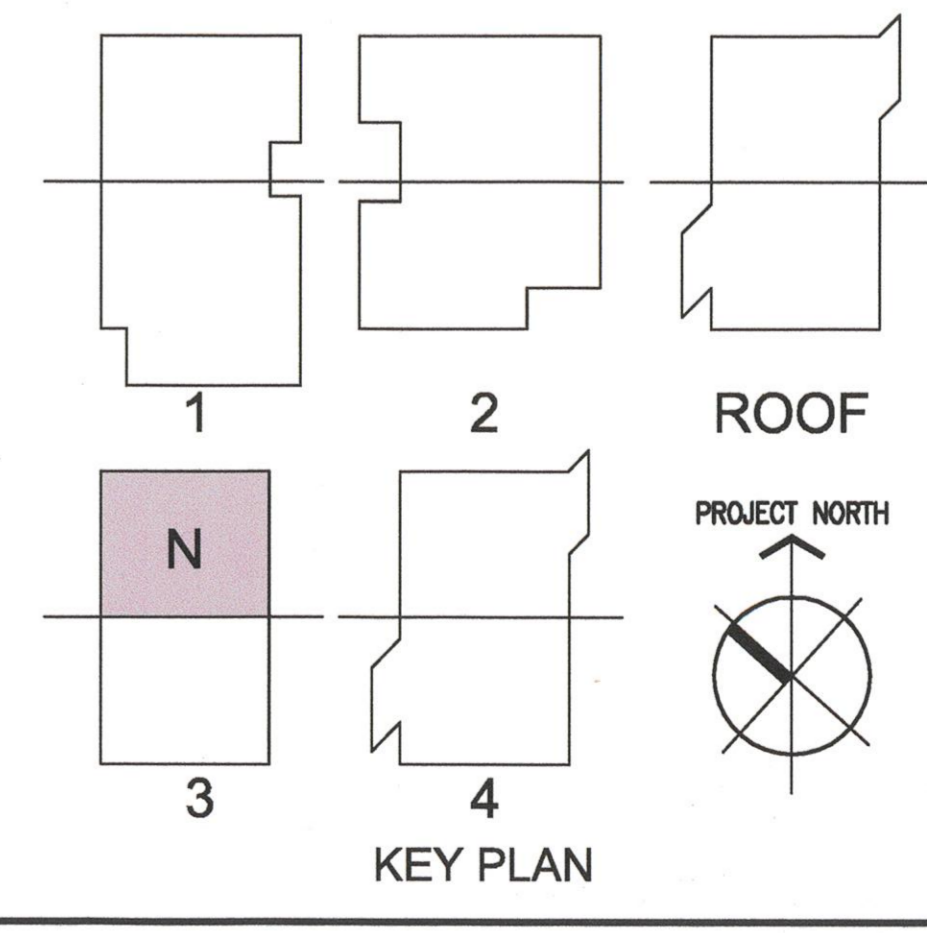

**DRAWING OF RECORD**  
ROSENBLUM ELECTRIC, INC.  
DATE: 01-21-2011