
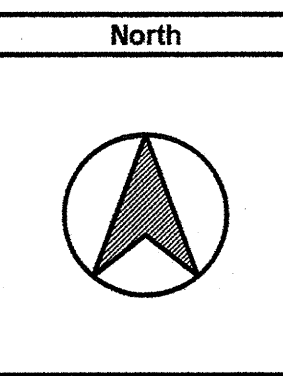


3RD FLOOR BLDG. "5"  
 (1ST FLOOR BLDG. "8")  
 PIPING PLAN  
 1/8" = 1'-0"

3RD FLOOR REFLECTED PLAN  
 Scale: 1/8" = 1'-0"

A. Approved as noted for Architectural Review  
 B. Review & Resubmit  
 C. Rejected  
 This drawing is for general information with plans and specifications only. Any deviation from these plans shall be noted by the submittal form and returned. Review shall not constitute a complete check of structural drawings or other drawings to verify the accuracy of structural requirements for the project. It is the responsibility of the submittal form reviewer.  
 21/California No. 41897 Canada College 5&6 Renovations  
 By: Andy Hale Date: 8/24/2010  
 Submittal Reference No. 21 000-0001-1

COORDINATION DRAWING SIGN-OFF			
TRADE	CONTRACTOR	SIGNATURE	DATE
Electrical			
Fire			
General			
HVAC			
Plumbing			
Architect			

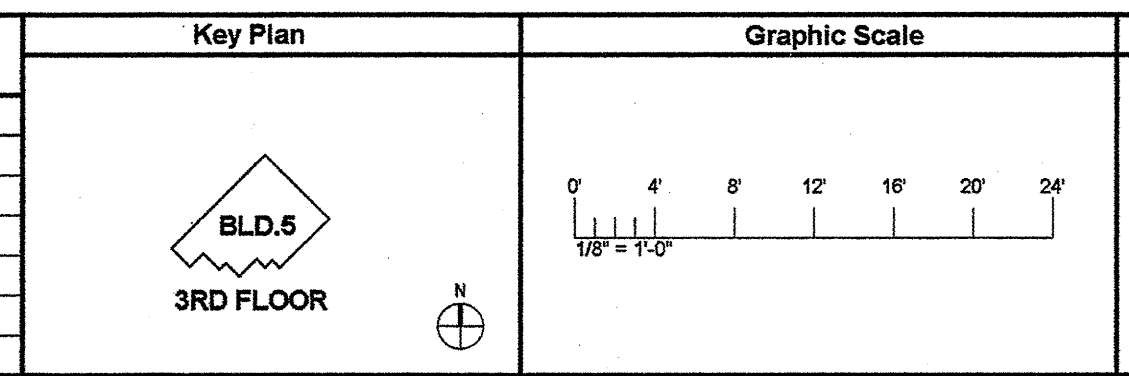


Revisions			
Rev	Date	Designer	Notes
1	5/24/10	JC	Revision based on BCA comments dated 5/7/10

Sprinkler Head Information										
Symbol	Brand	SIN #	Model	Description	Size	Temperature	K	Finish	Escutcheon	Quantity
○	TYCO	TY231	FRB	Seely recessed	1/2"	155°	5.6	White	White	0
○	TYCO	TY131	FRB	Upright	1/2"	200°	5.6	Brass	N/A	4
○	TYCO	TY331	FRB	Concealed	1/2"	155°	5.6	Brass	White	34
○	TYCO	TY331	FRB	Pendant	1/2"	155°	5.6	Brass	N/A	36
○	TYCO	TY348	WS	Window	1/2"	155°	5.6	White	White	0

Total This Sheet 74

Standard Symbols	
○	Riser location
○	Hanger
○	Two Way Brace
○	Four Way Brace
○	Hydraulic Node
○	Line Restraint

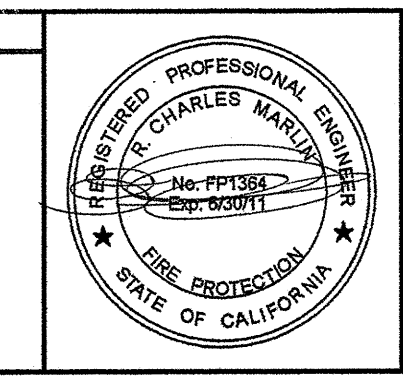

<b>TRANSBAY FIRE PROTECTION, INC.</b> License No. 629778 2162 Rheaun Dr. Redwood City, CA 94061 (925) 945-0034 Fax: (925) 945-0110		<b>FP-04</b>
Job No.: 1025 Date: 4/12/10 Designer: JC Checked: CM Scale: 1/8" = 1'-0"	<b>CANADA COLLEGE - BUILDING 5</b> 4200 FARM HILL BOULEVARD REDWOOD CITY, CA. 94061 3RD FLOOR REFLECTED CEILING PLAN	