

MECHANICAL SYMBOL LIST

* This is a standard list and not all symbols and abbreviations may be used.

Table containing symbols and descriptions for DUCTWORK, DAMPERS, DUCTWORK FITTINGS, PIPING VALVES, PIPING FITTINGS, PIPING SYSTEMS, and ABBREVIATIONS.

GENERAL SEISMIC NOTES

- A. PIPING AND DUCTWORK DISTRIBUTION SYSTEMS SHALL BE BRACED TO SYSTEM THE FORCES PRESCRIBED IN ASCE 7-05 SECTION 13.3 AS DEFINED IN ASCE 7-05 SECTION 13.6.8, 13.6.7, AND 13.6.5.5, ITEM 6, RESPECTIVELY.
THE BRACING AND ATTACHMENTS TO THE STRUCTURE SHALL COMPLY WITH ONE OF THE OSHPD PRE-APPROVALS WITH AN OPA #, SUCH AS MASON INDUSTRIES (OPA 349), OR ISAT (OPA 485) AS MODIFIED TO SATISFY ANCHORAGE REQUIREMENTS OF AGI 316, APPENDIX D.

GENERAL MECHANICAL NOTES

- A. COORDINATE EXACT LOCATION OF ALL CEILING DIFFUSERS, REGISTERS AND GRILLES WITH LIGHTING LAYOUT, CEILING TILE PATTERN AND WITH ARCHITECTURAL REFLECTED CEILING PLANS.
B. PROVIDE MANUAL VOLUME DAMPERS TO FACILITATE PROPER BALANCE OF THE AIR DISTRIBUTION SYSTEM. VOLUME DAMPER AT DIFFUSERS AND REGISTERS SHALL NOT BE USED FOR AIR BALANCING.

SHEET INDEX


- M0.1 MECHANICAL LEGENDS, NOTES, ABBREVIATIONS & DRAWING INDEX
M0.2 TITLE 24 MANDATORY MEASURES AND COMPLIANCE FORMS
M0.3 TITLE 24 MANDATORY MEASURES AND COMPLIANCE FORMS
M01.1 FIRST FLOOR DEMOLITION PLAN - MECHANICAL

RECORD DRAWINGS



Buntun Clifford Associates, Inc. 210 Hammond Ave. Fremont, California 94539 [T] 510.445.1000 [F] 510.445.1005 www.BCAincOnline.com

PROJECT: 2007-0731 CONTACT: Omar Hawit INTERFACE ENGINEERING 717 Market Street Suite 500 San Francisco, CA 94103 TEL: 415.489.7240 FAX: 415.489.7289 www.interfaceengineering.com

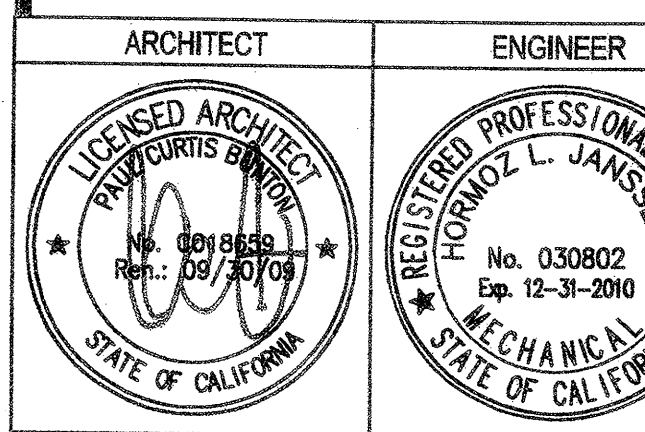

1. This sheet is part of a set and is not to be used alone. 2. This sheet is not to be used for construction unless the architect's stamp and signature appear on the drawings and the status box indicates drawings have been released for construction.

Table with columns for REMARKS and DATE, listing addendum no. 1 and 2.

Table with columns for DRAWING STATUS (ASA PLAN CHECK, ASA BACK CHECK, BIDDING, CONSTRUCTION), FILE NO. (7-41-C1), IDENTIFICATION STAMP, and DATE (01-110074).

BUILDINGS 5 & 6 RENOVATIONS

San Mateo County Community College District

BID ADDENDA

APPROVED BY THE STATE ARCHITECT: AC 111, FLS 63, SS JG DATE: 11/07/10

CAÑADA COLLEGE 4200 Farm Hill Boulevard Redwood City, CA 94061

MECHANICAL LEGENDS, NOTES, ABBREVIATIONS AND DRAWING INDEX

Date: 08/29/08 Drawing Number: AS NOTED Scale: MO.1 Project Number: 07013