## GRAVITY HOOD SCHEDULE OVERALL DIM. THROAT DIM. | CURB DIM. PD MFR MOIDEL CFM HOOD VELOCITY WEIGHT REMARKS LOCATION (LxWxH) MARK 60"x60" | 66"x66"x20" 802 | SERVES AHU-2, AHU-3 ALUMINUM FRAME, INTAKE BACKDRAFT DAMPER 108"x100"x31" 24,500 GH-1 ROOF COOK .115 500 214 SERVES CLASSROOM 4-201 NAIL LAB ALUMINUM, MOTORIZED DAMPER 28"x28" 32"x32"x20" GH-2ROOF 3,520 .041 300 COOK 51"x52"x31" 128 SERVES CLASSROOM 4-201 NAIL LAB ALUMINUM, MOTORIZED DAMPER 1,715 GH-3**ROOF** COOK 51"x52"x31" 14"x14" | 18"x18"x20" .047 300

PUMP SCHEDULE

MAX IMPELLER

HEAD

FT/H20

35

GPM

175

MOTOR

VOLT.

460/3/60

HP

WT

LBS

REMARKS

HOT WATER BOOSTER PUMP, VFD

RPM

1750

1. FOR MOUNTING/ ANCHORAGE, SEE DETAIL  $\frac{1}{M509}$   $\frac{2}{M509}$ 

$\boxtimes$	NAILOR	4320MR	L	6"	155	PATTERNED DEFLECTOR, 24"X24", APPLIANCE WHITE, LAY-IN
$\boxtimes$	NAILOR	4320MR	L	8"	245	PATTERNED DEFLECTOR, 24"X24", APPLIANCE WHITE, LAY-IN
$\boxtimes$	NAILOR	4320MR	L	10"	350	PATTERNED DEFLECTOR, 24"X24", APPLIANCE WHITE, LAY-IN
$\boxtimes$	NAILOR	4320MR	L	12"	450	PATTERNED DEFLECTOR, 24"X24", APPLIANCE WHITE, LAY-IN
$\boxtimes$	NAILOR	4340M	S	6"	170	PATTERNED DEFLECTOR, APPLIANCE WHITE, SURFACE MOUNT
$\boxtimes$	NAILOR	4340M	S	8"	290	PATTERNED DEFLECTOR, APPLIANCE WHITE, SURFACE MOUNT
$\boxtimes$	NAILOR	4340M	S	10"	415	PATTERNED DEFLECTOR, APPLIANCE WHITE, SURFACE MOUNT
$\boxtimes$	NAILOR	4340M	S	12"	550	PATTERNED DEFLECTOR, APPLIANCE WHITE, SURFACE MOUNT
	NAILOR	4340R	S	6"	165	RETURN AND/OR EXHAUST, APPLIANCE WHITE, SURFACE MOUNT
	NAILOR	4340R	S	8"	320	RETURN AND/OR EXHAUST, APPLIANCE WHITE, SURFACE MOUNT
	NAILOR	4340R	S	10	450	RETURN AND/OR EXHAUST, APPLIANCE WHITE, SURFACE MOUNT
	NAILOR	4340R	S	12"	650	RETURN AND/OR EXHAUST, APPLIANCE WHITE, SURFACE MOUNT
	NAILOR	4360	L	6"	225	RETURN AND/OR EXHAUST, 24"X24", APPLIANCE WHITE, LAY-IN
	NAILOR	4360	L	8"	350	RETURN AND/OR EXHAUST, 24"X24", APPLIANCE WHITE, LAY-IN
	NAILOR	4360	L	10"	500	RETURN AND/OR EXHAUST, 24"X24", APPLIANCE WHITE, LAY-IN
	NAILOR	4360	L	12"	700	RETURN AND/OR EXHAUST, 24"X24", APPLIANCE WHITE, LAY-IN
	NAILOR	4260	L	14"	860	EGGCRATE GRILLE, 24"X24", APPLIANCE WHITE, LAY-IN
	NAILOR	4260	L	16"	1,175	EGGCRATE GRILLE, 24"X24", APPLIANCE WHITE, LAY-IN
	NAILOR	5145H	S	SEE PLANS	SEE PLANS	SUPPLY SIDE WALL GRILLE, 45° DEFLECTION, 3/4' BLADE SPACING, APPLIANCE WHITE, SURFACE MOUNT
	ļ					

AIR OUTLET SCHEDULE

FRAME | NECK SIZE | CFM | REMARKS

MODEL

MFR

NAILOR 51FH

4. REFRIGERANT R-410a

MARK

۱.	FOR	Ν	OUNTING/	ANCI	HORAGE,	SEE	DI	ETAIL	9 M511	

MODEL

3x3x7B SERIES 80

MFR

B & G

MARK

P-1

LOCATION

SERVES

BUILDING HWS & R

	EXHAUST FAN SCHEDULE													
EQUIPMENT NUMBER	BUILDING/AREA SERVED	MFR. / MODEL #	FAN TYPE	AIR FLOW CFM	TOTAL EXT. S.P. IN. W.G.	MOTOR RPM	DRIVE TYPE	ELE MOTOR HP	ECTRICAL VOLT-PH-HZ	TOTAL EST. WT. LBS.	REMARKS			
EF-1	SOUTH WING	COOK / 210LPB	LOW PROFILE CENTRIFUGAL	3,815	1.0	1725	BELT	1 1/2	460/3/60	387	1			
EF-2	NORTH WING	COOK / 225LPB	LOW PROFILE CENTRIFUGAL	4,240	1.0	1725	BELT	2	460/3/60	463	1			
EF-3	Rm 4-120 & 4-122	COOK / 300TLC-B	LOW CONTOUR DOWN BLAST CENTRIFUGAL	5,330	1.0	1725	BELT	3	460/3/60	526	1			
EF-4	Rm 4-230	COOK / 300TLC-B	LOW CONTOUR DOWN BLAST CENTRIFUGAL	6,110	1.0	1725	BELT	3	460/3/60	526	1			
EF-5	Rm 4-240	PANASONIC/ FV-11VQD2	CEILING MOUNTED FAN	110	.10	1022	_	.35 (AMPS)	120/1/60	15	2 SPEED, TSTAT CONTROLLED			
EF-6	Rm 4-201	COOK / 225LPB	LOW PROFILE CENTRIFUGAL	3,520	.50	1725	BELT	3/4	460/3/60	473	13 ON/ OFF WALL MOUNTED SWITCH			
EF-7	Rm 4-201	COOK / 165LPB	LOW PROFILE CENTRIFUGAL	1,715	.50	1725	BELT	1/2	115/1/60	252	13 ON/ OFF WALL MOUNTED SWITCH			

			CAR	RIER	COOLIN	NG (	ONLY	SPLIT	r s	YSTE	M		
	EQUIPMENT TAG	MODEL	LOCATION	COOLING TOTAL	V/P/H	мсор		OUTDOOR MCA	CFM	WEIGHT LBS.	REMARKS		
$\exists$	AC-2/CU-2	40MVC024/ 38MVC024	TELE DATA/ROOF	24 MBH	208/1/60	20	25	14	750	40/150	12345678		
	AC-3/CU-3		TELE DATA/ROOF	24 MBH	208/1/60	20	25	14	750	40/150	12345678		
	AC-4/CU-4	40MVC024/ 38MVC024	TELE DATA/ROOF	24 MBH	208/1/60	20	25	14	750	40/150	12345678		
		SATE PUMP	2016		6. PROVIDE A			C CASING	OVER	REFRIGER	RANT		
H:	2. LOW AMI 3. WIND BA	BIENT CONTF AFFLE	(ULS		PIPING INSULATION.  7. SEE ARCHITECTURAL DRAWING FOR PIPING PENETRATION DETAIL								

5. CONDENSING UNIT REQUIRES EPOXY COATED. 8. FOR MOUNTING/ ANCHORAGE, SEE DETAILS  $\binom{6}{M510}$ 

SEE PLANS SEE RETURN/ EXHAUST SIDE WALL GRILLE, 45° DEFLECTION, 3/4" BLADE SPACING, APPLIANCE WHITE, SURFACE MOUNT

① 20" MFG. ROOF CURBS
② FOR MOUNTING/ ANCHORAGE, SEE DETAILS  $\frac{3}{\text{M509}}$   $\frac{4}{\text{M510}}$   $\frac{5}{\text{M510}}$ 

3 AIR DIVERTERS

				SOU	JND	TRA]	P (S'	T) SO	CHEDU	JLE			
UNIT MARK	MFR	MODEL	LOCATION	SERVES	-	VERALL S Γ (IN)	IZE	CFM	TOTAL AREA	VEL FPM	AIR PD IN WG	OPER. WT EA	NOTES
					W	Н	L (IN)		SF			LBS.	
ST-1	IAC	3LFL	4-100	AC-3	36	42	36	14,500	10.5	1,380	0.14	155	SUPPLY AIR

FI	RE/S	SMOK	E DA	MPER -	- FIRE DAMPER SCHEDULE
UNIT MARK	MFR	MODEL	SLEEVE	U.L. RATING	REMARKS
FSD-1	NAILOR	1270	16"-28"	1-1/2" HR	165° LINKAGE, INSTAL PER MFG. INSTRACTIONS, BLADE IN AIRSTREAM, LEKAGE CLASS II, RECTANGULAR DUCT

QUIPMENT				SUPPLY FAN		RETURN					HEATING COIL			_			ELECTRICAL	MIN.	TOTAL		
NUMBER	MANUFACTURER	SERVES	AIR FLOW CFM	EXT. S.P. INCH W.C.	FAN MOTOR HR	EXT S.P. INCH W.C.	FAN MOTOR HP	TOTAL MBH	SENSIBLE MBH	E/	T °F		T °F		HHW	I DP	VOLT/PH/HZ	OA CFM	EST. WT. LBS.	REMARKS	
										סט	WD		WD	EWT *F							
AHU-1	TEAM AIR CONDITIONING	SOUTH WING	22,500	3.0	20	1.0	10	395,902	395,902	40	_	56.1	_	180	20	1.60	460/3/60	9,455	10,475	BOTH SA & RA FANS ON VFD'S, SERVES SOUTH WINGS	
AHU-2	TEAM AIR CONDITIONING	NORTH WING	10,000	3.0	10	1.0	5	172,128	172,128	40	_	55.7	_	180	9	0.70	460/3/60	3,055	6,650	BOTH SA & RA FANS ON VFD'S, SERVES NORTH WINGS	
AHU-3	TEAM AIR CONDITIONING	NORTH WING	14,500	4.0	15	_	_	401,863	401,863	30	_	55.3	_	180	21	2.35	460/3/60	14,500	5,910	100% OUTSIDE AIR, SA FAN ON VFD, SERVES NORTH WINGS	

				INI	DOOR UNIT								C	OUTDOOR UNIT	Γ				
				COC	LING MBH	Ī	Е	LEC. DA	TA (INDOOF	₹)	OP. WT.	MARK	MODEL	LOCATION	ELEC DATA (OUTDOOR) OP. WT			OP. WT.	REMARKS
MARK	MFR	MODEL	LOCATION	TOTAL	SENSIBLE	CFM	FLA	MCA	MAX FUSE	VOLT/PH	LBS.	MARK	MODEL	LOCATION	MCA	MAX FUSE	VOLT/PH	LBS.	
FC-1	CARRIER	FXC4N0600	MAIN ELEC.RM.	51.0	42.0	1750	6.0	7.5	15	208/1	210	CU-1	38HDR060	ROOF	11.6	20	460/3	305	1234567


## **WRNSSTUDIO**LL

501 SECOND STREET 4TH FLOOR, STE. 402 SAN FRANCISCO **CALIFORNIA 94107** 415.489.2224 TEL 415.358.9100 FAX WWW.WRNSSTUDIO.COM

## **Steinberg Architects**



Hensel Phelps Construction Co.

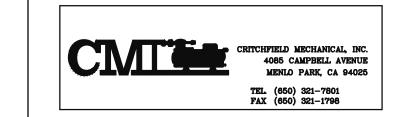

"These drawings and specifications have been prepared by CMI for their exclusive use in accord with Sec. 6737.4 of the Professional Engineers Act of the State of California."

ISSUES/REVISIONS	DATE
100% SCHEMATIC DESIGN	04/28/08
50 % DESIGN DEVELOPMENT	06/13/08
100% DESIGN DEVELOPMENT	07/28/08
<b>INCREMENT 2 80% REVIEW</b>	10/10/08
DSA INCREMENT 2	
STRUCTURE & GFRC PANELS	11/11/08
DSA INCREMENT #3 50% REVIEW	11/11/08
DSA INCREMENT #3 90% REVIEW	12/19/08

12/19/08

02/09/09

04/30/09

05/12/09

10/27/09

12/15/10

DSA INCREMENT #3 TENANT IMPROVEMENT AND ROOFING SYSTEM HPCC REVIEW


DSA INCREMENT #3 BACKCHECK ISSUED FOR CONSTRUCTION AS BUILTS

DIVISION OF THE STATE ARCHITECT APPL # 01-110117 FILE #<u>41-C1</u> AC \_\_\_\_\_ FLS \_\_\_\_



IDENTIFICATION STAMP

SKYLINE COLLEGE SAN MATEO COUNTY COMMUNITY COLLEGE DISTRICT CIP2 DESIGN-BUILD PROJECT **BUILDING 4 INCREMENT 3** 

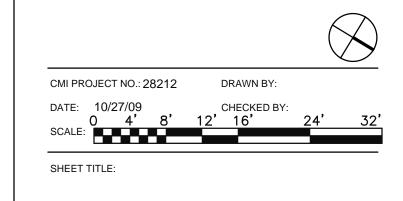

MECHANICAL **EQUIPMENT** SCHEDULES

SHEET NO:

M-003