


SHEET KEYNOTES
 ① ACOUSTIC TRANSFER AIR BOOT. SEE DETAIL 5/M601.

BCA

architecture
 planning
 interiors

Bunton Clifford Associates, Inc.
 210 Hammond Ave.
 Fremont, California 94539
 [T] 510.445.1000
 [F] 510.445.1005
 www.BCAincOnline.com

PROJECT 2007-0731
 CONTACT Omar Hawit
INTERFACE
 ENGINEERING
 717 Market Street
 Suite 500
 San Francisco, CA 94103
 TEL: 415.489.7240
 FAX: 415.489.7299
 www.InterfaceEngineering.com

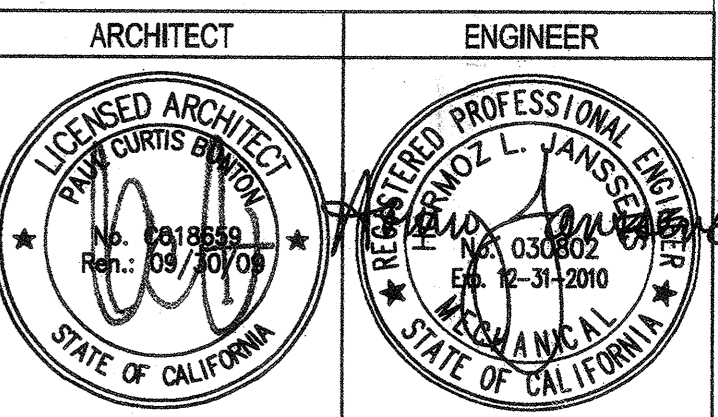

1. This sheet is part of a set and is not to be used alone.
 2. This sheet is not to be used for construction unless the architect's stamp and signature appear on the drawings and the status box indicates drawings have been released for construction.
 3. These plans and prints thereof, as instruments of service, are owned by the architect and are for use on this project only. Reproduction and/or distribution without the prior written consent of the architect is forbidden.
 4. Copyright Bunton Clifford Associates, 2007

REMARKS	DATE
ADDENDUM NO. 1	08/28/08
ADDENDUM NO. 2	11/06/09

DRAWING STATUS	DATE
ISA PLAN CHECK	08/28/08
ISA BACK CHECK	01/22/09
BIDDING (BID RELEASE)	09/18/09
CONSTRUCTION	

FILE NO. 41-C-1
 IDENTIFICATION STAMP
 DIV. OF THE STATE ARCHITECT
 01-110074
 AC: FLS: SS: DATE:

BUILDINGS 5 & 6 RENOVATIONS

San Mateo County Community College District



BID ADDENDA

APPROVED
 V. OF THE STATE ARCHITECT
 AC: FLS: SS: TC
 APPL. NO. 110074 DATE 5/20/10

CAÑADA COLLEGE
 4200 Farm Hill Boulevard
 Redwood City, CA 94061

MECHANICAL
 DUCTWORK PLAN
 SECOND FLOOR

Date 08/29/08 Drawing Number
 Scale AS NOTED Project Number 07013
M2.2d

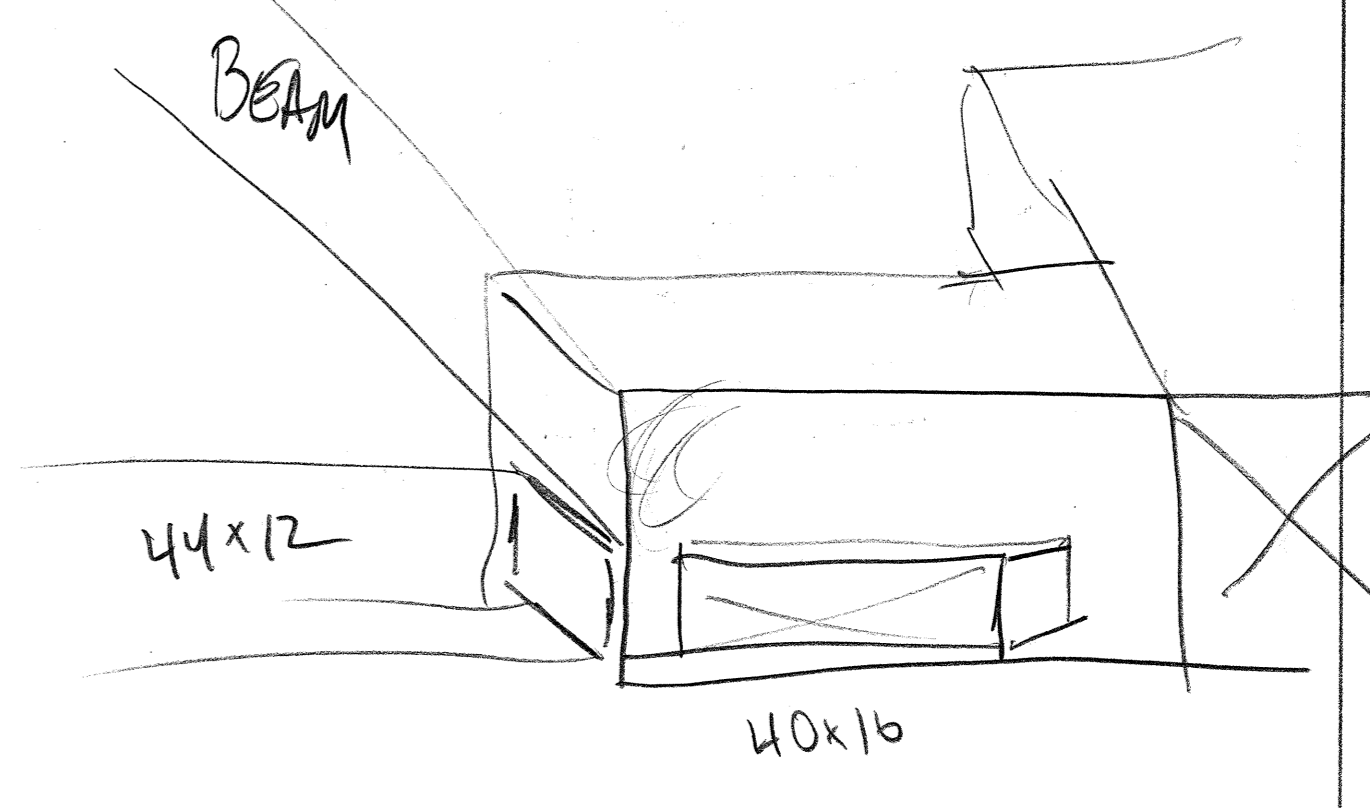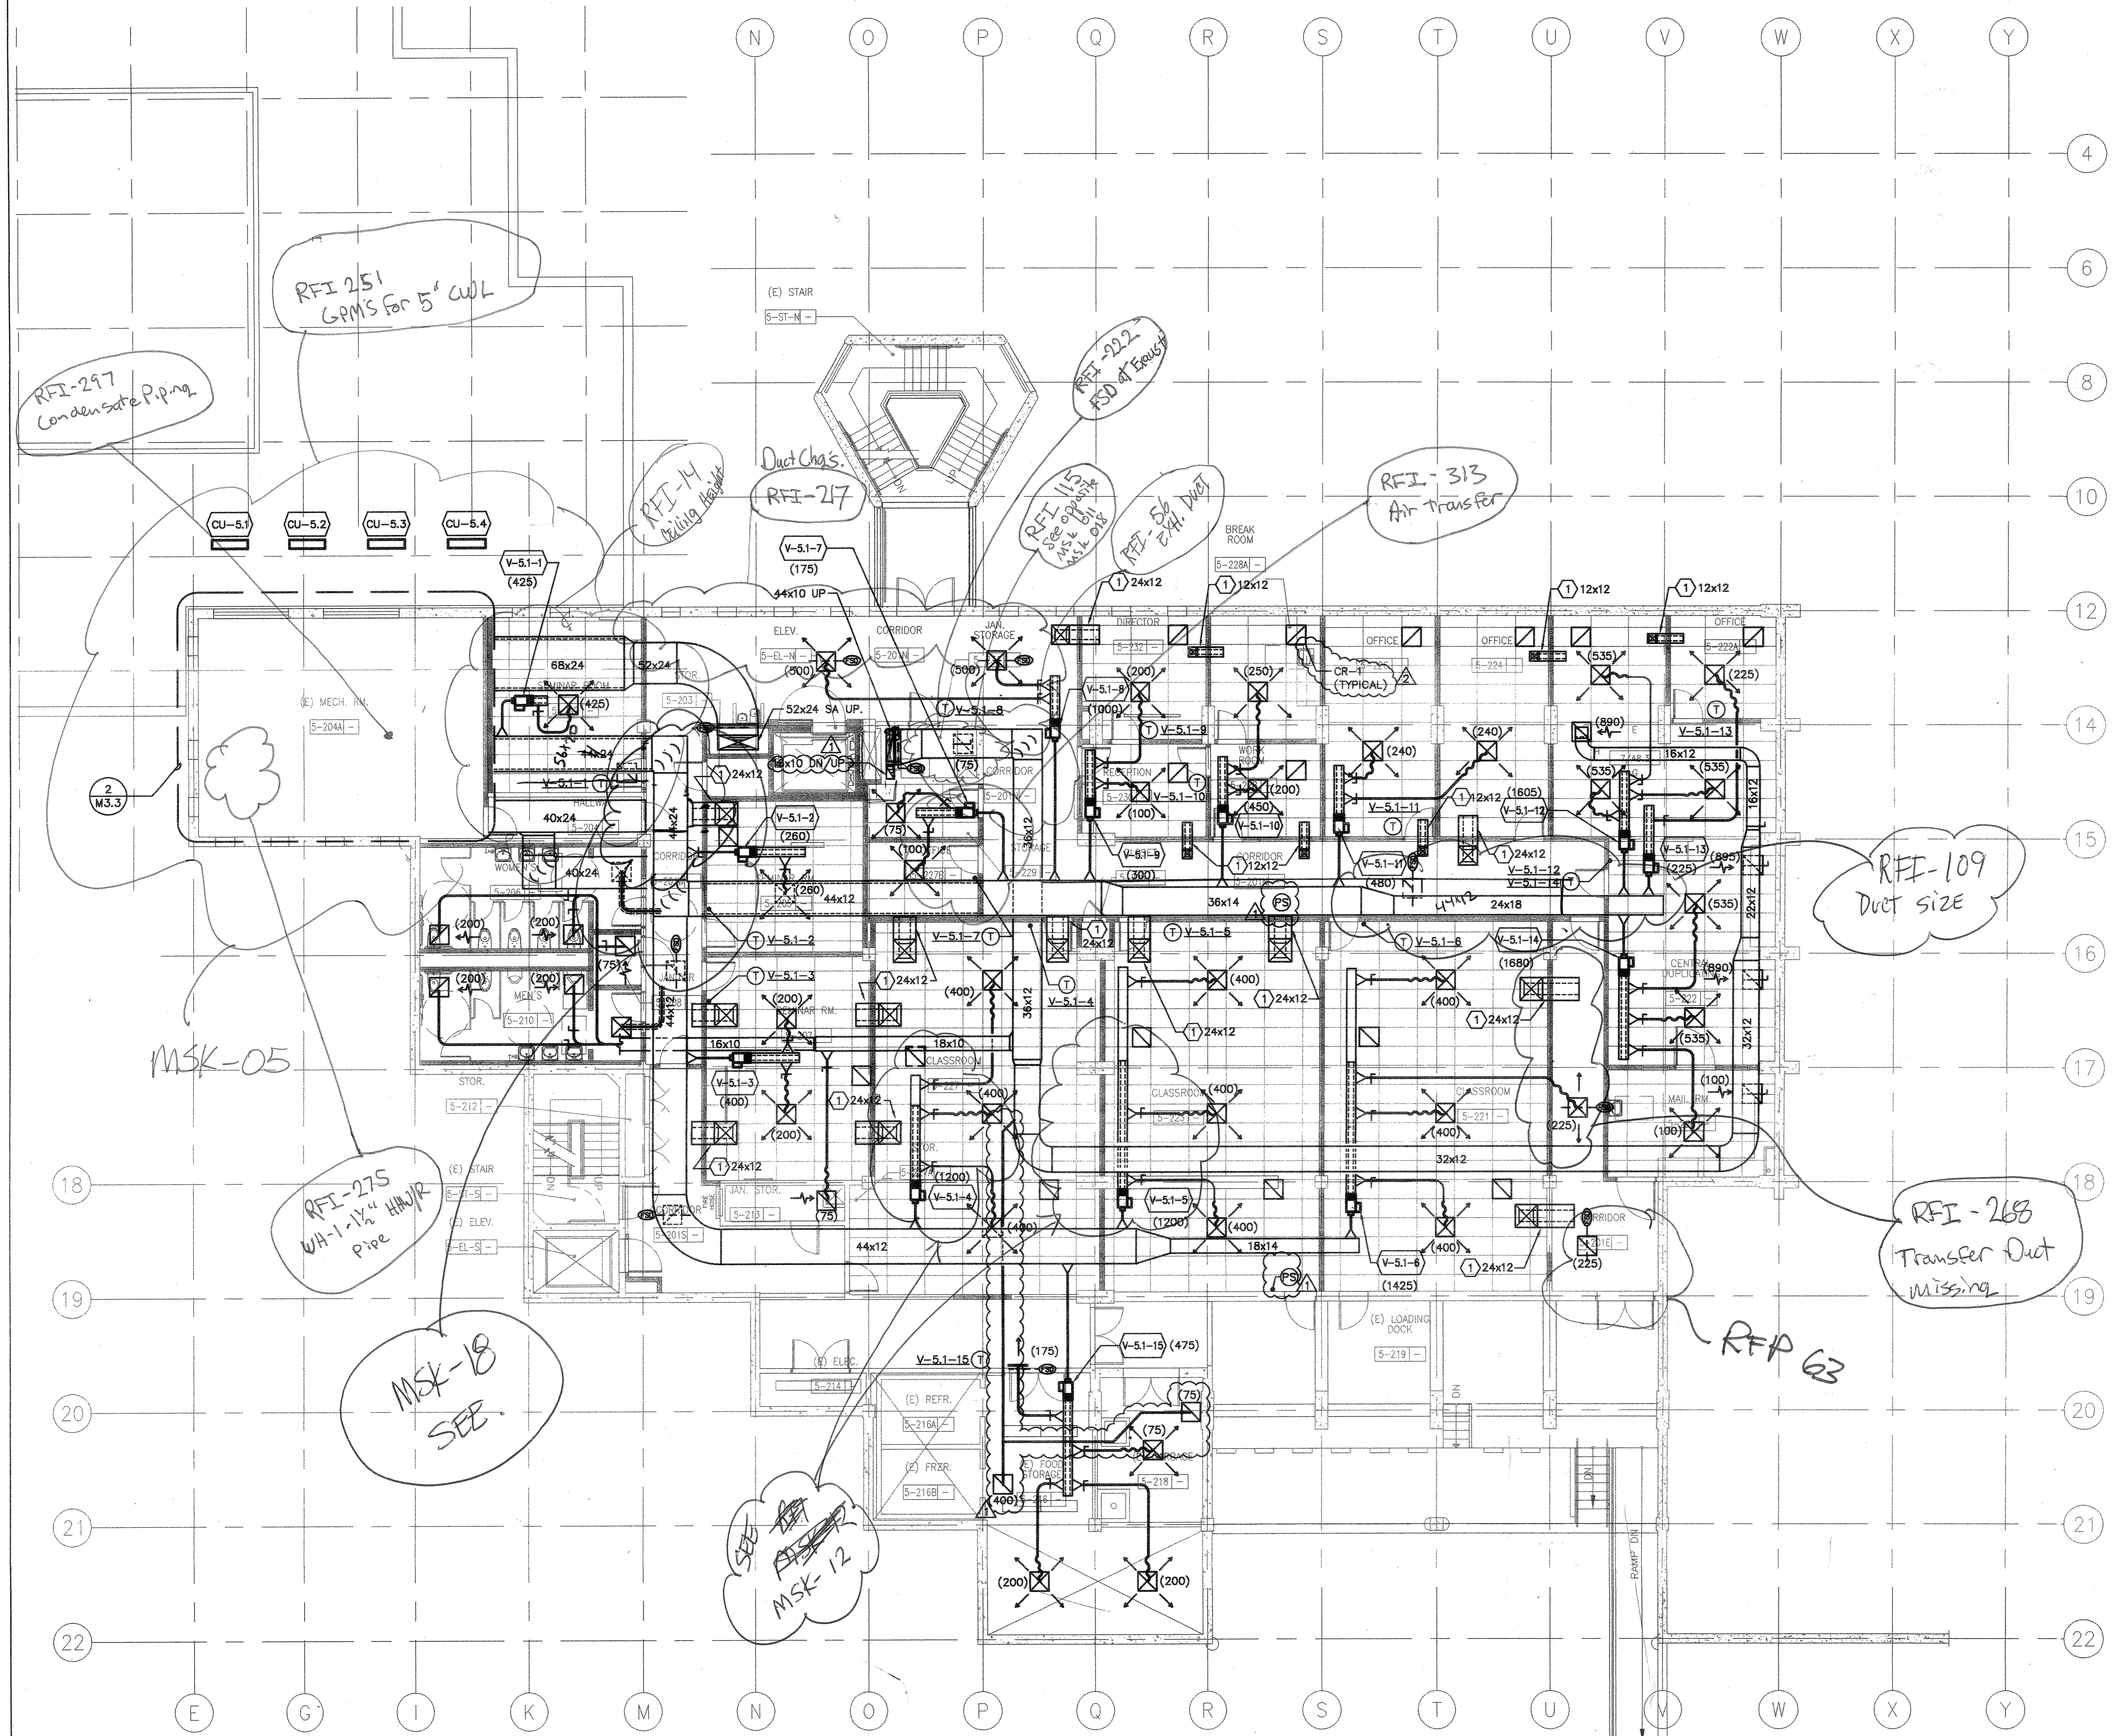

SUPPLY DIFFUSER SIZING TABLE

TAG	NECK SIZE	CFM RANGE
CD-1	8"	0-210
CD-1	10"	211-325
CD-1	12"	326-425
CD-1	14"	426-560
CD-1	16"	561-710

NOTES:
 1. ALL 24x24 CEILING SUPPLY DIFFUSERS SHALL BE OF TYPE CD-1 UNLESS OTHERWISE NOTED.
 2. ALL BRANCH DUCTWORK SHALL BE THE SAME SIZE AS THE DIFFUSER NECK SIZE UNLESS OTHERWISE NOTED.
 3. SEE DETAIL 5/M6.2.
 4. SEE DIFFUSER, GRILLE AND REGISTER SCHEDULE ON SHEET M4.1.

RETURN/EXHAUST REGISTER SIZING TABLE

TAG	NECK SIZE	CFM RANGE
CR-1	8"	0-175
CR-1	10"	176-275
CR-1	12"	276-400
CR-1	14"	401-540
CR-1	16"	541-700

NOTES:
 1. ALL CEILING 24x24 RETURN/EXHAUST REGISTERS SHALL BE OF TYPE CR-1 UNLESS OTHERWISE NOTED.
 2. ALL BRANCH DUCTWORK SHALL BE THE SAME SIZE AS THE REGISTER NECK SIZE UNLESS OTHERWISE NOTED.
 3. SEE DETAIL 5/M6.2.
 4. SEE DIFFUSER, GRILLE AND REGISTER SCHEDULE ON SHEET M4.1.

1 MECHANICAL DUCTWORK PLAN - SECOND FLOOR
 SCALE: 1/8"=1'-0"

RFI 255
 Register Sizes
 3 types