

THE OPERATOR WORKSTATION / NETWORK CONTROLLER, THROUGH A USER PROGRAMMABLE SCHEDULE, SHALL ENABLE THE OPERATION OF AHU & ASSOCIATED EXHAUST FAN

ASSOCIATED EXHAUST FAN.

WHEN IN OPERATION THE SUPPLY AND EXHAUST FAN SHALL BE
START/STOPPED BY THE AHU CONTROLLER. FAN STATUS ON THE SUPPLY
AND EXHAUST FAN SHALL BE MONITORED. AN ALARM MESSAGE SHALL BE
INDICATED WHEN THE FAN IS NOT CORRECTLY OPERATING AT THE OPERATOR
WORKSTATION. A HIGH LIMIT DUCT PRESSURE SWITCH SHALL DISABLE THE
VFD'S THROUGH THE AHU CONTROLLER WHEN THE HIGH LIMIT IN THE SUPPL
AIR DUCT IS REACHED. AN ALARM MESSAGE SHALL BE INDICATED AT THE

OPERATOR WORKSTATION WHEN THIS OCCURS.

1 THE VFD ON THE SUPPLY FAN SHALL BE USED TO MODULATE THE FAN TO
MAINTAIN SPACE TEMPERATURE AND ON THE EXHAUST FAN (EF-6.1) TO
MAINTAIN SPACE PRESSURE (0.05 IN H20 ADJUSTABLE). EF-5.2 RUNS
CONTINOUSLY DURING AC-6.1 OPERATION.

FILTER STATUS SHALL BE MONITORED. AN ALARM MESSAGE SHALL BE INDICATED AT THE OPERATOR WORKSTATION WHEN THE ADJUSTABLE ACCEPTABLE PRESSURE DROP HAS BEEN SURPASSED. (0.75 IN H2O)

THE AIRFLOW MEASURING STATION SHALL ASSURE THAT THE MINIMUM CFM IS PROVIDED BY THE AIRFLOW MEASURING STATION OUTSIDE AIR DAMPER.

THE DISCHARGE TEMPERATURE SHALL BE MAINTAINED AT AN ADJUSTABLE SETPOINT THROUGH THE MODULATION OF THE RETURN AIR (RA), HOT WATER VALVE, OUTSIDE AIR (OA) DAMPERS, EXHAUST FAN AND CHILLED WATER VALVE IN SEQUENCE.

THE OUTSIDE, DISCHARGE, RETURN, AND MIXED AIR TEMPERATURES SHALL ALL BE MONITORED THROUGH THE AHU FOR USE IN THE FOLLOWING ENERGY MANAGEMENT SEQUENCES:

ECONOMIZER

WHEN THE OUTSIDE AIR TEMPERATURE (OAT) < FREE COOLING ADJUSTABLE SETPOINT:

THE OUTSIDE(OA), RETURN(RA) DAMPERS, AND EXHAUST FAN SHALL MODULATE TO MAINTAIN THE DESIRED DISCHARGE TEMPERATURE. IF ADDITIONAL COOLING IS REQUIRED, THE COOLING COIL SHALL BE USED TO MAINTAIN THE DESIRED DISCHARGE TEMPERATURE.

WHEN THE OAT > FREE COOLING ADJUSTABLE SETPOINT, OA, RA DAMPERS, EXHAUST FAN AND COOLING COIL SHALL MODULATE IN SEQUENCE TO MAINTAIN THE DESIRED DISCHARGE TEMPERATURE.

UNOCCUPIED OVERRIDE


AREA WARM-UP OR COOL-DOWN ONE HOUR PRIOR TO OCCUPANCY.

DURING WARM—UP, THE EXHAUST FAN SHALL BE OFF. THE OA DAMPER SHALL BE DRIVEN CLOSED POSITION AND THE RA DAMPER SHALL BE DRIVEN OPENED. THIS WILL CONTINUE UNTIL THE SPACE TEMPERATURE IS AT THE ADJUSTABLE SETPOINT. THE SYSTEM AT THIS POINT SHALL RETURN TO NORMAL OPERATION.

DURING COOL—DOWN, IF OAT < RAT, THE OA DAMPER AND EA FAN SHALL BE FULLY OPENED AND THE RA DAMPER SHALL BE CLOSED. THE SUPPLY FAN AND EXHAUST FAN SHALL BE STARTED. WHEN THE SPACE TEMPERATURE < ADJUSTABLE SETPOINT, THE SYSTEM SHALL RETURN TO NORMAL OPERATION.

UPON SMOKE INDICATION IN THE SUPPLY AIR DUCT, THE SUPPLY AND EXHAUST FAN SHALL BE STOPPED THROUGH THE DDC CONTROLLERS. SYSTEM WILL OPERATE IN SHUT DOWN MODE.

1 AC-6.1 WITH EF-6.1 AND EF-5.2 CONTROL

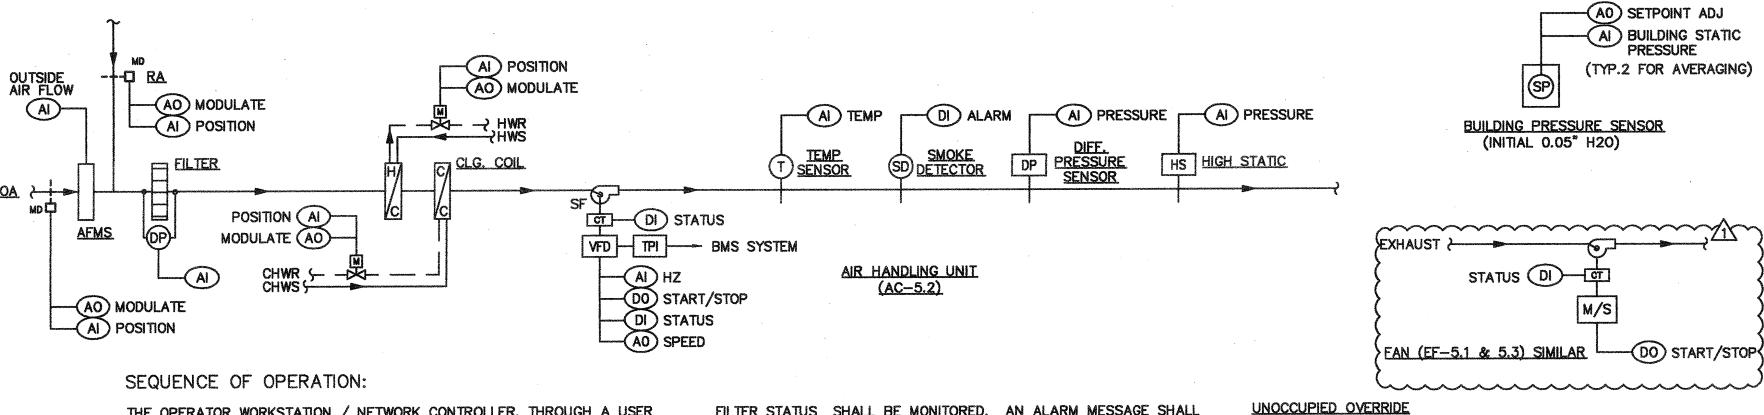

THE OPERATOR WORKSTATION / NETWORK CONTROLLER, THROUGH A USER PROGRAMMABLE SCHEDULE, SHALL ENABLE THE OPERATION OF AHU & ASSOCIATED EXHAUST FAN.

FAN STATUS ON THE SUPPLY AND EXHAUST FAN SHALL BE MONITORED. AN ALARM MESSAGE SHALL BE INDICATED WHEN THE FAN IS NOT CORRECTLY OPERATING AT THE OPERATOR WORKSTATION. A HIGH LIMIT DUCT PRESSURE SWITCH SHALL DISABLE THE VFD'S THROUGH THE AHU CONTROLLER WHEN THE HIGH LIMIT IN THE SUPPLY AIR DUCT IS REACHED. AN ALARM MESSAGE SHALL BE INDICATED AT THE OPERATOR WORKSTATION WHEN THIS OCCURS.

THE VFD ON THE SUPPLY FAN SHALL BE USED TO MODULATE THE FAN TO MAINTAIN SPACE TEMPERATURE AND PROVIDE THE REQUIRED MAKE—UP AIR TO THE KITCHEN. IF EF—5.1 OR EF—5.3 IS COMMANDED ON, THEN AC—5.2 SUPPLY FAN MUST SUPPLY A MINIMUM VALUE OF EXHAUSTED AIR.

FILTER STATUS SHALL BE MONITORED. AN ALARM MESSAGE SHALL BE INDICATED AT THE OPERATOR WORKSTATION WHEN THE ADJUSTABLE ACCEPTABLE PRESSURE DROP HAS BEEN SURPASSED. (0.75 IN H2O) THE AIRFLOW MEASURING STATION SHALL ASSURE THAT THE MINIMUM CFM IS PROVIDED BY THE AIRFLOW MEASURING STATION OUTSIDE AIR DAMPER.

THE DISCHARGE TEMPERATURE SHALL BE MAINTAINED AT AN ADJUSTABLE SETPOINT THROUGH THE MODULATION OF THE RETURN AIR (RA), HOT WATER VALVE, OUTSIDE AIR (OA) DAMPERS, EXHAUST FAN AND CHILLED WATER VALVE IN SEQUENCE.

THE OUTSIDE, DISCHARGE, RETURN, AND MIXED AIR TEMPERATURES SHALL ALL BE MONITORED THROUGH THE AHU FOR USE IN THE ENERGY MANAGEMENT.


AREA WARM-UP OR COOL-DOWN ONE HOUR PRIOR TO OCCUPANCY.

DURING WARM-UP, THE EXHAUST FAN SHALL BE OFF. THE OA DAMPER SHALL BE DRIVEN CLOSED POSITION AND THE RA DAMPER SHALL BE DRIVEN OPENED. THIS WILL CONTINUE UNTIL THE SPACE TEMPERATURE IS AT THE ADJUSTABLE SETPOINT. THE SYSTEM AT THIS POINT SHALL RETURN TO

DURING COOL—DOWN, IF OAT < RAT, THE OA DAMPER AND EA FAN SHALL BE FULLY OPENED AND THE RA DAMPER SHALL BE CLOSED. THE SUPPLY FAN AND EXHAUST FAN SHALL BE STARTED. WHEN THE SPACE TEMPERATURE < ADJUSTABLE SETPOINT, THE SYSTEM SHALL RETURN TO NORMAL OPERATION.

UPON SMOKE INDICATION IN THE SUPPLY AIR DUCT, THE SUPPLY AND EXHAUST FAN SHALL BE STOPPED THROUGH THE DDC CONTROLLERS. SYSTEM WILL OPERATE IN SHUT DOWN MODE.

3 AC-5.2 WITH EF-5.1, AND EF-5.3 CONTROL

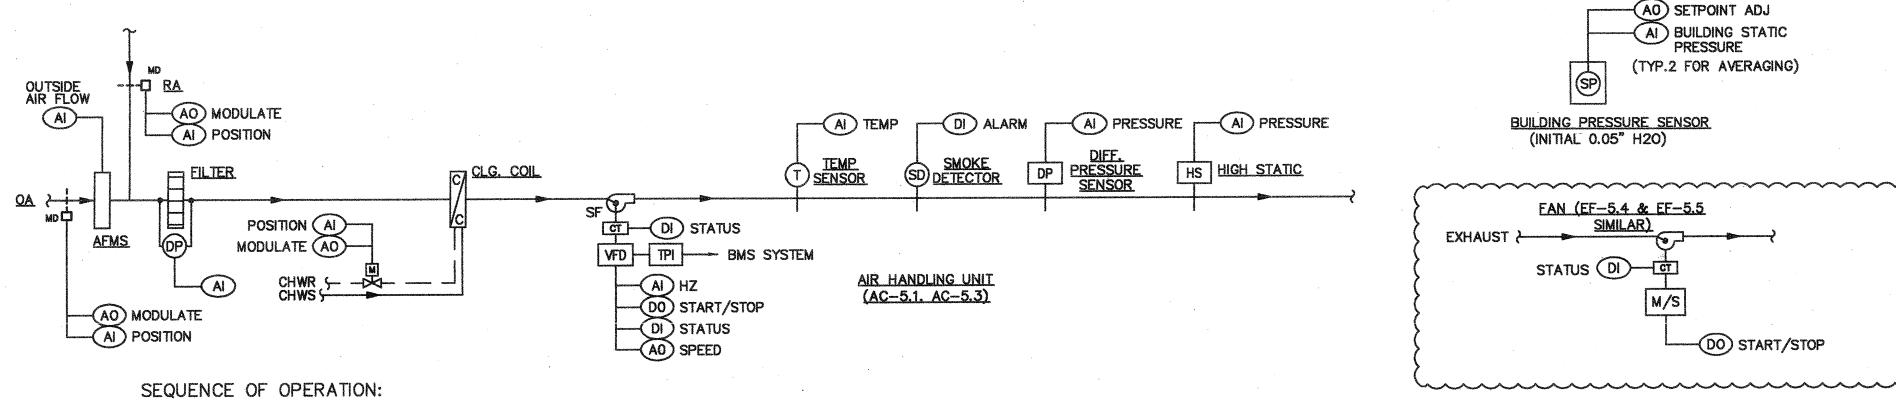

THE OPERATOR WORKSTATION / NETWORK CONTROLLER, THROUGH A USER PROGRAMMABLE SCHEDULE, SHALL ENABLE THE OPERATION OF AHU & ASSOCIATED EXHAUST FAN.

WHEN IN OPERATION THE SUPPLY FAN SHALL BE START/STOPPED BY THE AHU. FAN STATUS ON THE SUPPLY FAN SHALL BE MONITORED. AN ALARM MESSAGE SHALL BE INDICATED WHEN THE FAN IS NOT CORRECTLY OPERATING AT THE OPERATOR WORKSTATION. A HIGH LIMIT DUCT PRESSURE SWITCH SHALL DISABLE THE VFD'S THROUGH THE AHU CONTROLLER WHEN THE HIGH LIMIT IN THE SUPPLY AIR DUCT IS REACHED. AN ALARM MESSAGE SHALL BE INDICATED AT THE OPERATOR WORKSTATION WHEN THIS OCCURS. THE ASSOCIATED EXHAUST FAN SHALL BE COMMANDED ON UPON AHU OPERATION.

THE VFD ON THE SUPPLY FAN SHALL BE USED TO MODULATE THE FAN TO MAINTAIN SPACE TEMPERATURE AND TO MAINTAIN SPACE PRESSURE (0.05 IN H2O)
FILTER STATUS SHALL BE MONITORED. AN ALARM MESSAGE SHALL BE MODICATED AT THE OPERATOR WORKSTATION WHEN THE ADJUSTABLE

FILTER STATUS SHALL BE MONITORED. AN ALARM MESSAGE SHALL BE INDICATED AT THE OPERATOR WORKSTATION WHEN THE ADJUSTABLE ACCEPTABLE PRESSURE DROP HAS BEEN SURPASSED. (0.75 IN H2O)
THE AIRFLOW MEASURING STATION SHALL ASSURE THAT THE MINIMUM CFM IS PROVIDED BY THE AIRFLOW MEASURING STATION OUTSIDE AIR DAMPER.

THE DISCHARGE TEMPERATURE SHALL BE MAINTAINED AT AN ADJUSTABLE SETPOINT THROUGH THE MODULATION OF THE RETURN AIR (RA), HOT WATER VALVE, OUTSIDE AIR (OA) DAMPERS, EXHAUST FAN AND CHILLED DURING WARM—UP, THE DURING WARM—UP, THE

WATER VALVE, OUTSIDE AIR (OA) DAMPERS, EXHAUST FAN AND CHILLED WATER VALVE IN SEQUENCE.

THE OUTSIDE, DISCHARGE, RETURN, AND MIXED AIR TEMPERATURES SHALL ALL BE MONITORED THROUGH THE AHU FOR USE IN THE FOLLOWING ENERGY MANAGEMENT SEQUENCES:


AREA WARM-UP OR COOL-DOWN ONE HOUR PRIOR TO OCCUPANCY.

DURING WARM—UP, THE EXHAUST FAN SHALL BE OFF. THE OA DAMPER SHALL BE DRIVEN CLOSED POSITION AND THE RA DAMPER SHALL BE DRIVEN OPENED. THIS WILL CONTINUE UNTIL THE SPACE TEMPERATURE IS AT THE ADJUSTABLE SETPOINT. THE SYSTEM AT THIS POINT SHALL RETURN TO NORMAL OPERATION.

DURING COOL-DOWN, IF OAT < RAT, THE OA DAMPER AND EA FAN SHALL BE FULLY OPENED AND THE RA DAMPER SHALL BE CLOSED. THE SUPPLY FAN AND EXHAUST FAN SHALL BE STARTED. WHEN THE SPACE TEMPERATURE < ADJUSTABLE SETPOINT, THE SYSTEM SHALL RETURN TO NORMAL OPERATION.

UPON SMOKE INDICATION IN THE SUPPLY AIR DUCT, THE SUPPLY AND EXHAUST FAN SHALL BE STOPPED THROUGH THE DDC CONTROLLERS. SYSTEM WILL OPERATE IN SHUT DOWN MODE.

6 AC-5.1 WITH EF-5.4 AND AC-5.3 WITH EF-5.5 CONTROL

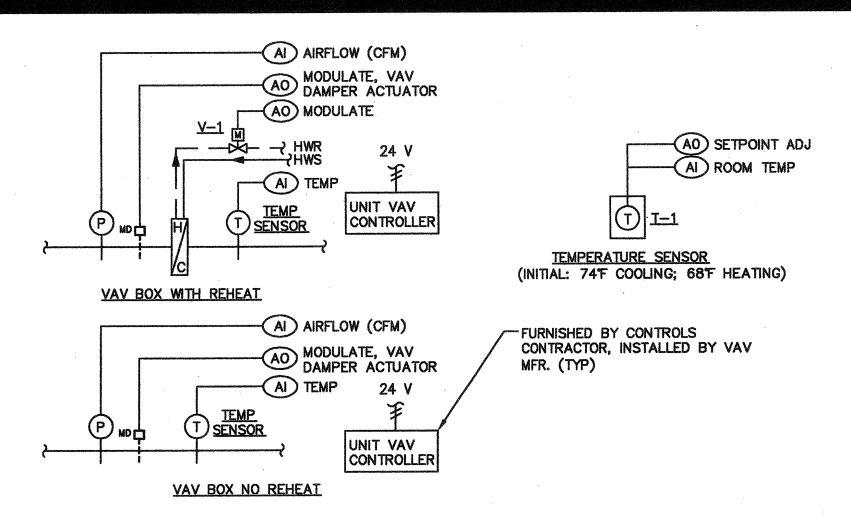

SEQUENCE OF OPERATION:


OCCUPIED COOLING:
THE TERMINAL UNIT CONTROLLER SHALL TAKE AN INPUT FROM THE ROOM TEMPERATURE SENSOR TO MODULATE
THE VAV DAMPER ACTUATOR TO MAINTAIN THE SPACE ROOM TEMPERATURE.

OCCUPIED HEATING:
ONCE THE ZONE TEMPERATURE DROPS BELOW THE HEATING SETPOINT THE TERMINAL UNIT WILL GO INTO THE HEATING MODE, PRIMARY CFM SETPOINT WILL CHANGE TO THE HEATING FLOW INDICATED IN THE VAV TERMINAL UNIT SCHEDULE. THE HEATING HOT WATER VALVE (V-1) WILL MODULATE TO MAINTAIN SPACE SETPOINT TEMPERATURE (OPERATOR DEFINABLE), A TWO (2) DEGREE ABOVE SETPOINT DEADBAND WILL BE UTILIZED TO MINIMIZE CYCLING (OPERATOR DEFINABLE).


UNOCCUPIED MODE: T-1 SET TO TITLE 24 SET-BACK TEMPERATURE; V-1 CLOSED.

ALARMS: SEND AN ALARM IF VALVES ARE COMMANDED OPEN/CLOSE BUT DISCHARGE TEMPERATURE DOES NOT INDICATE CHANGE IN TEMPERATURE.

2 VAV CONTROL

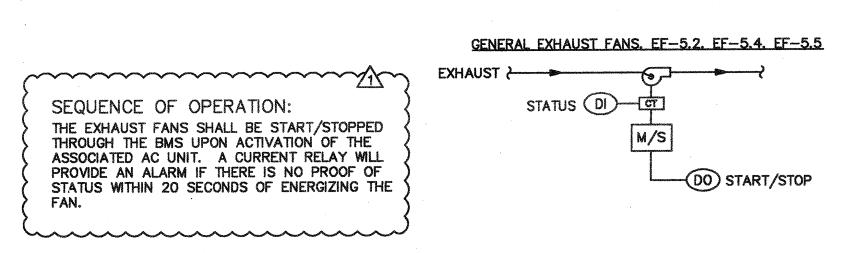

4 EF-5.2, EF-5.3, EF-5.4, AND EF-5.5 CONTROL

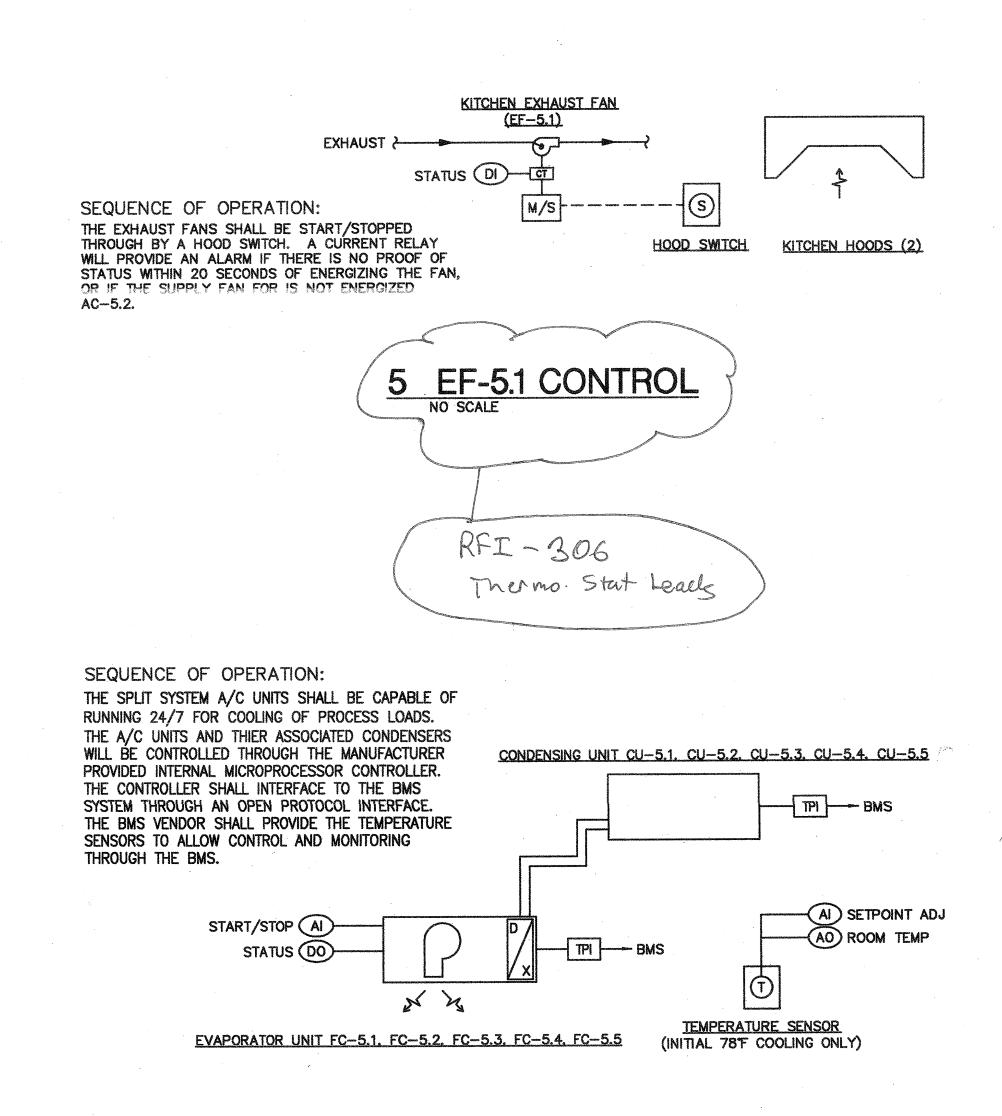

7 FC AND CU CONTROL


BCA

architecture planning interiors

Bunton Clifford Associates, Inc. 210 Hammond Ave. Fremont, California 94539 [T] 510.445.1000

[F] 510.445.1005

PROJECT	2007-0731			
CONTACT	Omar Hawit			
		 GII		
717 Marke Suite 500	t Street			
	isco, CA 94103			
	.489.7240			
FAX 415	.489.7289			
www.interf	aceengineering.com			
٨٥٨	UITECT	ENC	INIEE	D

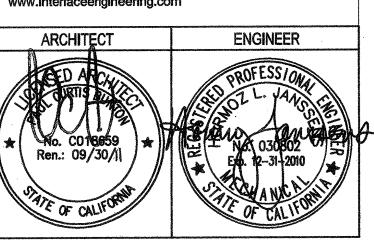

1. This sheet is part of a set and is not to be used alone.
2. This sheet is not to be used for construction unless the architect's stamp and signature appear on the drawings and the status box indicates drawings have been released for construction.
3. These plans and prints thereof, as instruments of service, are owned by the architect and are for use on this project only. Reproduction and/or distribution without the prior written consent of the architect is forbidden.
4. Copyright Bunton Clifford Associates, 2007

REMARKS	DATE
ADDENDUM NO. 1	09/18/09
<u> </u>	
<u> </u>	
	and control place and reproductive Control and Control and Control and Control and Control and Control and Control
	etica description contrattamente de privato a del Stotopor in son eticonici dicato trinspoto vide più demonstrativa del contrat
white the control of	eda periodrapia una presenta de la secución entre activo en el como de la disciplicación de la constitución de

	DATE
DSA PLAN CHECK	08/29/08
DSA BACK CHECK	01/22/09
BIDDING (BID #86593)	09/18/09
BIDDING (BID #86593) CONSTRUCTION	

	AND DESCRIPTION OF THE PERSON
FILE NO. 41-C1	
IDENTIFICATION STAMP DIV. OF THE STATE ARCHITECT	
01- 110074	
ACFLSSS	
DATE	

BUILDINGS 5 & 6 RENOVATIONS

San Mateo County Community College District

BID ADDENDA

DIV OF THE STATE ARCHITECT

AC M FILS AC SS MAR

APPL NO. 110074 DATE 2/17/1

CAÑADA COLLEGE

4200 Farm Hill Boulevard Redwood City, CA 94061

MECHANICAL
CONTROL DIAGRAMS

07013

Date	Drawing Number			
08/29/08				
Scale	RAE			
AS NOTED	IVIO.2			
Project Number				