

NO.	ISSUES/REVISIONS	DATE
	100% SCHEMATIC DESIGN	04/29/09
	50% DESIGN DEVELOPMENT	06/13/09
	100% DESIGN DEVELOPMENT	07/28/09
	INCREMENT 2 90% REVIEW	10/10/09
	DSA INCREMENT 2	
	STRUCTURE & OFFICE PANELS	11/11/09
7	DSA INCREMENT #3 50% REVIEW	11/11/09
9	DSA INCREMENT #3 90% REVIEW	12/19/09
10	DSA INCREMENT #3	
	TENANT IMPROVEMENT AND ROOFING SYSTEM	02/09/09
12	HSSC REVIEW	
14	DSA INCREMENT #3 BACKCHECK	05/12/09
	ISSUED FOR CONSTRUCTION	10/27/09
	AS BUILT	12/19/10


DIVISION OF THE STATE ARCHITECT
APPL # 01-110117
FILE # 41-C1
AC _____ FLS _____
SSS _____ DATE _____
IDENTIFICATION STAMP



SKYLINE COLLEGE
SAN MATEO COUNTY COMMUNITY COLLEGE DISTRICT
CIP2 DESIGN-BUILD PROJECT
BUILDING 4
INCREMENT 3

CMTI PROJECT NO. 28212 DRAWN BY: _____
DATE: 10/27/09 CHECKED BY: _____
SCALE: 0' 8' 12' 16' 24' 32'
SHEET TITLE:
LEVEL 3 TEMP CONTROL ZONES

SHEET NO. M-603

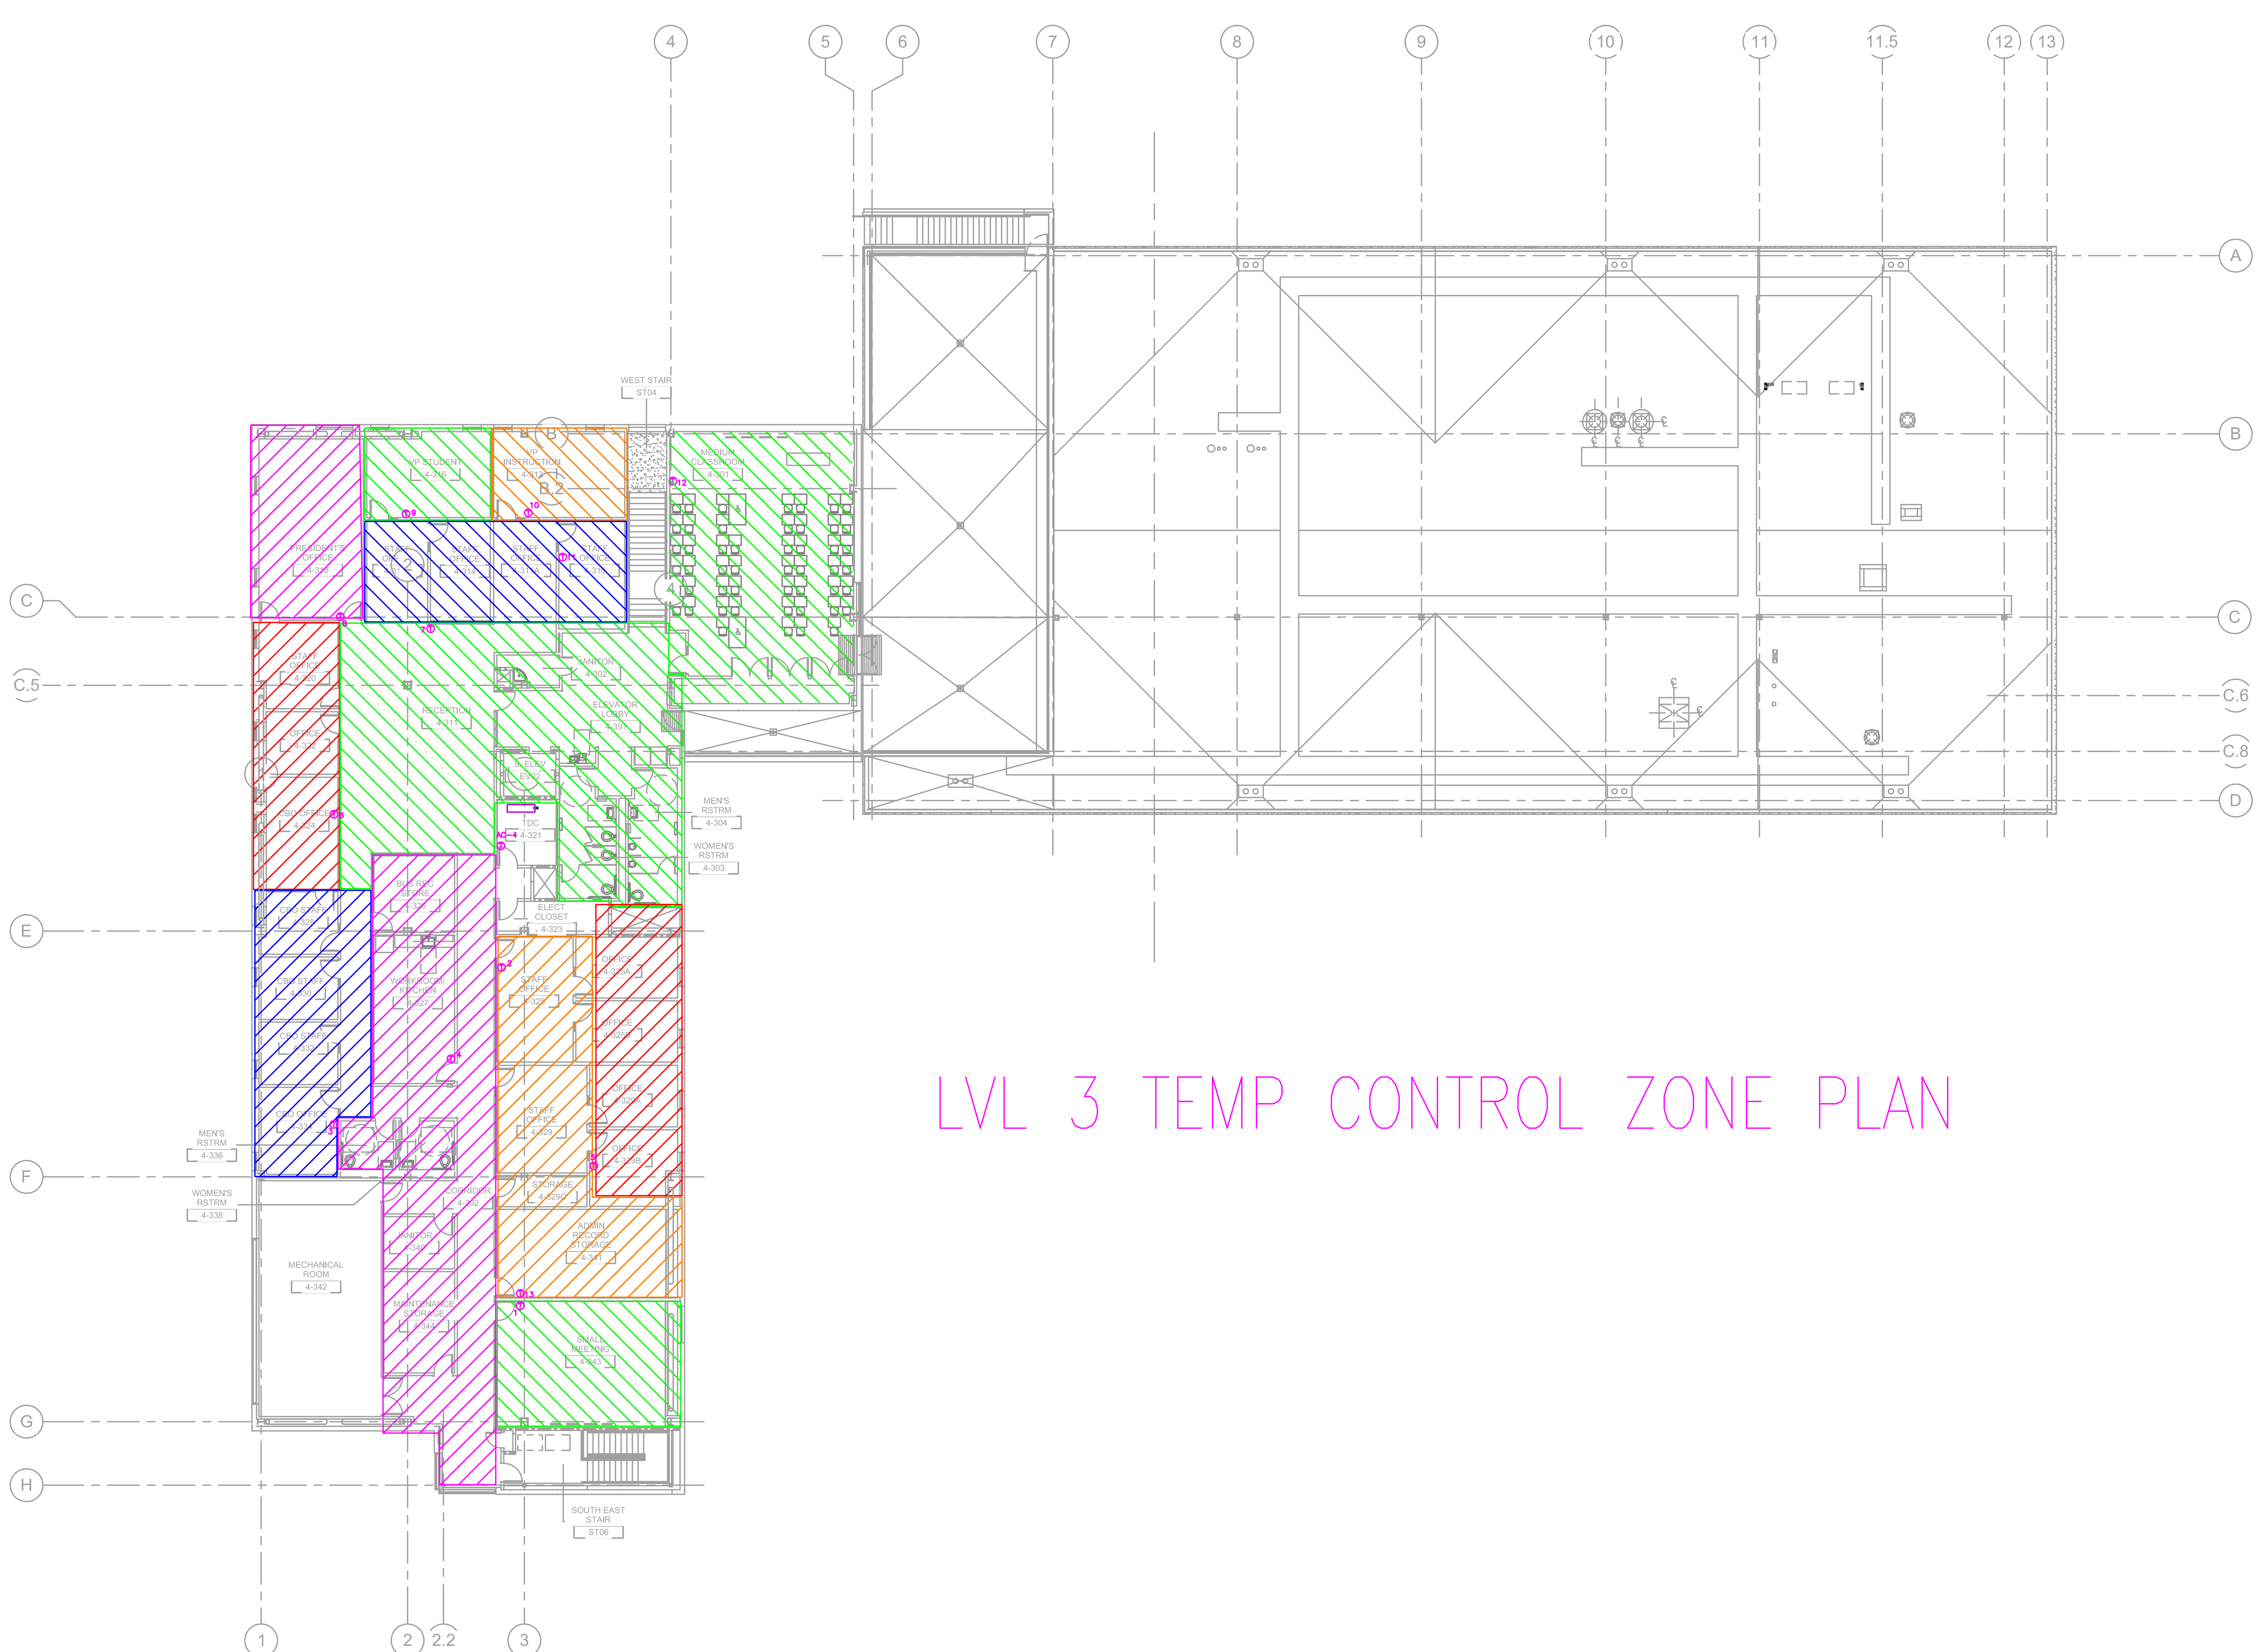

LVL 3 TEMP CONTROL ZONE PLAN

All drawings and written material appearing herein constitute original and unpublished work of the Architect/Engineer and may not be duplicated, used or disclosed without consent of Architect/Engineer.
If this drawing is not 30"x42", then the drawing has been revised from its original size. Noted scales must be adjusted. This line should be equal to one inch.