


NO.	ISSUES/REVISIONS	DATE
	100% SCHEMATIC DESIGN	04/28/08
	50 % DESIGN DEVELOPMENT	06/13/08
	100% DESIGN DEVELOPMENT	07/28/08
	INCREMENT 2 80% REVIEW	09/10/08
	DSA INCREMENT 2	
	STRUCTURE & GFRC PANELS	11/11/08
7	DSA INCREMENT #3 50% REVIEW	11/11/08
9	DSA INCREMENT #3 80% REVIEW	12/15/08
10	DSA INCREMENT #3	02/09/09
	TENANT IMPROVEMENT AND ROOFING SYSTEM	
12	HVAC REVIEW	04/30/09
14	DSA INCREMENT #3 BACKCHECK	05/12/09
15	ISSUE FOR CONSTRUCTION AS-BUILTS	12/15/10



DIVISION OF THE STATE ARCHITECT
APPL # 01-110117
FILE # 41-C1
AC _____ FLS _____
SSS _____ DATE _____
IDENTIFICATION STAMP

Increment 3

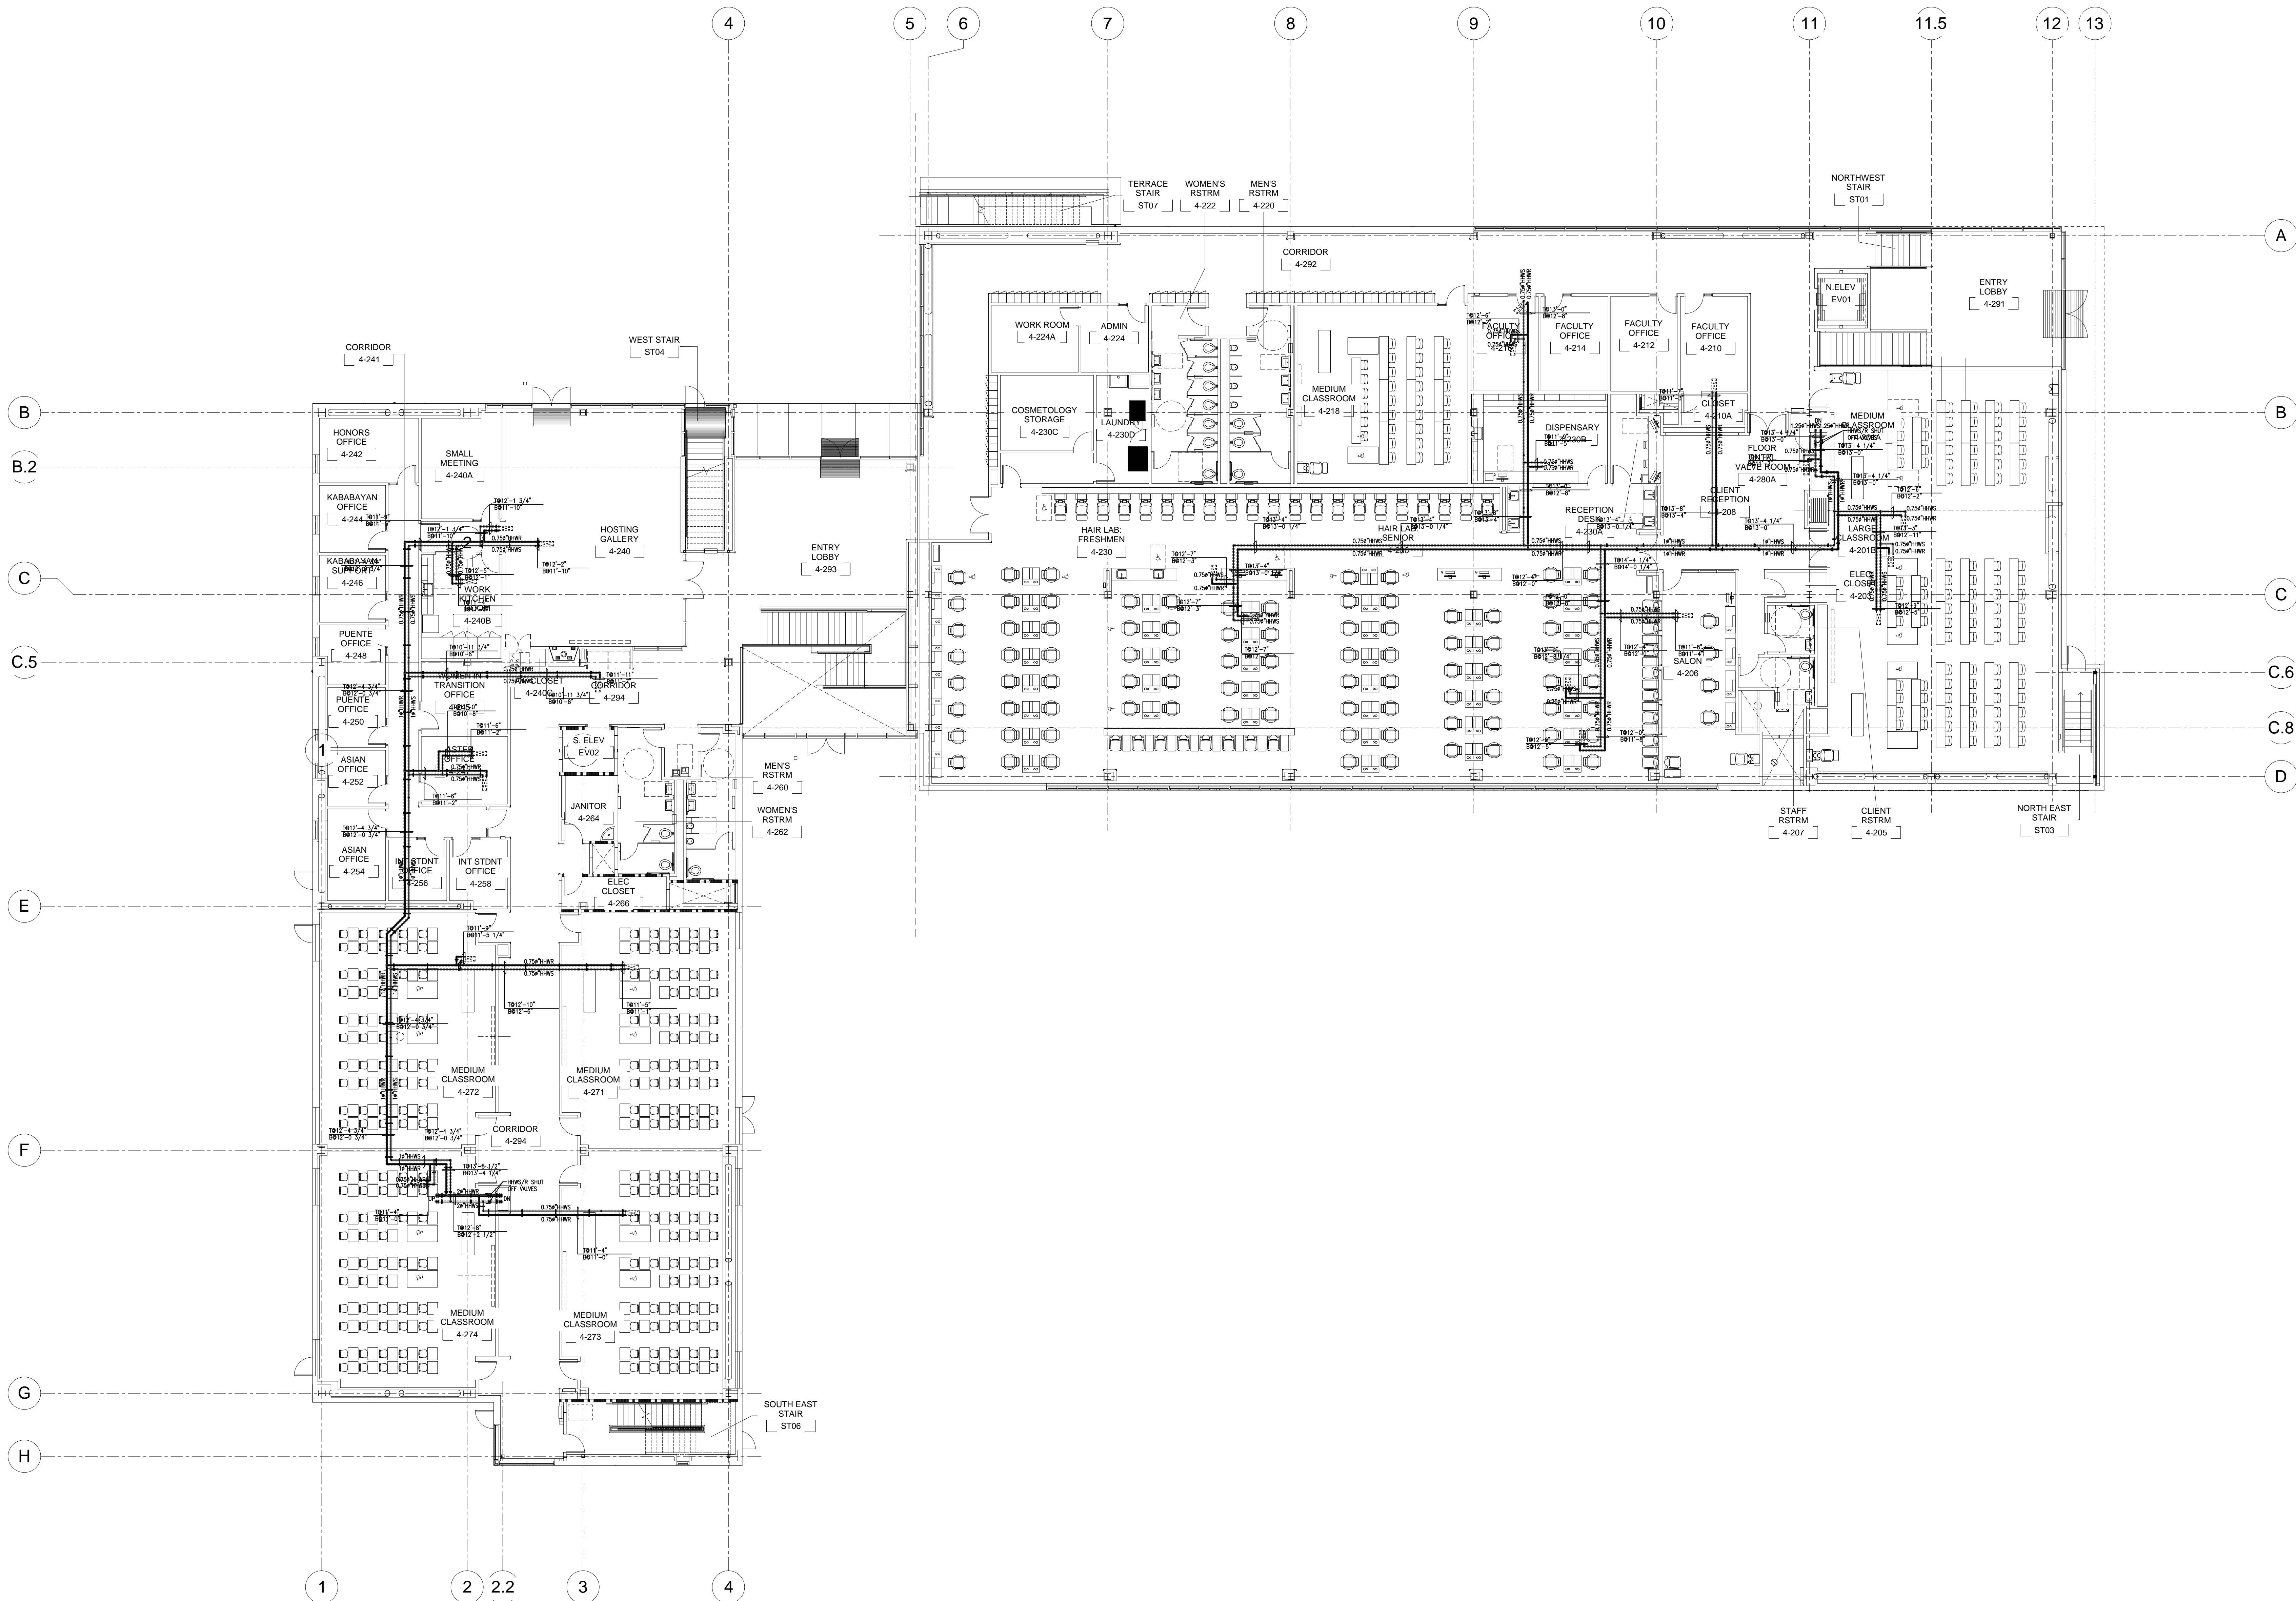

SKYLINE COLLEGE
SAN MATEO COUNTY
COMMUNITY COLLEGE
DISTRICT
CIP2 DESIGN-BUILD
PROJECT
BUILDING 4
INCREMENT 3

KEY PLAN
CMI PROJECT NO. 28212 DRAWN BY:
DATE: 04/28/08 CHECKED BY:
SCALE: 0' 4' 8' 12' 16' 24' 32'
SHEET TITLE:
LEVEL 2
MECHANICAL
PIPING OVERALL
FLOOR PLAN
SHEET NO. MP-202