

**WRNSSTUDIO** 

**501 SECOND STREET** 4TH FLOOR, STE. 402 SAN FRANCISCO CALIFORNIA 94107 415.489.2224 TEL 415.358.9100 FAX WWW.WRNSSTUDIO.COM

Steinberg Architects



**Hensel Phelps Construction Co.** 

CRITCHFIELD MECHANICAL, INC. 4085 CAMPBELL AVENUE MENLO PARK, CA 94025


"These drawings and specifications have been prepared by CMI for their exclusive use in accord with Sec. 6737.4 of the Professional Engineers Act of the State of California.

ISSUES/REVISIONS 04/28/08 100% SCHEMATIC DESIGN 50 % DESIGN DEVELOPMENT 06/13/08 100% DESIGN DEVELOPMENT 07/28/08 INCREMENT 2 80% REVIEW 10/10/08 DSA INCREMENT 2 STRUCTURE & GFRC PANELS DSA INCREMENT #3 50% REVIEW DSA INCREMENT #3 90% REVIEW DSA INCREMENT #3 02/09/09 TENANT IMPROVEMENT AND ROOFING SYSTEM HPCC REVIEW DSA INCREMENT #3 BACKCHECK 05/12/09 10/27/09

ISSUED FOR CONSTRUCTION

AS-BUILT DRAWINGS


04/06/11

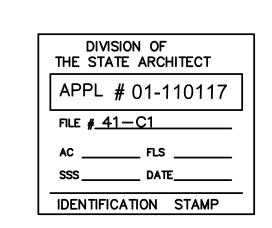



SKYLINE COLLEGE SAN MATEO COUNTY COMMUNITY COLLEGE

CIP2 DESIGN-BUILD **PROJECT BUILDING 4 INCREMENT 3** 

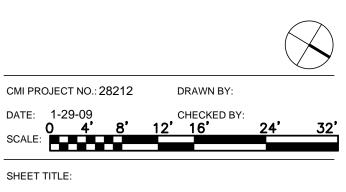

**PLUMBING** SEISMIC **DETAILS** 

P-401