


These drawings and specifications have been prepared by CMT for their exclusive use in accordance with Sec. 6337.4 of the Professional Engineers Act of the State of California.

NO.	ISSUES/REVISIONS	DATE
	100% SCHEMATIC DESIGN	04/28/08
	50% DESIGN DEVELOPMENT	06/13/08
	100% DESIGN DEVELOPMENT	07/28/08
	INCREMENT 2 80% REVIEW	09/10/08
	DSA INCREMENT 2	
7	STRUCTURE & GFRG PANELS	11/11/08
	DSA INCREMENT #3 80% REVIEW	11/11/08
9	DSA INCREMENT #3 80% REVIEW	12/18/08
10	DSA INCREMENT #3	02/09/09
	TENANT IMPROVEMENT AND ROOFING SYSTEM	
12	HFCC REVIEW	04/30/09
14	DSA INCREMENT #3 BACKCHECK	05/13/09
	ISSUED FOR CONSTRUCTION	10/27/09
	AS-BUILT DRAWINGS	04/06/11

DIVISION OF THE STATE ARCHITECT
APPL # 01-110117
FILE # 41-C1
AC _____ FLS _____
SSS _____ DATE _____
IDENTIFICATION STAMP

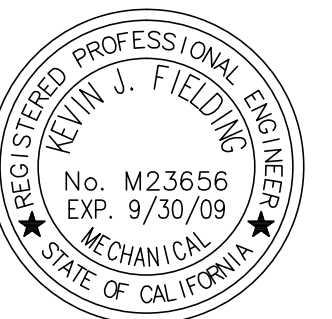


SKYLINE COLLEGE
SAN MATEO COUNTY
COMMUNITY COLLEGE
DISTRICT
CIP2 DESIGN-BUILD
PROJECT
BUILDING 4
INCREMENT 3

REP: PLAN
CMT PROJECT NO: 28212 DRAWN BY:
DATE: 1-29-09 CHECKED BY:
SCALE: 0' 4' 8' 12' 16' 24' 32'
SHEET TITLE:

SEISMIC,
SECOND FLOOR
WASTE & VENT
PLUMBING PLAN

SHEET NO. P-403

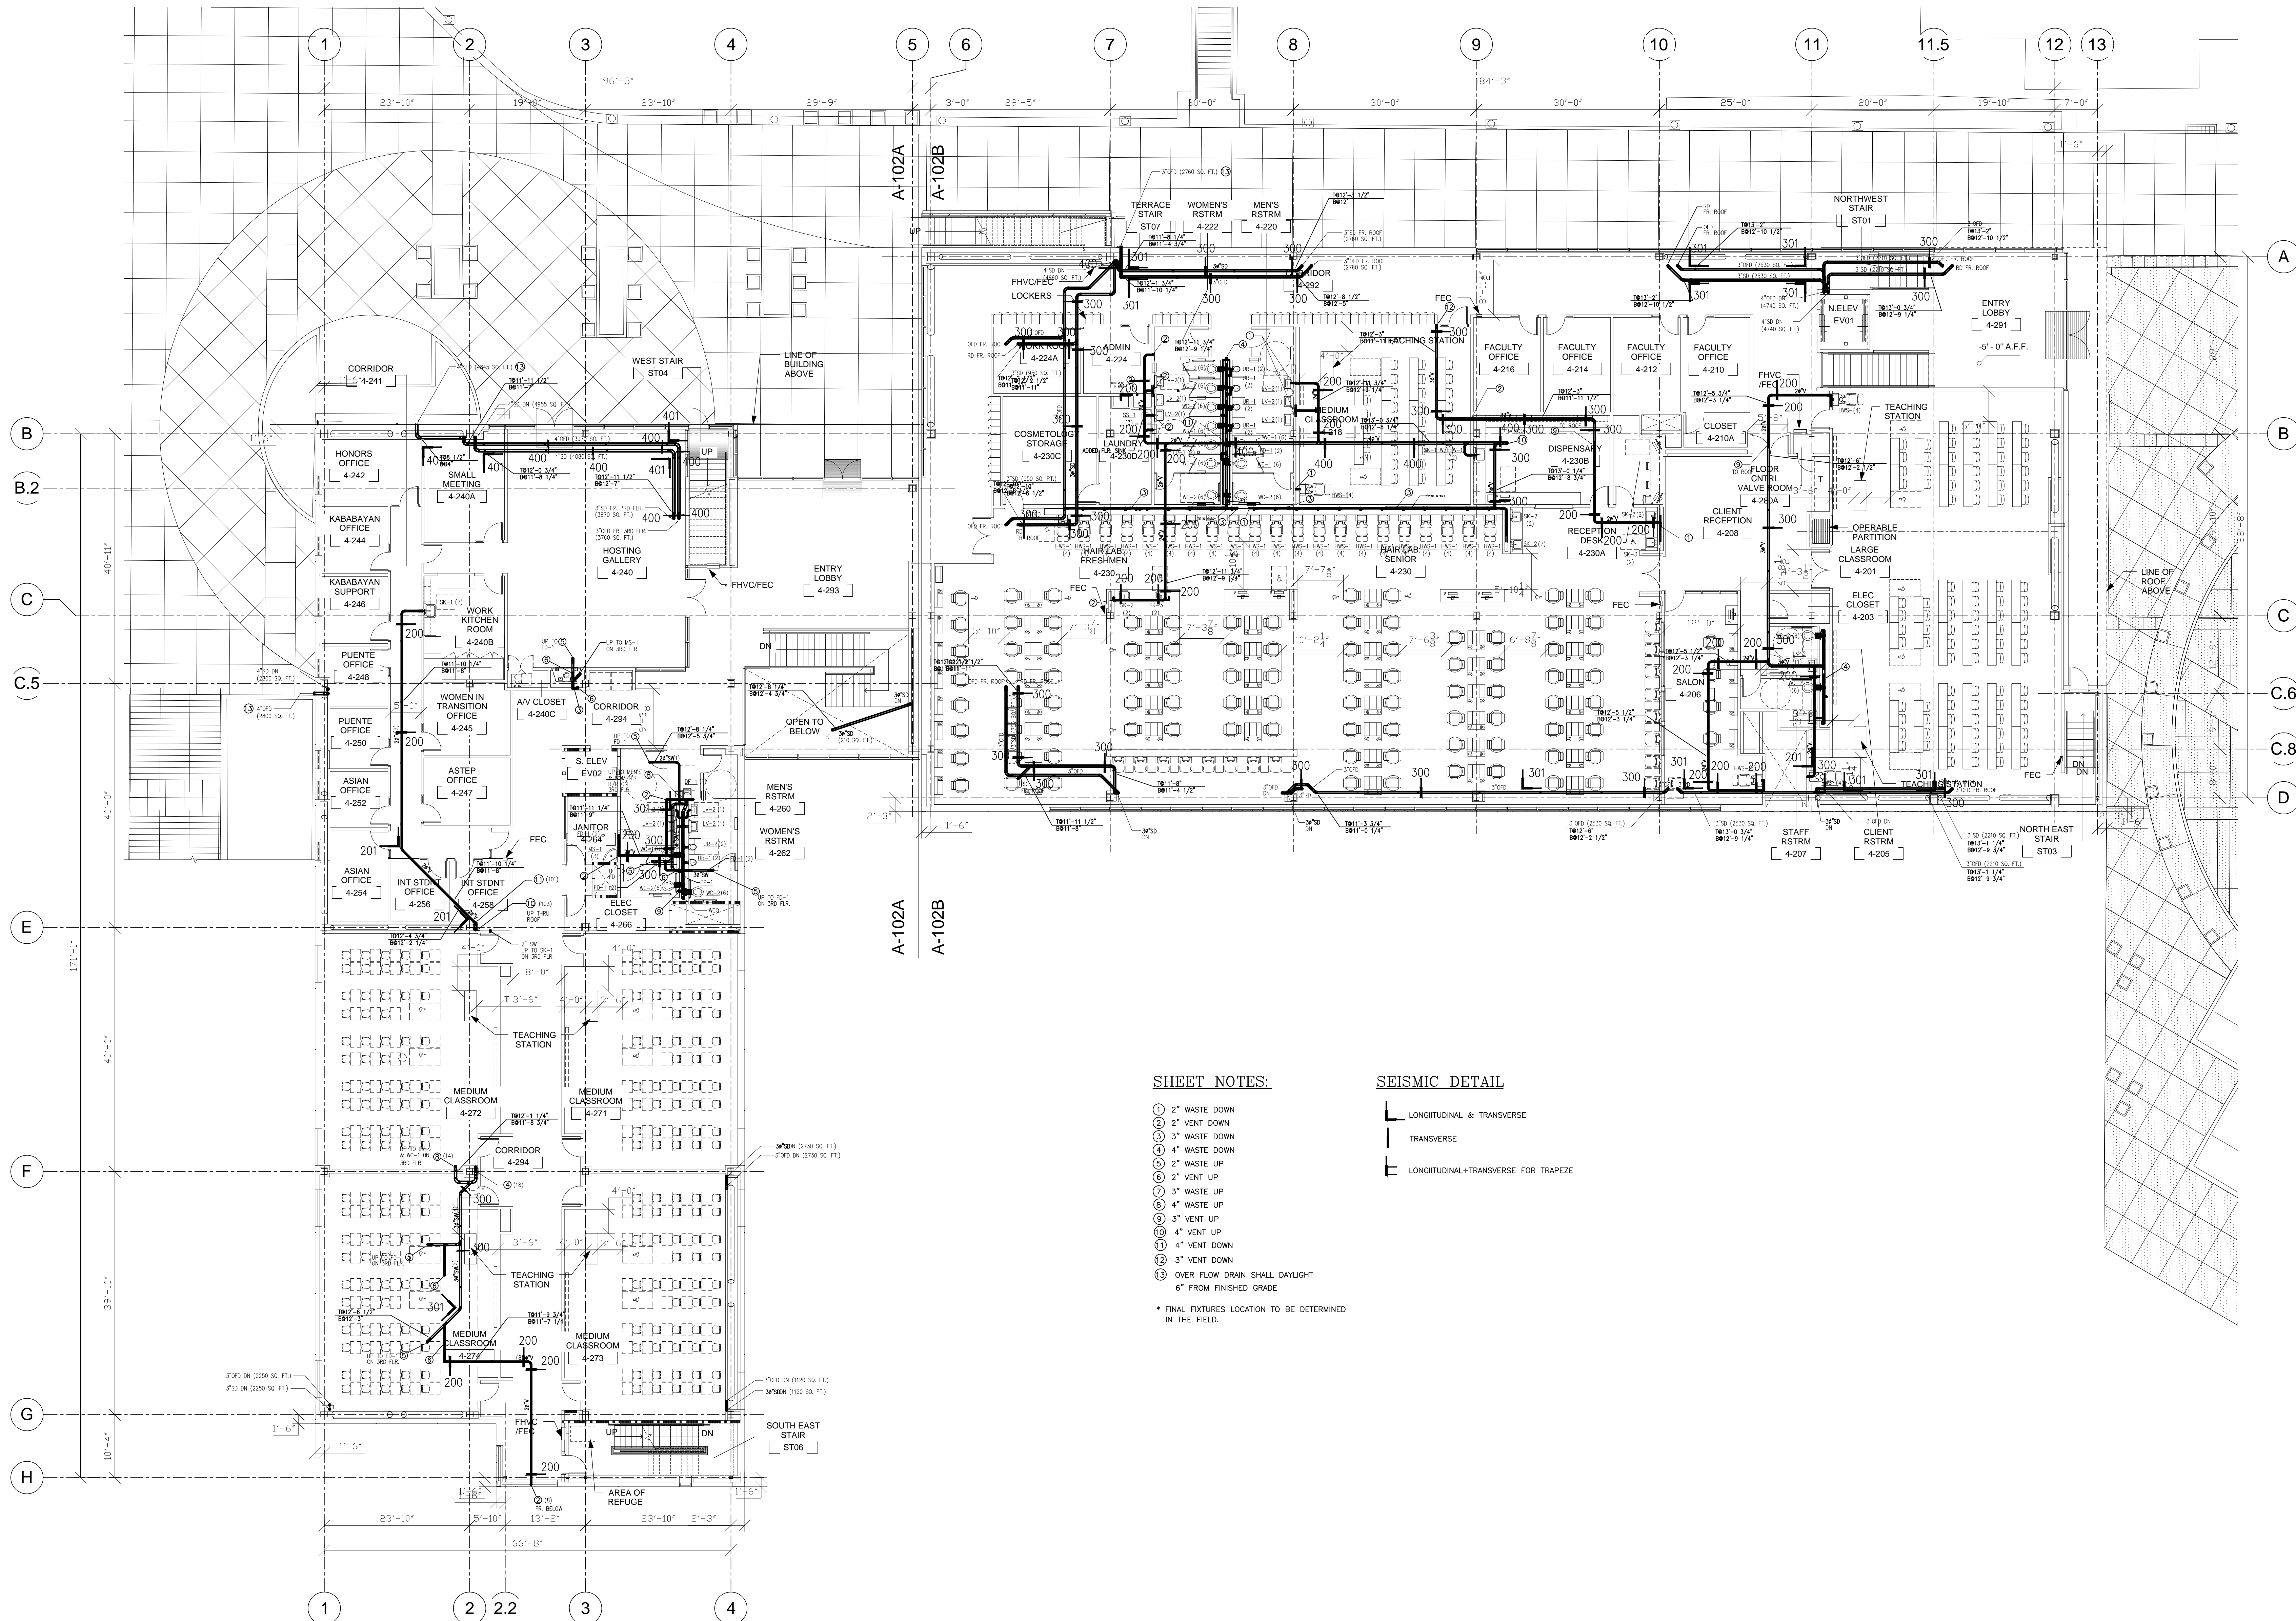

SHEET NOTES:

- ① 2" WASTE DOWN
- ② 2" VENT DOWN
- ③ 3" WASTE DOWN
- ④ 4" WASTE DOWN
- ⑤ 2" WASTE UP
- ⑥ 2" VENT UP
- ⑦ 3" WASTE UP
- ⑧ 4" WASTE UP
- ⑨ 3" VENT UP
- ⑩ 4" VENT UP
- ⑪ 4" VENT DOWN
- ⑫ 3" VENT DOWN
- ⑬ OVER FLOW DRAIN SHALL DAYLIGHT 6" FROM FINISHED GRADE
- * FINAL FIXTURES LOCATION TO BE DETERMINED IN THE FIELD.

SEISMIC DETAIL

- ┌ LONGITUDINAL & TRANSVERSE
- ├ TRANSVERSE
- └ LONGITUDINAL+TRANSVERSE FOR TRAPEZE