




SECTION A-A

## WATER HEATER PIPING DETAIL SCALE: NO SCALE



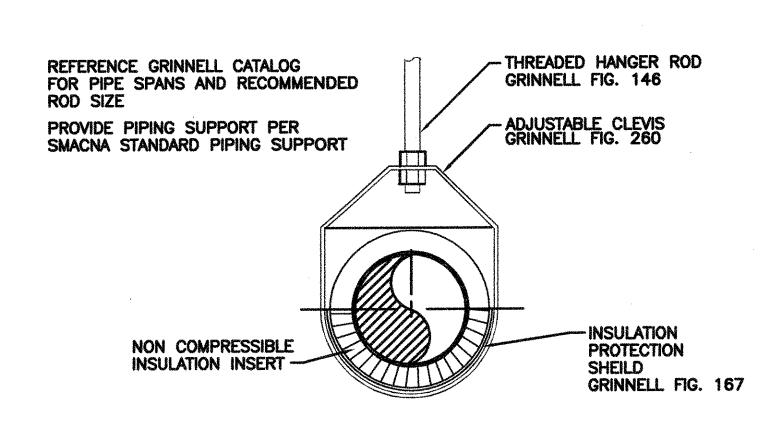

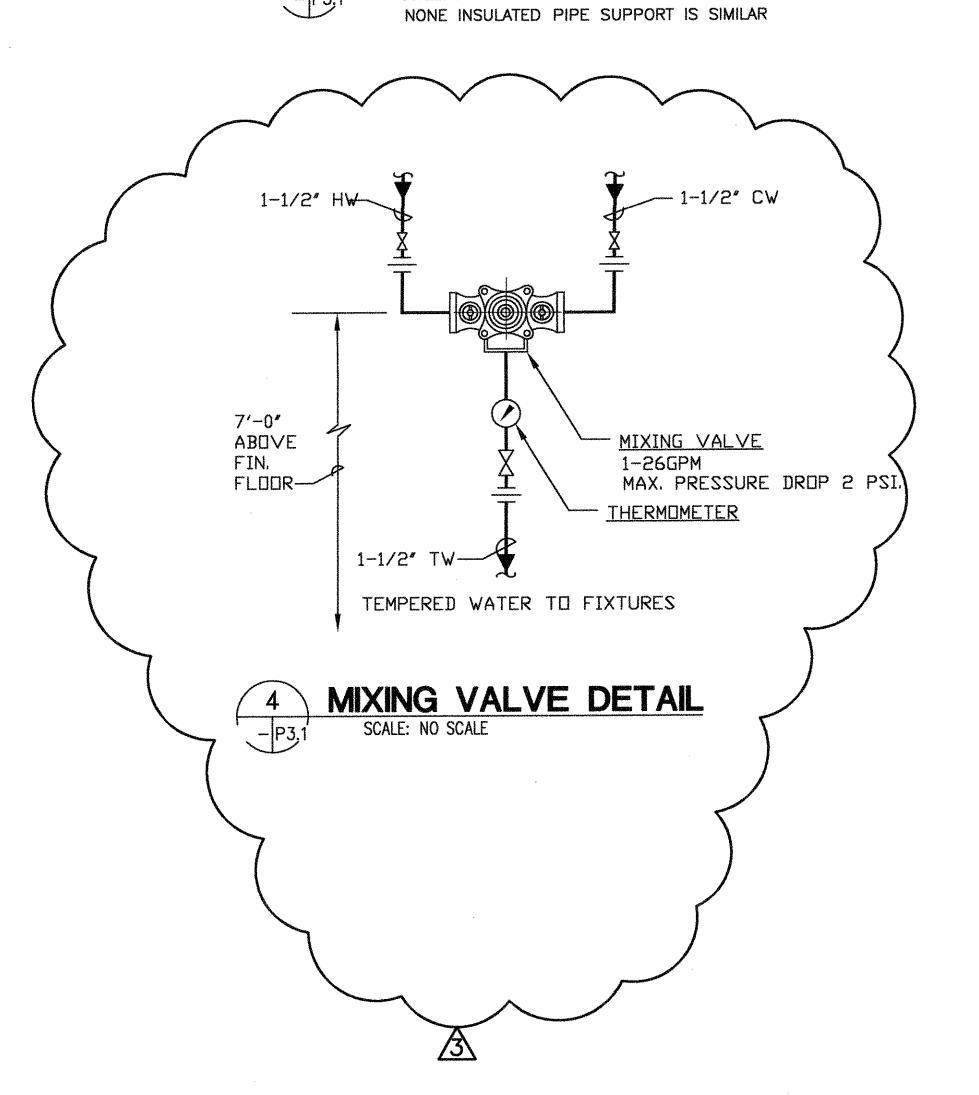

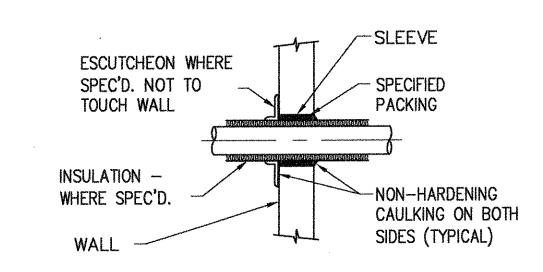

PIPE THRU WALL DETAIL
SCALE: NO SCALE

Sugimura ★ S C 26311 REN FEB. 28 2005

2145.002 13 FEB 2004-