

NO.	REVISIONS	DATE
1	ISSUE FOR PERMIT	02/11/10
2	NO. 30 SCHEMATIC DESIGN SUBMITTAL	02/11/10
3	NO. 30 DESIGN DEVELOPMENT SUBMITTAL	02/11/10
4	NO. 30 DESIGN DEVELOPMENT SUBMITTAL	02/11/10
5	NO. 30 DESIGN DEVELOPMENT SUBMITTAL	02/11/10
6	NO. 30 DESIGN DEVELOPMENT SUBMITTAL	02/11/10
7	NO. 30 DESIGN DEVELOPMENT SUBMITTAL	02/11/10
8	NO. 30 DESIGN DEVELOPMENT SUBMITTAL	02/11/10
9	NO. 30 DESIGN DEVELOPMENT SUBMITTAL	02/11/10
10	NO. 30 DESIGN DEVELOPMENT SUBMITTAL	02/11/10
11	NO. 30 DESIGN DEVELOPMENT SUBMITTAL	02/11/10




DIVISION OF THE
 STATE ARCHITECT
 APPL # 01-110117
 REG. # ARCHT
 AG _____ RS _____
 SSS _____ DNE _____
 IDENTIFICATION
 STAMP

SKYLINE COLLEGE
 SAN JUANITO COUNTY
 COMMUNITY COLLEGE
 DRG PROJ
CIP2 DESIGN-BUILD
PROJECT
BUILDING 4
INCREMENT 2
 FLOOR PLAN

LEVEL 2
OVERALL
FLOOR PLAN
AS BUILT DRAWINGS
JANUARY 12, 2011

PC-102

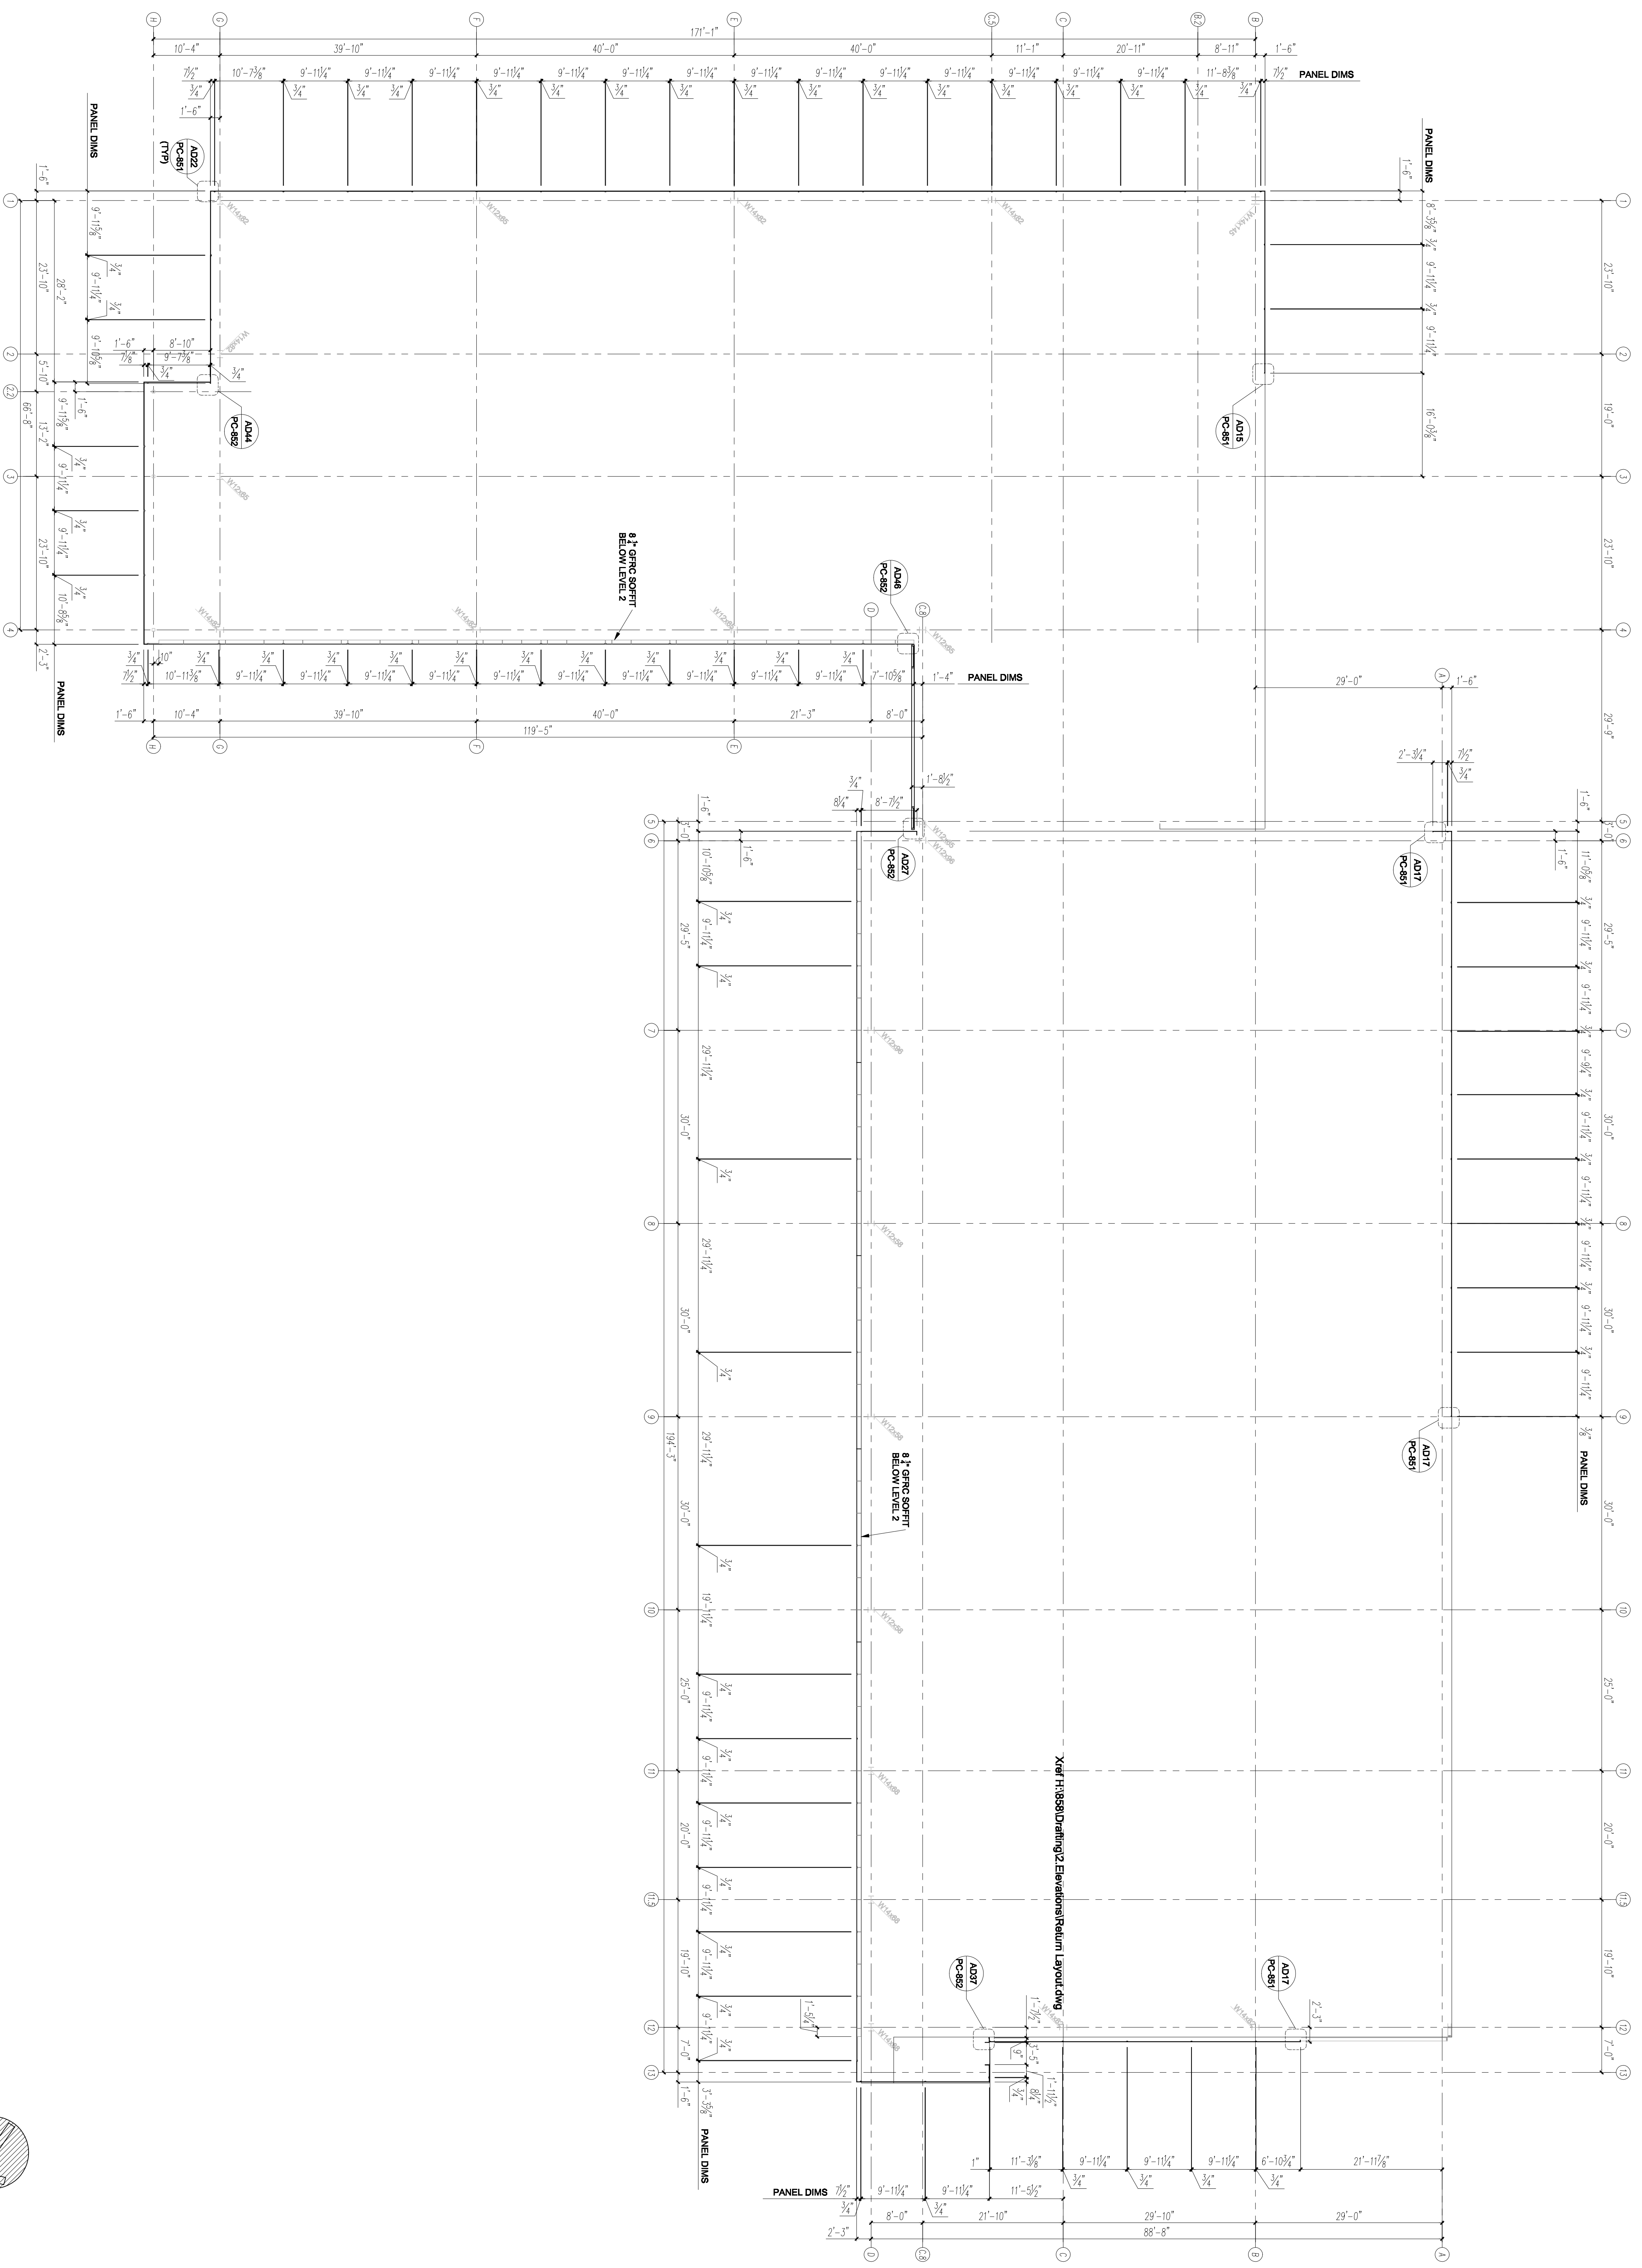

LEVEL 2 - FLOOR PLAN 1

All drawings and notes are the property of Steinberg Architects and shall remain the property of Steinberg Architects. No part of these drawings may be reproduced, stored in a retrieval system, or transmitted in any form or by any means, electronic, mechanical, photocopying, recording, or by any information storage and retrieval system, without the prior written permission of Steinberg Architects.

This drawing is not to be used for any other project without the prior written permission of Steinberg Architects. The use of this drawing for any other project without the prior written permission of Steinberg Architects is strictly prohibited.