

**WILLS CONSTRUCTION CO. INC.**  
 PRE-CAST CONCRETE PRODUCTS  
 2281 SAN JUAN AVENUE, SAN JUAN BAPTIST CA, 95045  
 TEL: (925) 622-2900 FAX: (925) 622-2908

NO.	REVISIONS	DATE
1	100% SCHEMATIC DESIGN SUBMITTAL	02/08/10
2	90% DESIGN DEVELOPMENT SUBMITTAL	03/09/10
3	100% DESIGN DEVELOPMENT SUBMITTAL	03/09/10
4	FINAL DESIGN DEVELOPMENT SUBMITTAL	03/09/10
5	PERMITS	10/09/10
6	PERMITS	10/09/10
7	PERMITS	10/09/10
8	PERMITS	10/09/10
9	PERMITS	10/09/10
10	PERMITS	10/09/10
11	PERMITS	03/11/10



DIVISION OF THE  
 STATE ARCHITECT  
 APPL # 01-10117  
 FILE # A-101  
 AG: RS  
 SSS: DME  
 IDENTIFICATION  
 STAMP









**SKYLINE COLLEGE**  
 SAN JUAN COUNTY  
 COMMUNITY COLLEGE  
 DESIGN  
**CIP2 DESIGN-BUILD**  
**PROJECT**  
**BUILDING 4**  
**INCREMENT 2**

DATE: 04/08/09  
 DRAWN BY: JACO  
 CHECKED BY:  
 SCALE: 1/8" = 1'-0"

**CONNECTION**  
**DETAILS**

**AS BUILT DRAWINGS**  
**JANUARY 12, 2011**

PC-831

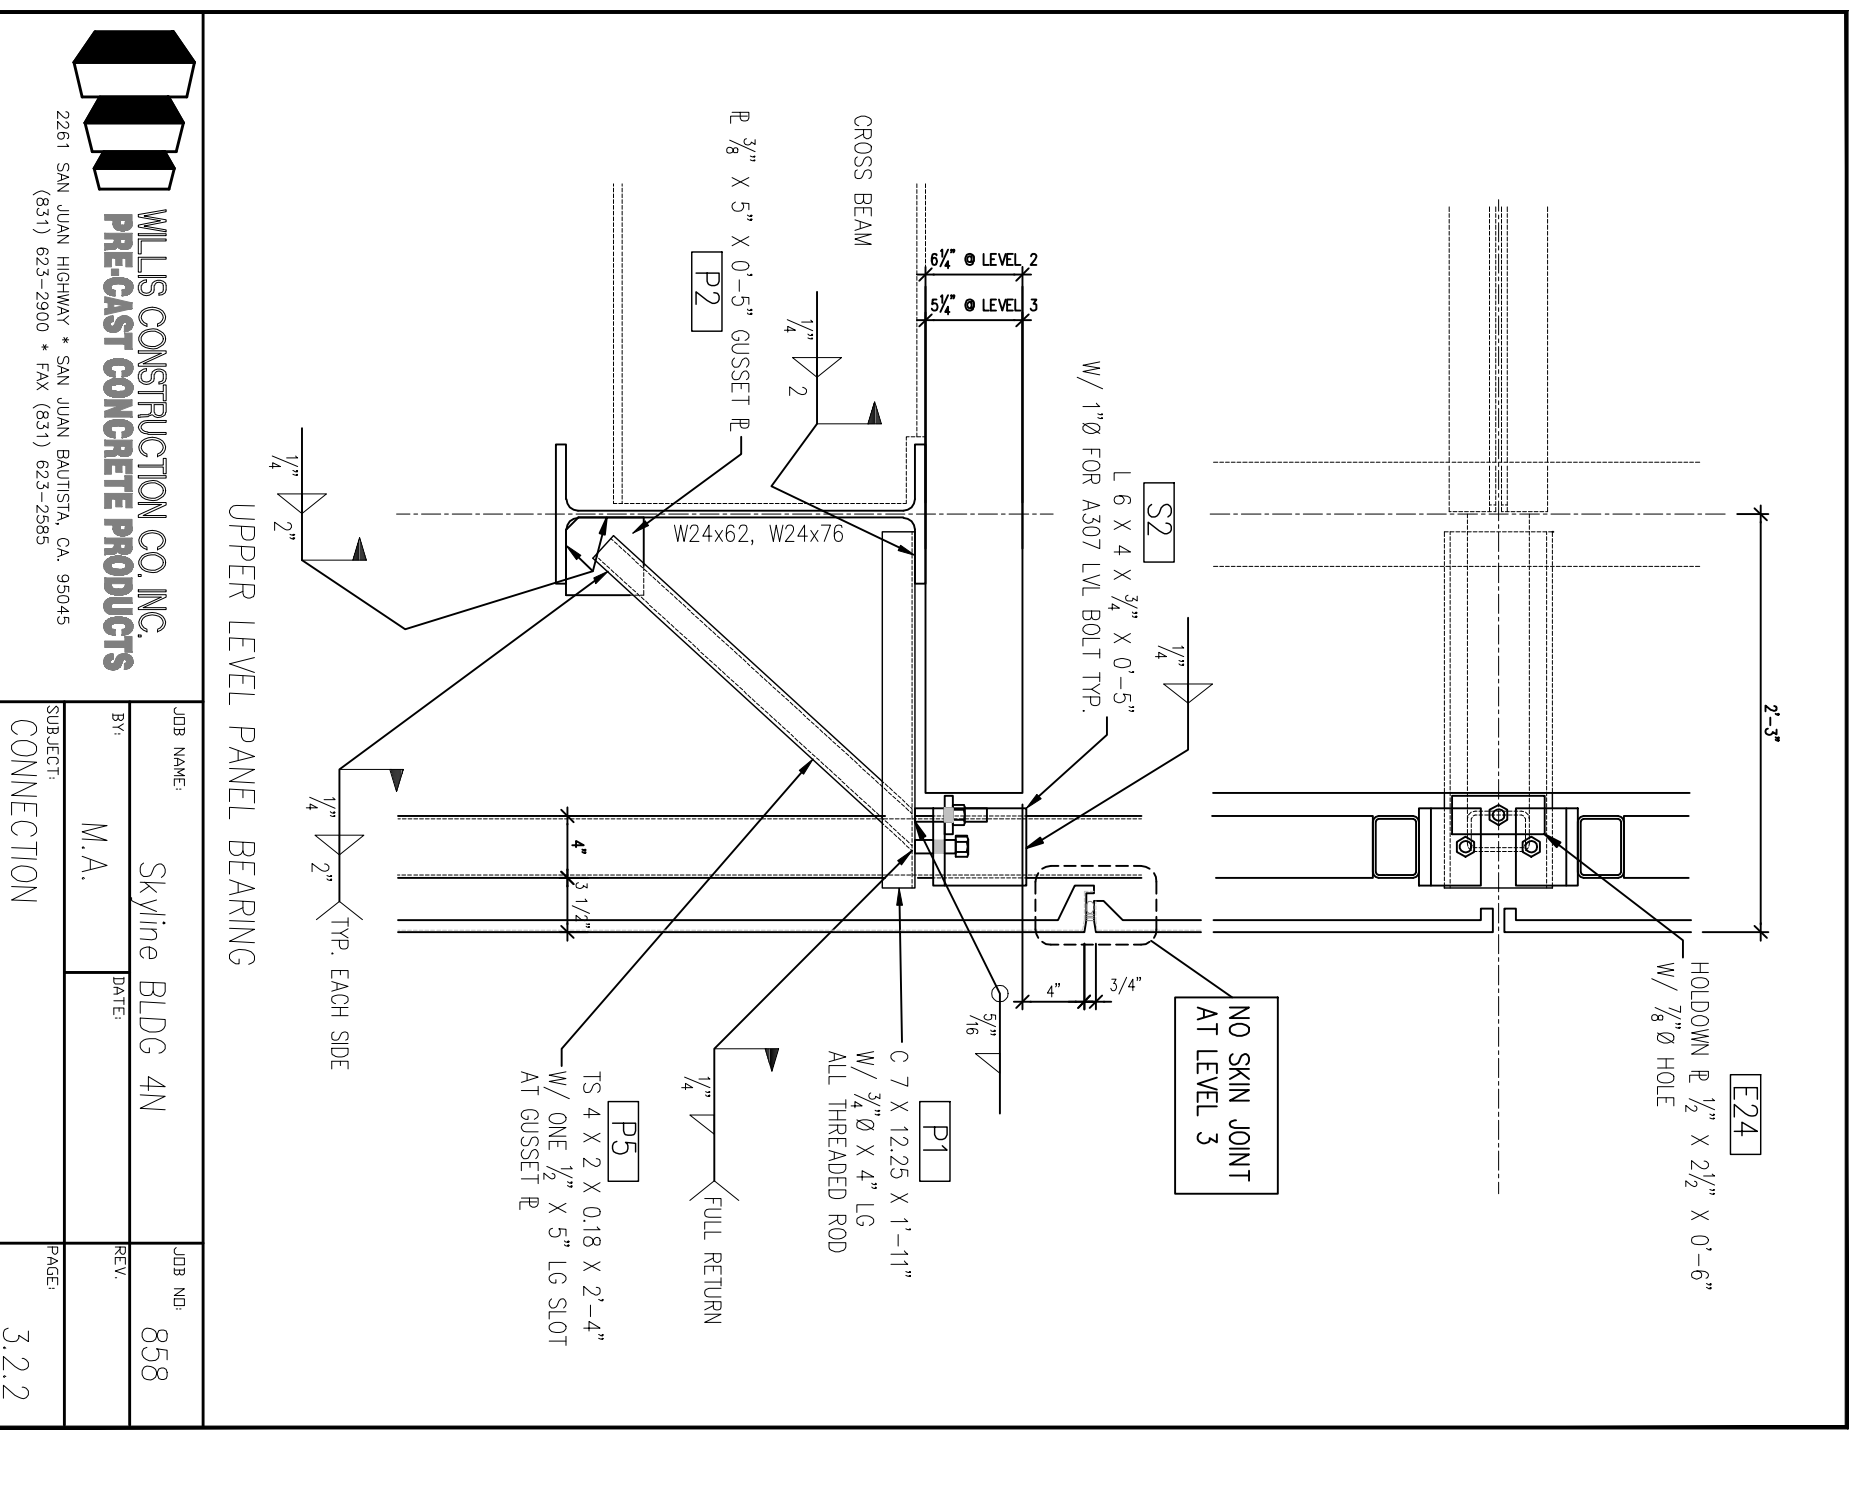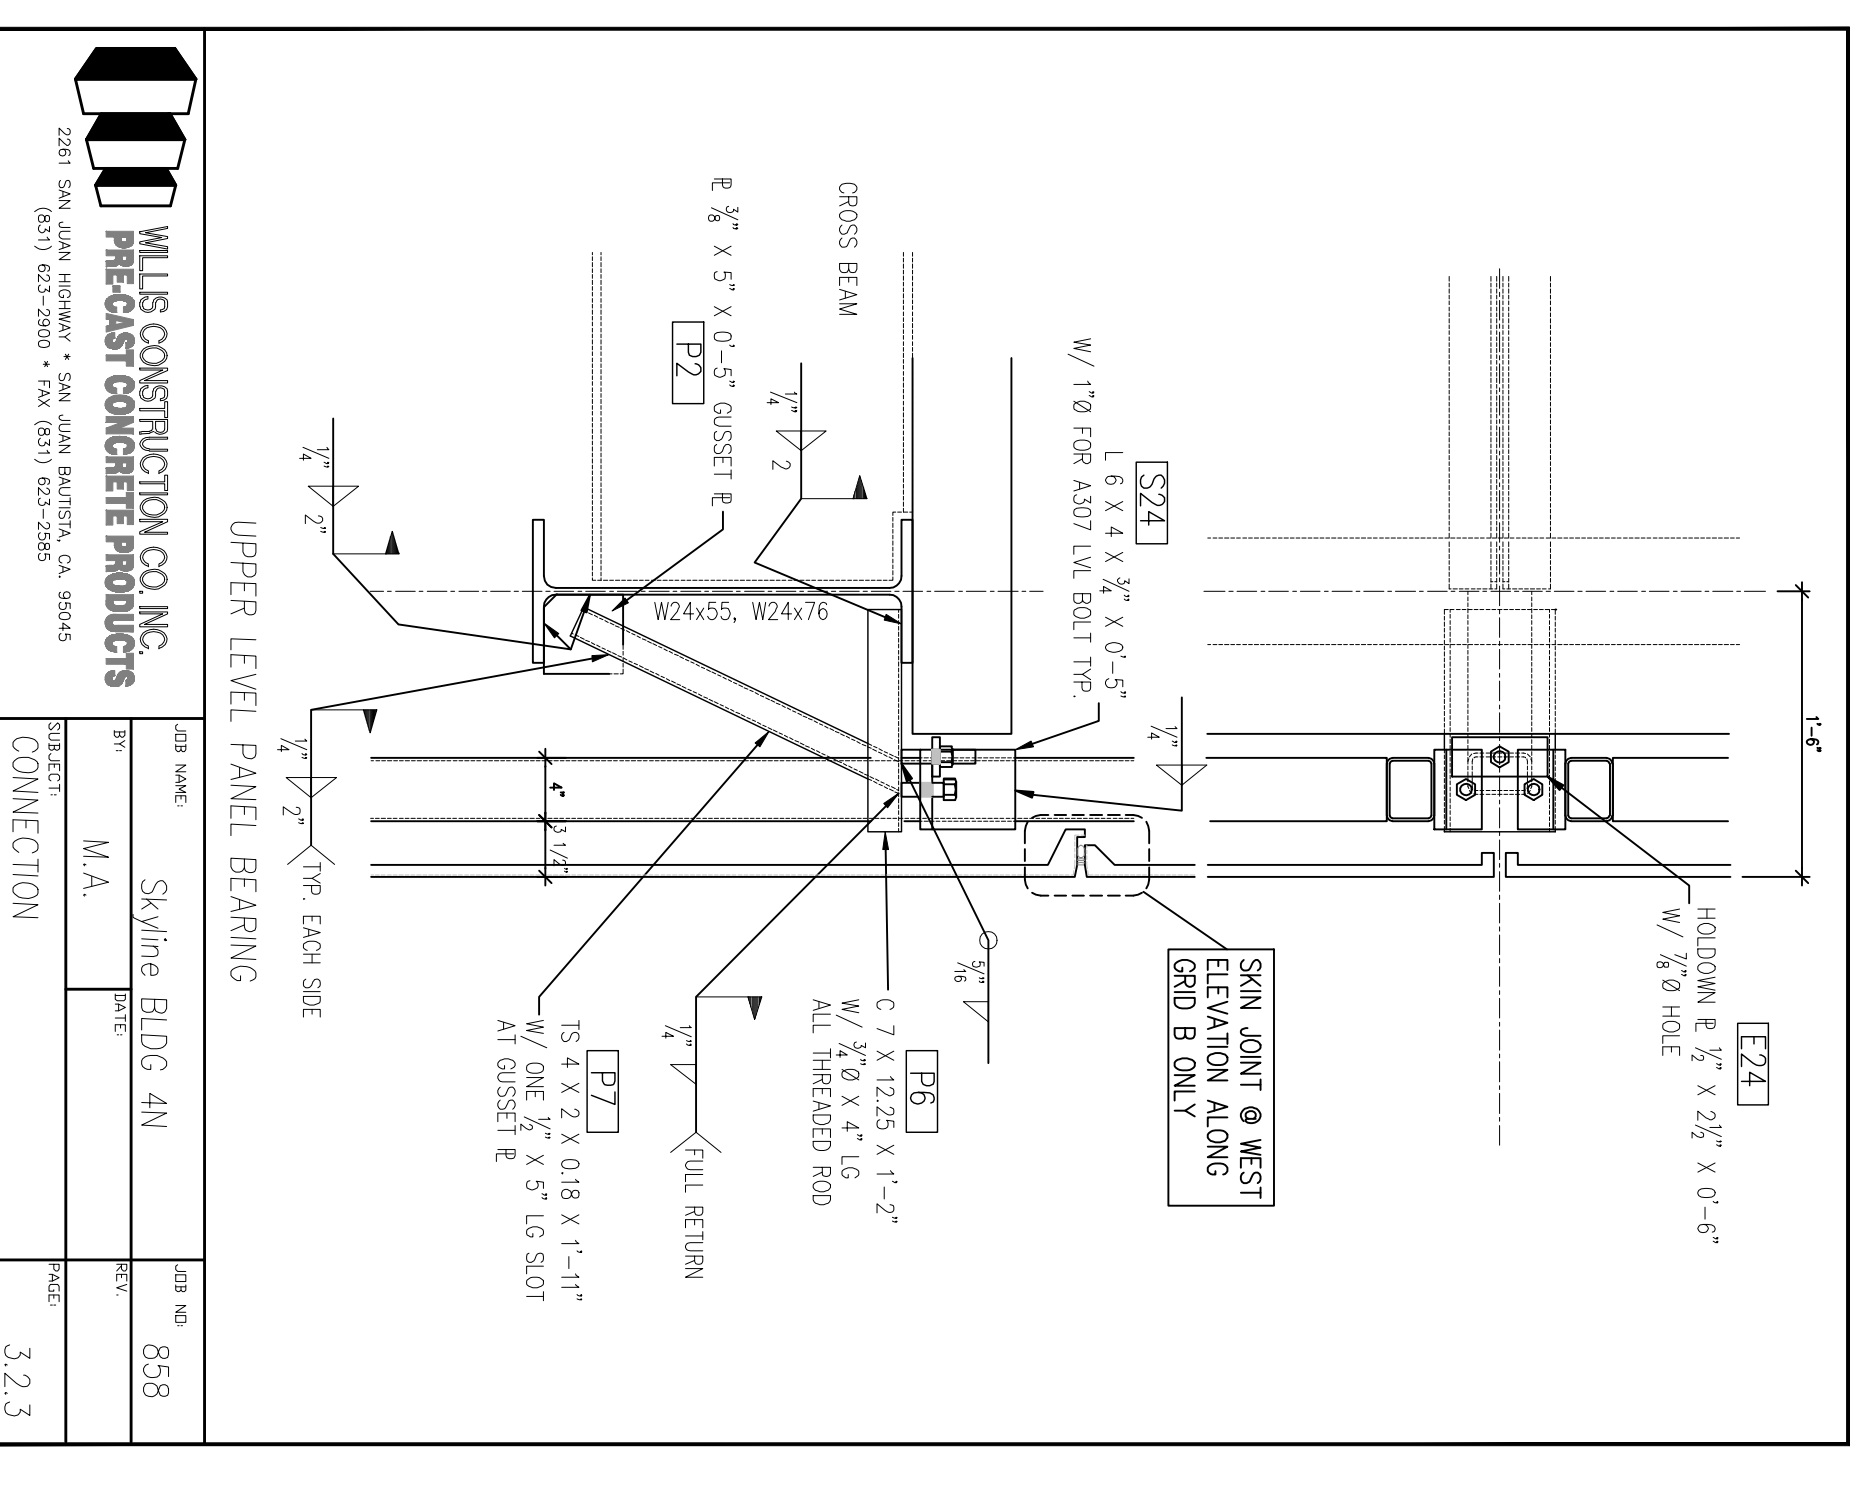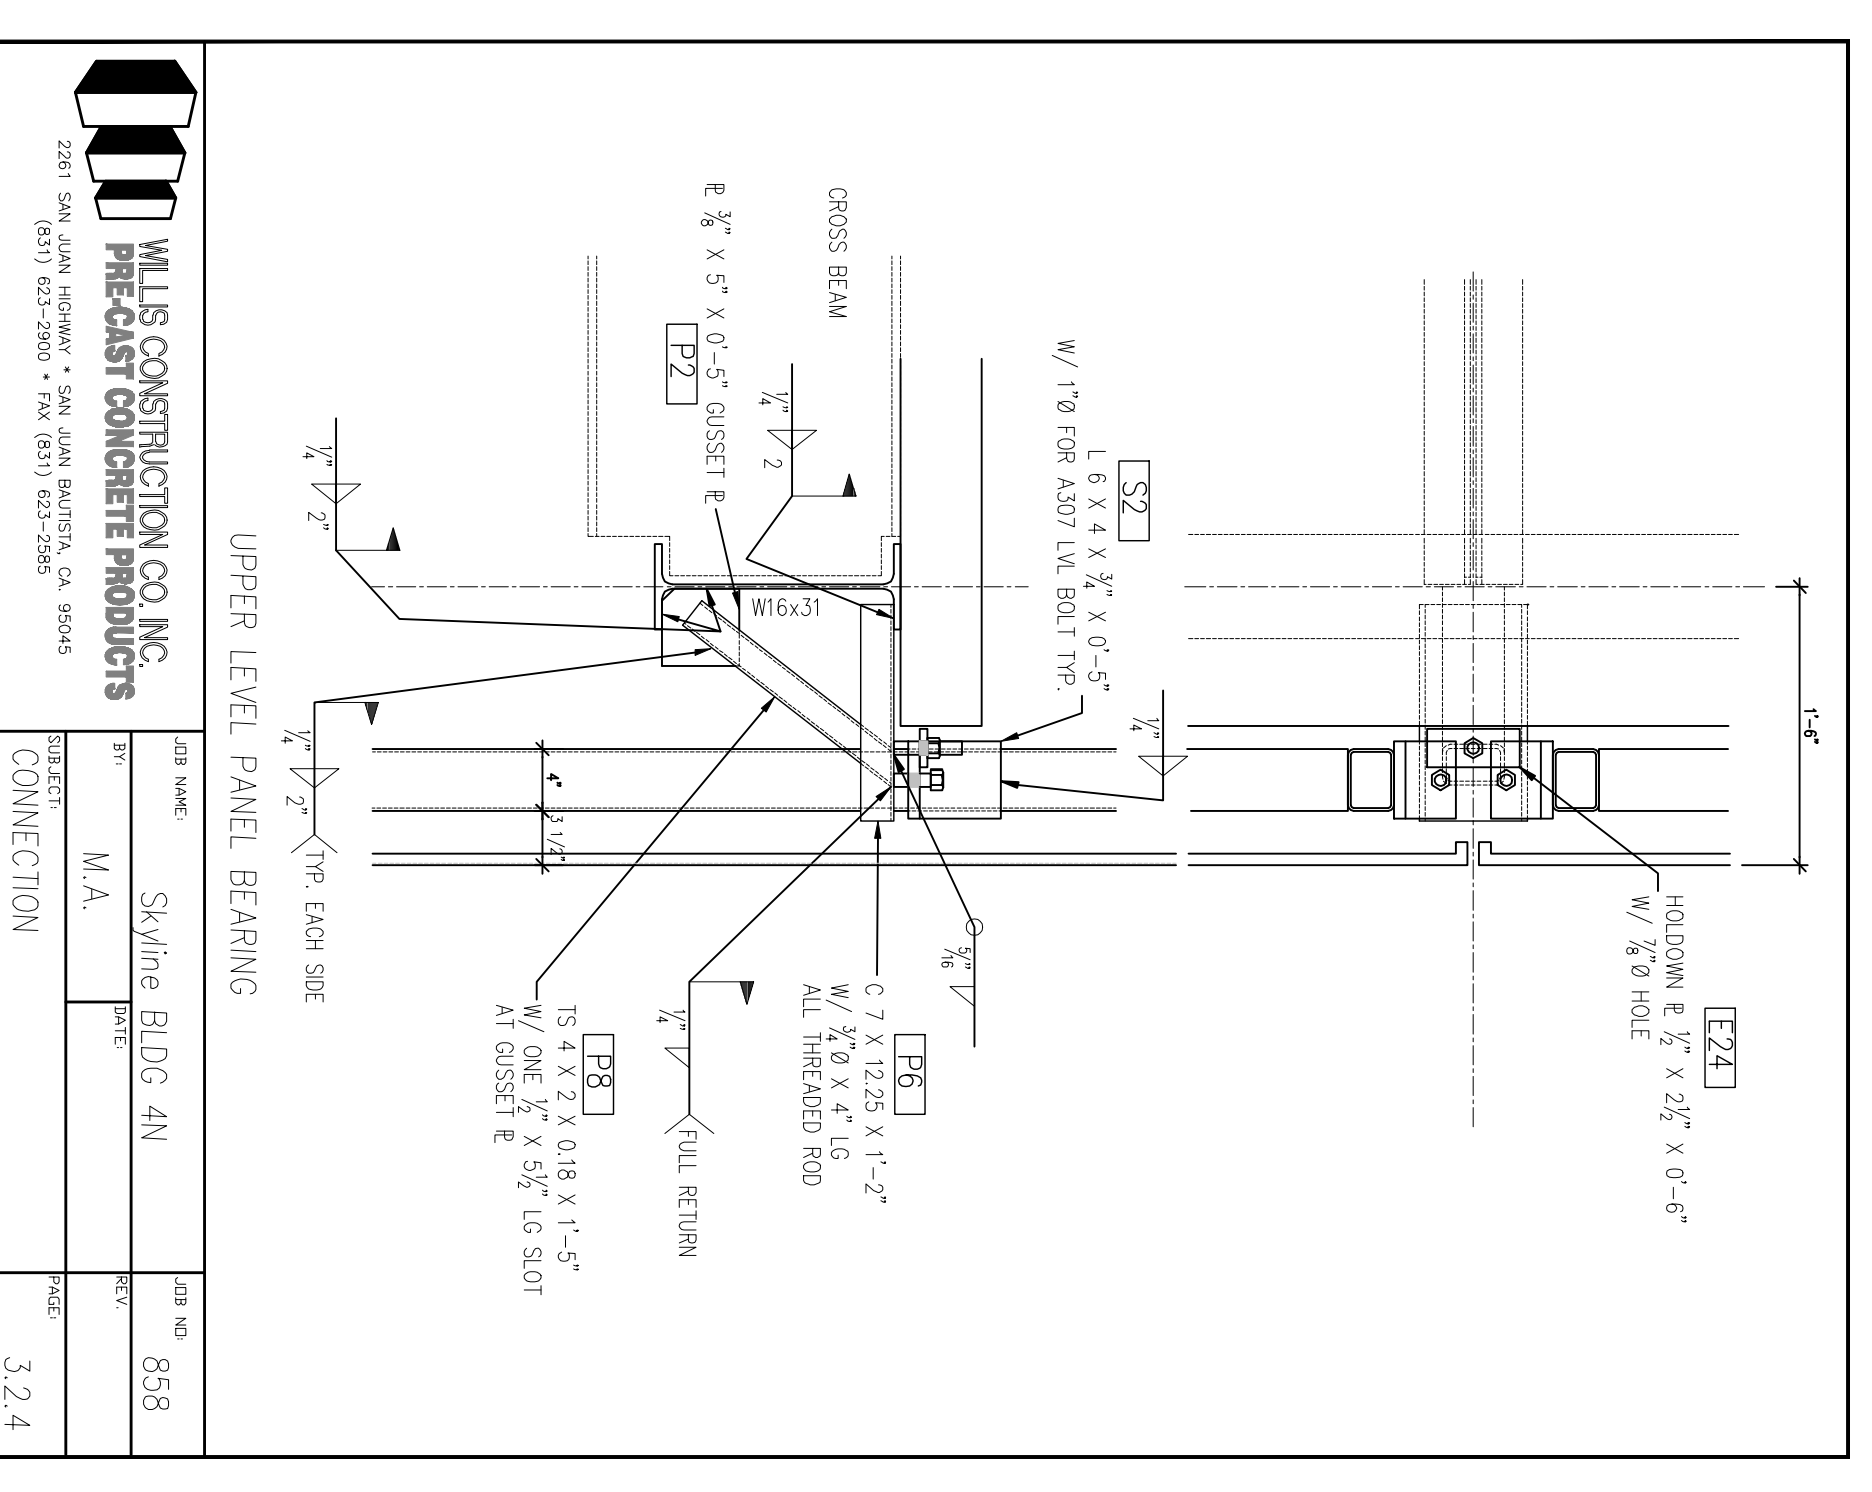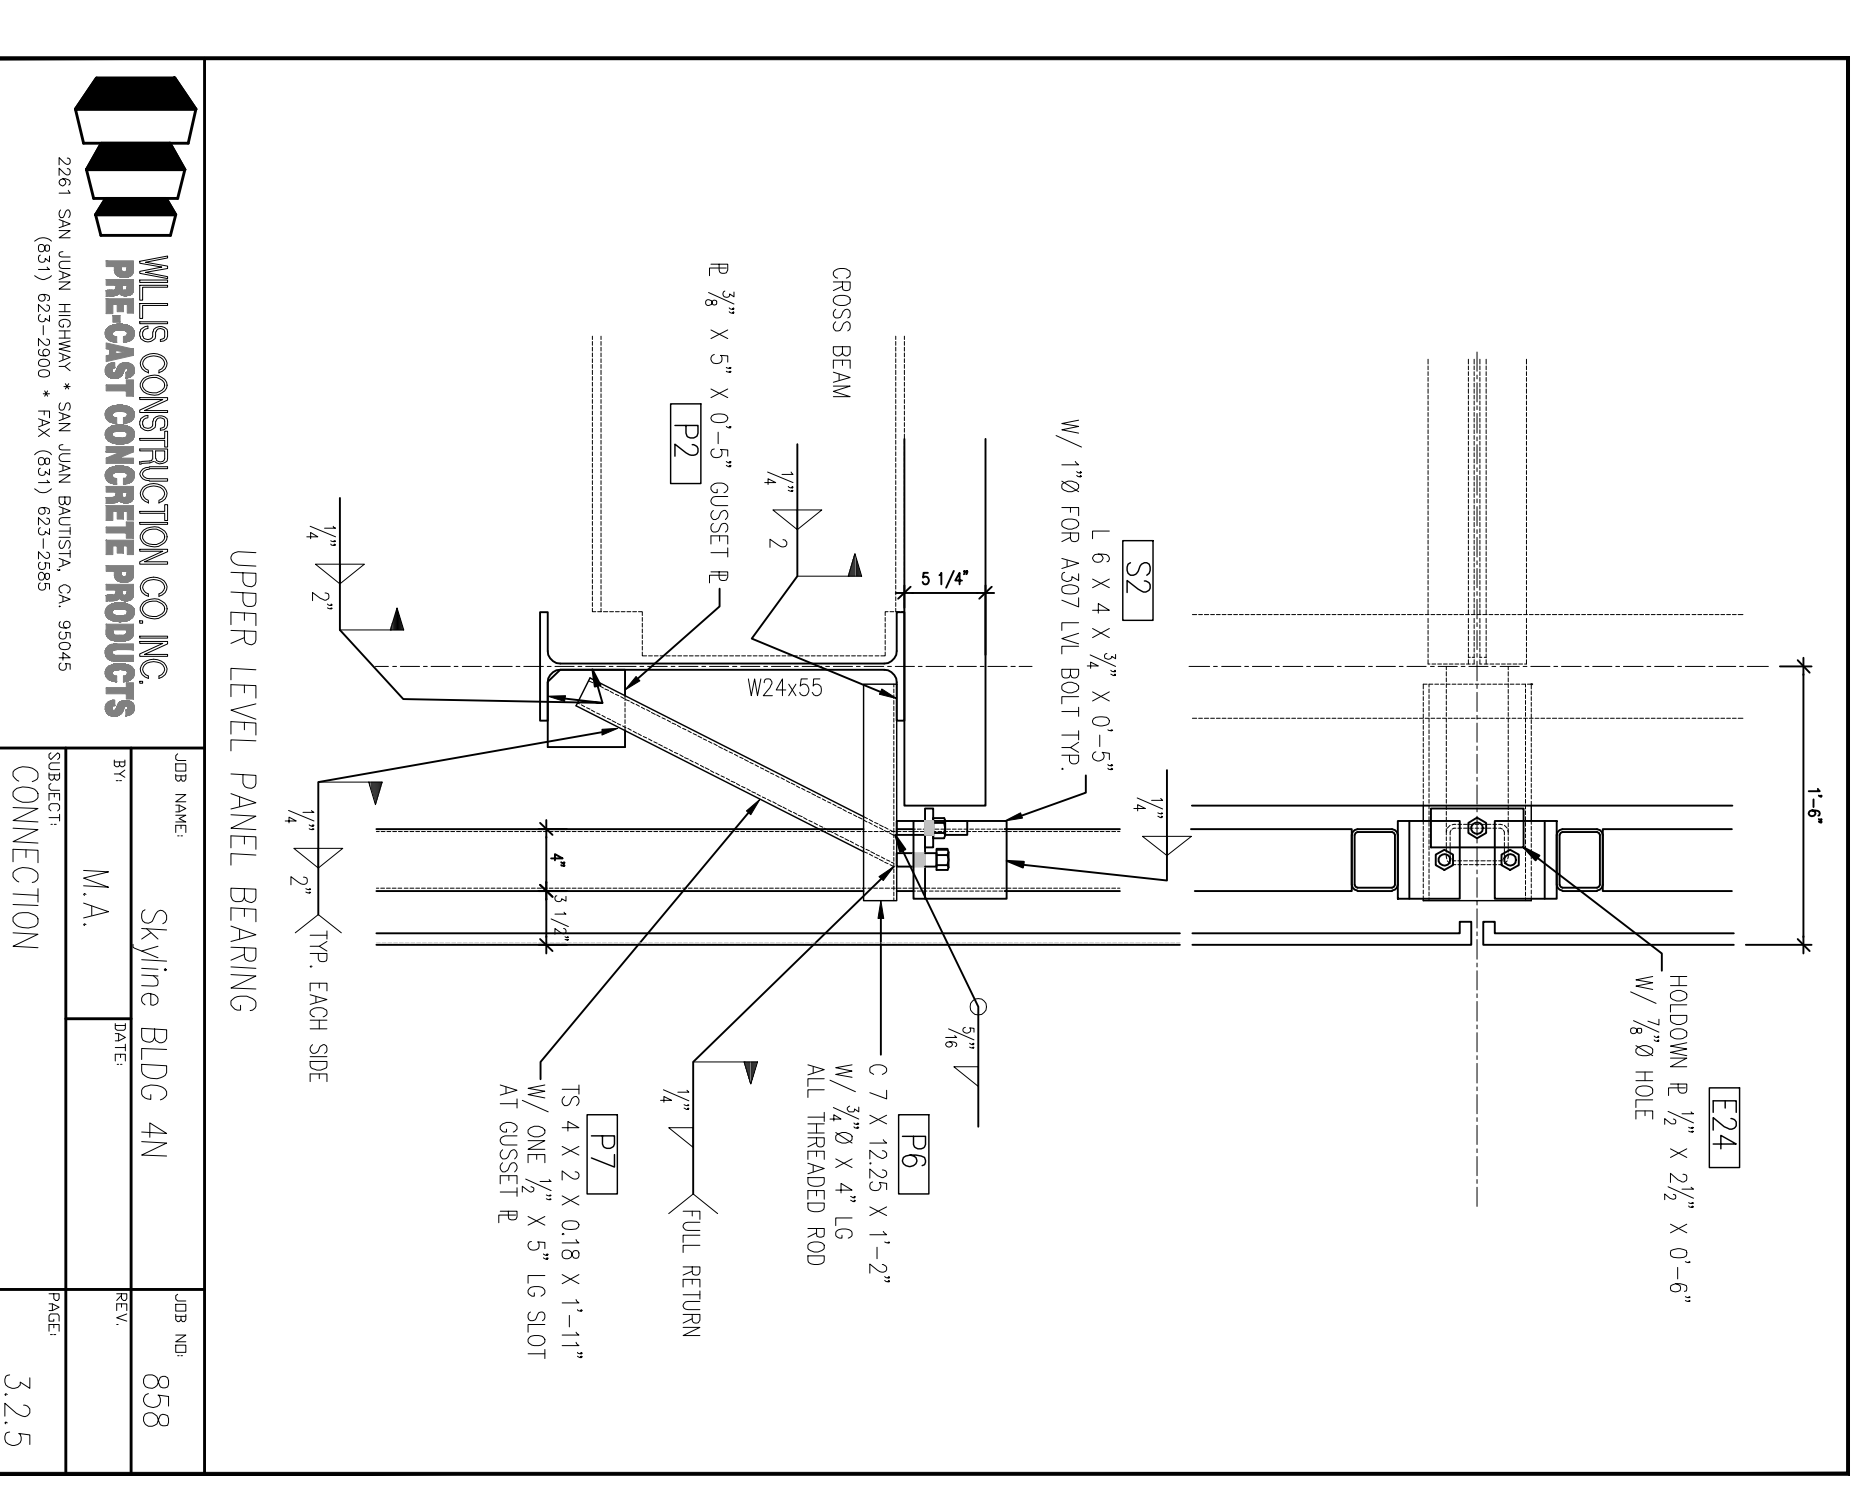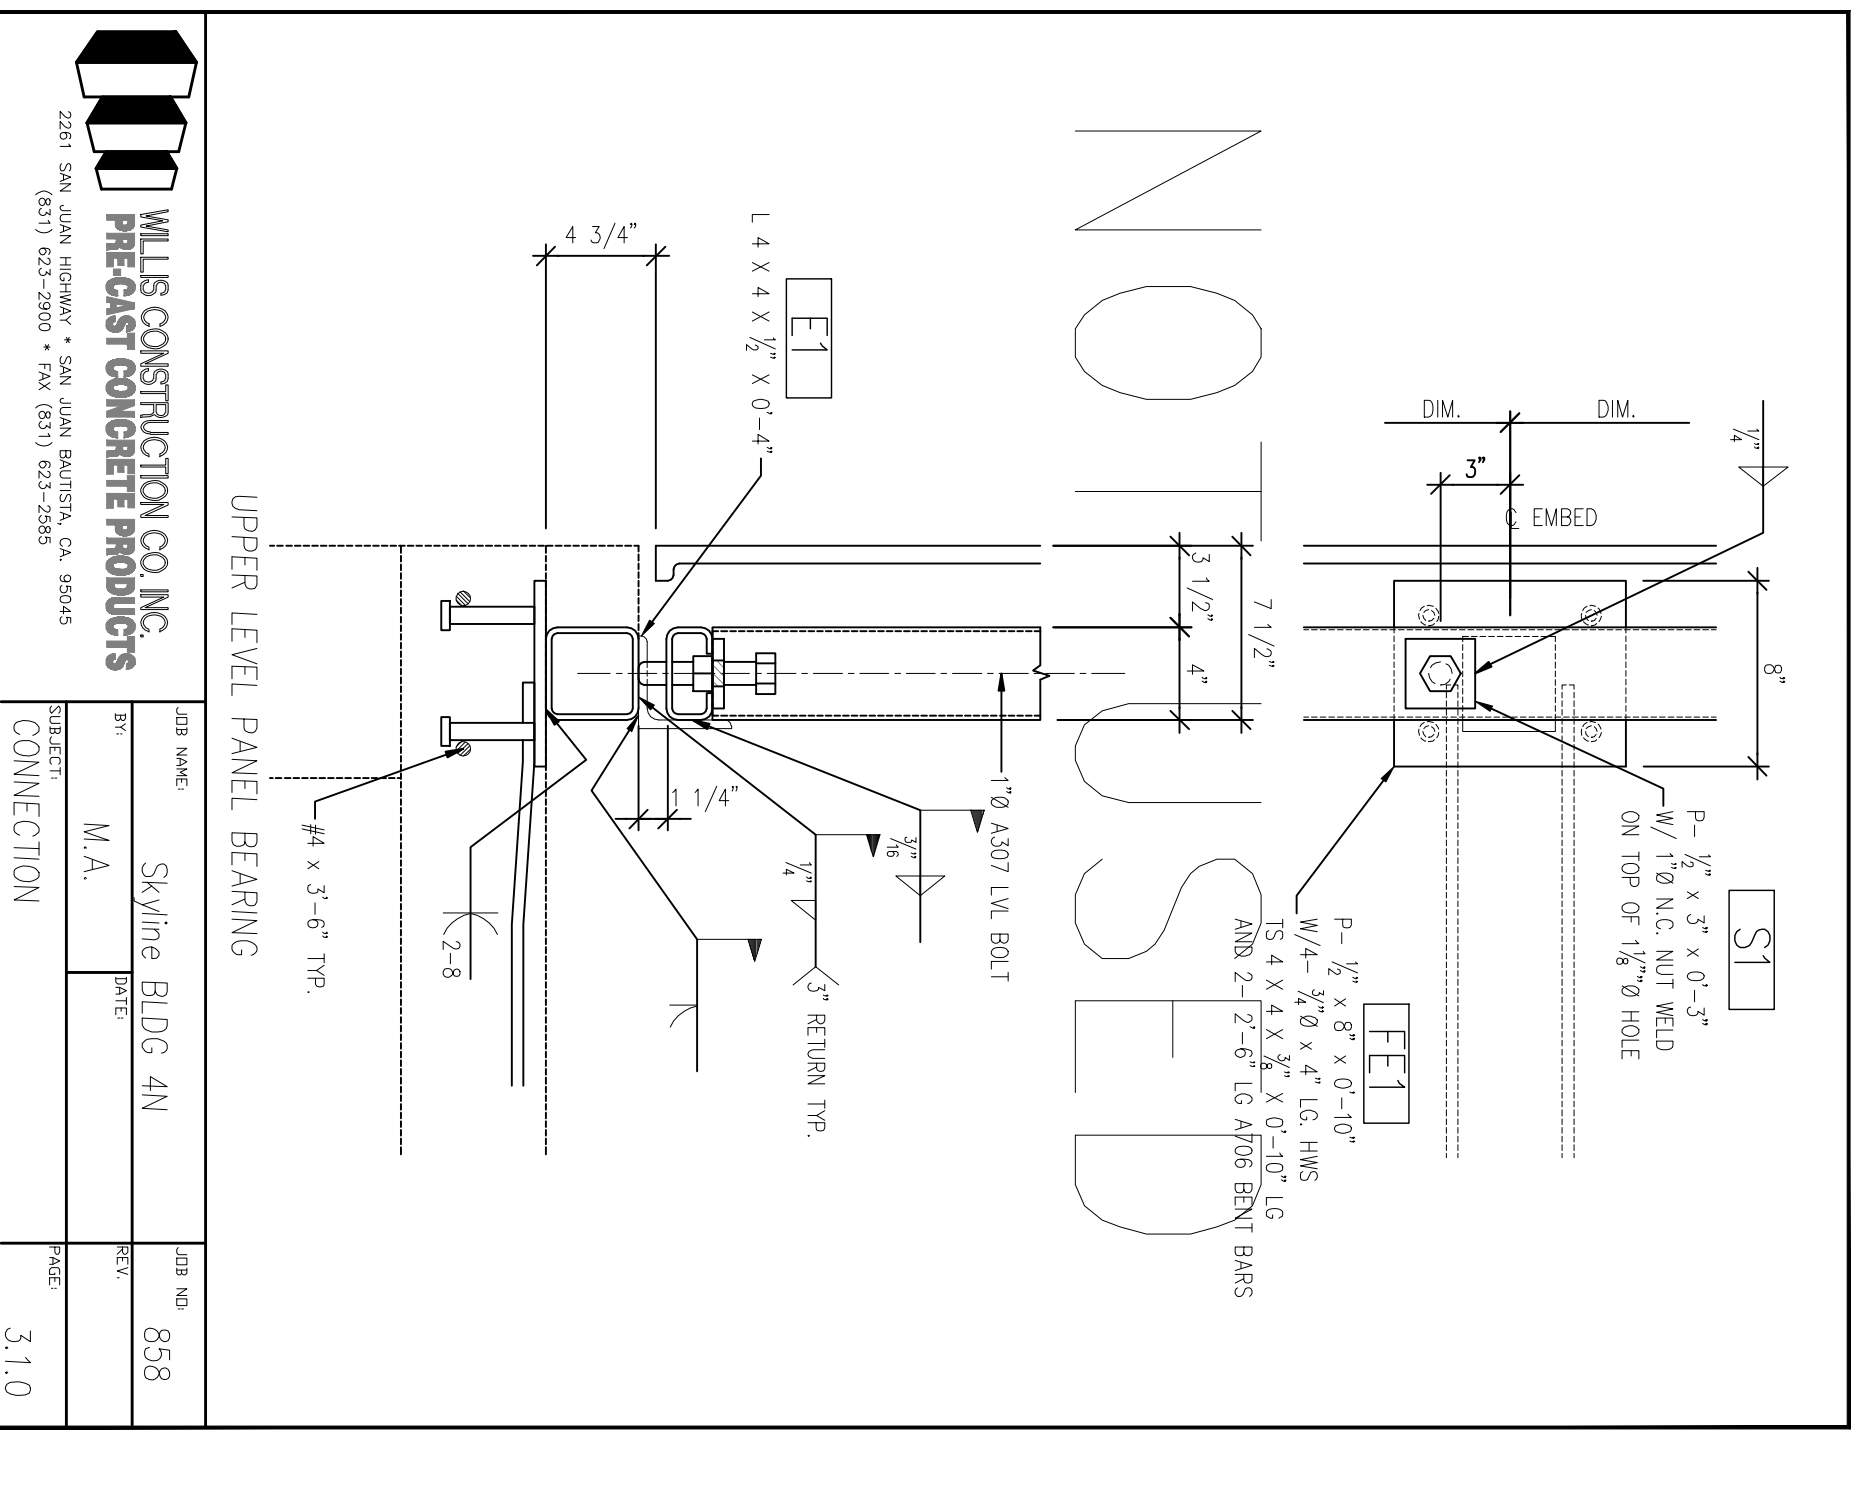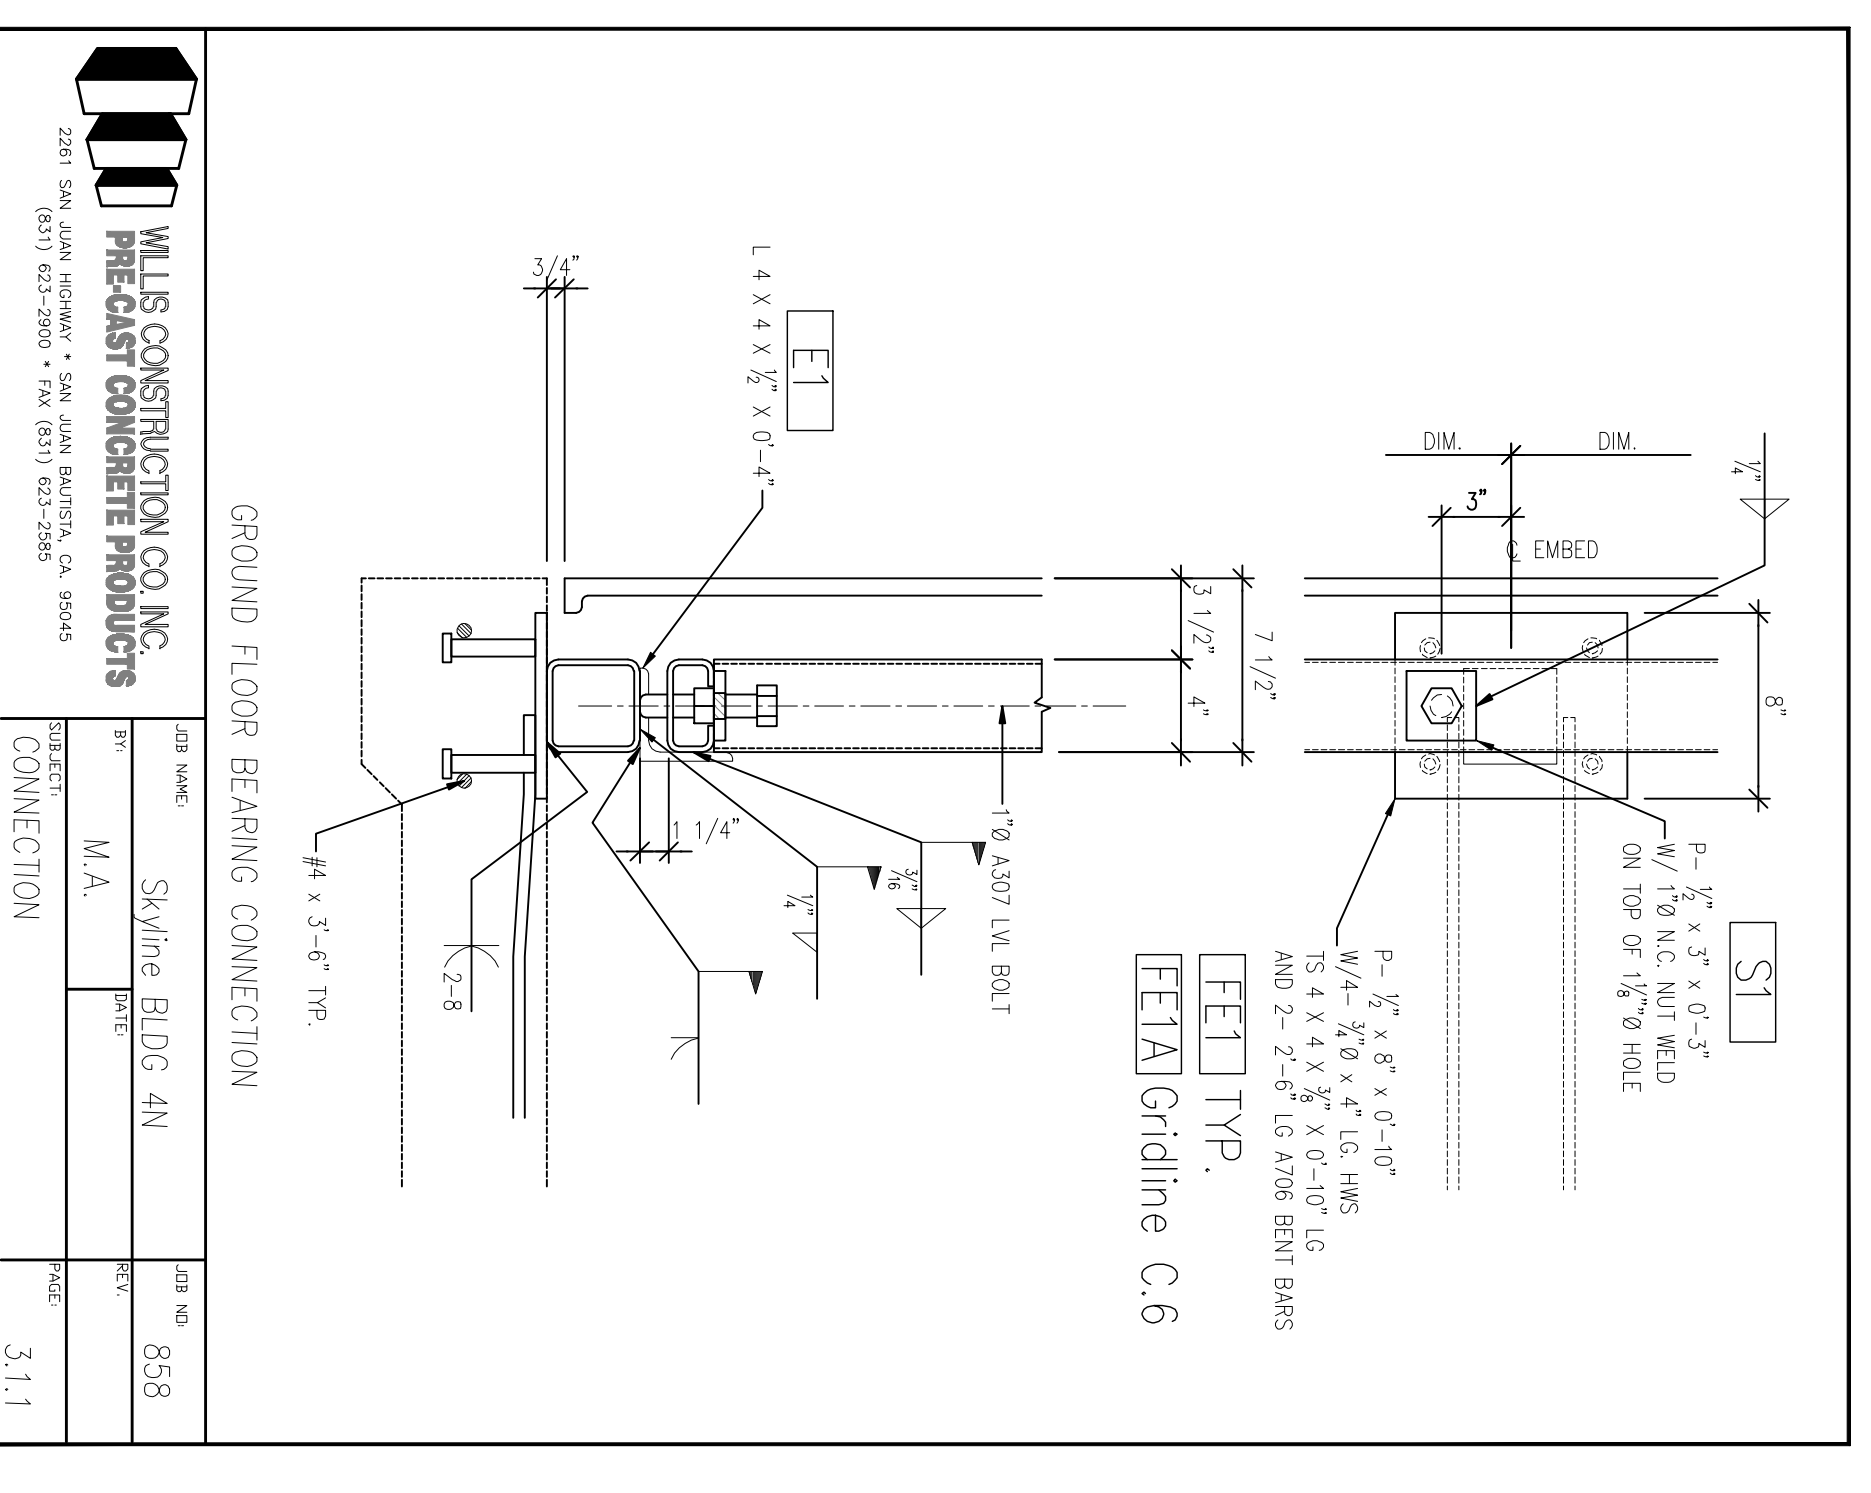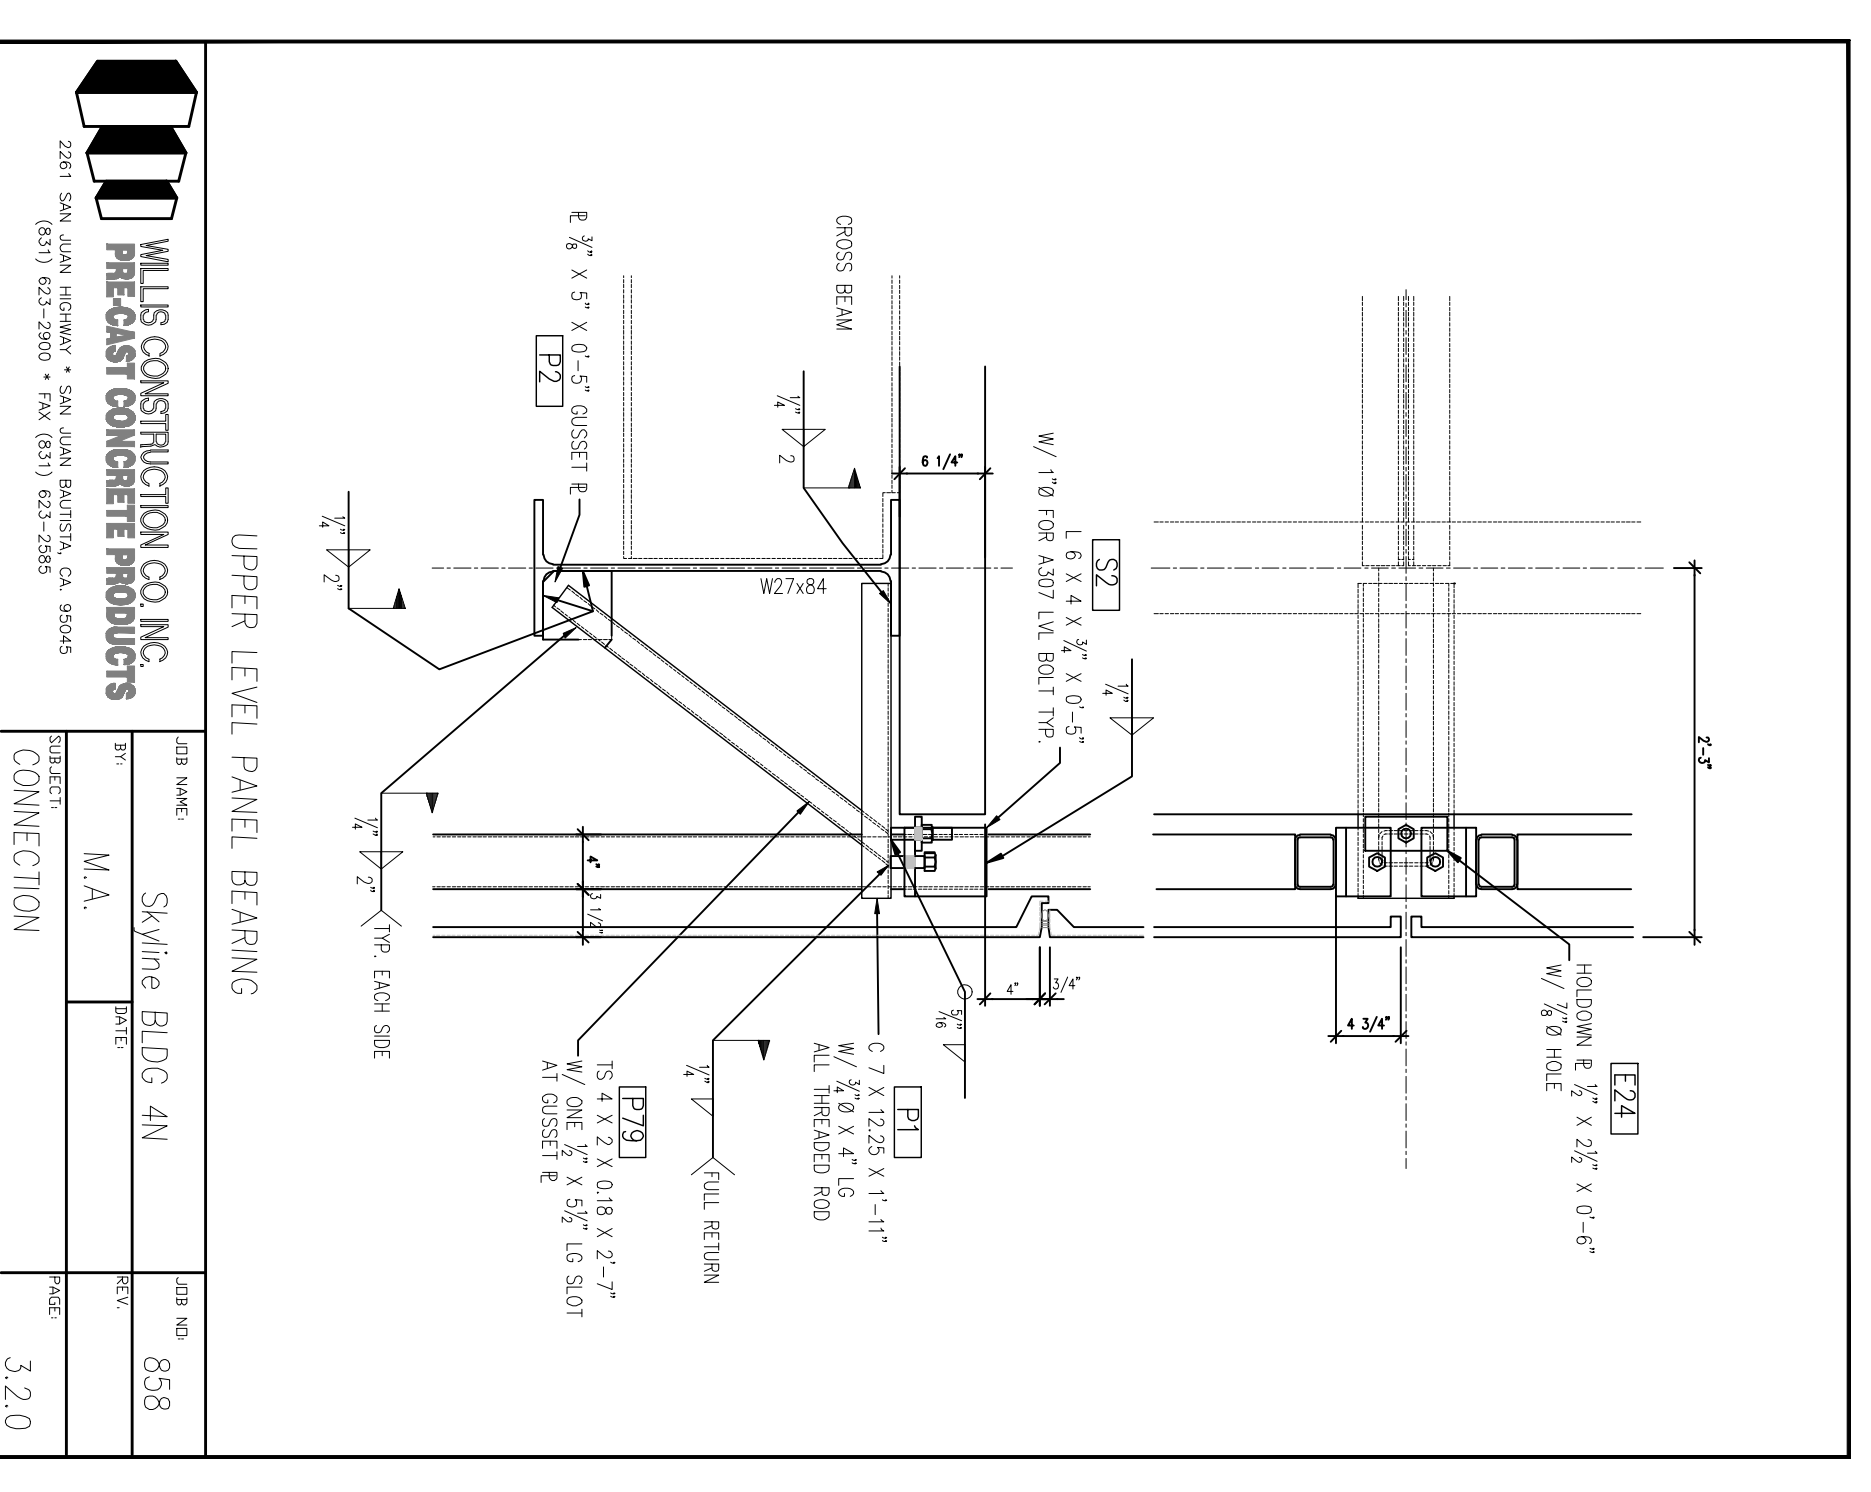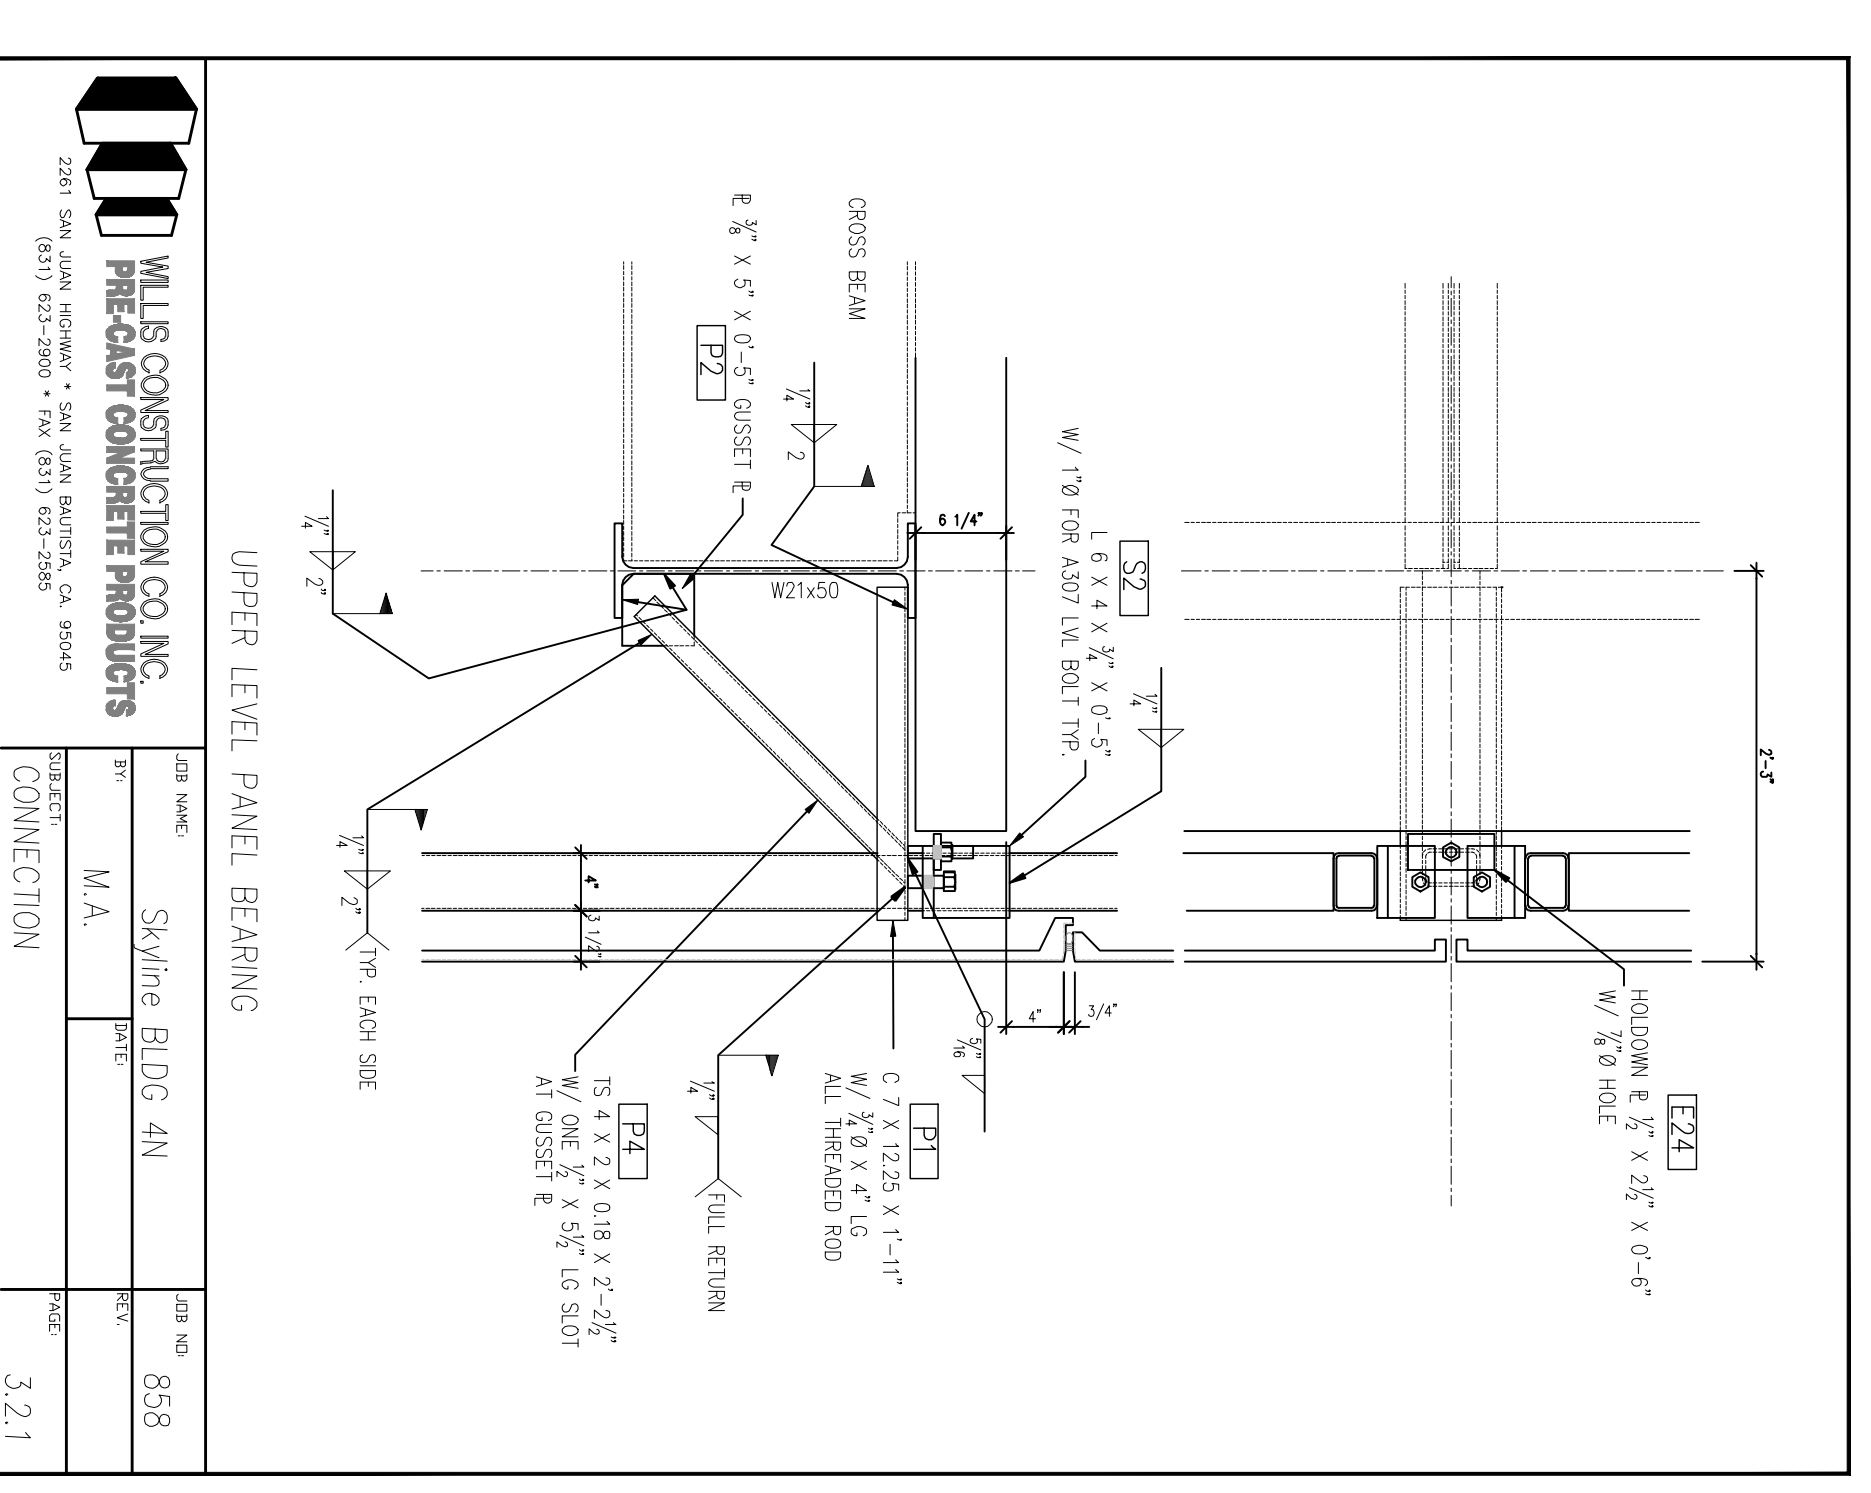

All drawings and details are the property of Will S. Williams and shall remain the property of Will S. Williams. No part of these drawings may be reproduced, stored in a retrieval system, or transmitted in any form or by any means, electronic, mechanical, photocopying, recording, or by any information storage and retrieval system, without the prior written permission of Will S. Williams.

This drawing is not to be used for any other project without the prior written permission of Will S. Williams. This drawing is not to be used for any other project without the prior written permission of Will S. Williams.