

<b>WILLS CONSTRUCTION CO. INC.</b> PRE-CAST CONCRETE PRODUCTS 2281 SAN JUAN AVENUE, SAN JUAN BAPTIST, CALIFORNIA (951) 423-2900 FAX (951) 423-2948	
NO.	DATE
1	ISSUE FOR PERMITS
2	NON-SCHEMATIC DESIGN SUBMITTAL
3	90% DESIGN DEVELOPMENT SUBMITTAL
4	100% DESIGN DEVELOPMENT SUBMITTAL
5	FINAL DESIGN DEVELOPMENT SUBMITTAL
6	PERMITS
7	CONSTRUCTION
8	REVISION #1
9	REVISION #2
10	REVISION #3
107	REVISION #100




DIVISION OF THE  
 STATE ARCHITECT  
 APPL # 01-110117  
 FILE # AD-CL  
 AG \_\_\_\_\_ RS \_\_\_\_\_  
 SSS \_\_\_\_\_ DNE \_\_\_\_\_  
 IDENTIFICATION  
 STAMP

**SKYLINE COLLEGE**  
 SAN JUAN COUNTY  
 COMMUNITY COLLEGE  
 DESIGN  
**CIP2 DESIGN-BUILD**  
**PROJECT**  
**BUILDING 4**  
**INCREMENT 2**  
 PERMIT


PROJECT NO. 070120  
 DRAWN BY: JACO  
 DATE: 04/08/09  
 CHECKED BY:  
 SCALE: \_\_\_\_\_

**AS BUILT DRAWINGS**  
**JANUARY 12, 2011**


PC-937

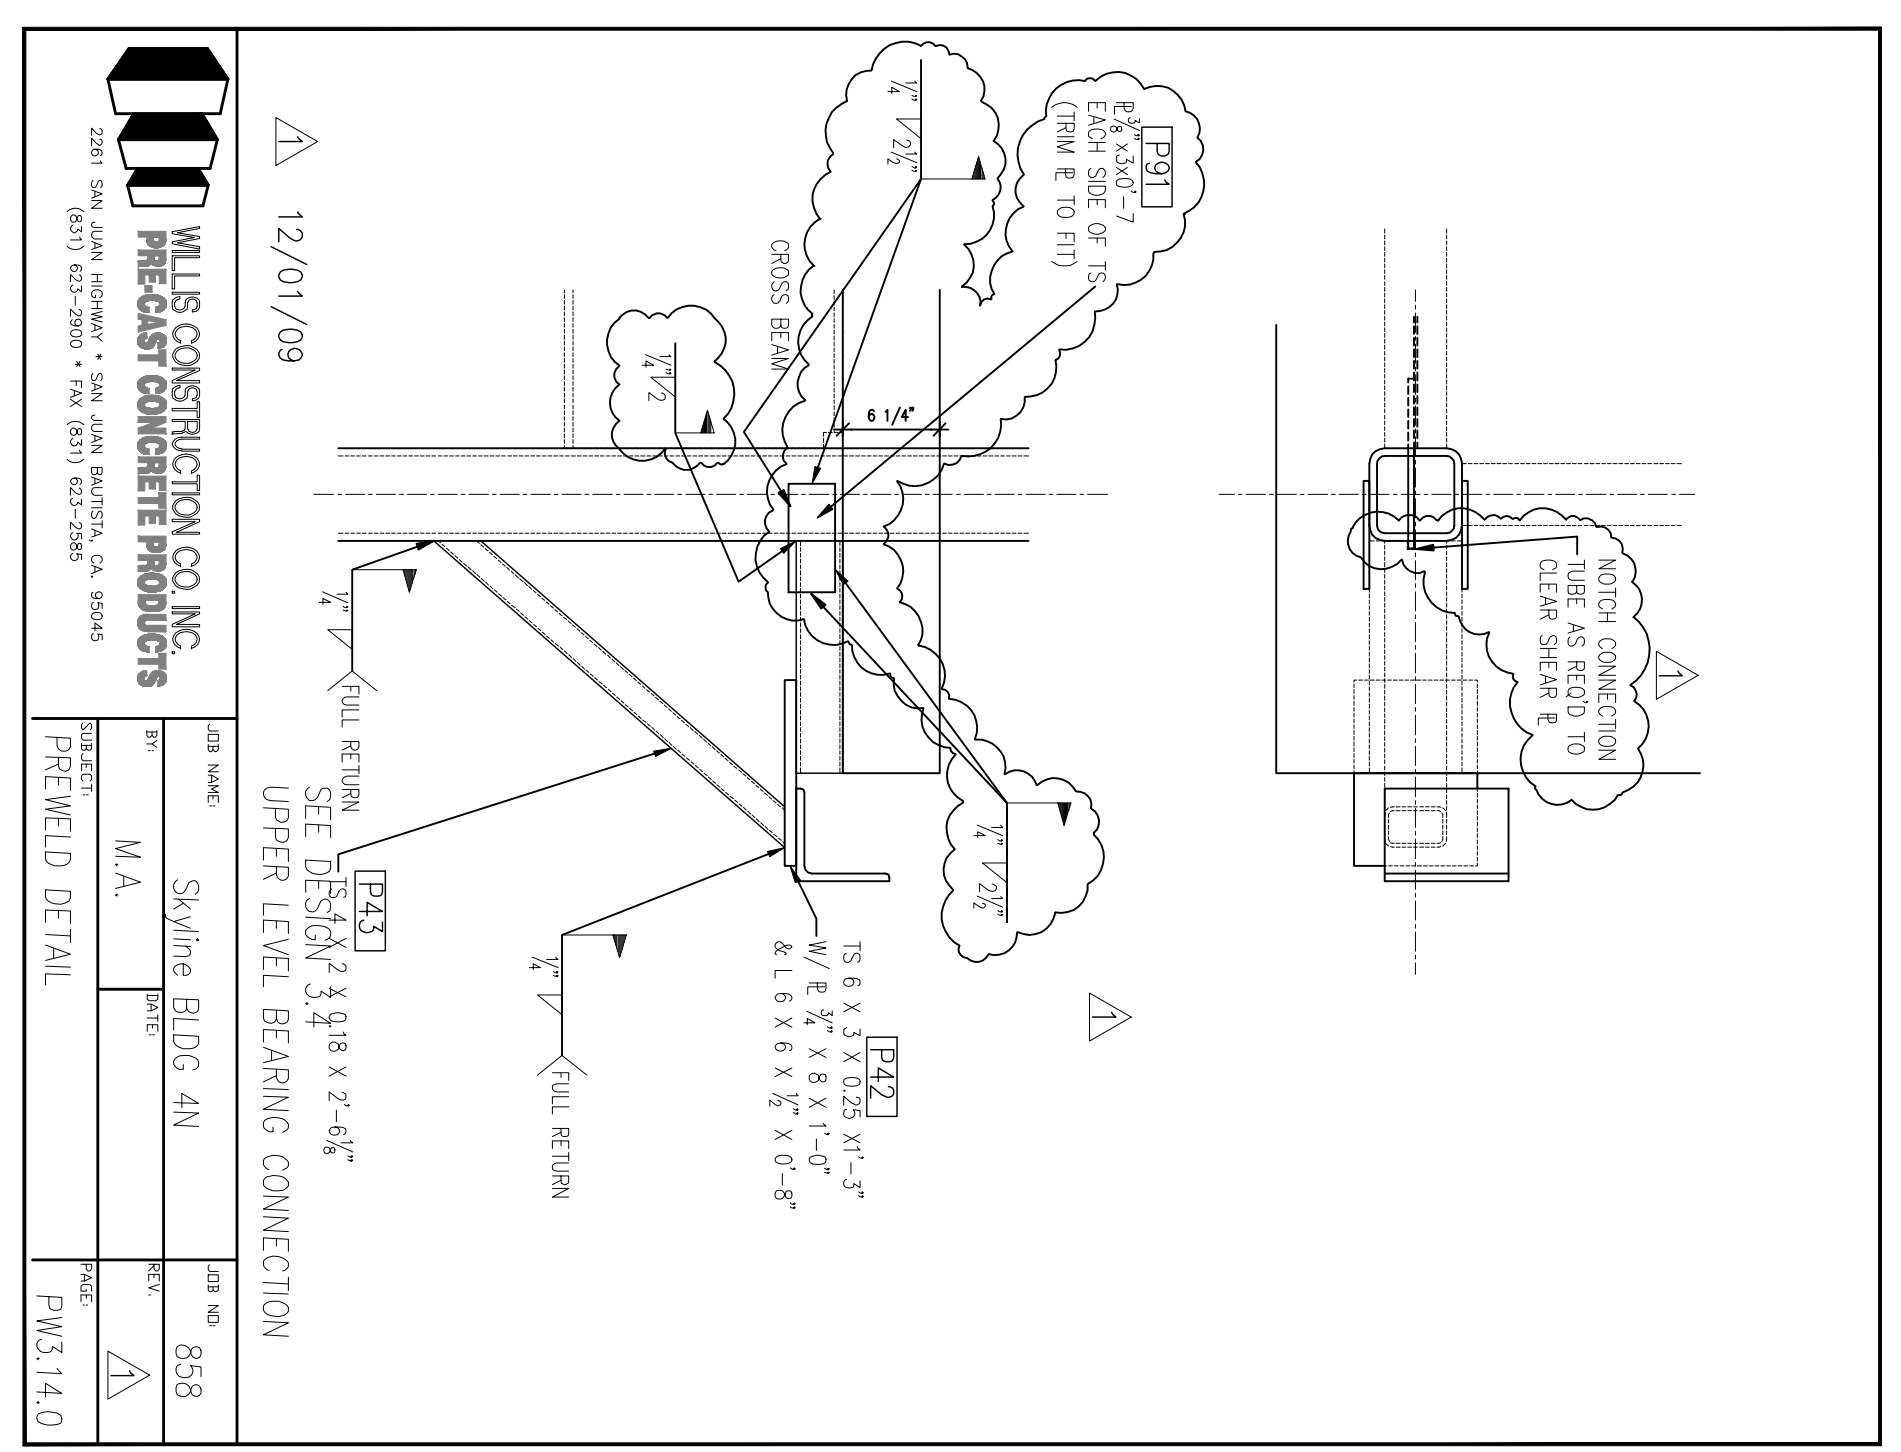


WILLS CONSTRUCTION CO. INC.  
 PRE-CAST CONCRETE PRODUCTS  
 2281 SAN JUAN AVENUE, SAN JUAN BAPTIST, CALIFORNIA  
 (951) 423-2900 FAX (951) 423-2948  
 PROJECT: Skyline Bldg. 4N  
 SHEET: PM3.14.0  
 DATE: 12/01/09

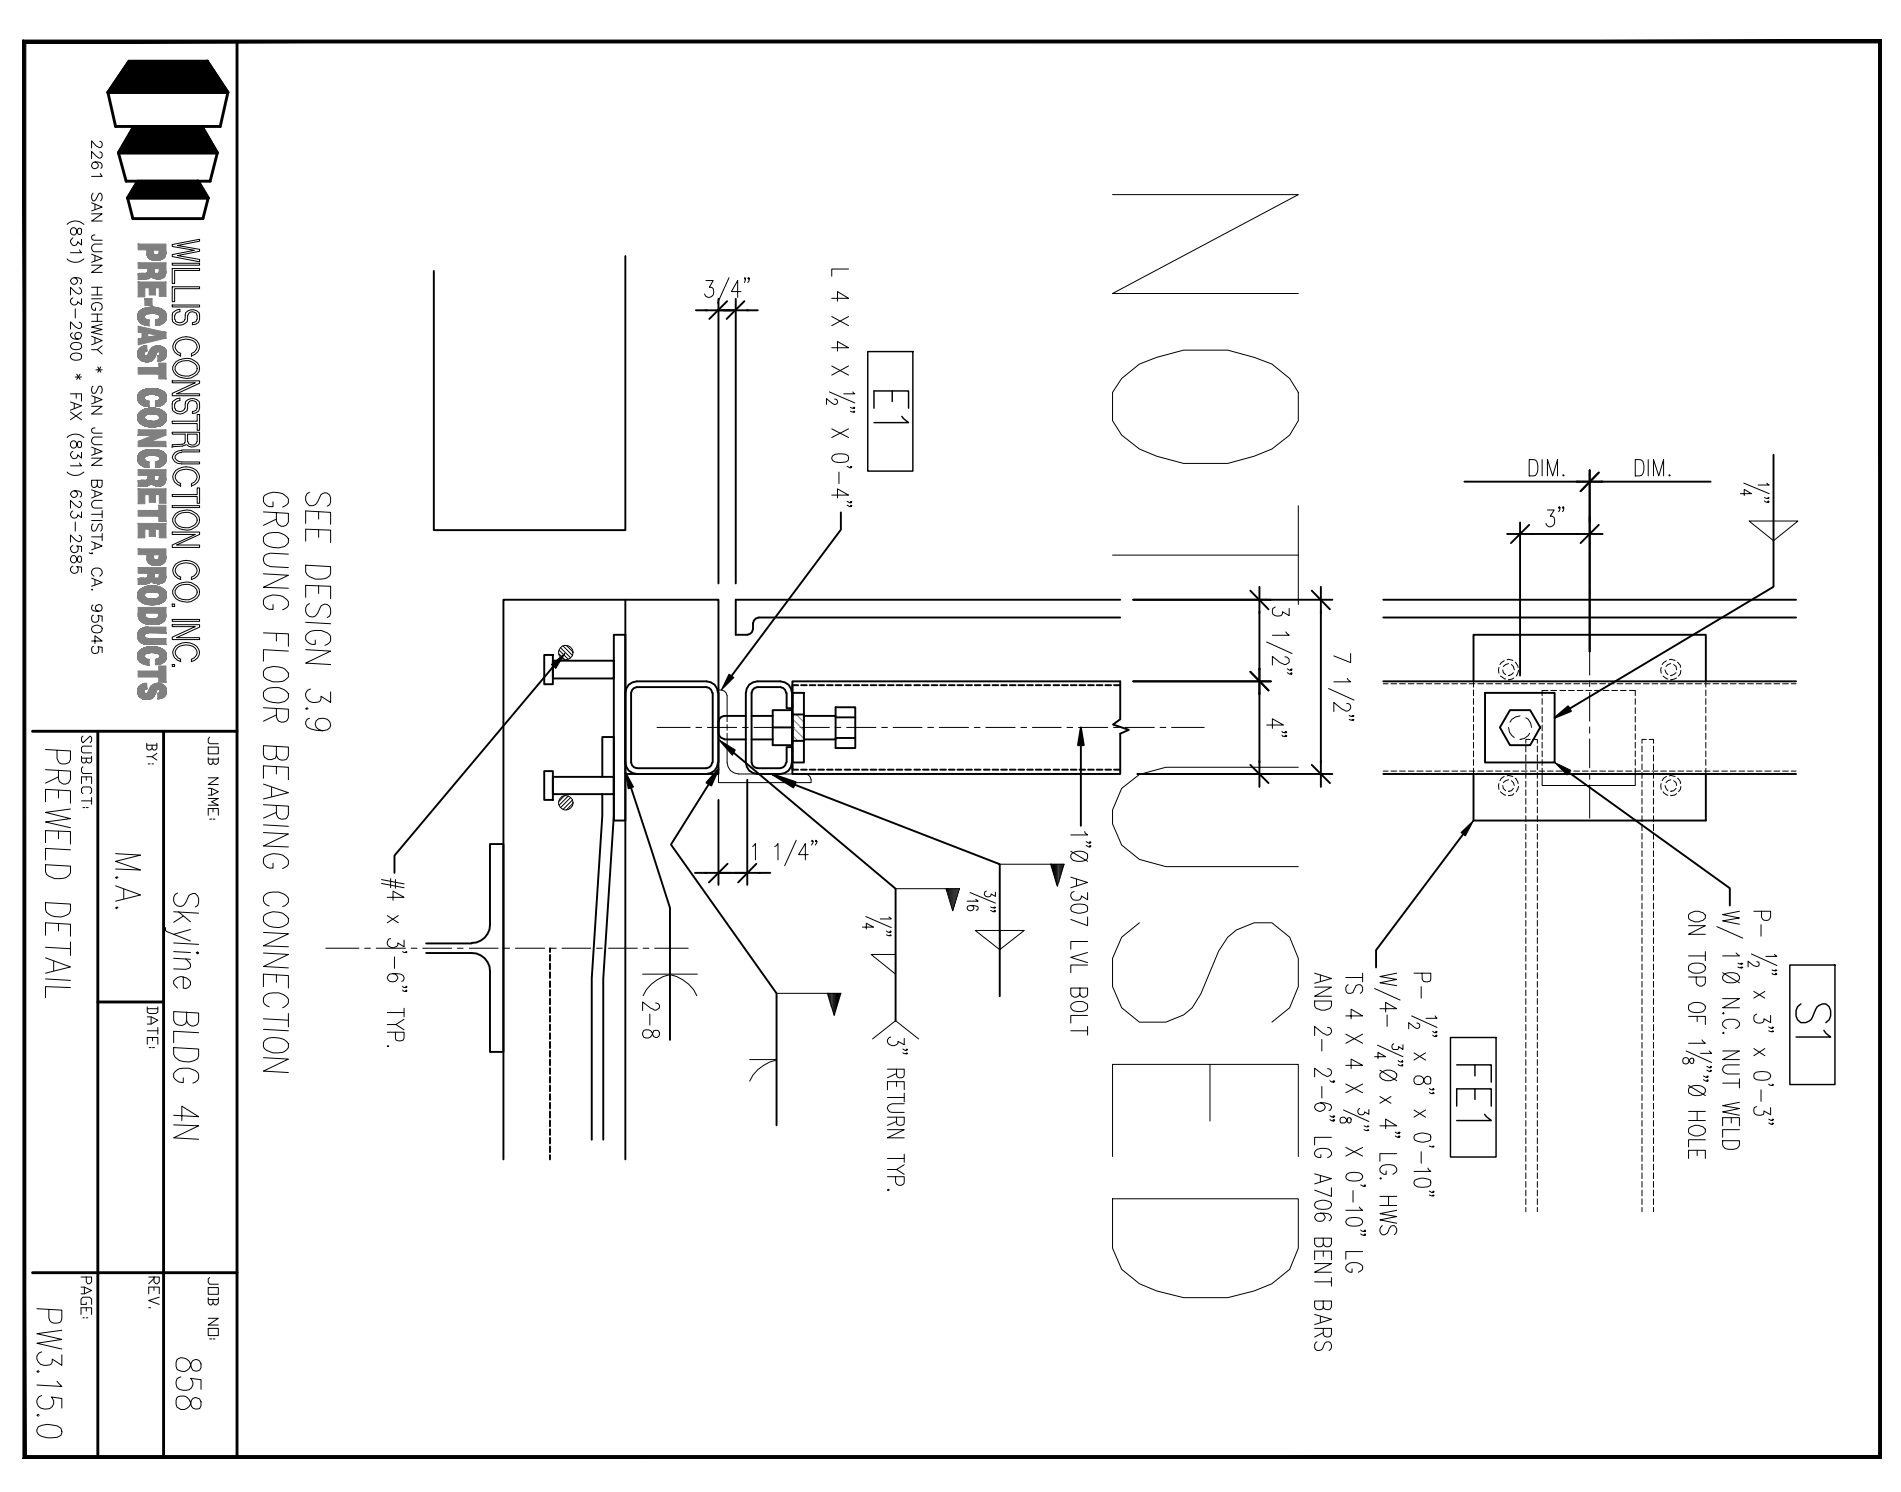


WILLS CONSTRUCTION CO. INC.  
 PRE-CAST CONCRETE PRODUCTS  
 2281 SAN JUAN AVENUE, SAN JUAN BAPTIST, CALIFORNIA  
 (951) 423-2900 FAX (951) 423-2948  
 PROJECT: Skyline Bldg. 4N  
 SHEET: PM3.15.0  
 DATE: 12/01/09

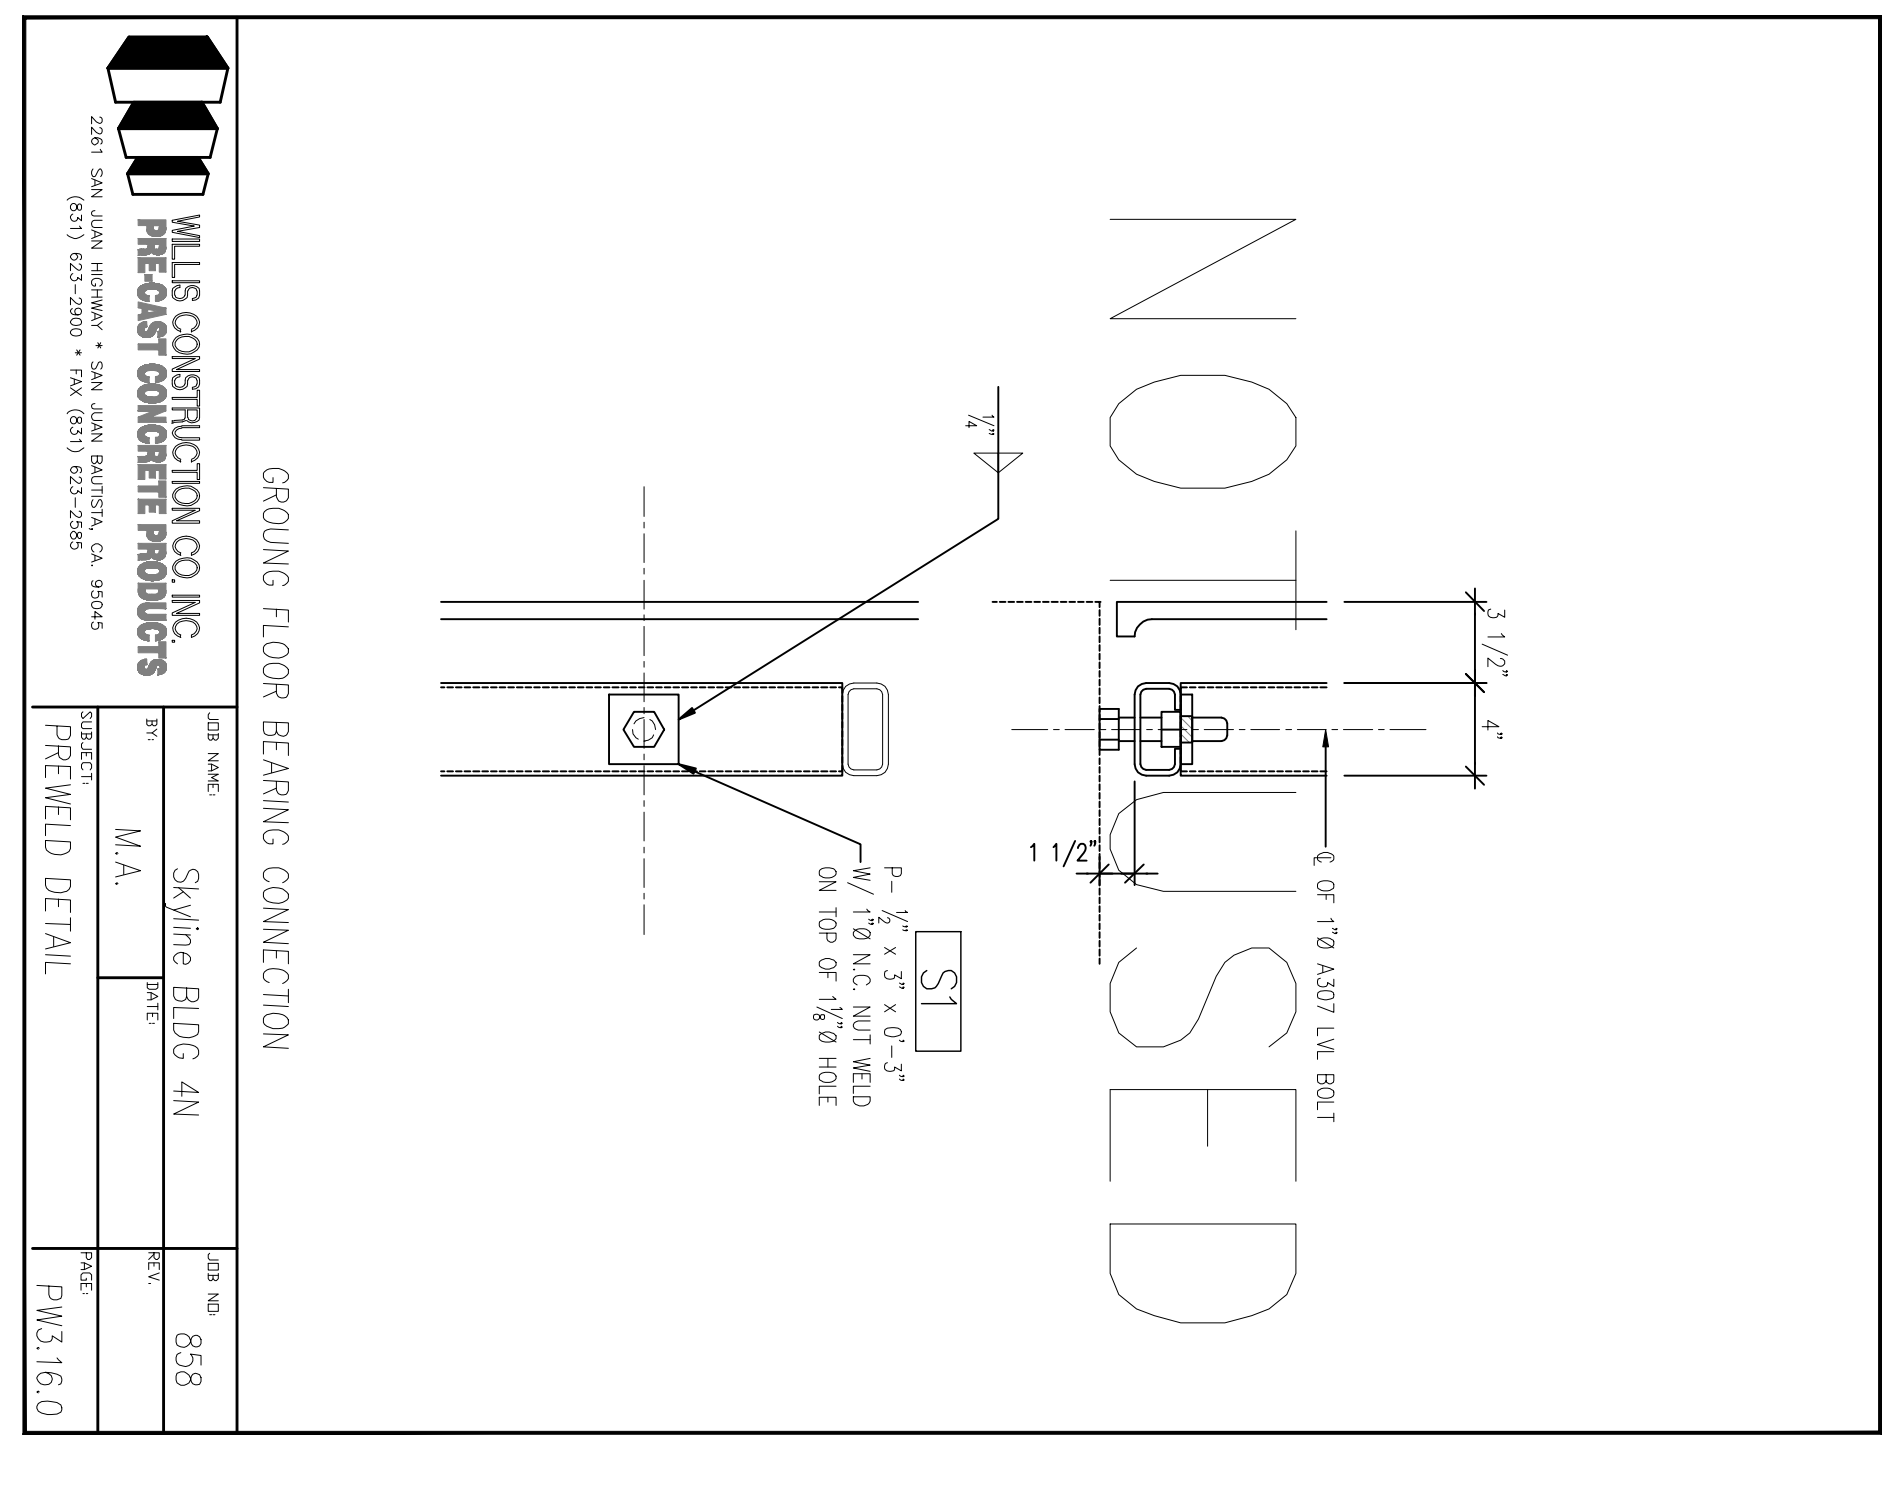


WILLS CONSTRUCTION CO. INC.  
 PRE-CAST CONCRETE PRODUCTS  
 2281 SAN JUAN AVENUE, SAN JUAN BAPTIST, CALIFORNIA  
 (951) 423-2900 FAX (951) 423-2948  
 PROJECT: Skyline Bldg. 4N  
 SHEET: PM3.16.0  
 DATE: 12/01/09

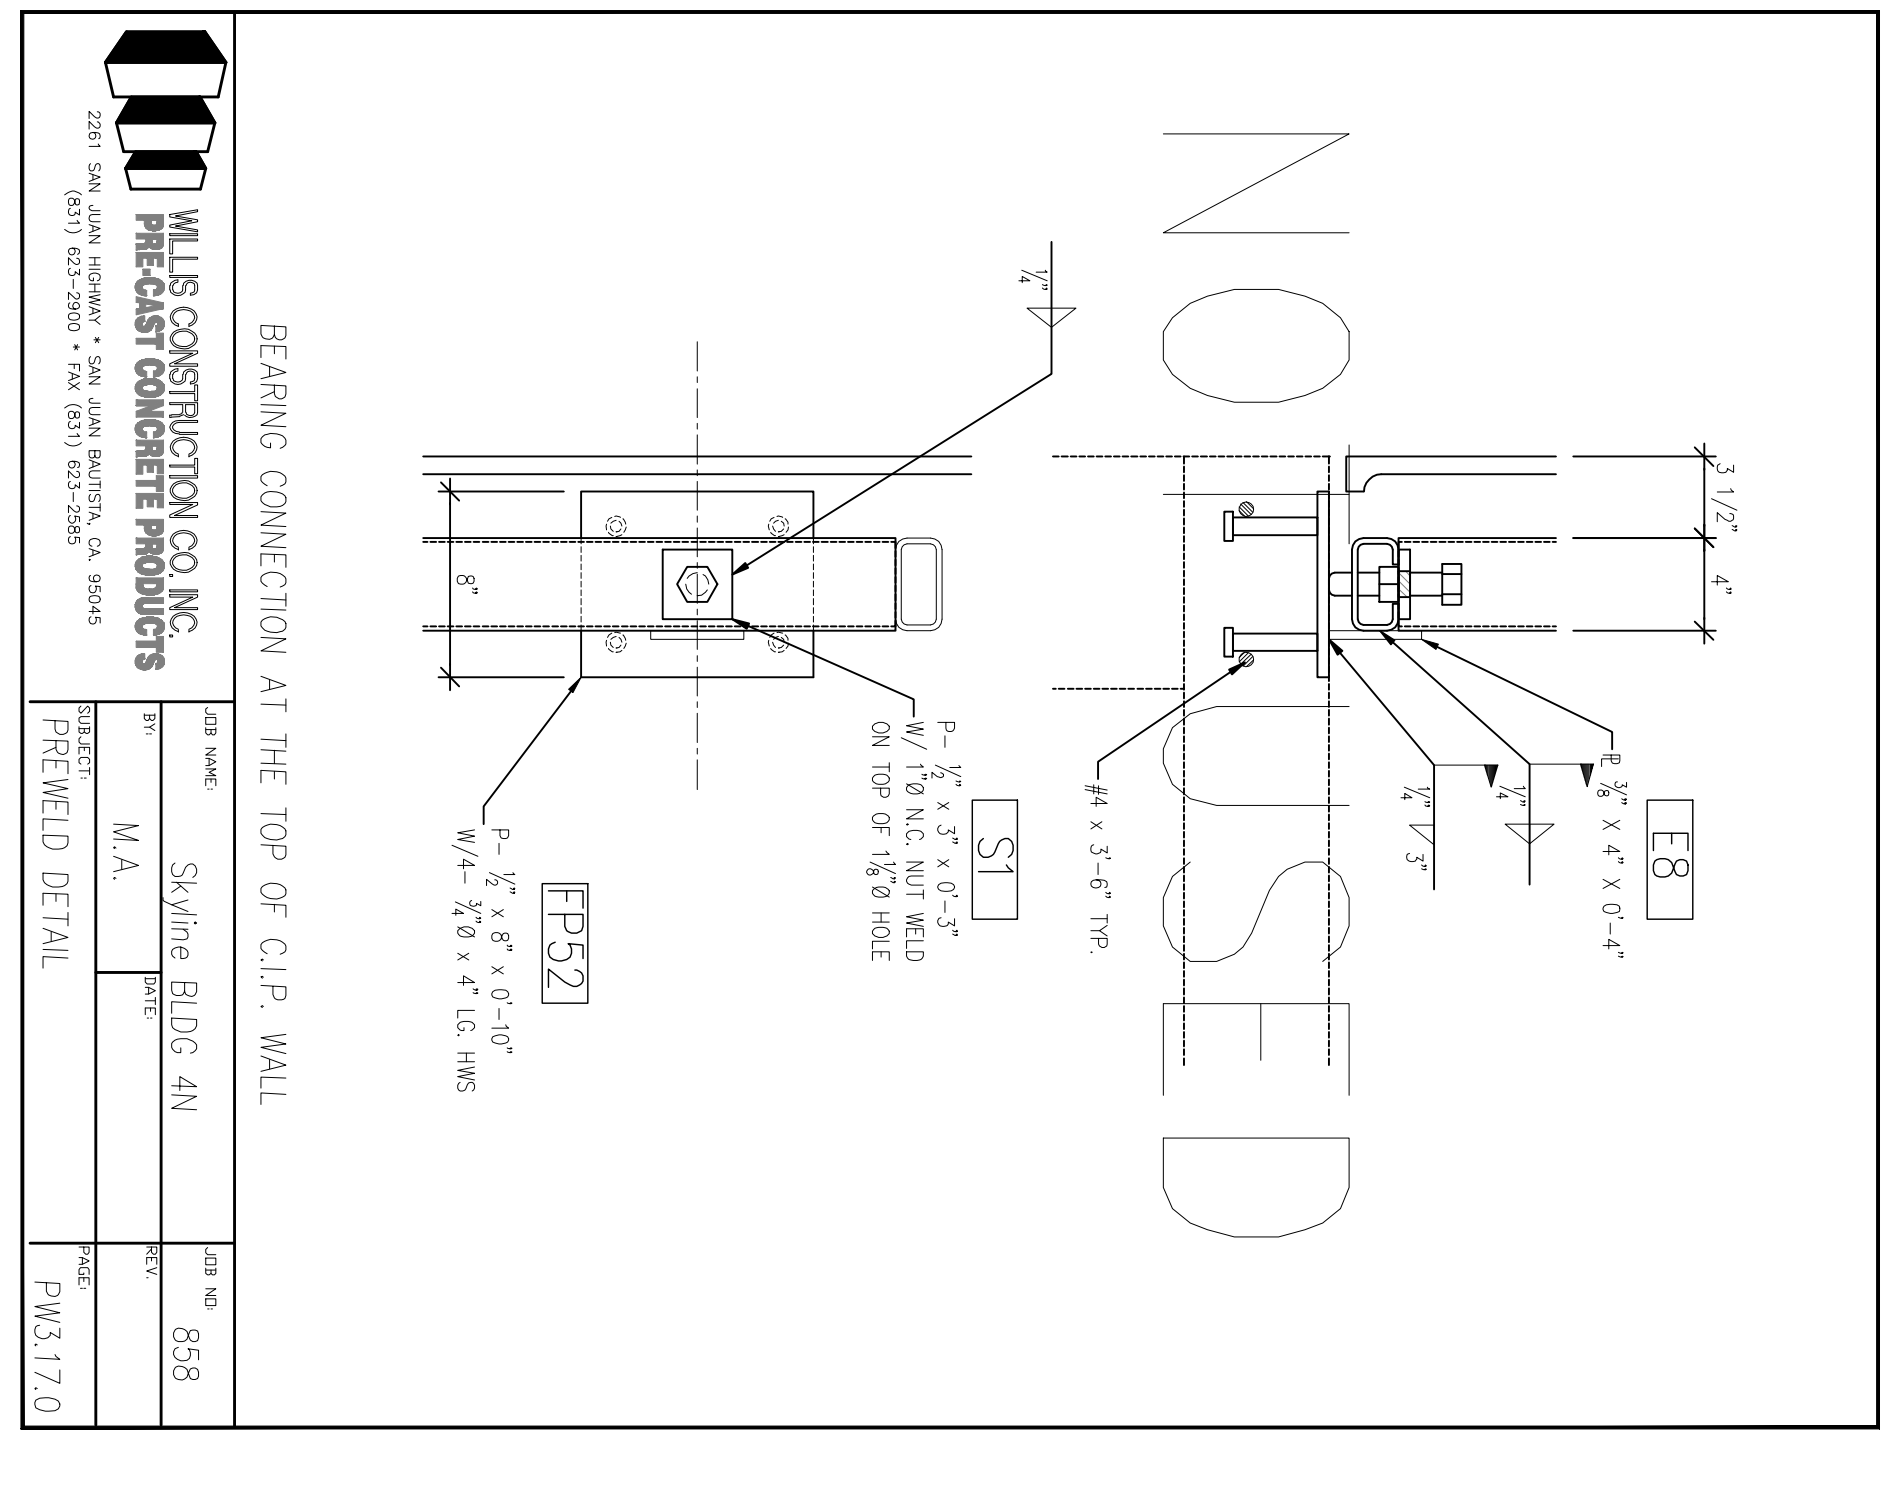


WILLS CONSTRUCTION CO. INC.  
 PRE-CAST CONCRETE PRODUCTS  
 2281 SAN JUAN AVENUE, SAN JUAN BAPTIST, CALIFORNIA  
 (951) 423-2900 FAX (951) 423-2948  
 PROJECT: Skyline Bldg. 4N  
 SHEET: PM3.17.0  
 DATE: 12/01/09

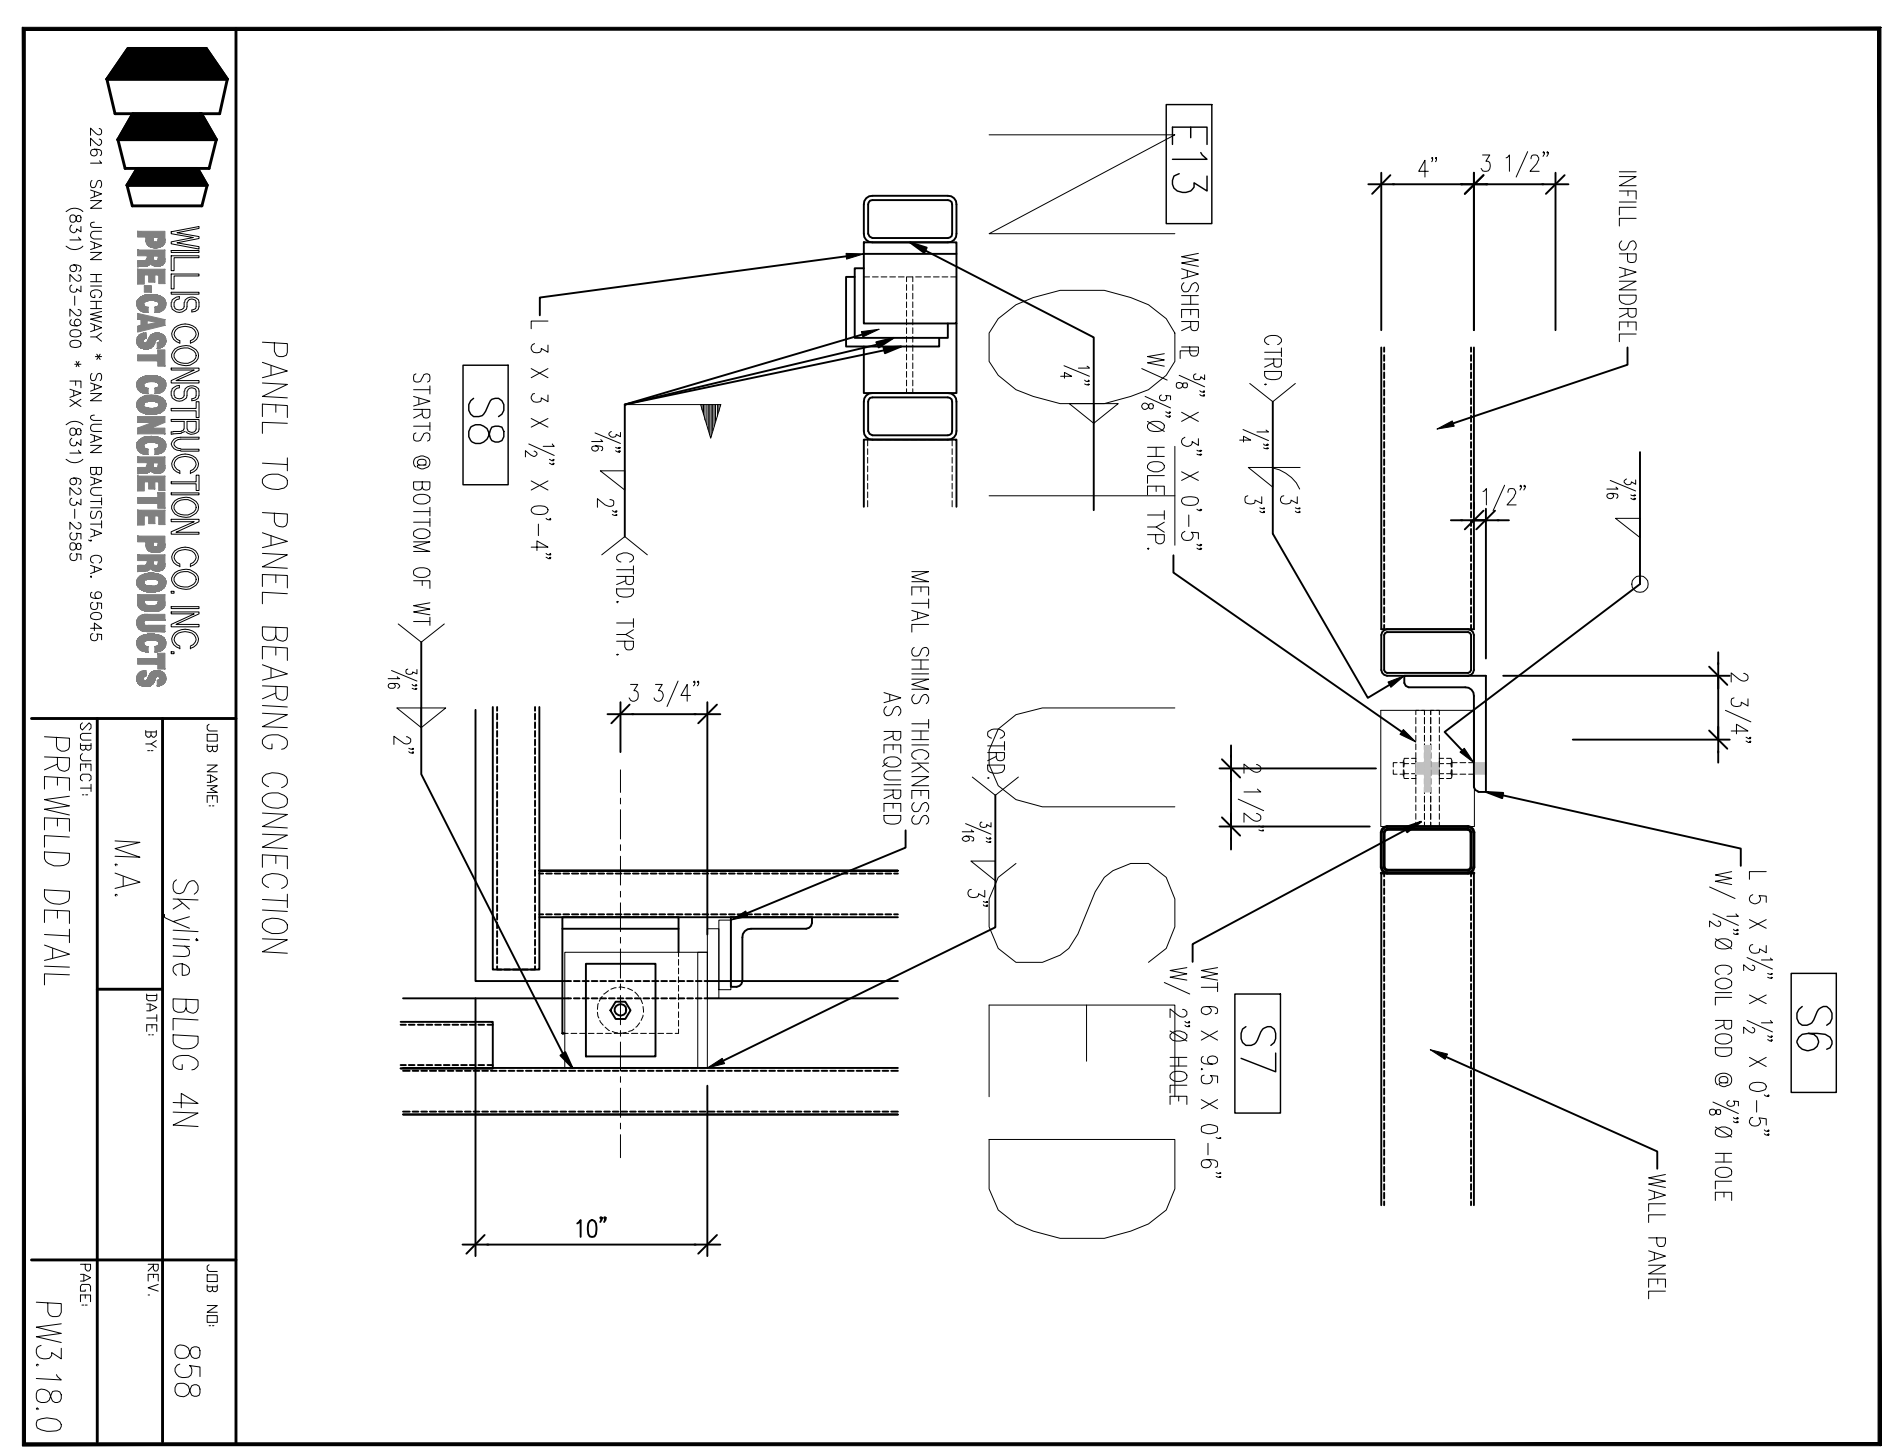

WILLS CONSTRUCTION CO. INC.  
 PRE-CAST CONCRETE PRODUCTS  
 2281 SAN JUAN AVENUE, SAN JUAN BAPTIST, CALIFORNIA  
 (951) 423-2900 FAX (951) 423-2948  
 PROJECT: Skyline Bldg. 4N  
 SHEET: PM3.18.0  
 DATE: 12/01/09

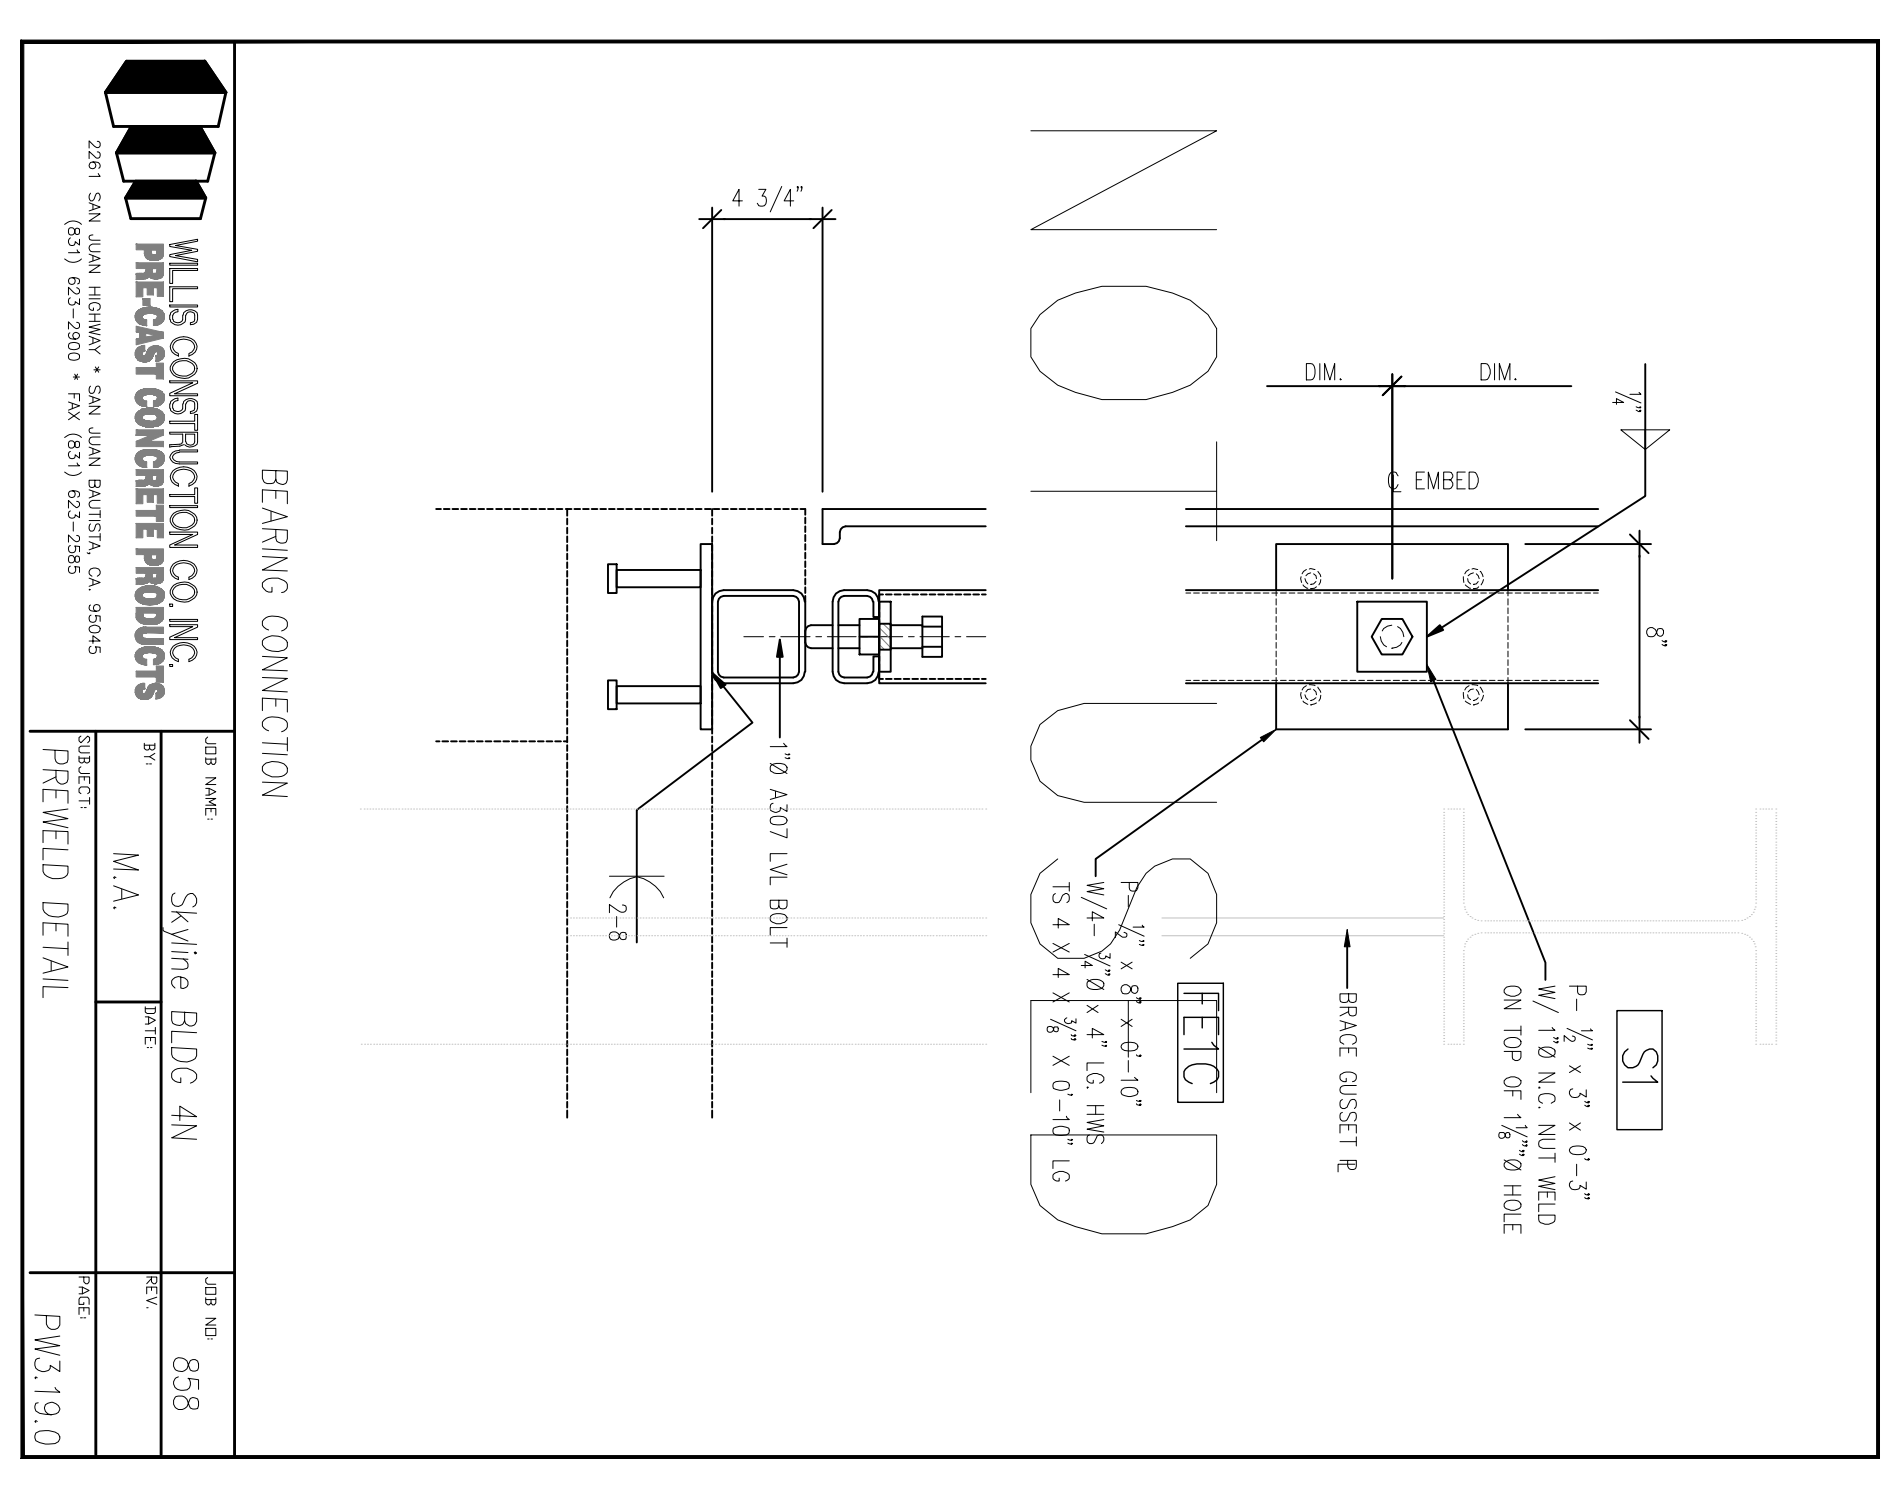

WILLS CONSTRUCTION CO. INC.  
 PRE-CAST CONCRETE PRODUCTS  
 2281 SAN JUAN AVENUE, SAN JUAN BAPTIST, CALIFORNIA  
 (951) 423-2900 FAX (951) 423-2948  
 PROJECT: Skyline Bldg. 4N  
 SHEET: PM3.19.0  
 DATE: 12/01/09

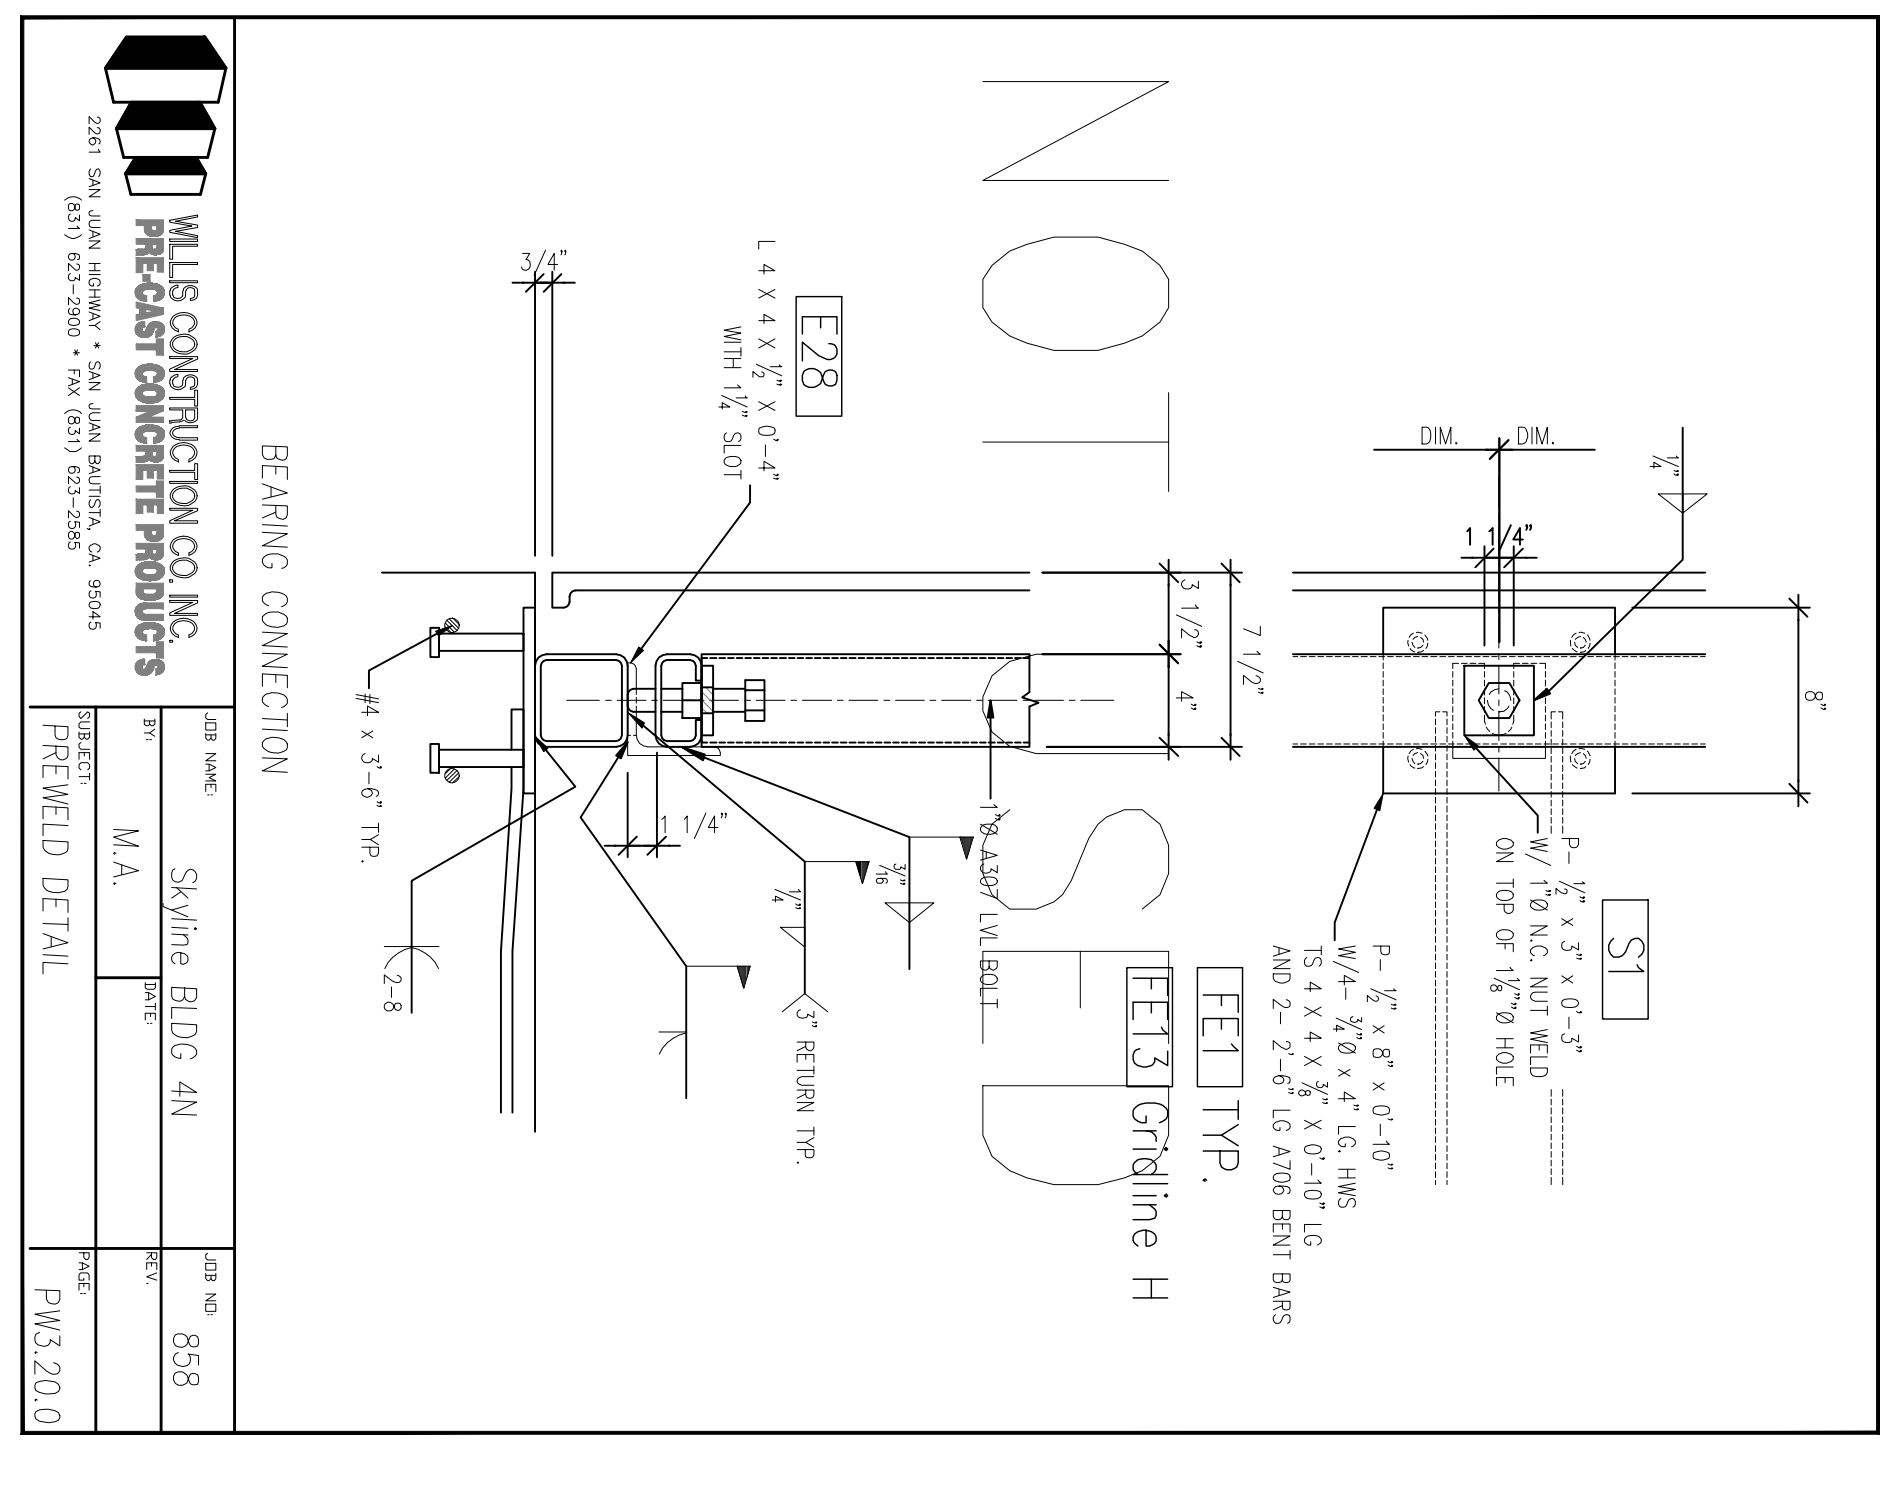

WILLS CONSTRUCTION CO. INC.  
 PRE-CAST CONCRETE PRODUCTS  
 2281 SAN JUAN AVENUE, SAN JUAN BAPTIST, CALIFORNIA  
 (951) 423-2900 FAX (951) 423-2948  
 PROJECT: Skyline Bldg. 4N  
 SHEET: PM3.20.0  
 DATE: 12/01/09