

| | |
|---|---------|
| WILIS CONSTRUCTION CO. INC. PRE-CAST CONCRETE PRODUCTS | |
| 2281 SAN JUAN AVENUE • SAN JUAN BAUTISTA, CALIFORNIA 95043 TEL: (937) 423-2900 • FAX: (937) 423-2948 | |
| NO. | DATE |
| 1 | 10/4/09 |
| 2 | 10/4/09 |
| 3 | 10/4/09 |
| 4 | 10/4/09 |
| 5 | 10/4/09 |
| 6 | 10/4/09 |
| 7 | 10/4/09 |
| 8 | 10/4/09 |
| 9 | 10/4/09 |
| 10 | 10/4/09 |
| 11 | 10/4/09 |











DIVISION OF THE
 STATE ARCHITECT
 APPL # 01-110117
 FILE # ARCH
 AG _____ RS _____
 SSS _____ DWG _____
 IDENTIFICATION
 STAMP

SKYLINE COLLEGE
 SAN JUAN COUNTY
 COMMUNITY COLLEGE
 DESIGN
CIP2 DESIGN-BUILD
PROJECT
BUILDING 4
INCREMENT 2

PROJECT NO. 0701200
 DRAWN BY: JACO
 DATE: 04/09/09
 CHECKED BY:
 SCALE: _____

AS BUILT DRAWINGS
JANUARY 12, 2011

PC-939

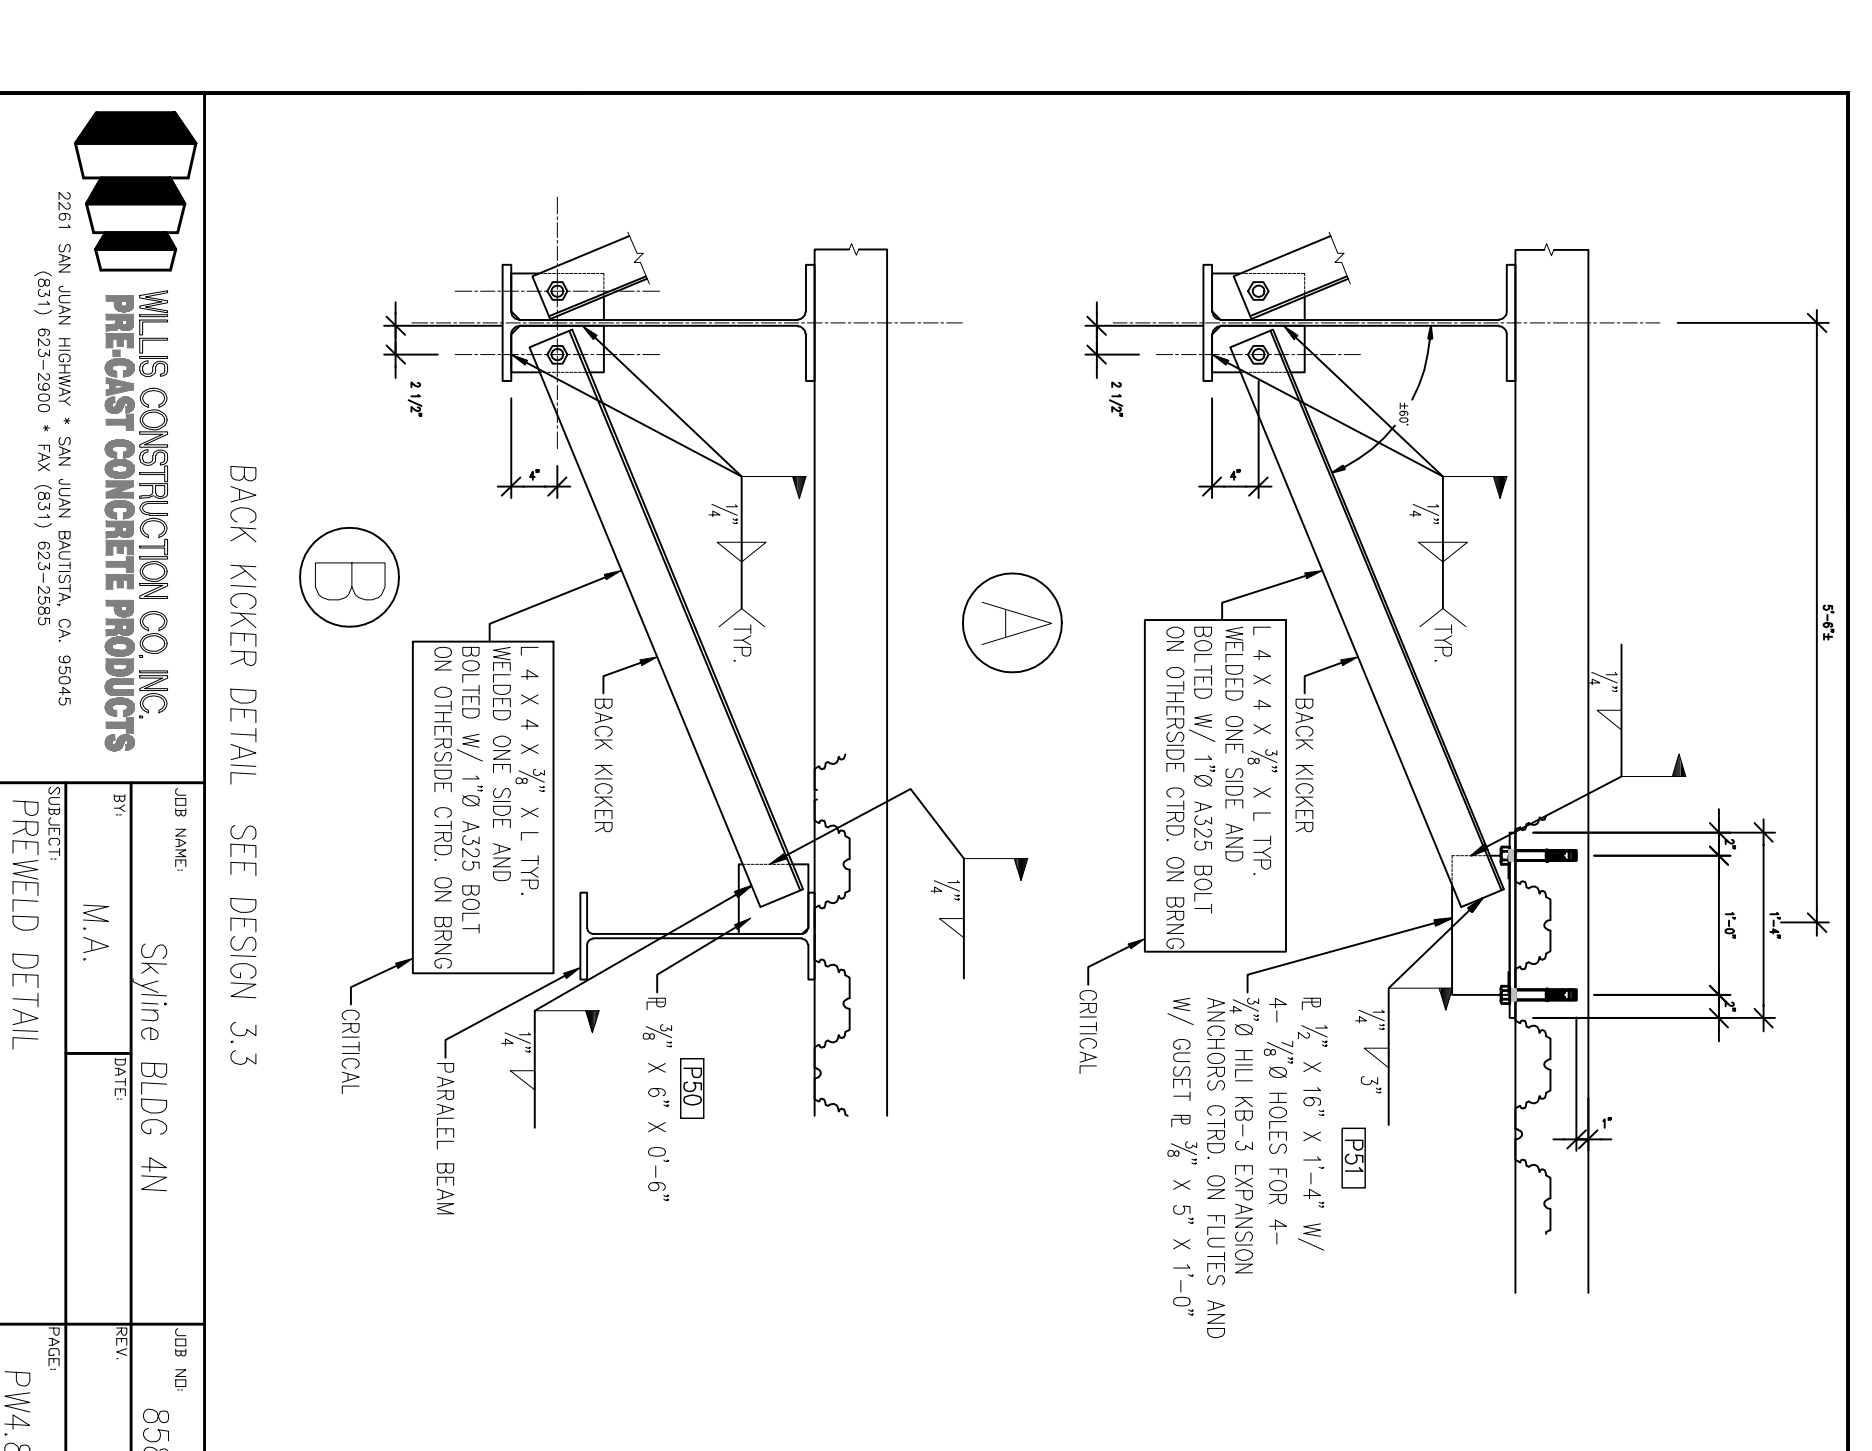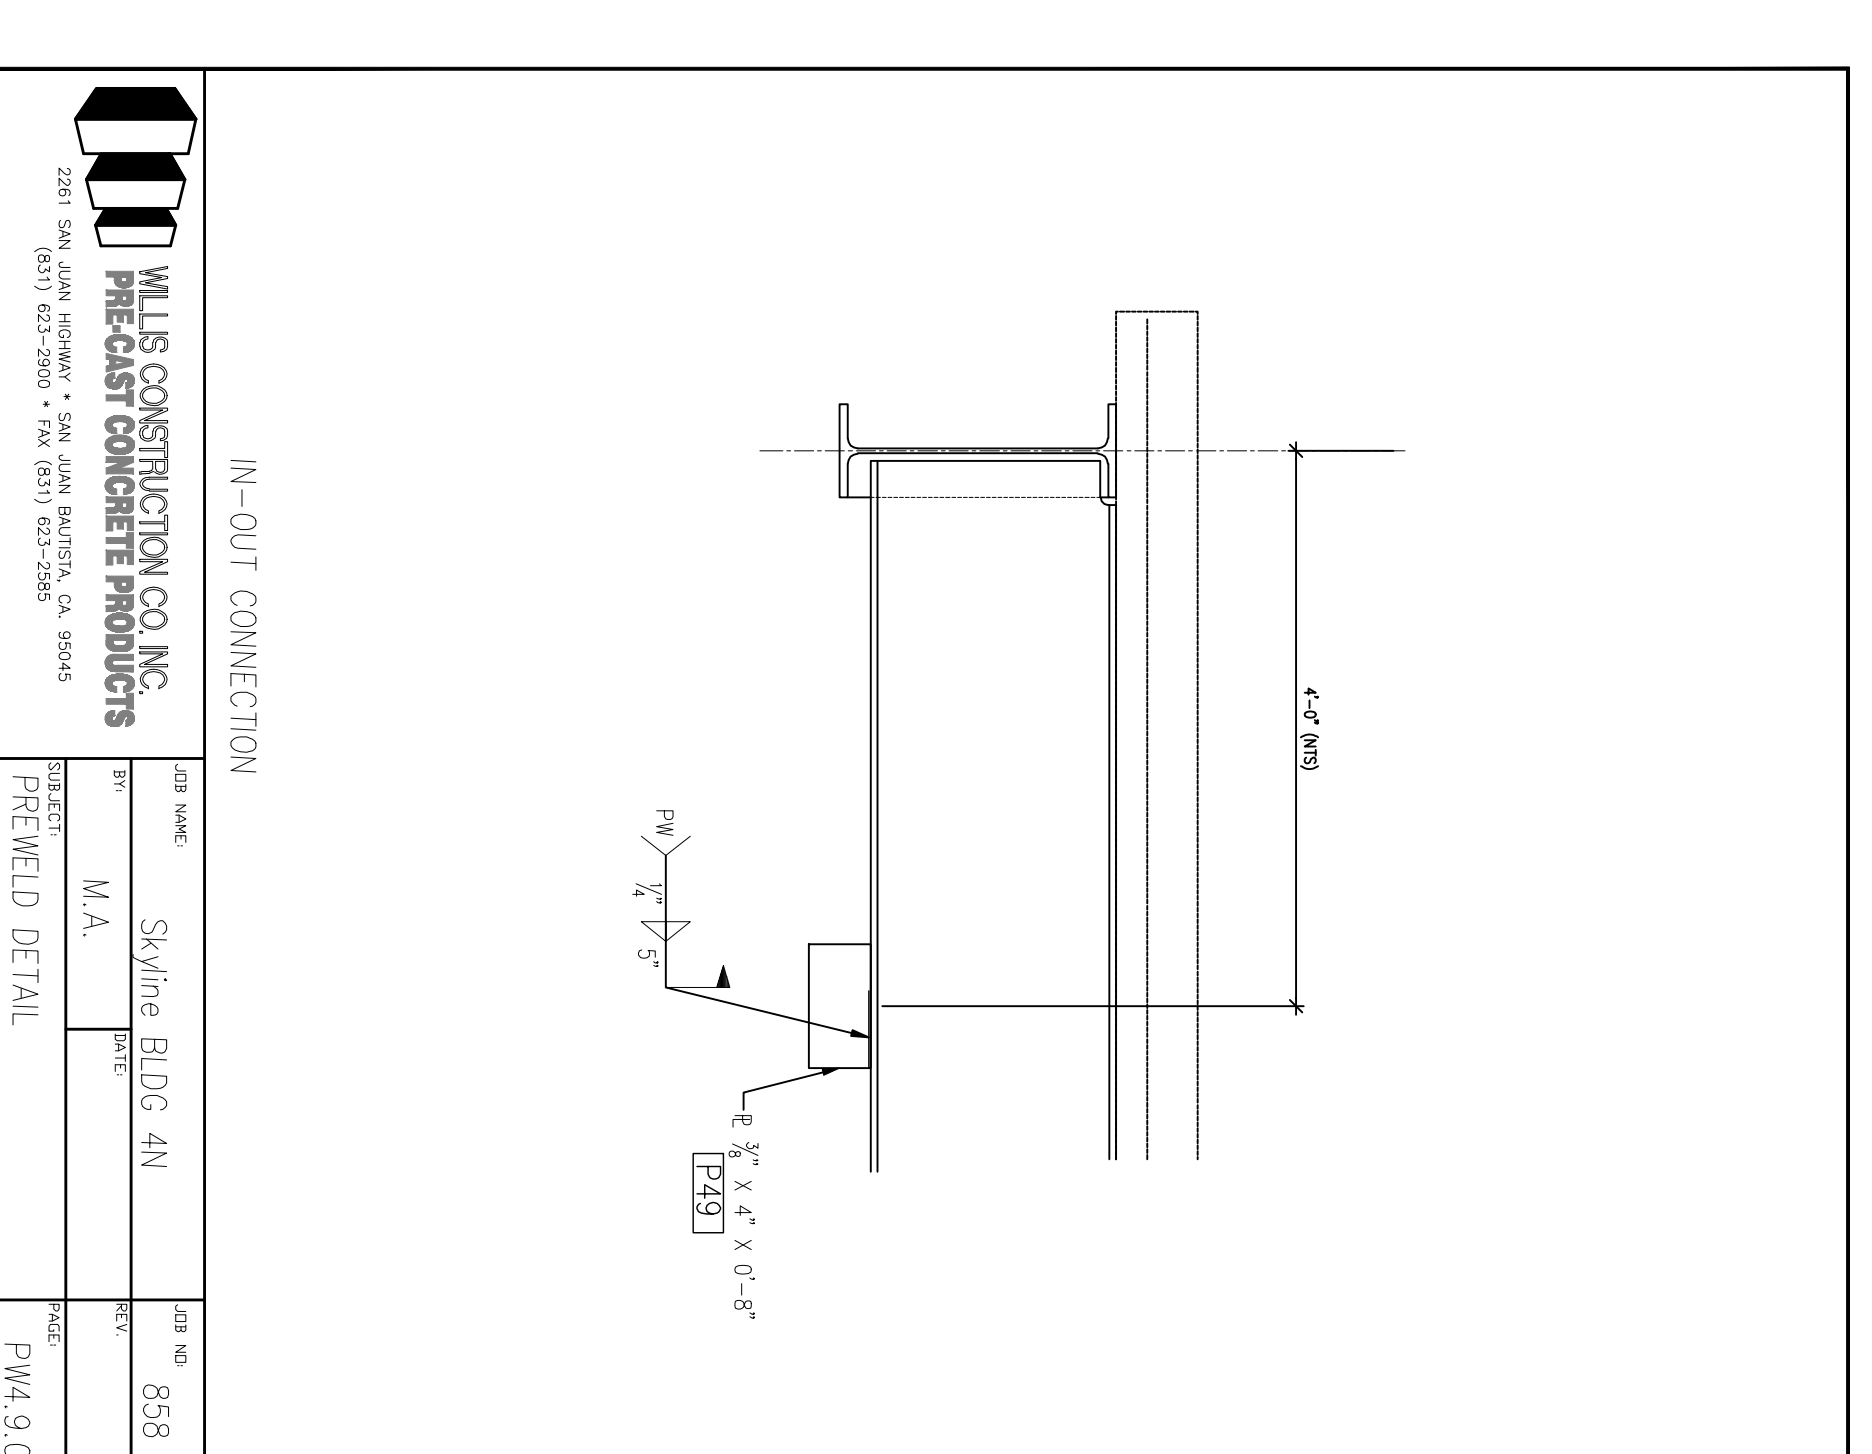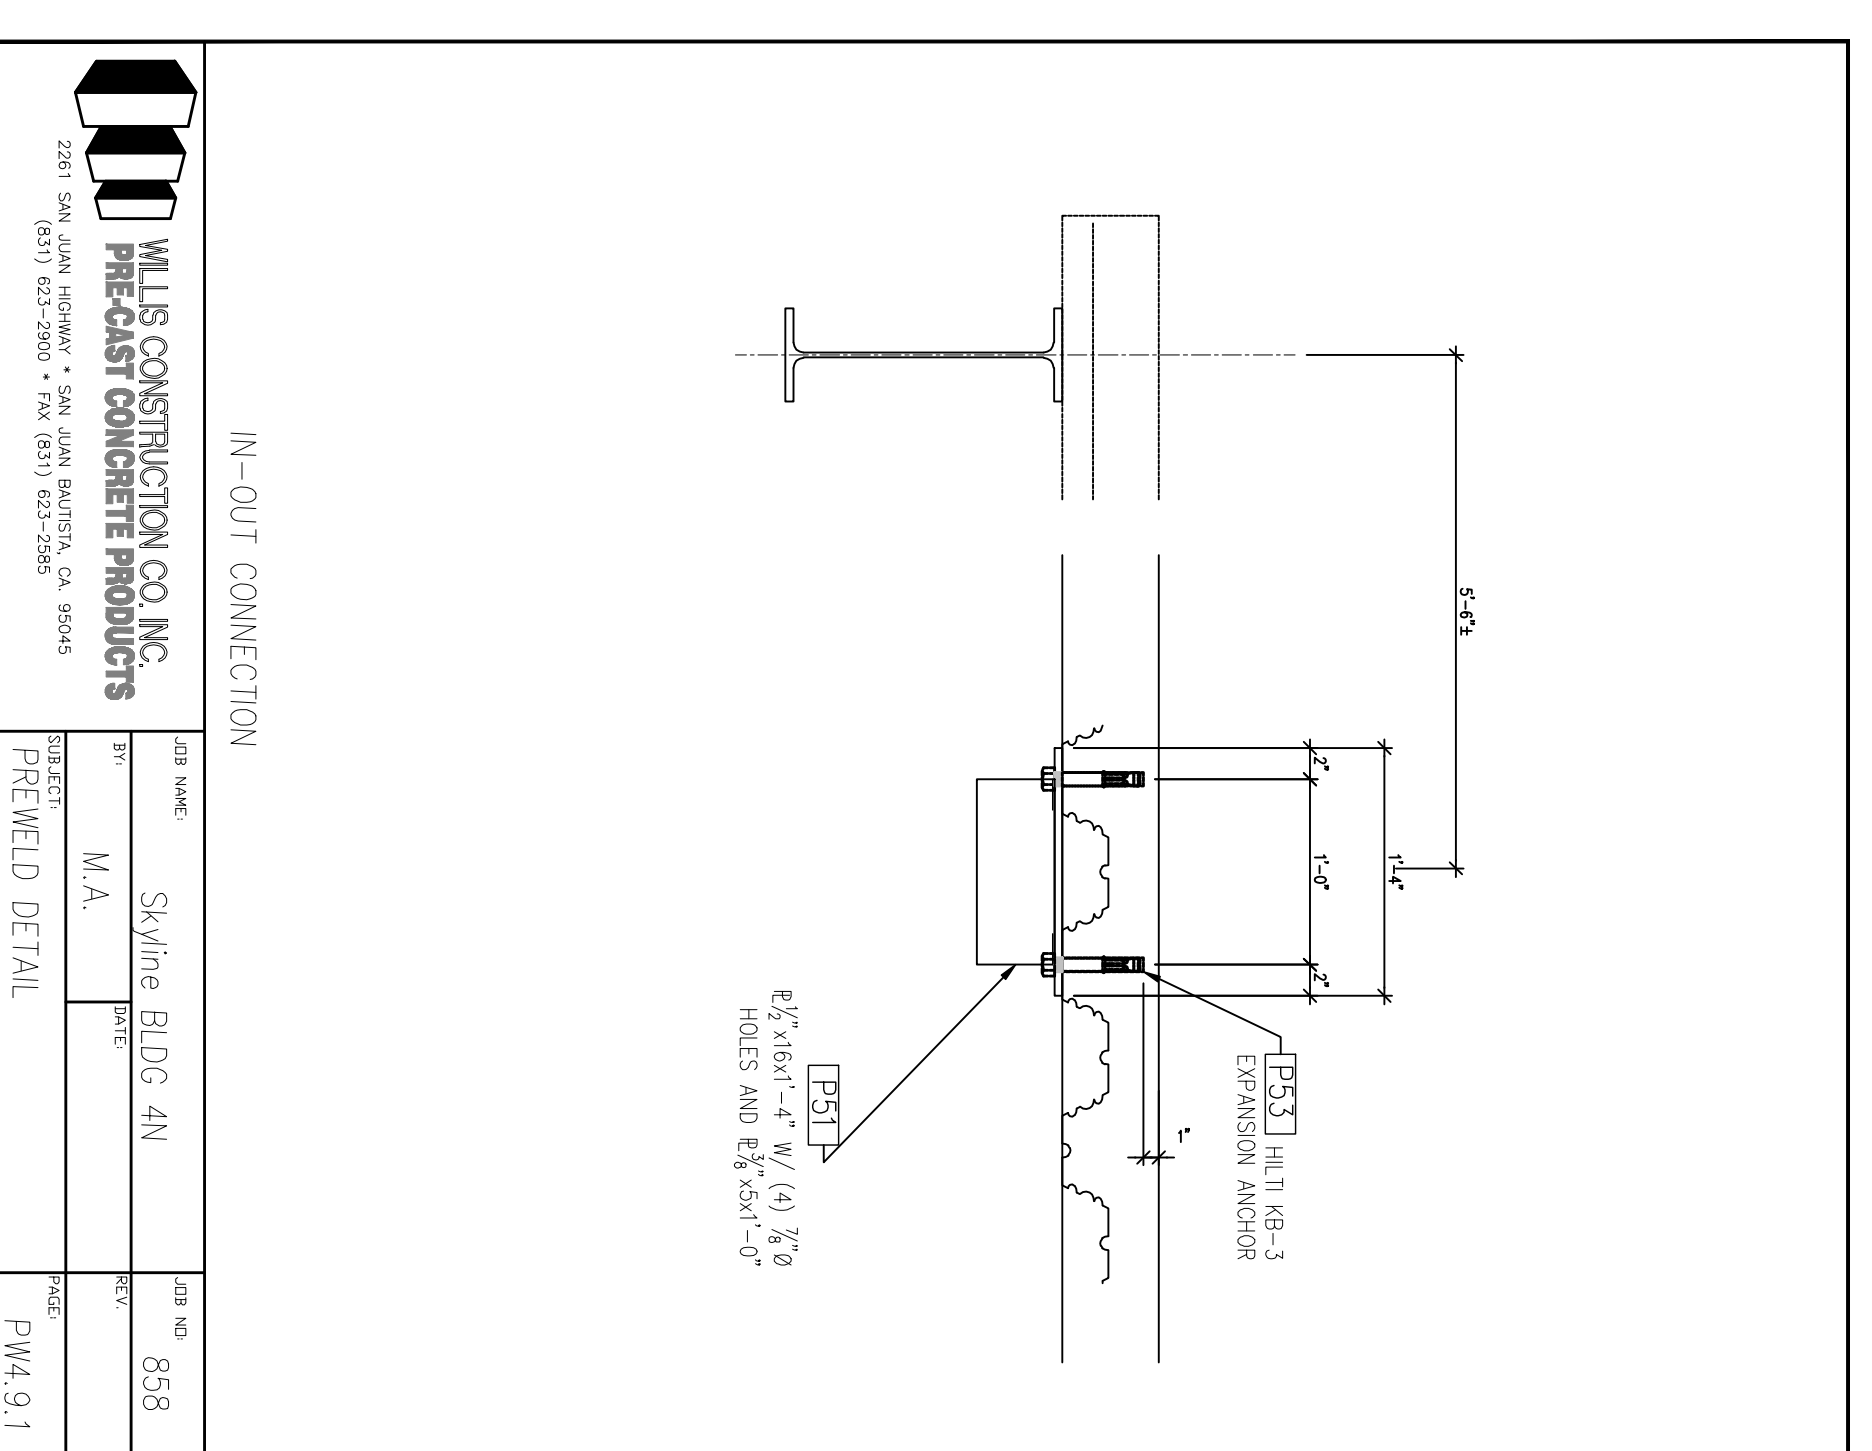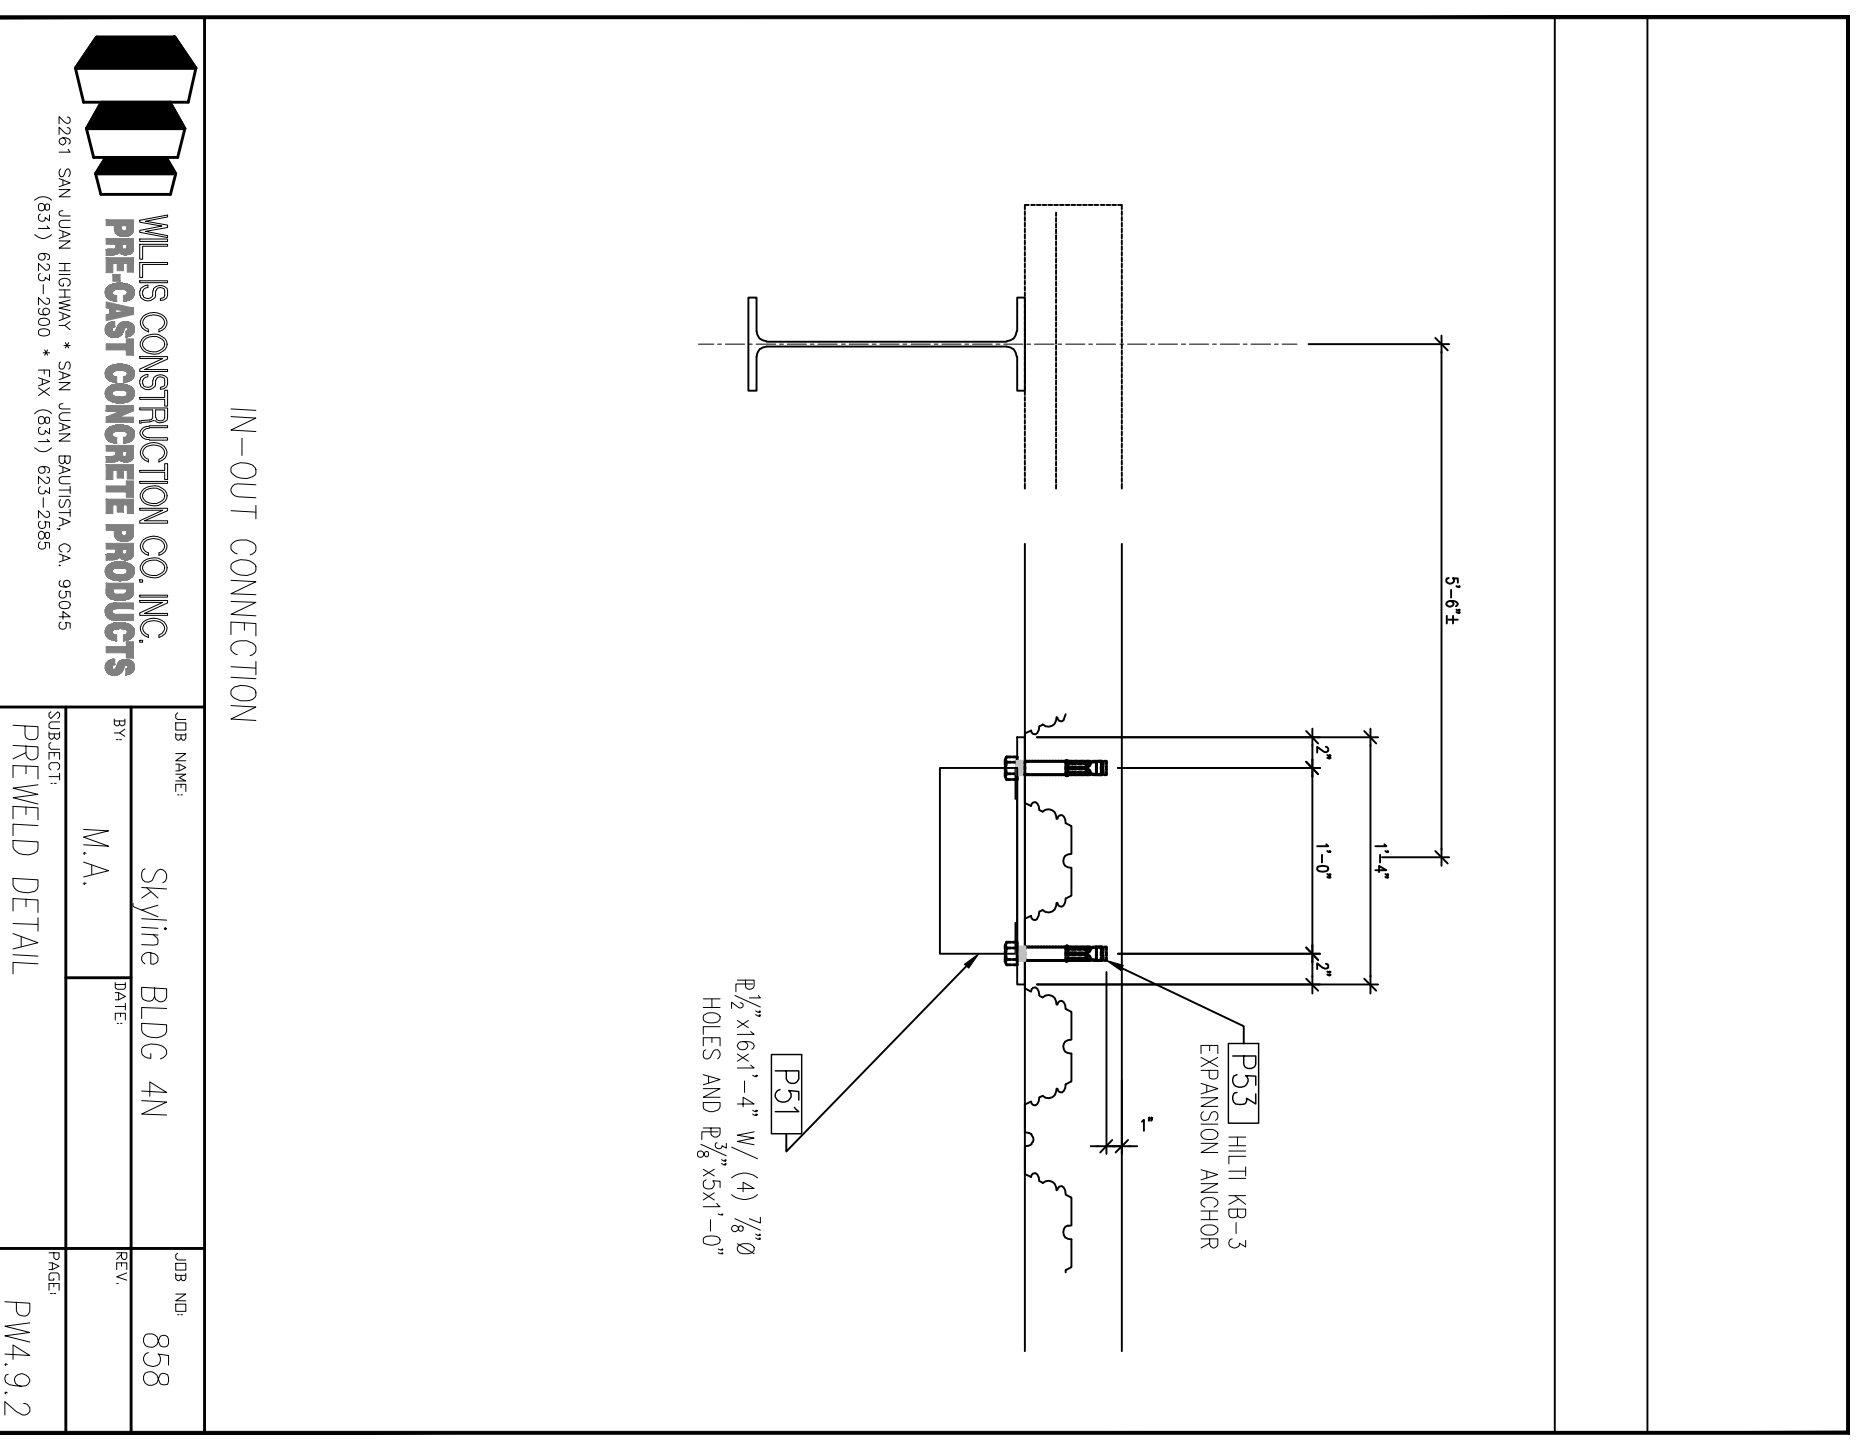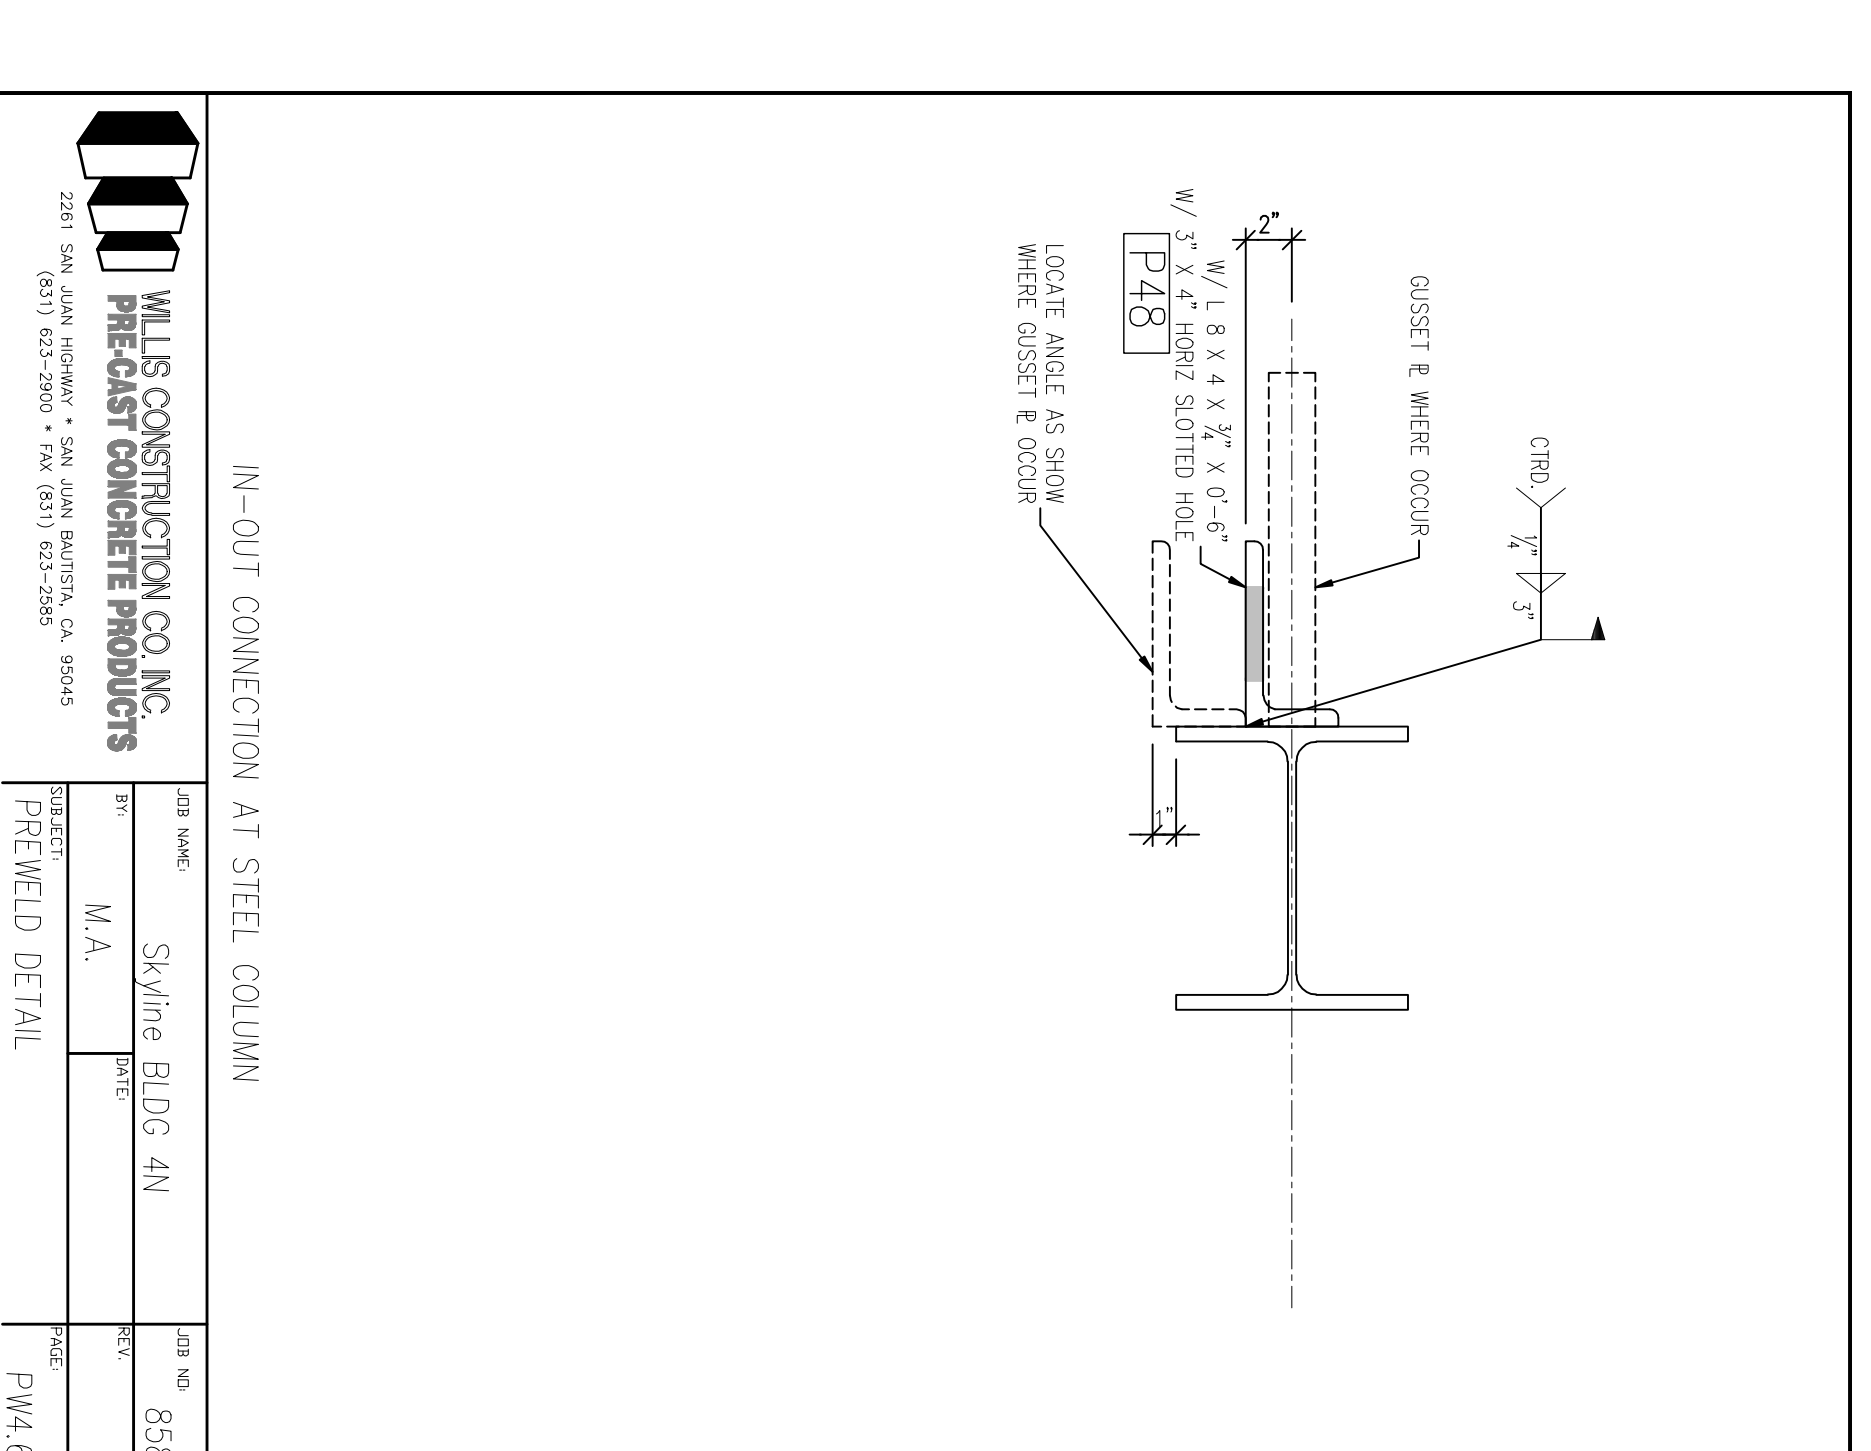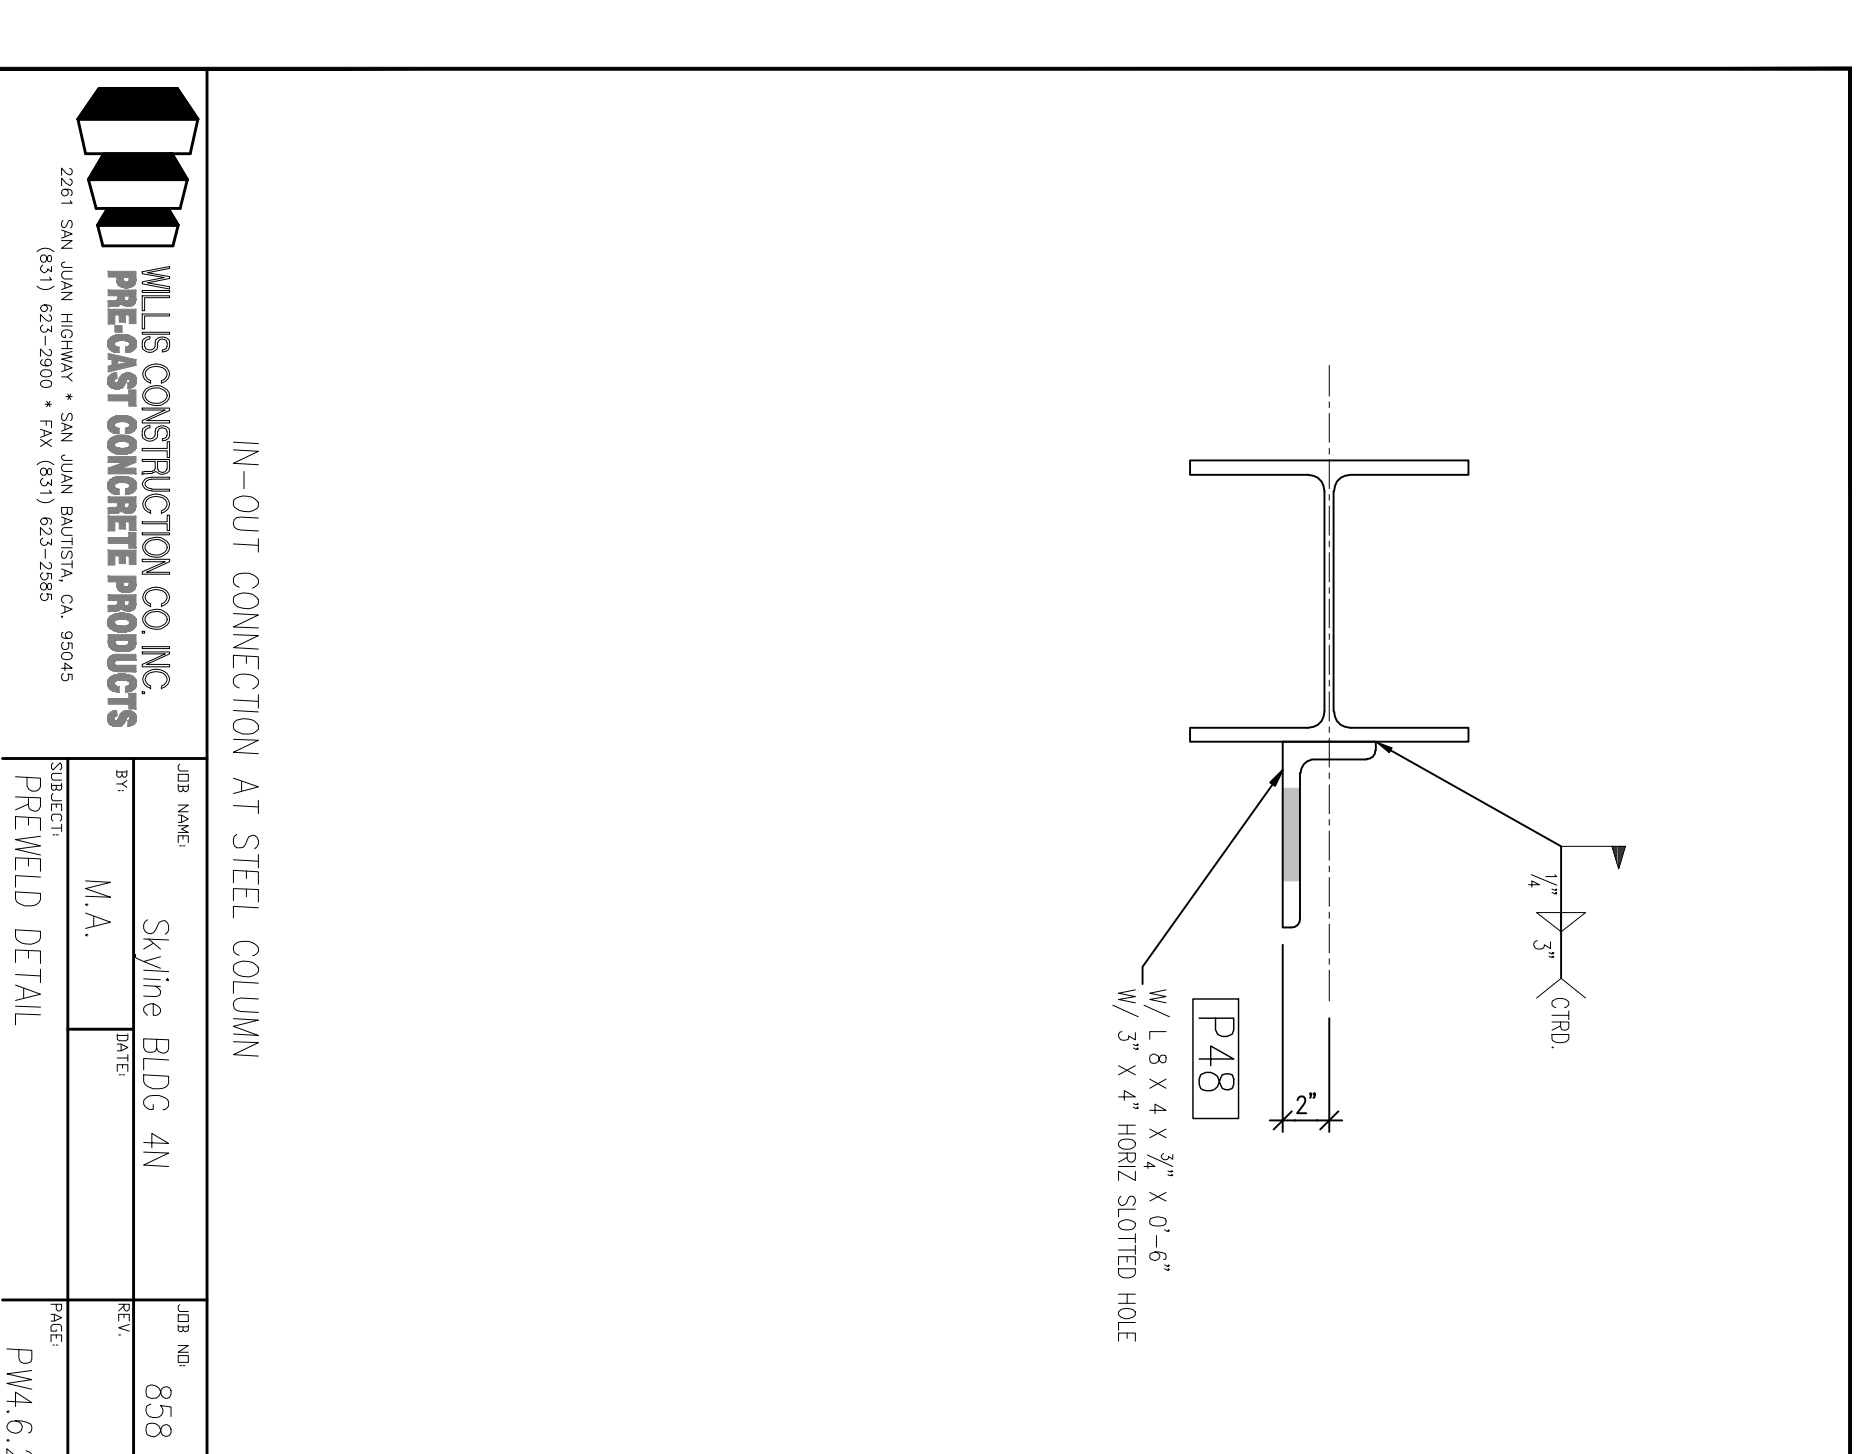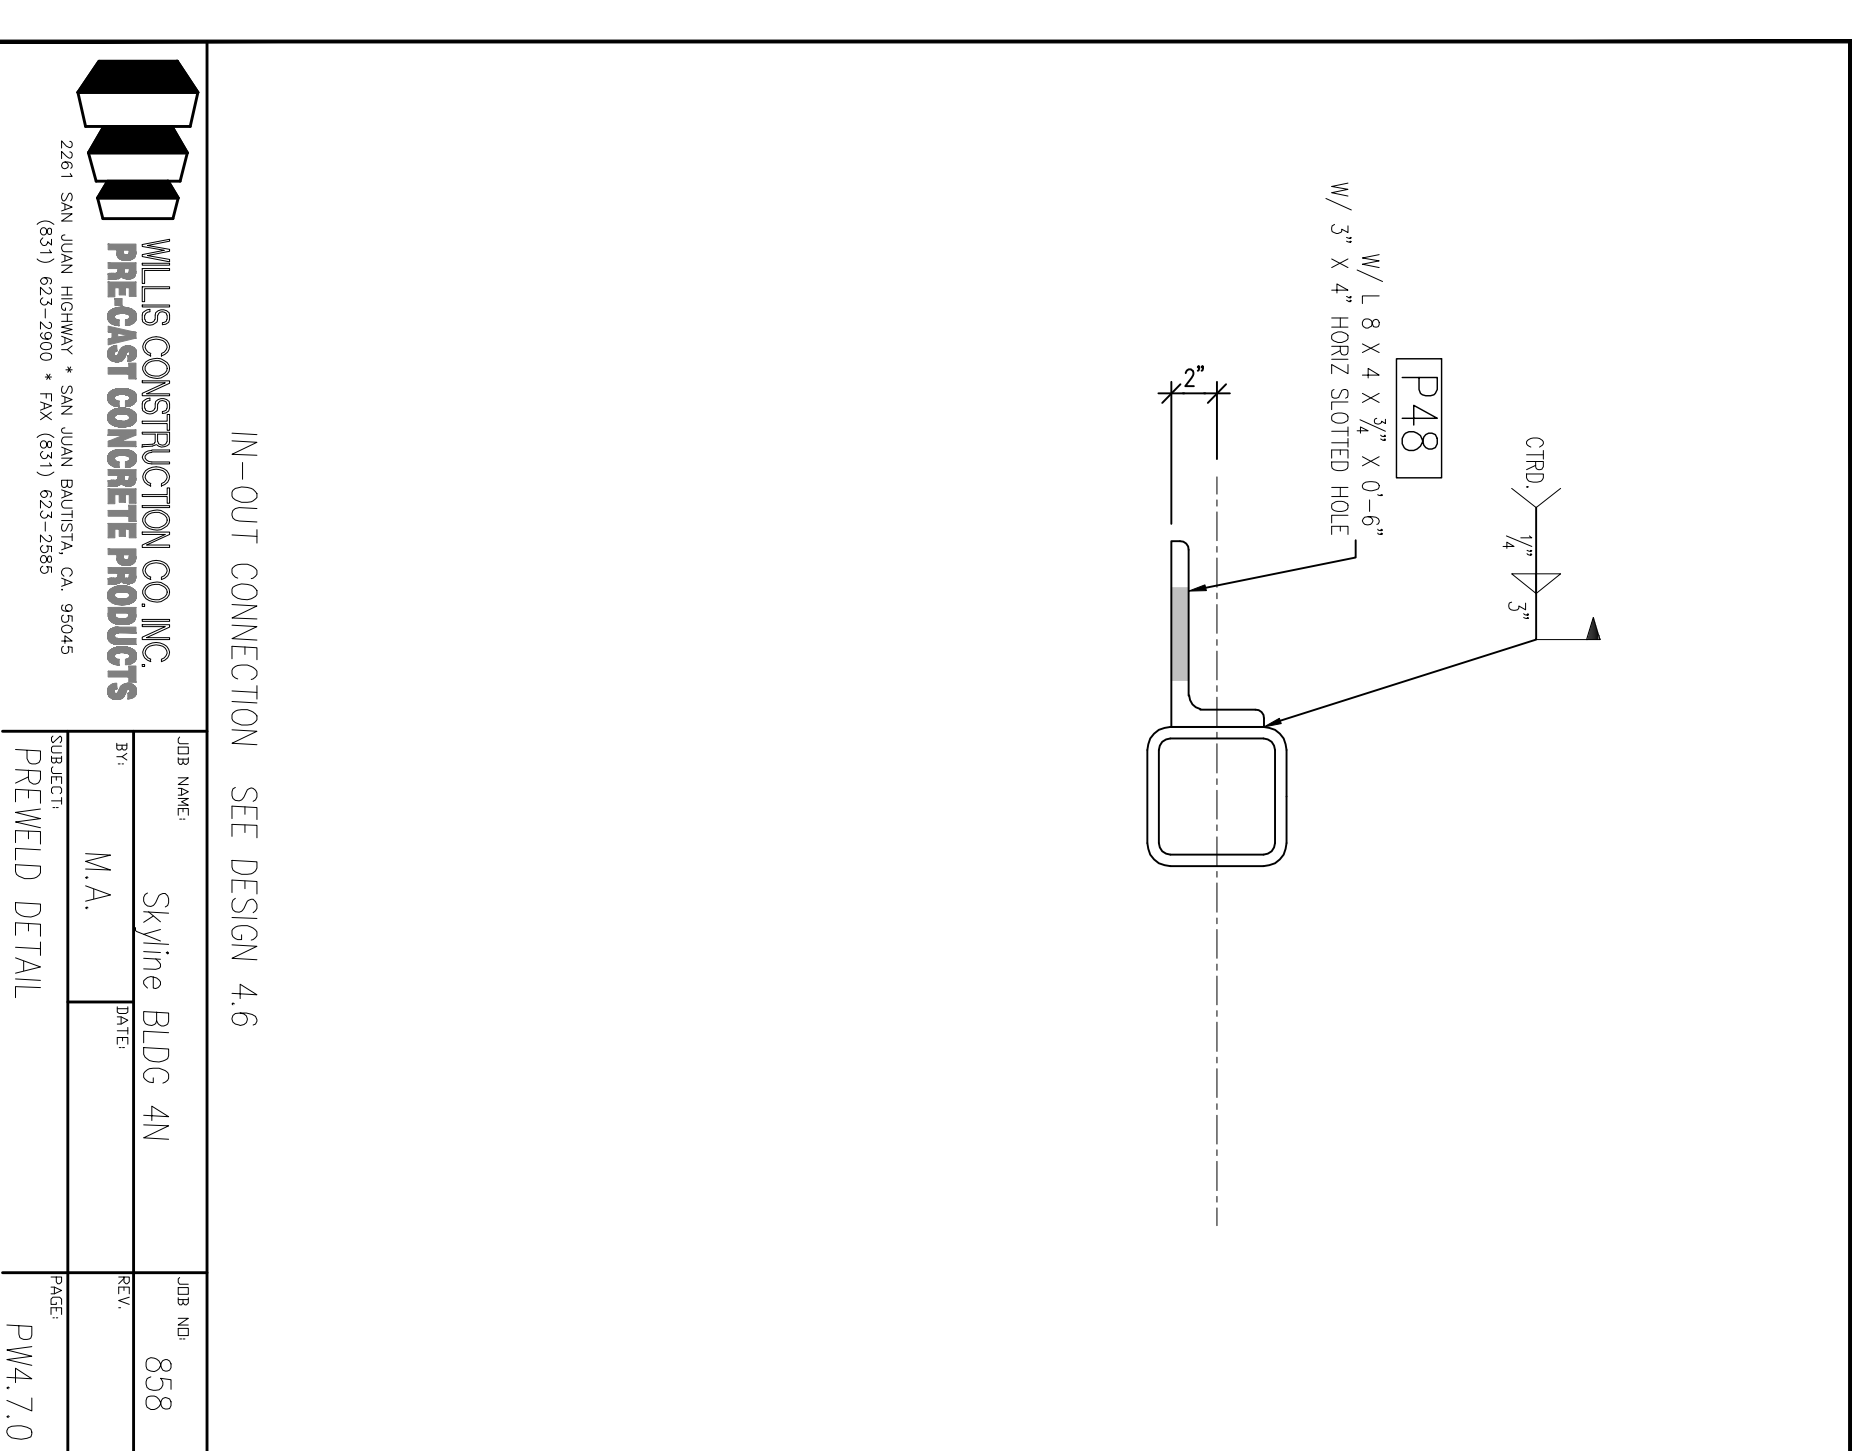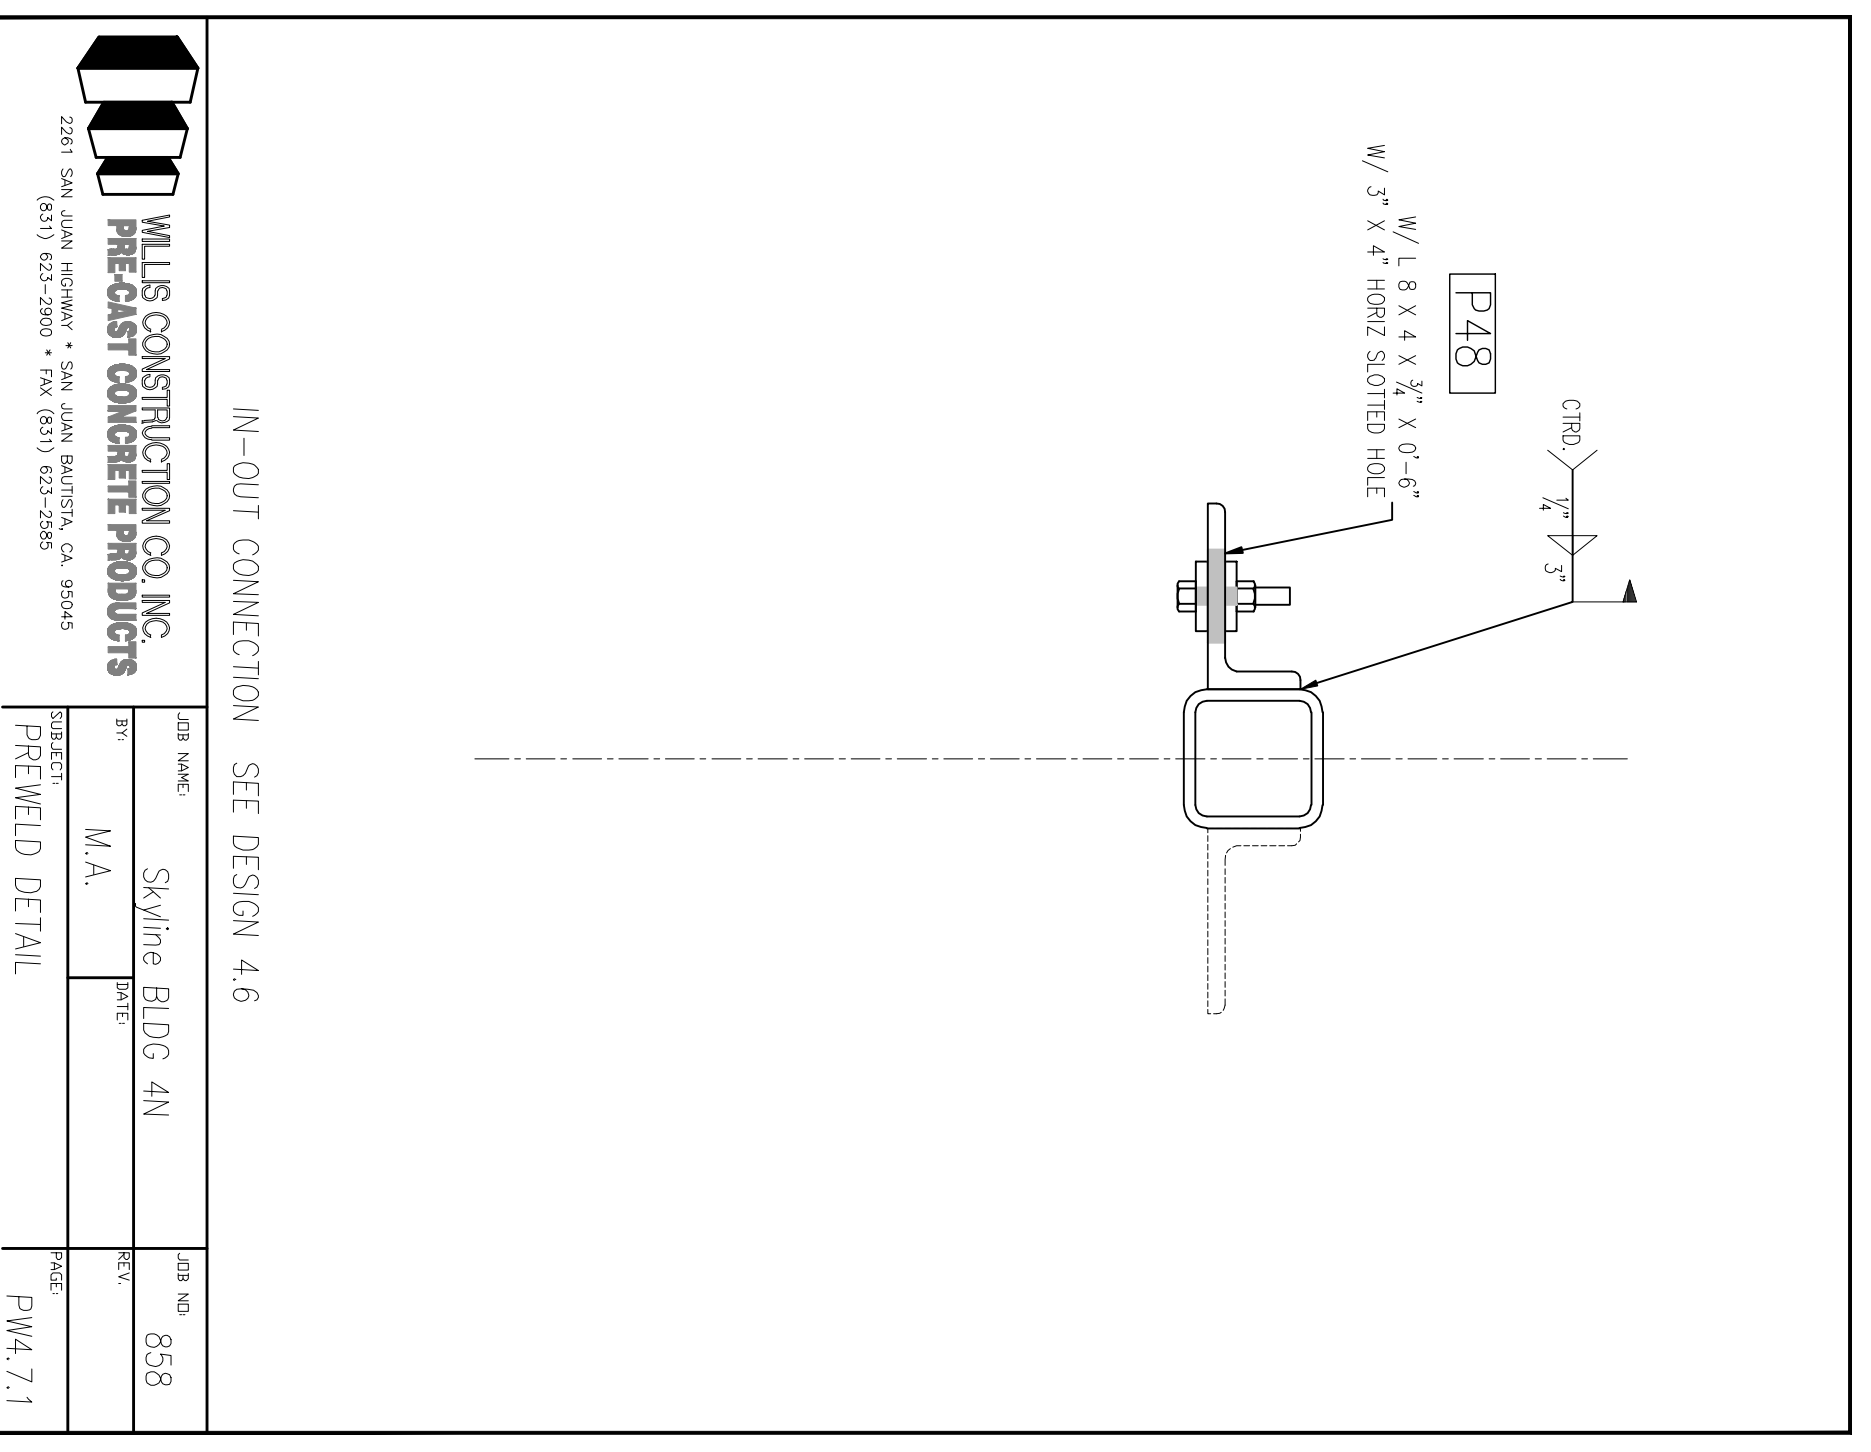

All drawings and details created specifically for this project and are not to be used for any other project without the written consent of the architect.

This drawing is not to be used for any other project without the written consent of the architect.