


RFP15

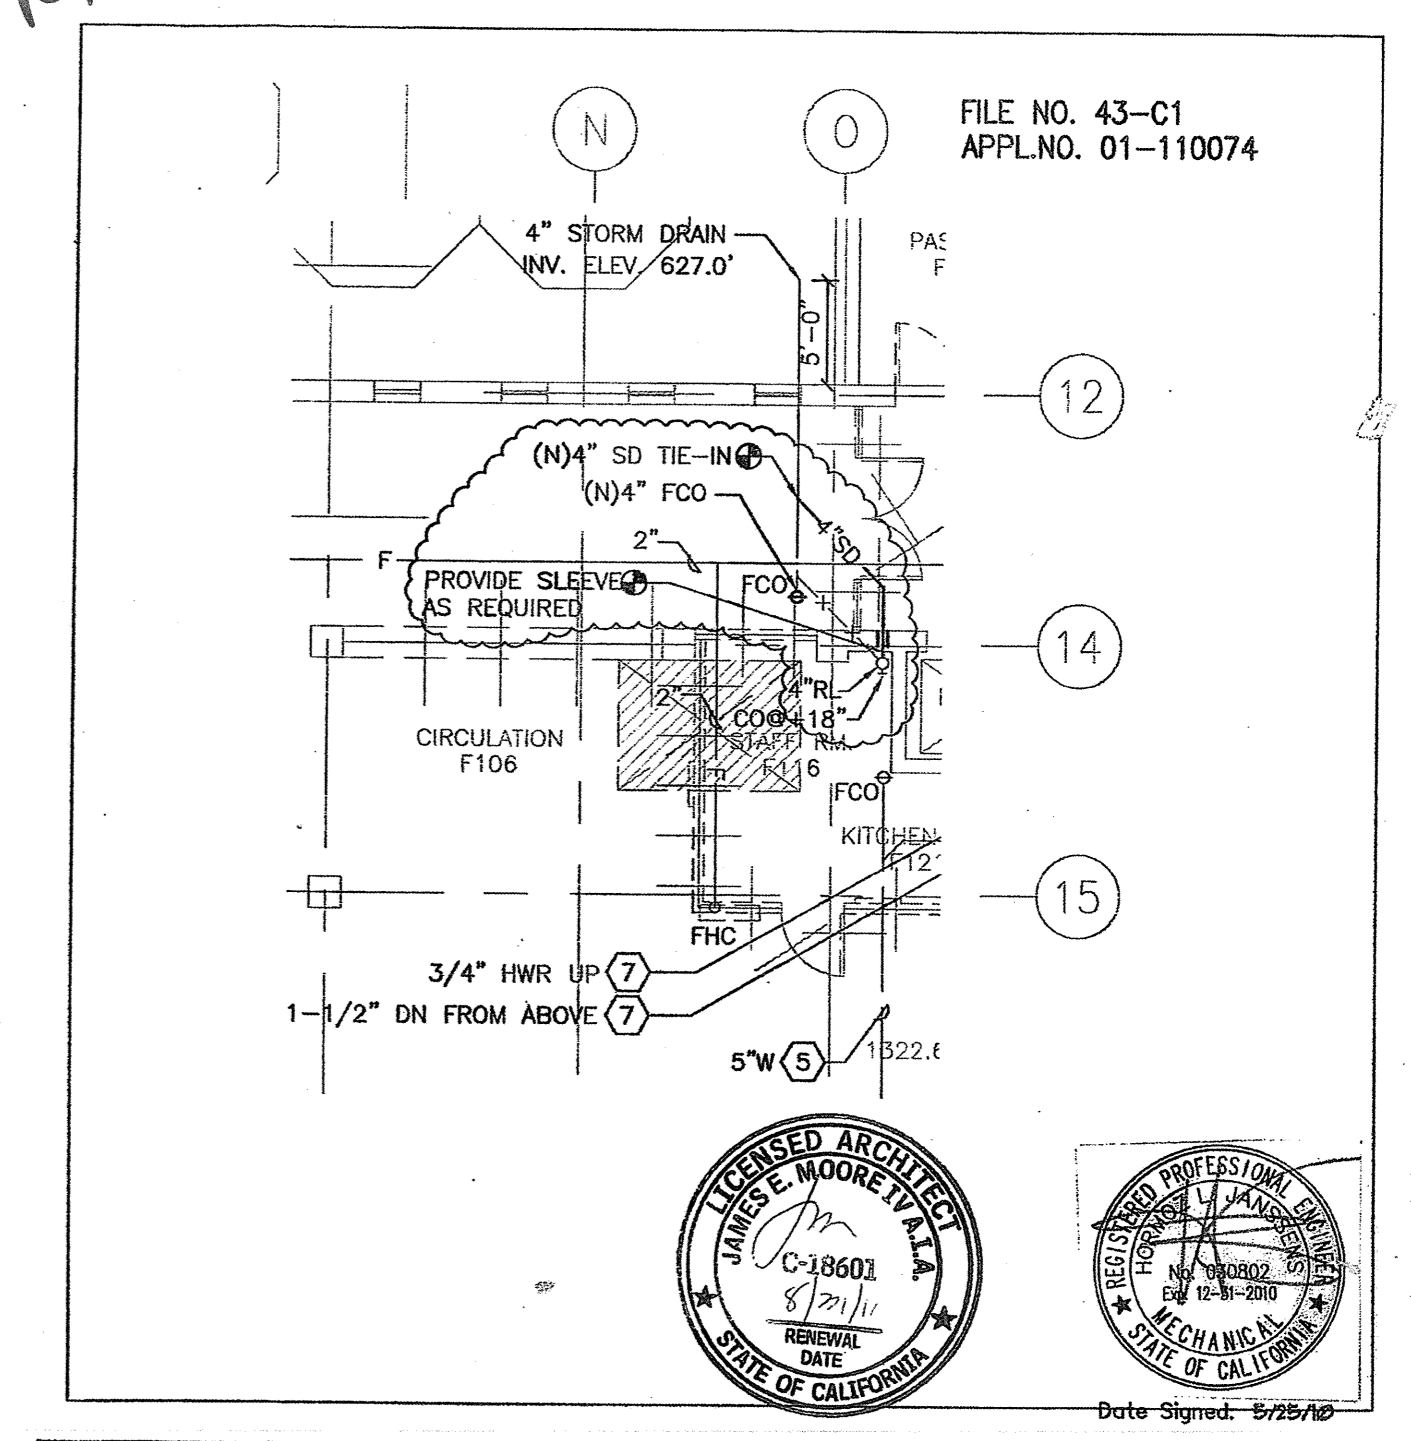

BCA architecture planning interiors	Project Name: CANADA COLLEGE - BUILDINGS 5 & 6 RENOVATIONS SAN MATEO COUNTY COMMUNITY COLLEGE DISTRICT 4200 FARM HILL BOULEVARD REDWOOD CITY, CA 94061 FILE NO. 43-C1 APPL. 01-110074	Date: 8/25/11	Sheet: PSK-01	Project Number: 0101
---	---	------------------	------------------	-------------------------