

PROJECT 2007-0731
CONTACT Omar Hawit

INTERFACE
ENGINEERING

717 Market Street
Suite 500
San Francisco, CA 94103
TEL 415.459.7240
FAX 415.489.7289
www.interfaceengineering.com

ARCHITECT	ENGINEER

GENERAL NOTES

- This sheet is part of a set and is not to be used alone.
- This sheet is not to be used for construction unless the architect's stamp and signature appear on the drawings and the status box indicates drawings have been released for construction.
- These plans and prints thereof, as instruments of service, are owned by the architect and are for use on this project only. Reproduction and/or distribution without the prior written consent of the architect is forbidden.
- Copyright Bunton Clifford Associates, 2007.

REMARKS	DATE

DRAWING STATUS	DATE

FILE NO. 41-C1

IDENTIFICATION STAMP
DN. OF THE STATE ARCHITECT

01-110074

AC 1/11/09 FLS 1/28/09

DATE MAR 19 2009

**BUILDINGS 5 & 6
RENOVATIONS**

San Mateo County Community
College District

DSA BACK-CHECK

CAÑADA COLLEGE
4200 Farm Hill Boulevard
Redwood City, CA 94061

SECOND FLOOR
DEMOLITION PLAN
PLUMBING


Date 01/22/09
Scale AS NOTED
Project Number 07013

Drawing Number
PD1.2

SHEET KEYNOTES

- REMOVE (E) WALL MOUNTED WATER CLOSET INCLUDING CARRIER, FLUSHMETER VALVE, TOILET SEAT AND RELATED PIPING. CAP (E) WASTE PIPE BELOW THE FLOOR AND CAP VENT PIPE ABOVE THE FLOOR INSIDE THE WALL.
- REMOVE (E) URINAL INCLUDING STOP VALVES AND RELATED PIPING. CAP (E) WASTE PIPE BELOW THE FLOOR AND CAP VENT PIPE ABOVE THE FLOOR INSIDE THE WALL.
- REMOVE (E) WALL MOUNTED LAVATORY INCLUDING DRAIN, P-TRAP, SUPPLY TUBING, STOP VALVES AND RELATED PIPING. CAP (E) WASTE PIPE BELOW THE FLOOR AND CAP VENT PIPE ABOVE THE FLOOR INSIDE THE WALL. PATCH HOLE TO MATCH (E) WALL.
- (E) FD AND RELATED PIPING TO BE REMOVED. PATCH FLOOR SLAB TO MATCH (E) FLOOR SLAB.
- (E) PIPING TO REMAIN.
- REMOVE (E) HOSE BIBB AND RELATED PIPING.
- (E) PIPE RISER TO REMAIN.
- PROVIDE CAP ON (E) PIPING.
- (E) JANITOR SINK TO REMAIN.
- REMOVE (E) HOT WATER GENERATOR, HOT WATER CIRCULATING PUMP AND ASSOCIATED APPURTENANCES.
- (E) FD TO REMAIN.
- REMOVE & DISPOSE (E) GREASE INTERCEPTOR AND RELATED MATERIALS. PATCH FLOOR SLAB TO MATCH (E) FLOOR SLAB.

RFI-237
Grease Trap Repair
REF. ASI-022

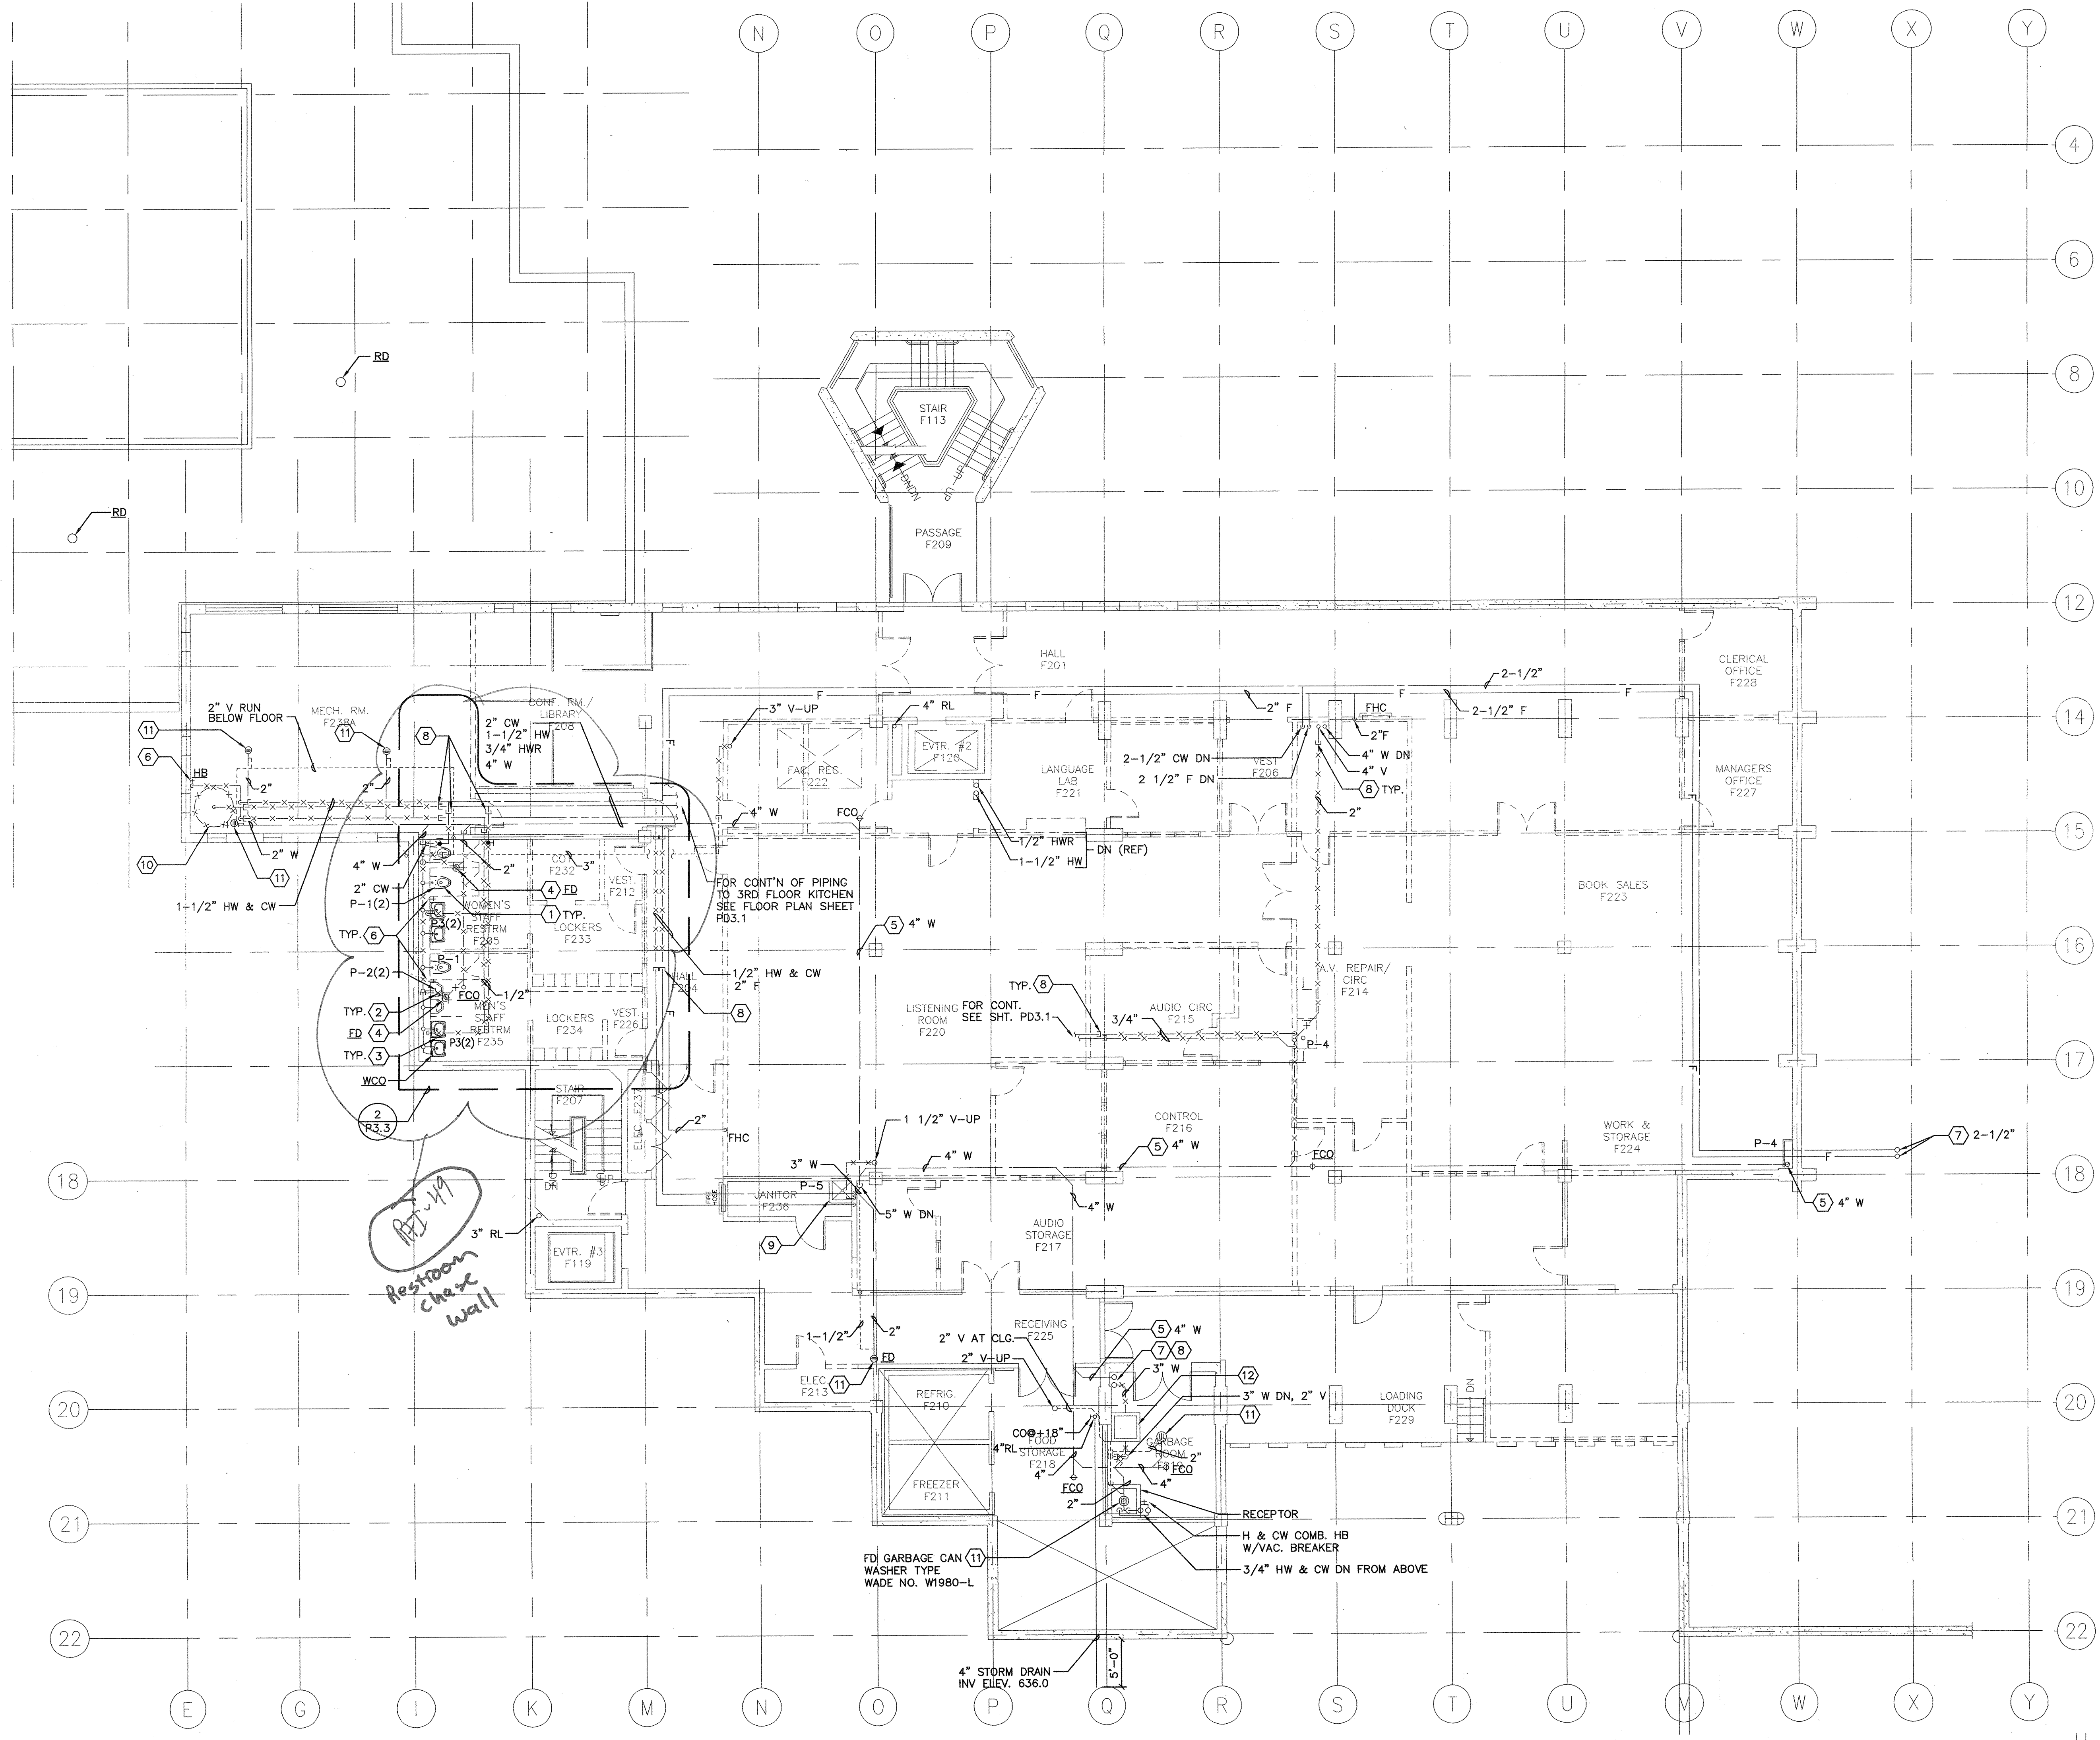

1 SECOND FLOOR DEMOLITION PLAN - PLUMBING

0 4' 8' 16'

SCALE: 1/8"=1'-0"