


Revision	Description	Date

Revision	Description	Date


Job No.	27082.30
Date	09 APRIL 2009
Drawn by	MC
Checked by	PR
Scale	NO SCALE

**SITE CONSTRUCTION CONCRETE DETAILS**


**S0.2**

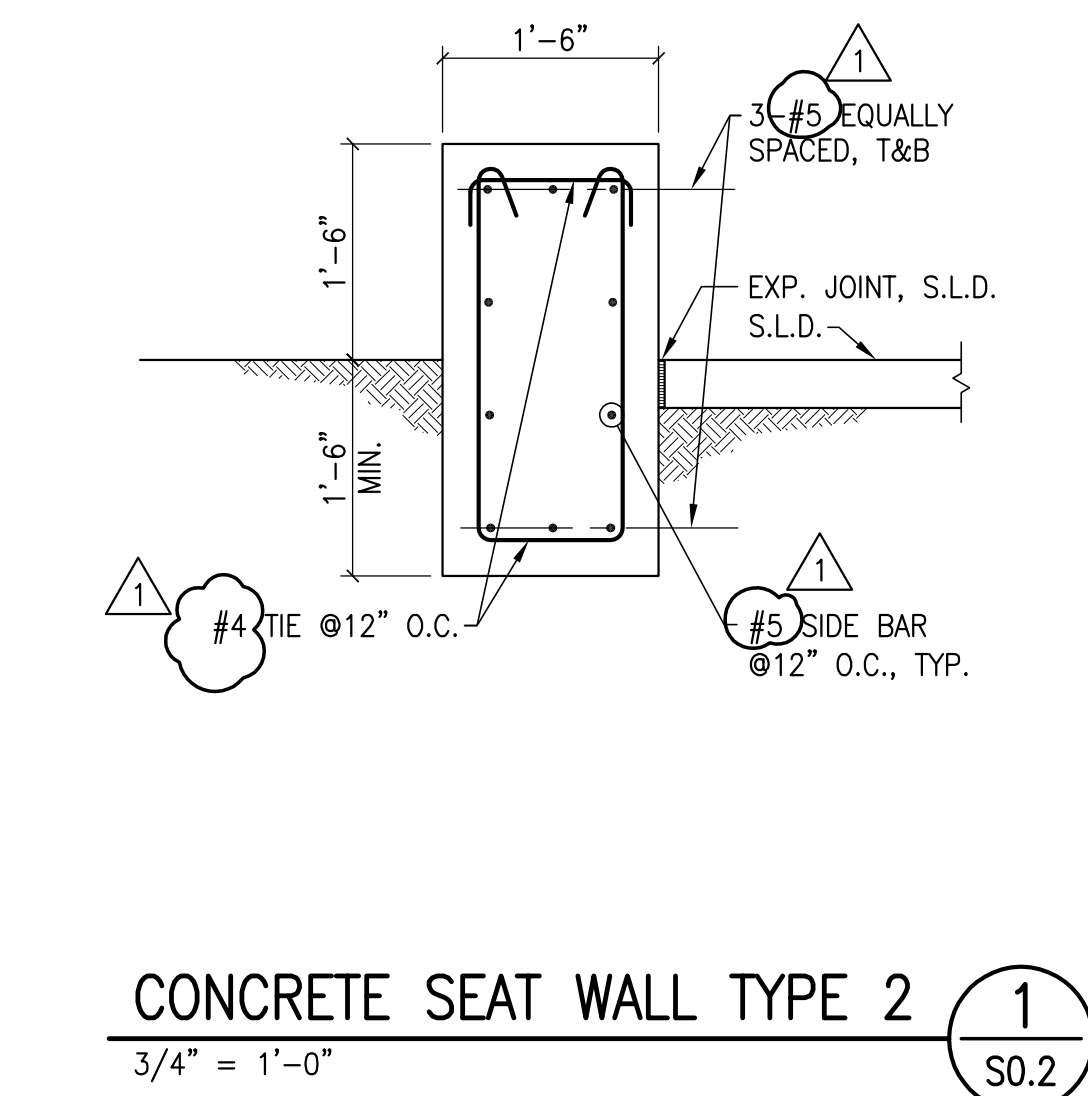


**CONCRETE SEAT WALL TYPE 2** 1  
3/4" = 1'-0" S0.2

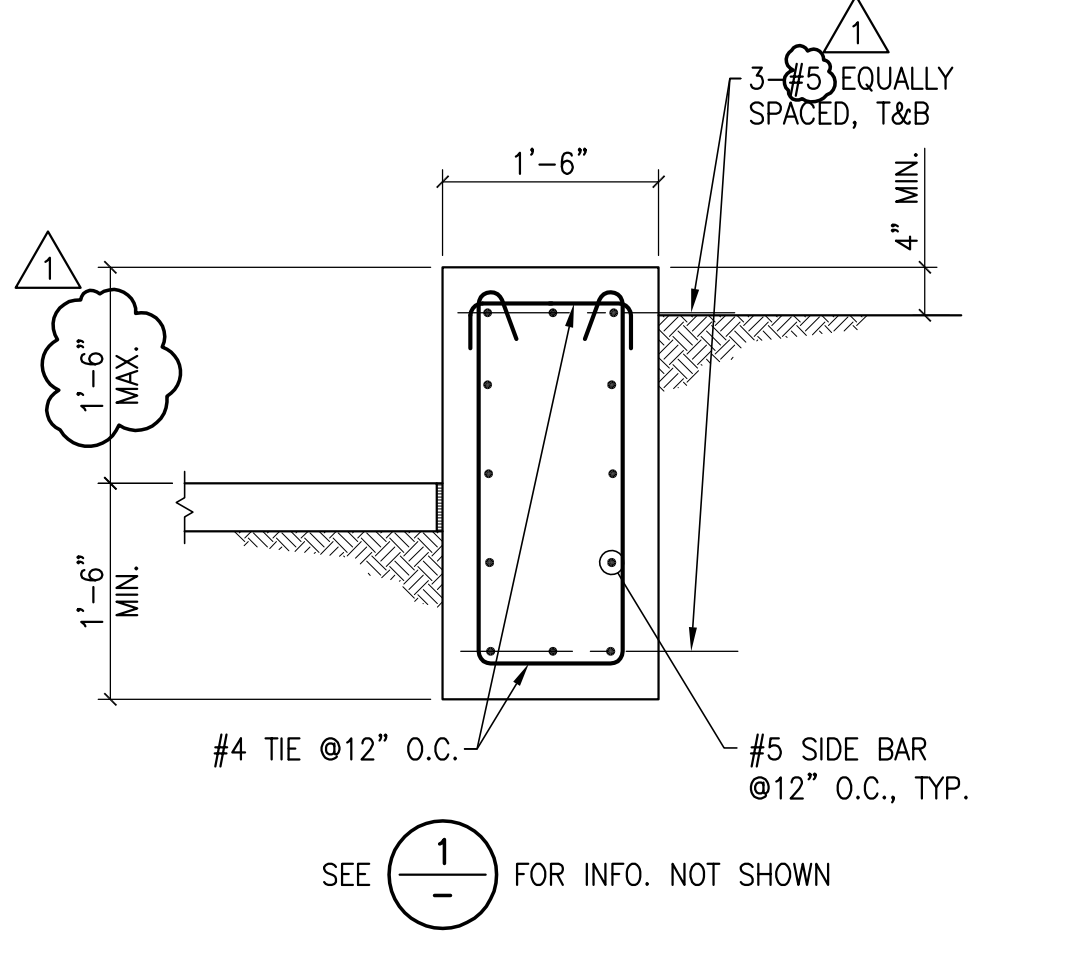


**CONCRETE SEAT WALL TYPE 4** 2  
3/4" = 1'-0" S0.2

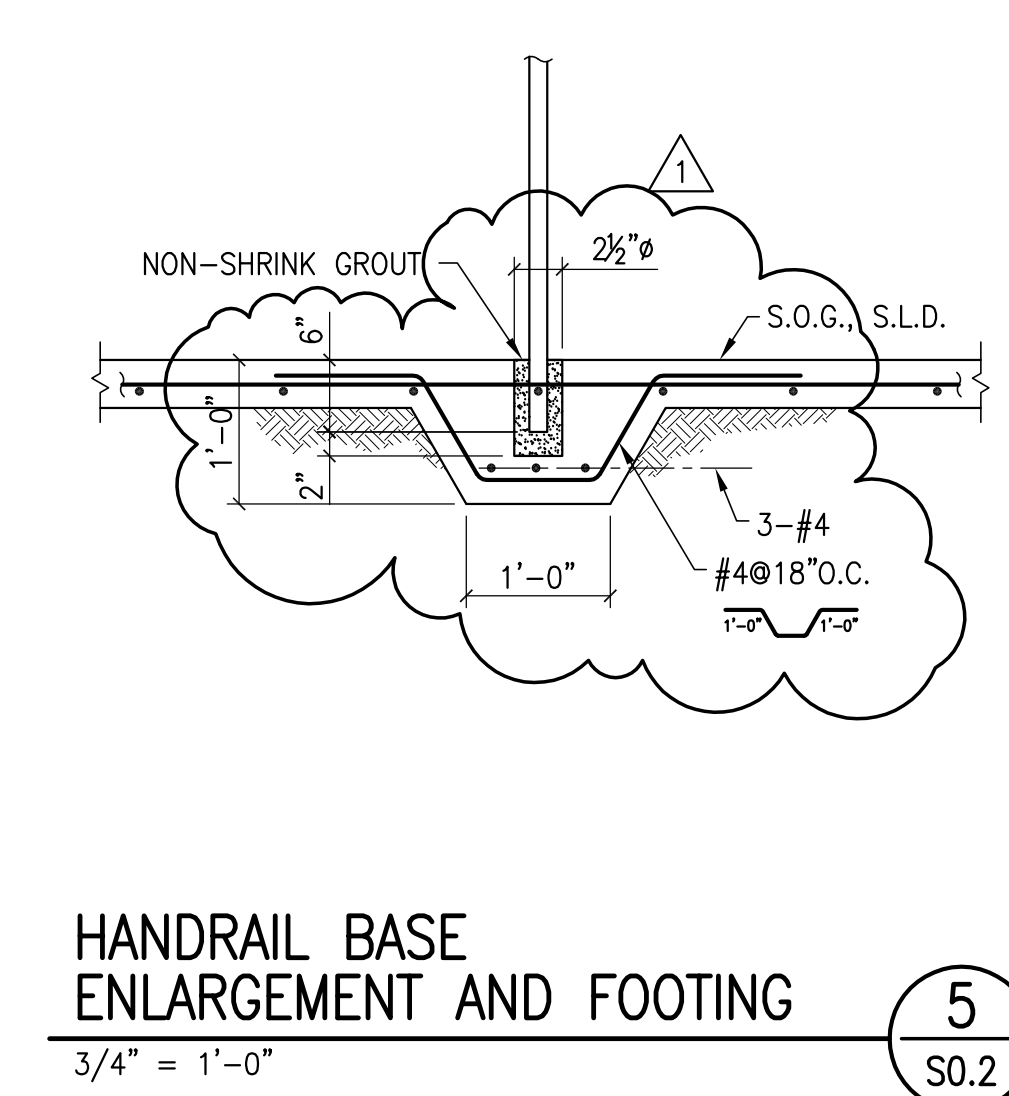


**HANDRAIL BASE ENLARGEMENT AND FOOTING** 5  
3/4" = 1'-0" S0.2

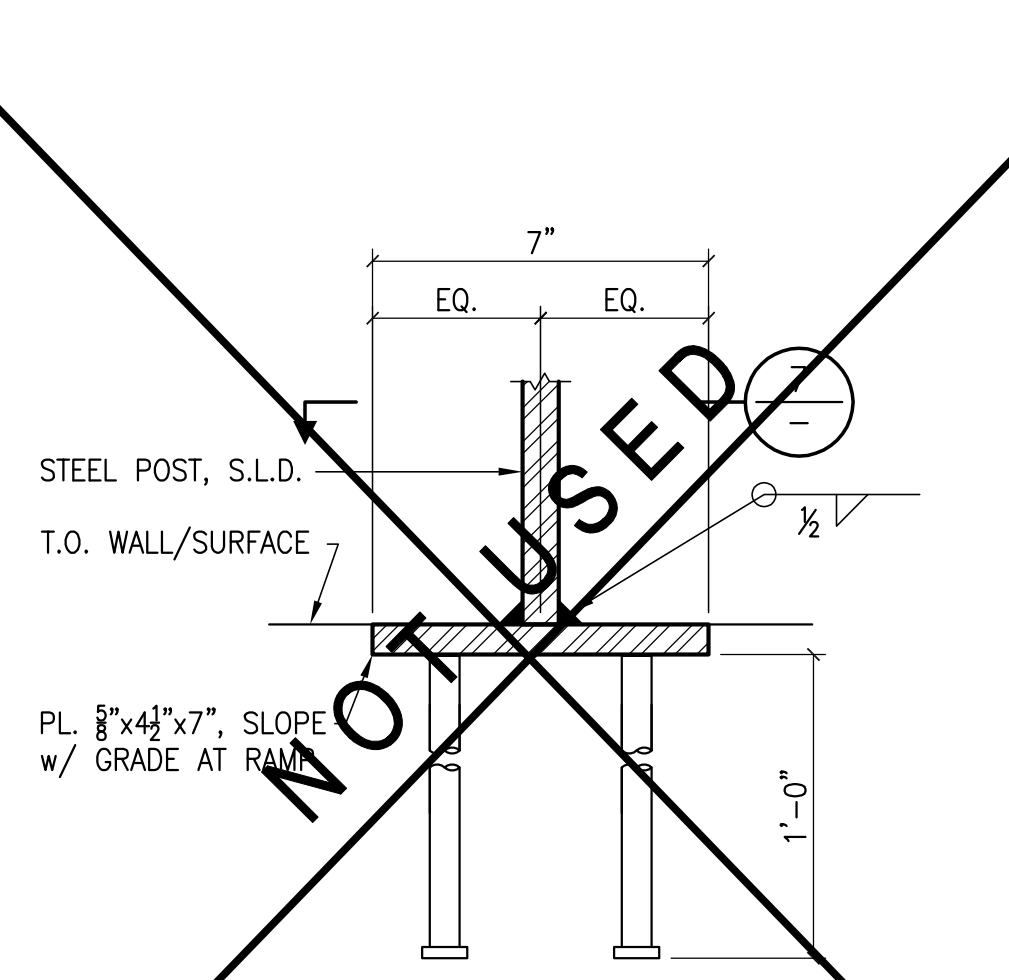


**BASE PL. ENLARGEMENT** 6  
3" = 1'-0" S0.2

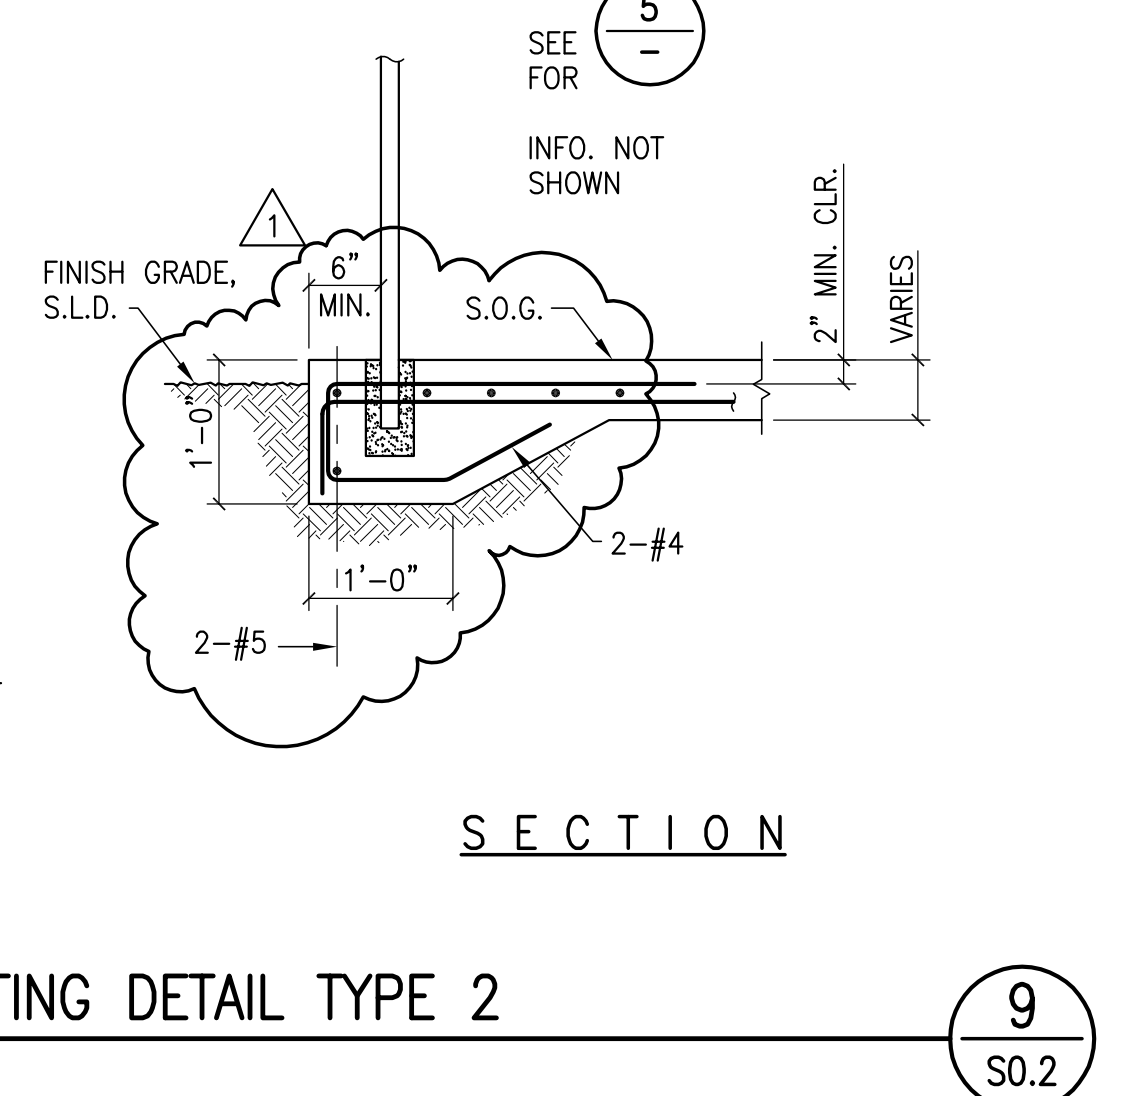


**HANDRAIL BASE ENLARGEMENT AND FOOTING DETAIL TYPE 2** 9  
3/4" = 1'-0" S0.2

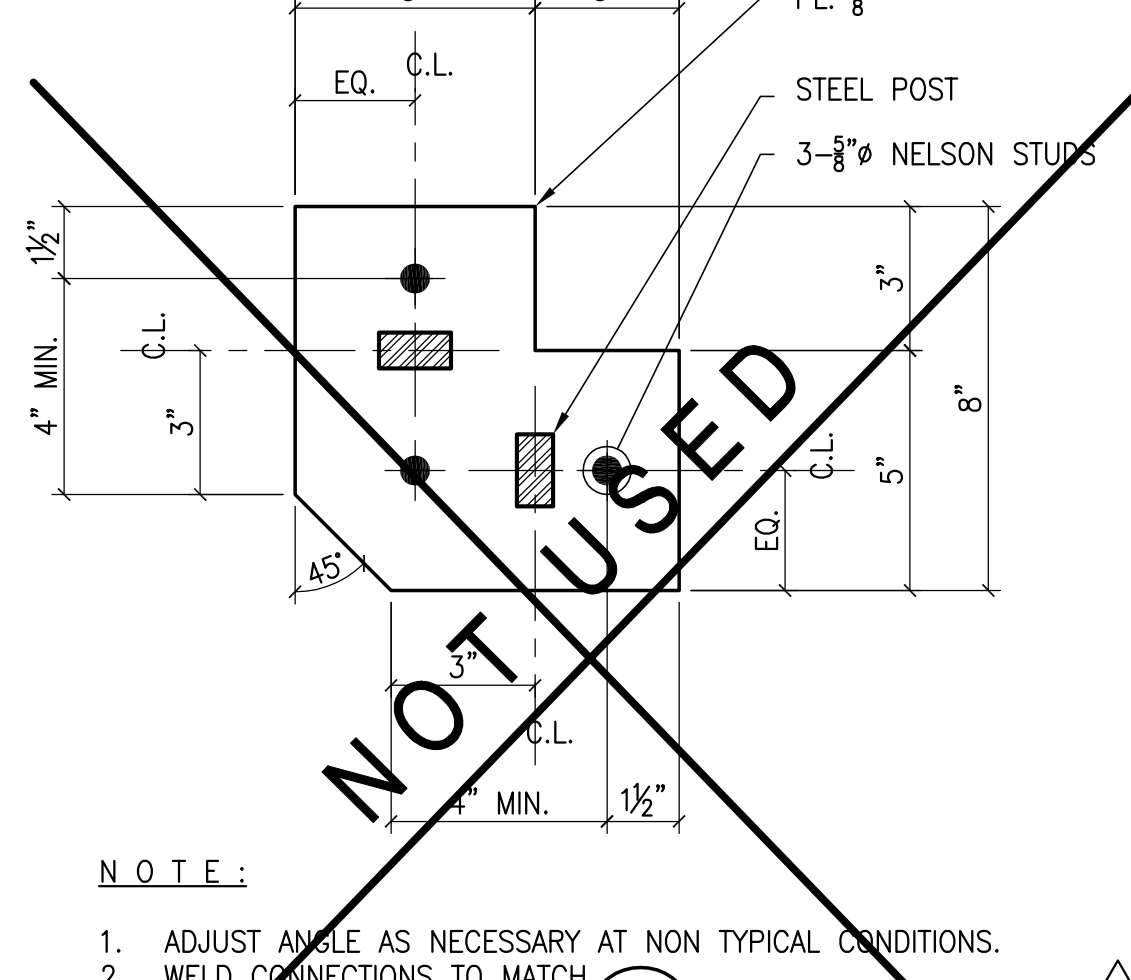


**BASE PL. CORNER PLAN** 10  
3" = 1'-0" S0.2

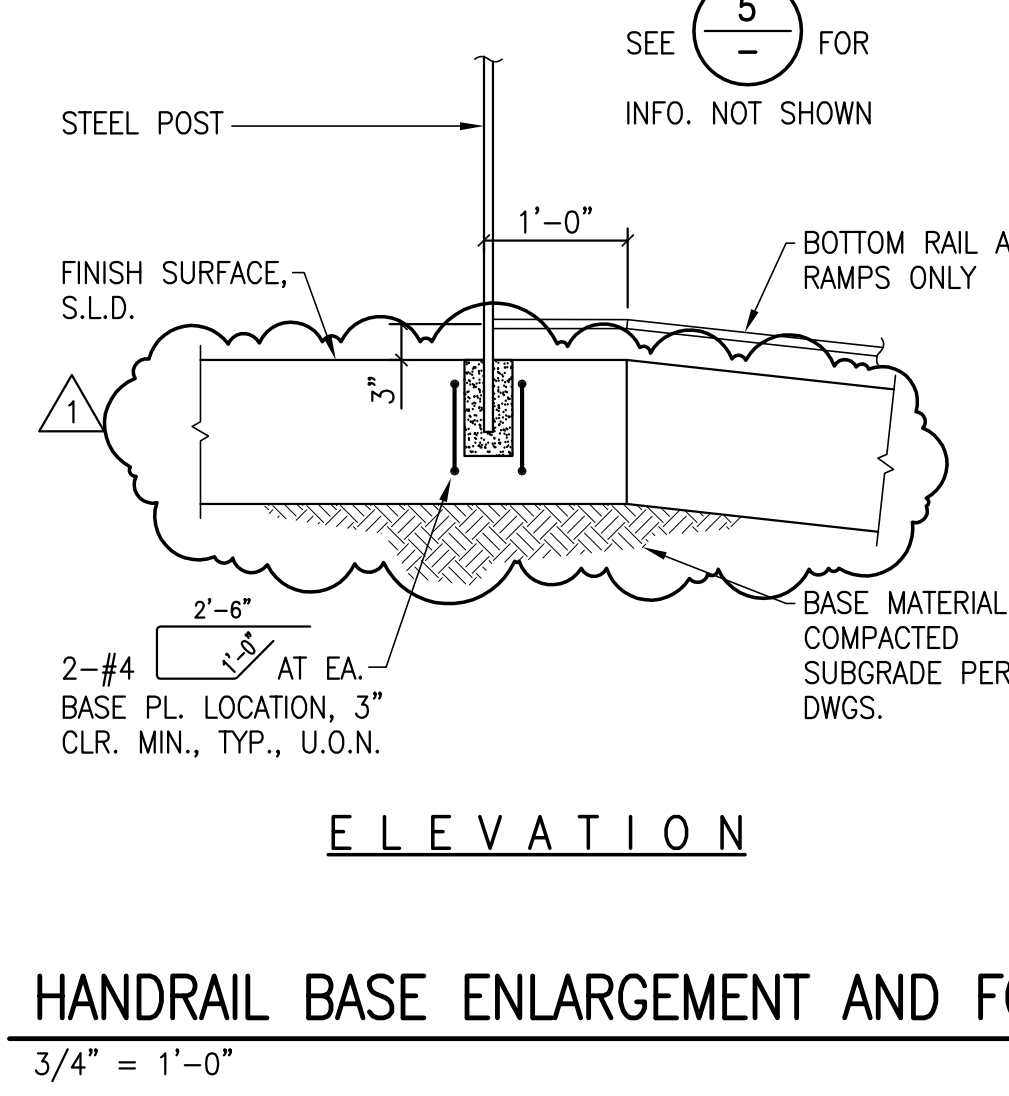


**HANDRAIL BASE ENLARGEMENT AND FOOTING DETAIL TYPE 2** 9  
3/4" = 1'-0" S0.2

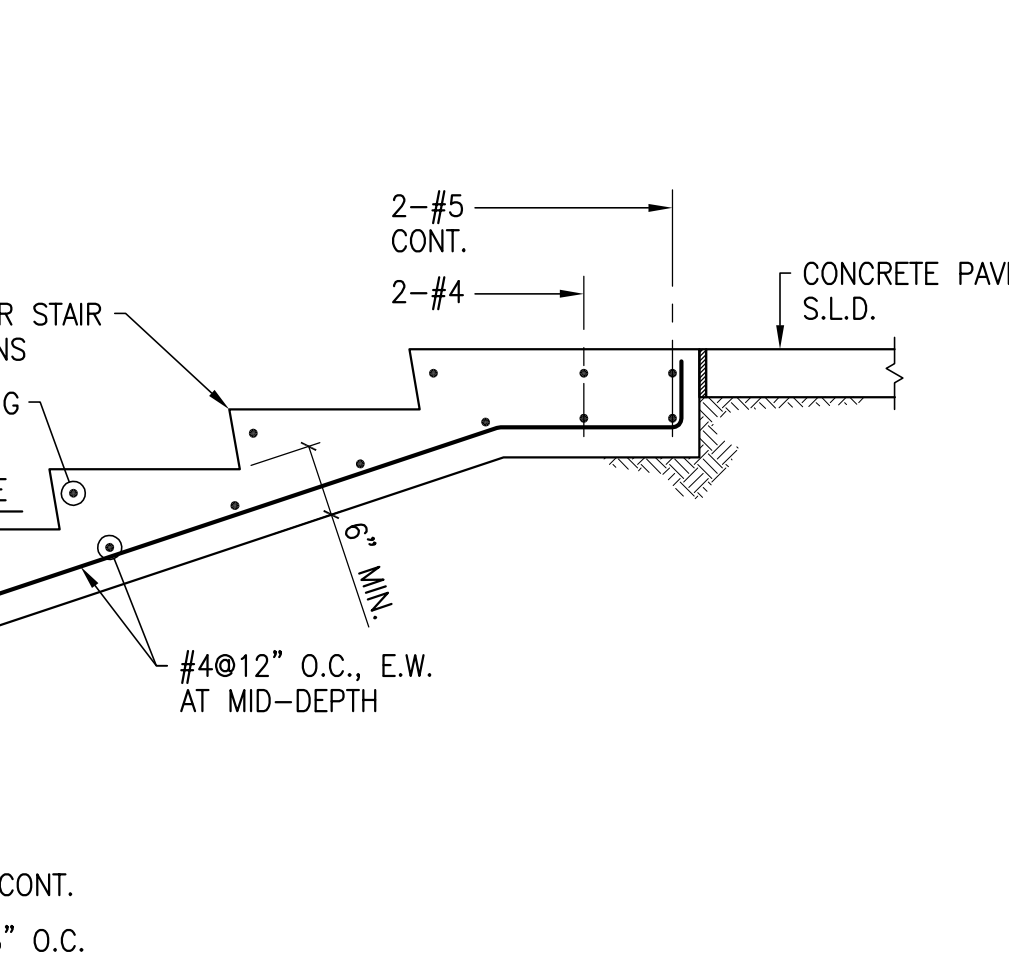


**BASE PL. ENLARGEMENT** 6  
3" = 1'-0" S0.2

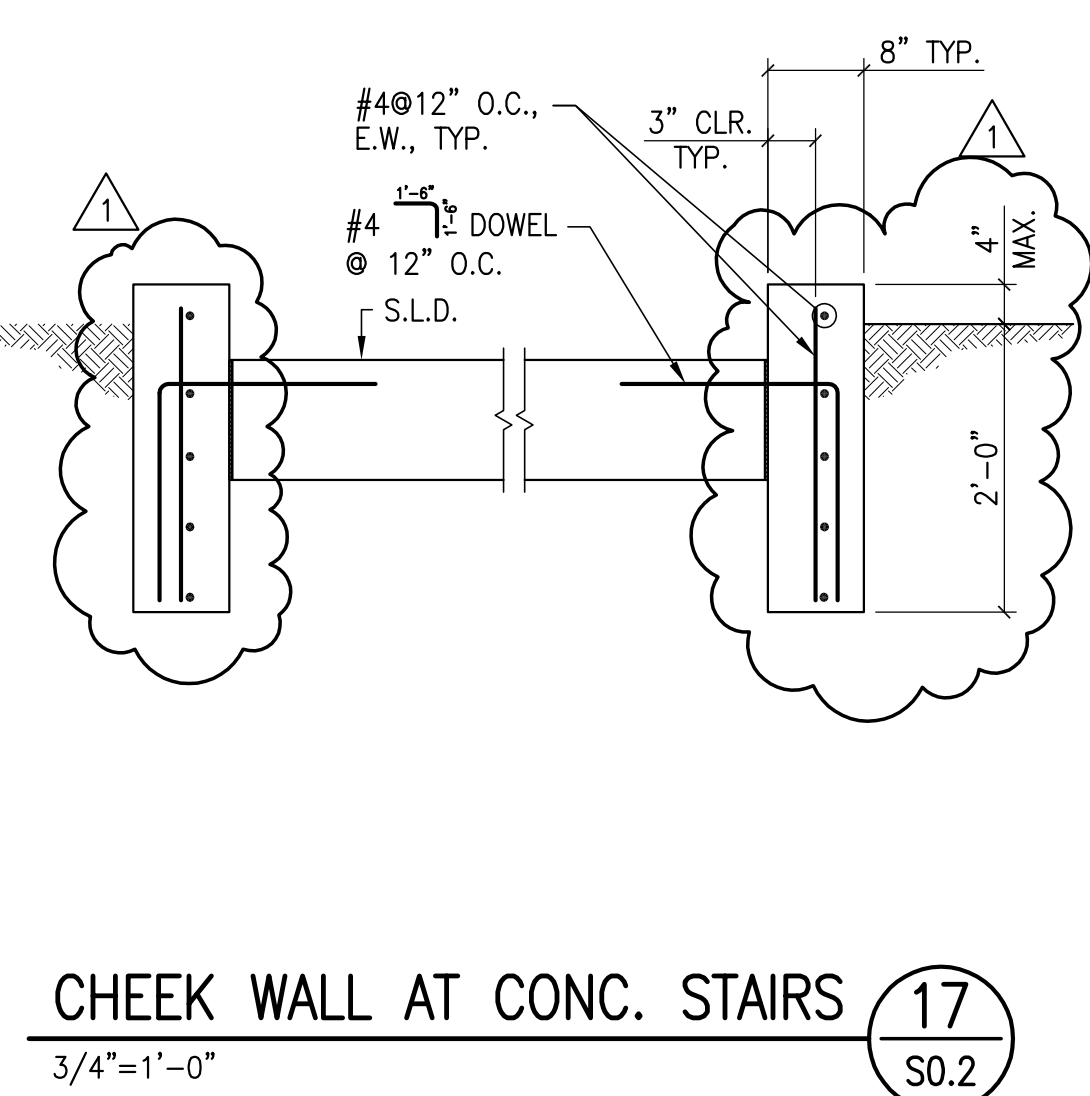


**CHEEK WALL AT CONC. STAIRS** 17  
3/4" = 1'-0" S0.2

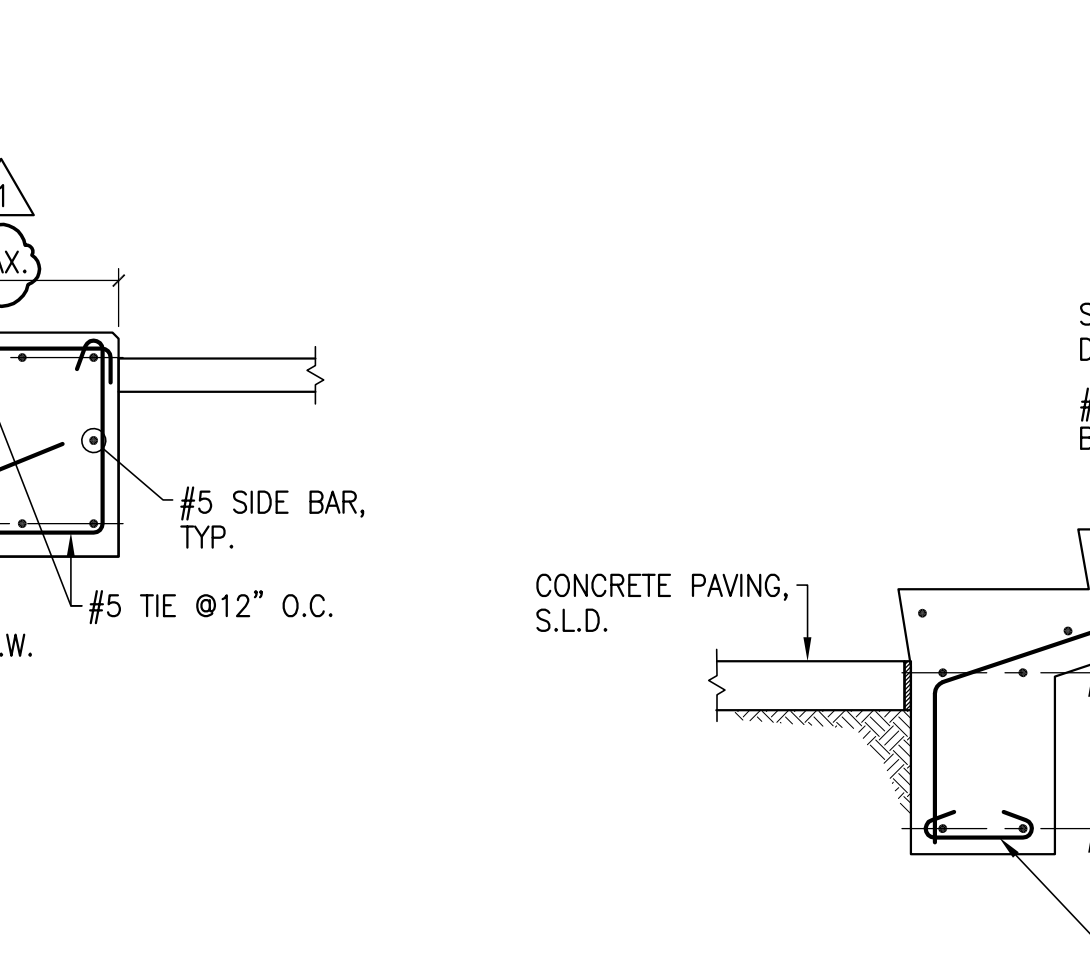


**CONCRETE STAIRS** 14  
3/4" = 1'-0" S0.2

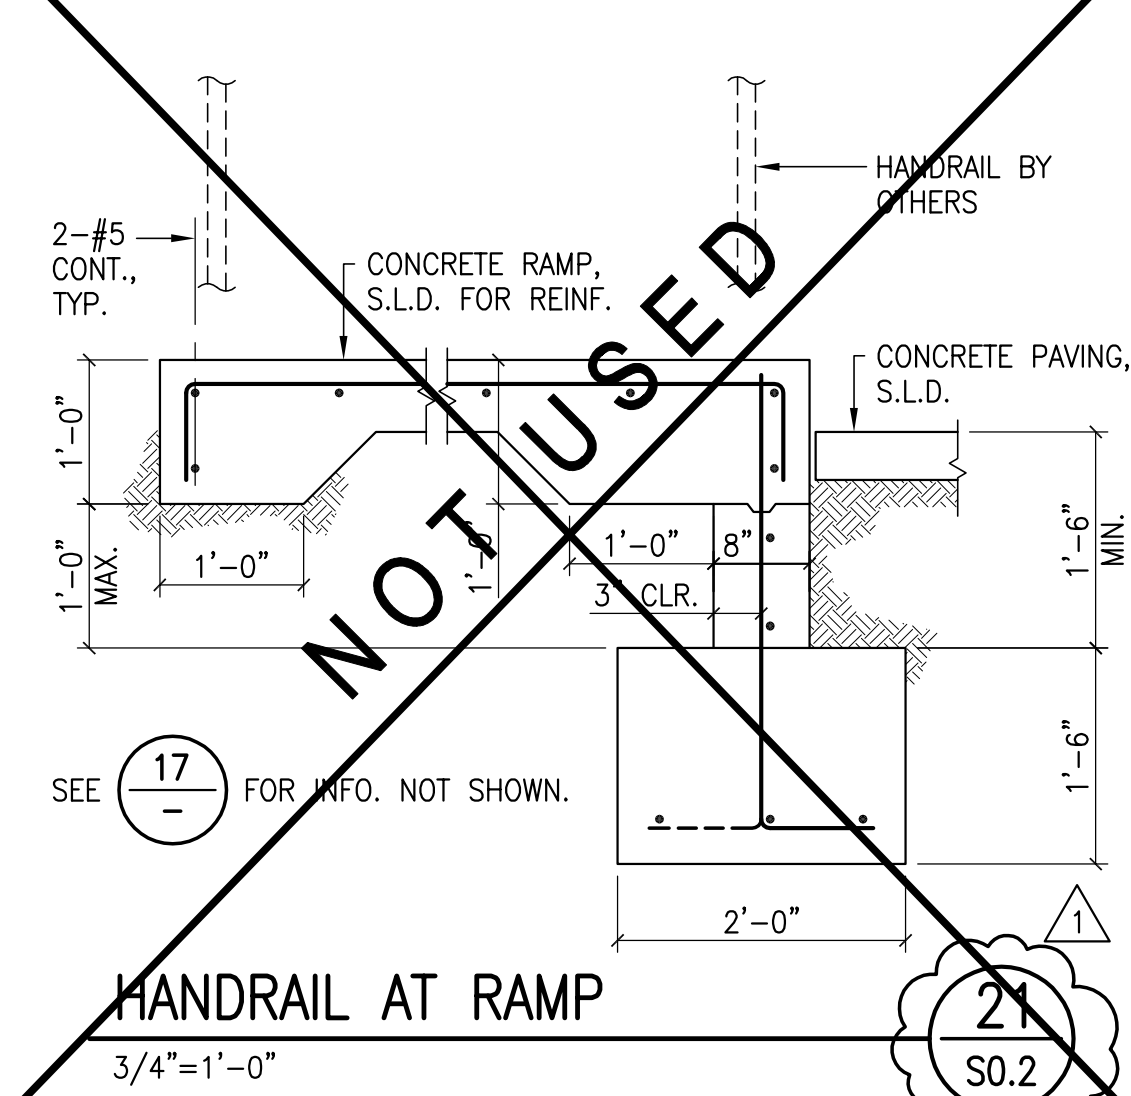


**HANDRAIL AT RAMP** 21  
3/4" = 1'-0" S0.2

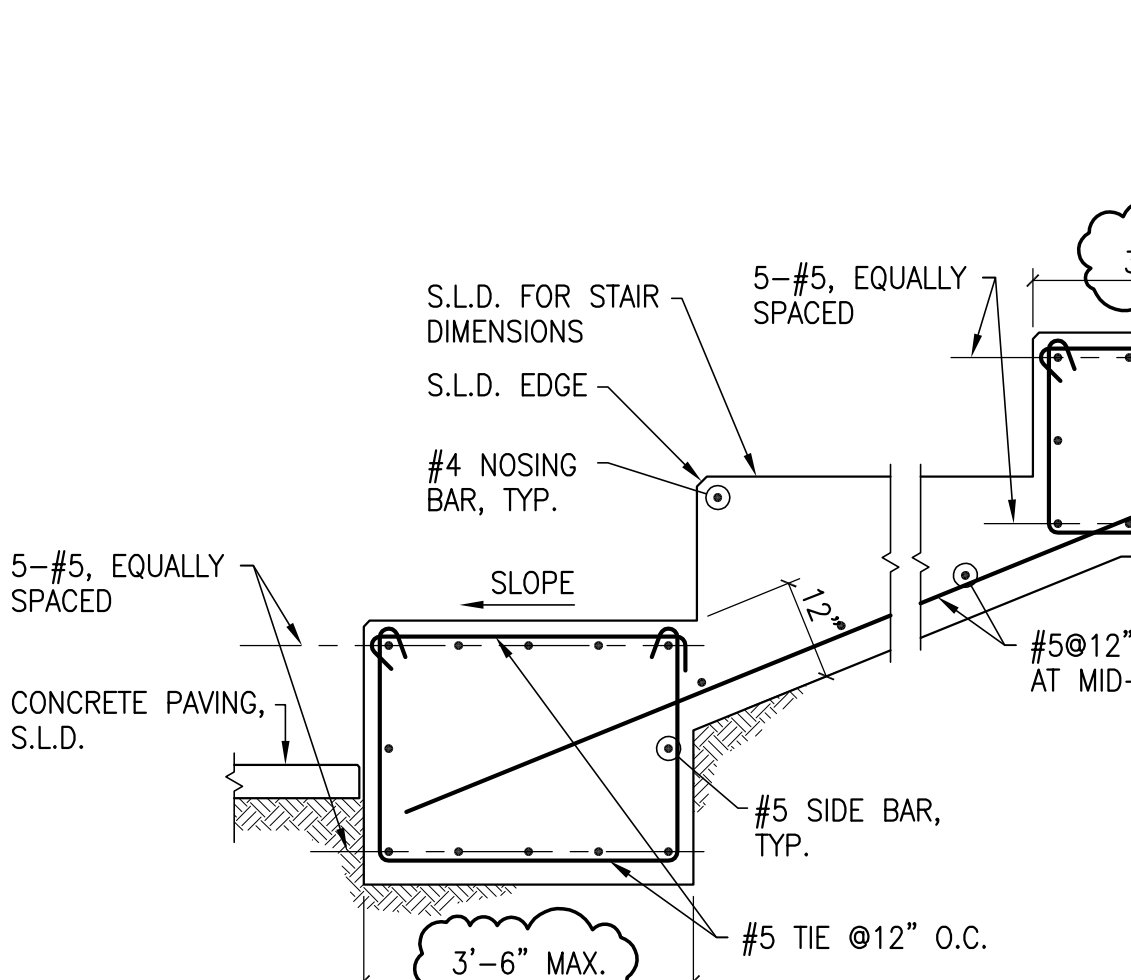


**CONCRETE RETAINING WALL TYPE 2** 18  
1/2" = 1'-0" S0.2

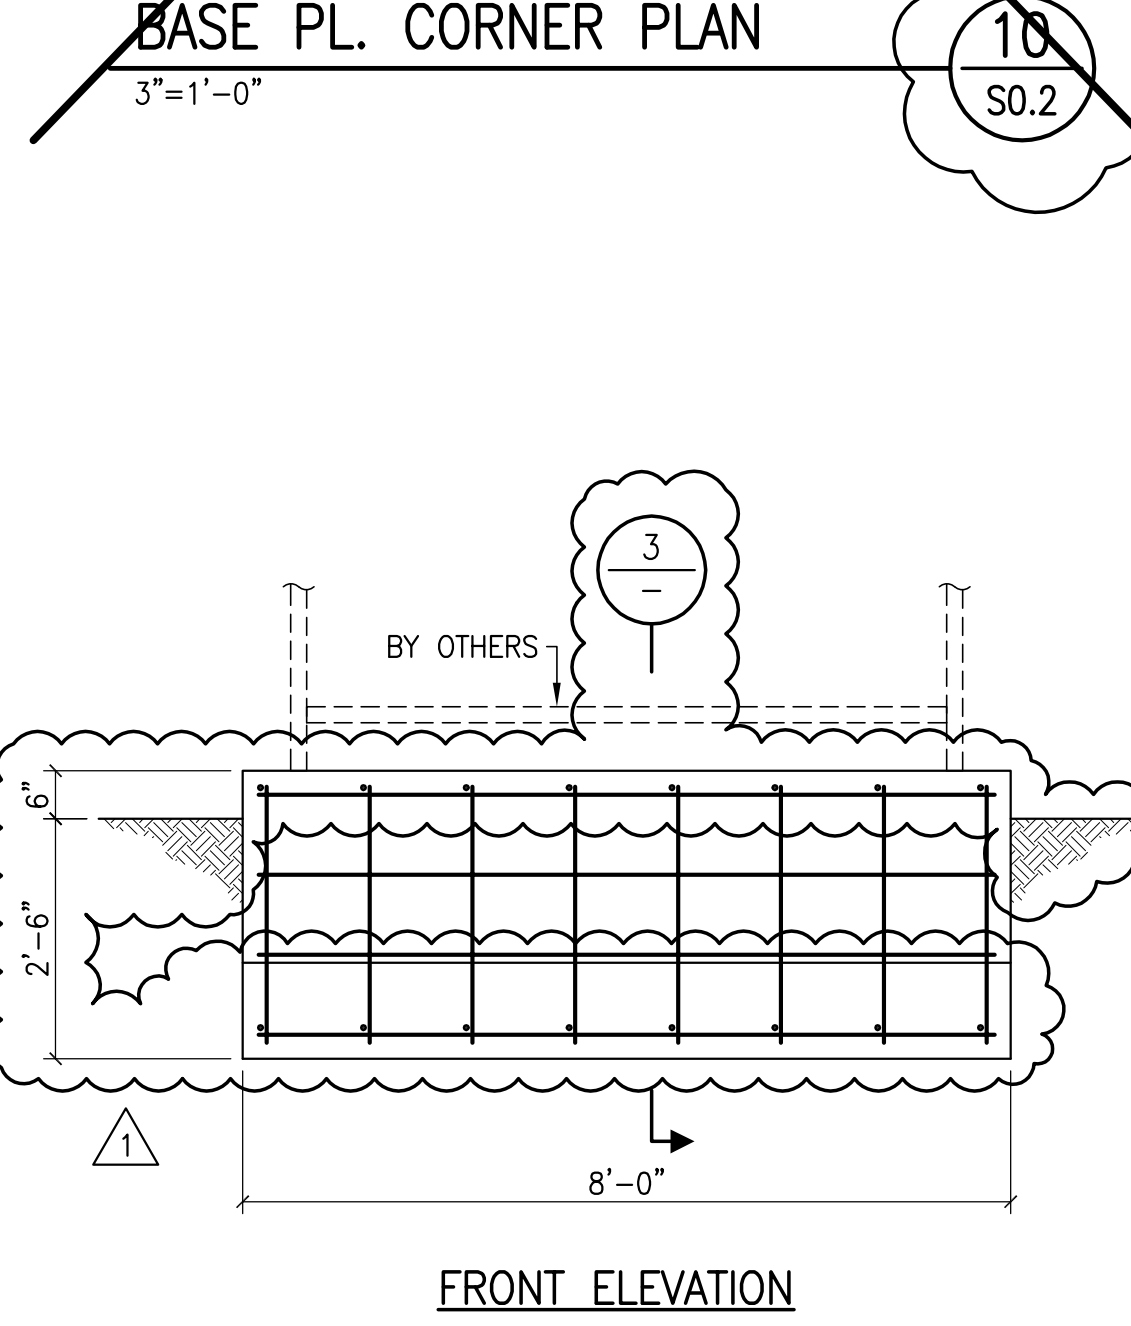


**TEACHING STATION BOARD** 11  
1/2" = 1'-0" S0.2

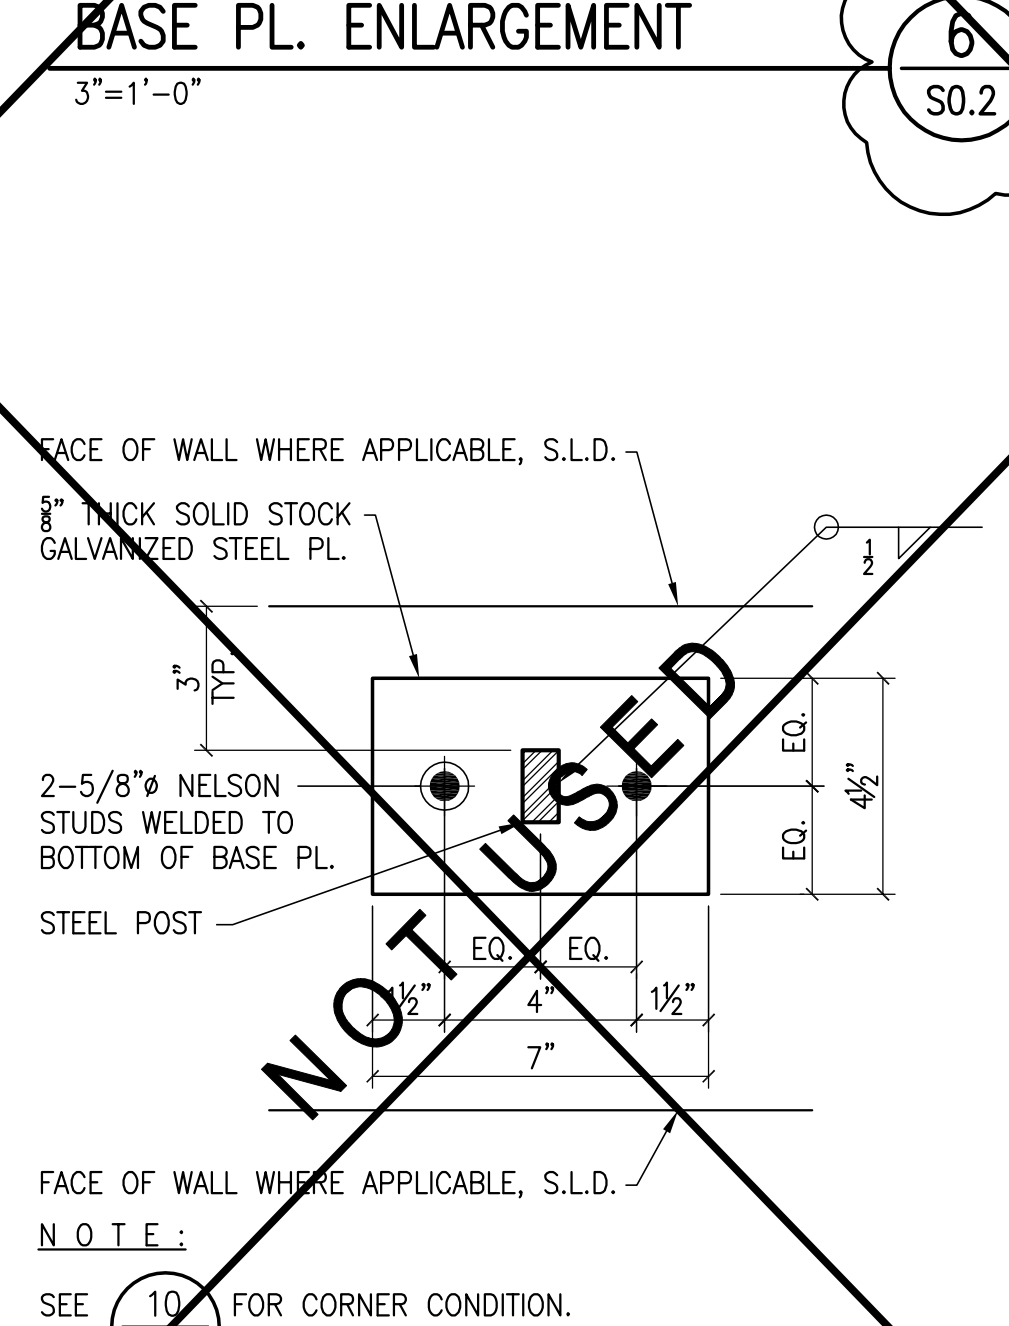


**BASE PL. PLAN ENLARGEMENT** 7  
3" = 1'-0" S0.2

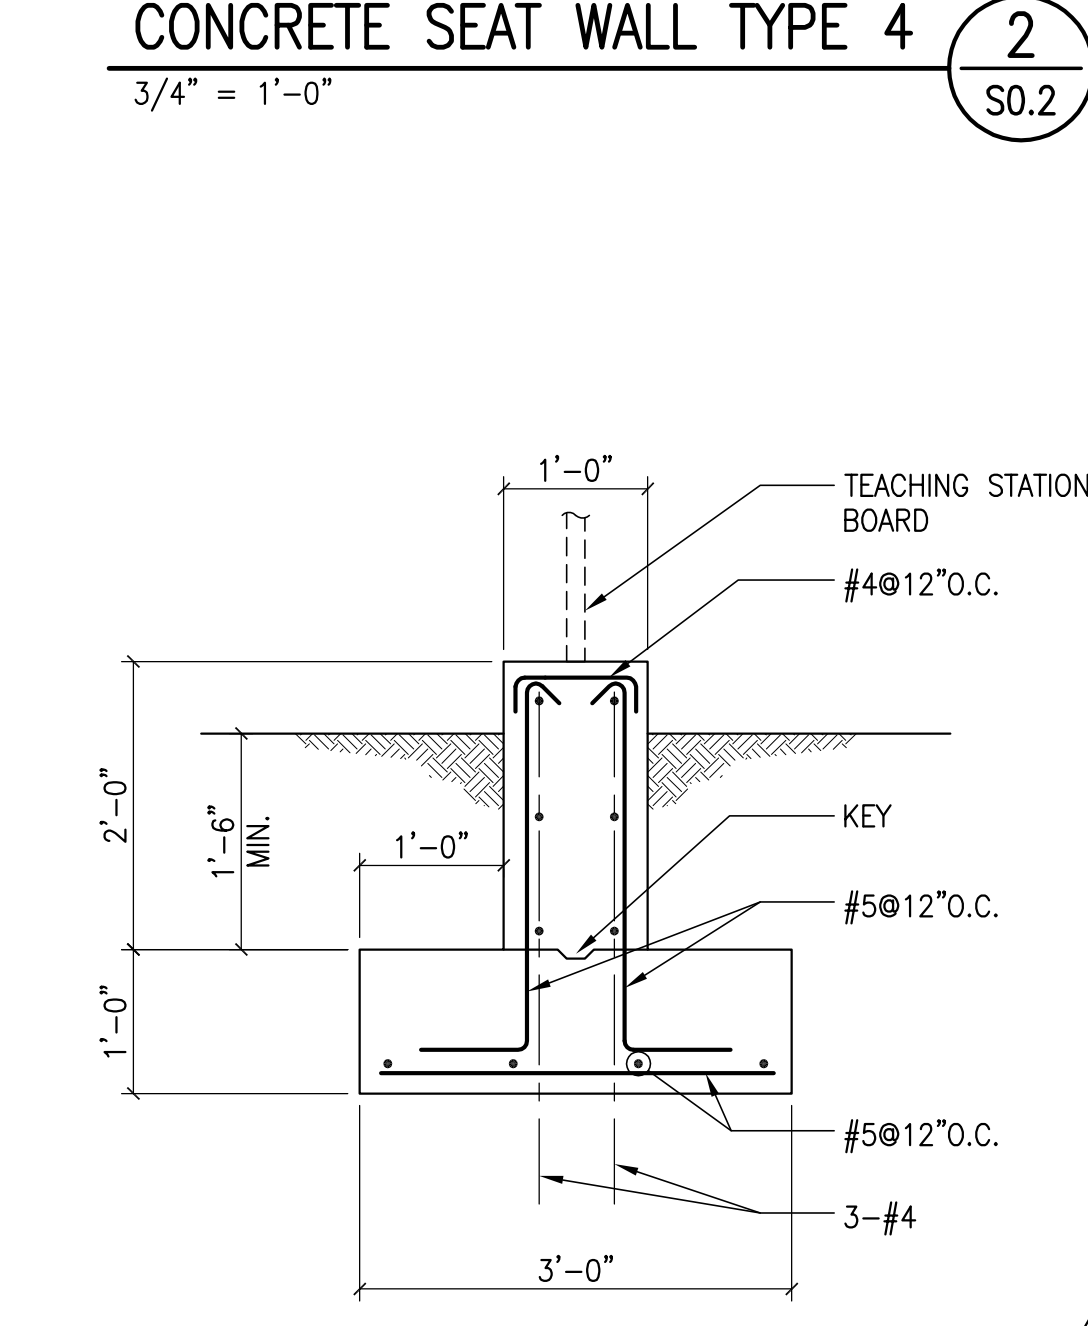


**SECTION** 3  
3/4" = 1'-0" S0.2

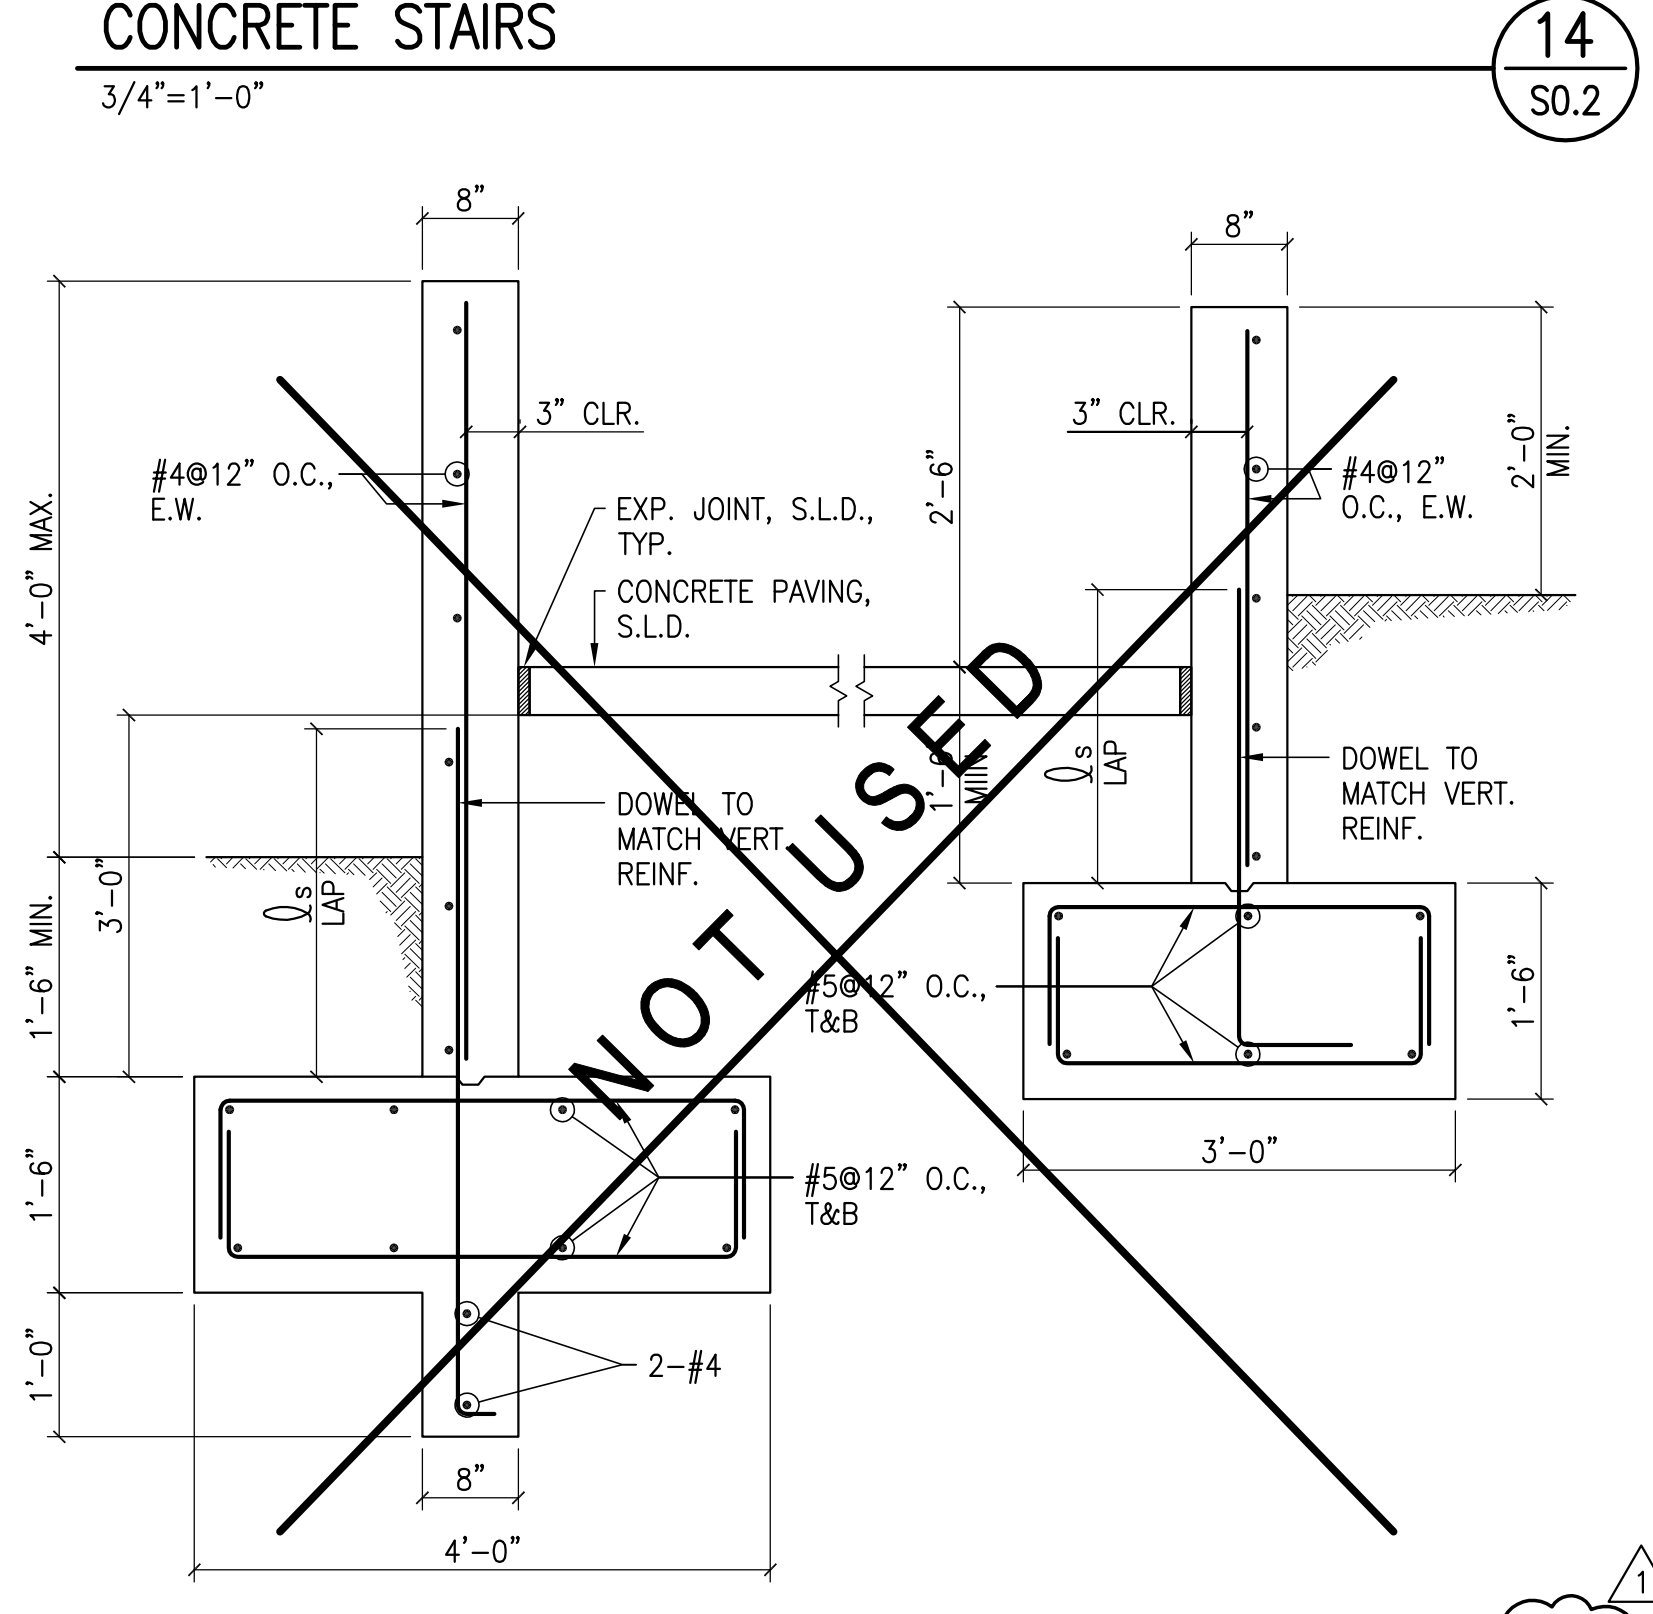


**SECTION AT 10N STAIRS** 15  
3/4" = 1'-0" S0.2

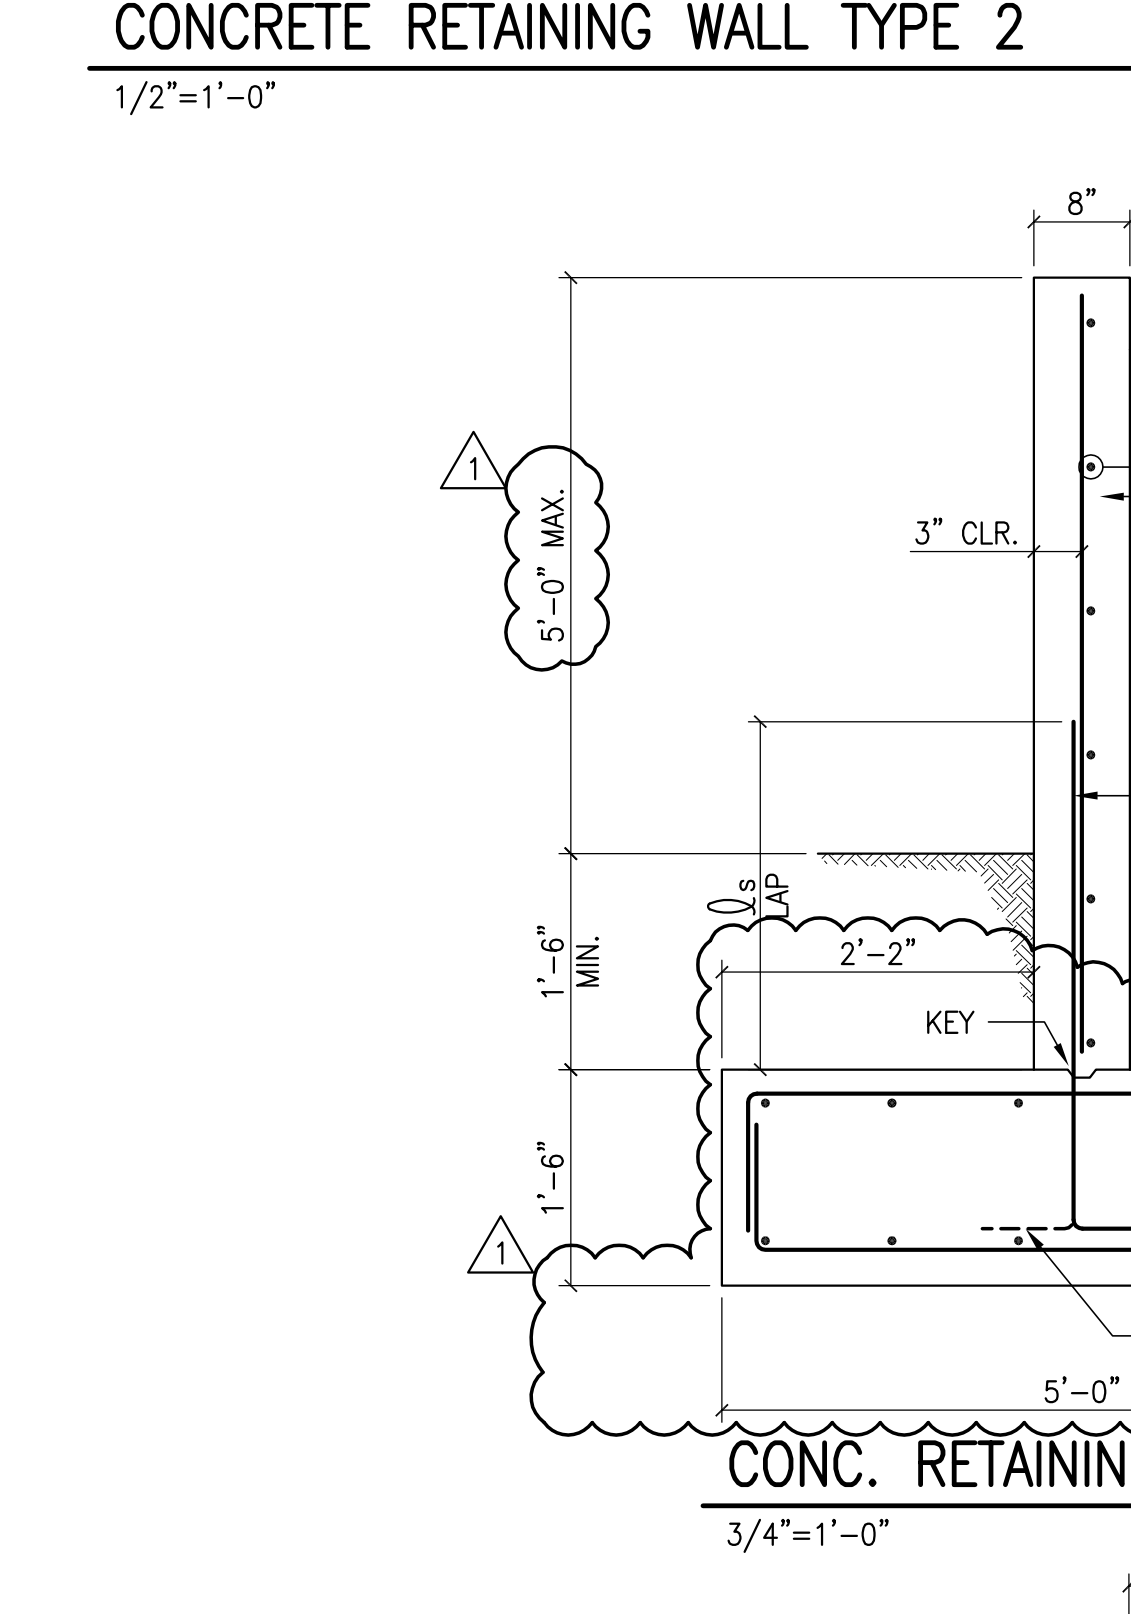


**CONC. RETAINING WALL TYPE 4** 19  
3/4" = 1'-0" S0.2

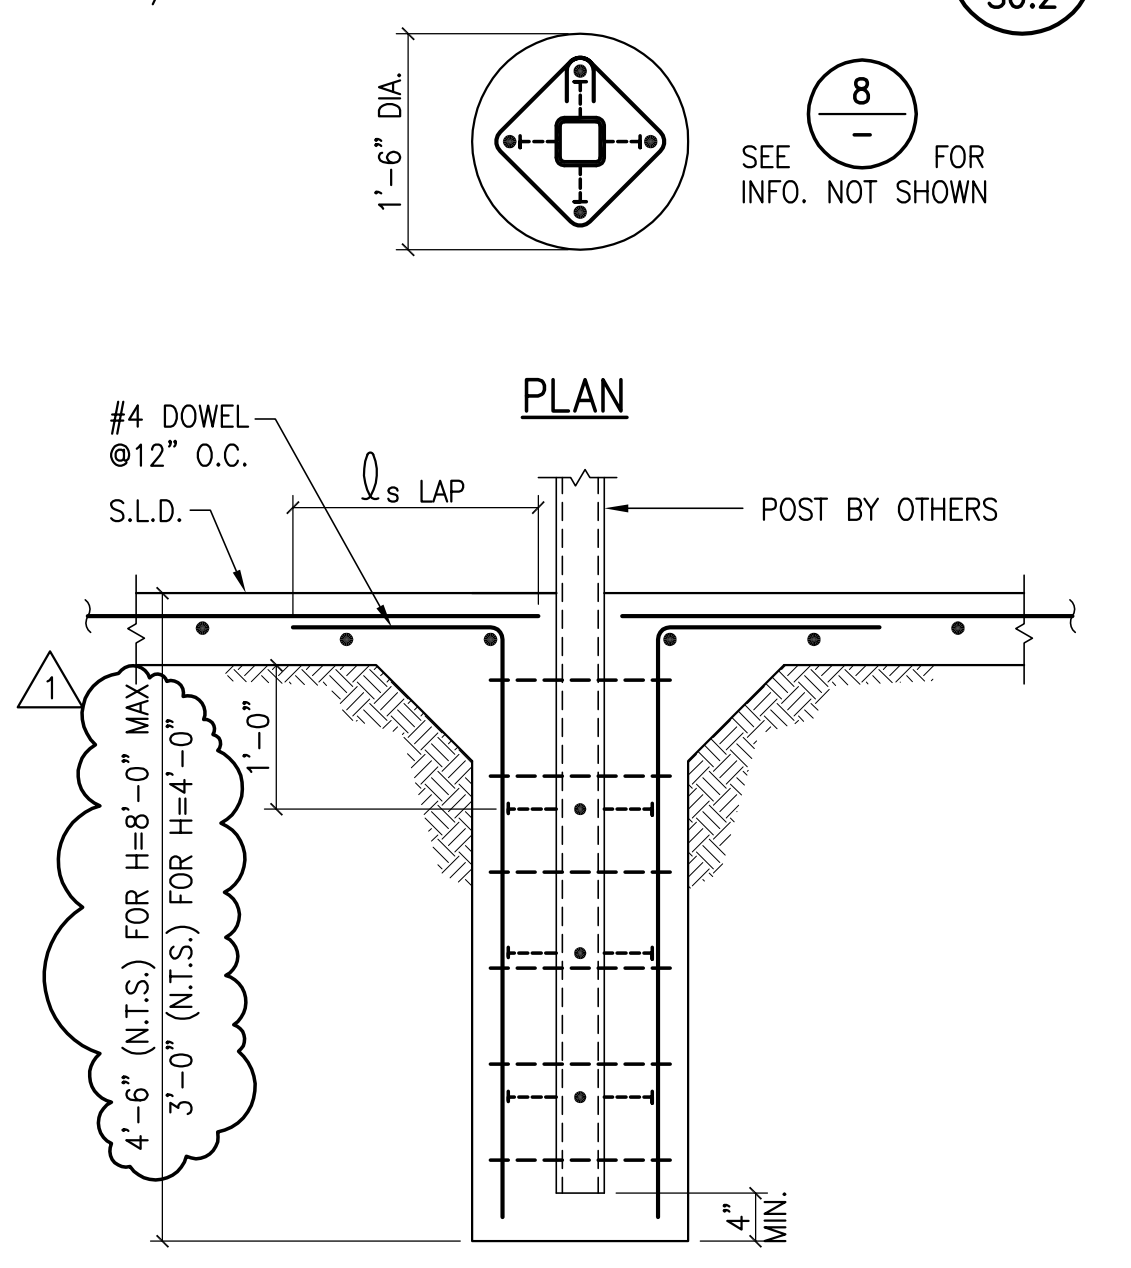


**T.S. FENCE POST FOOTING** 12  
3/4" = 1'-0" S0.2

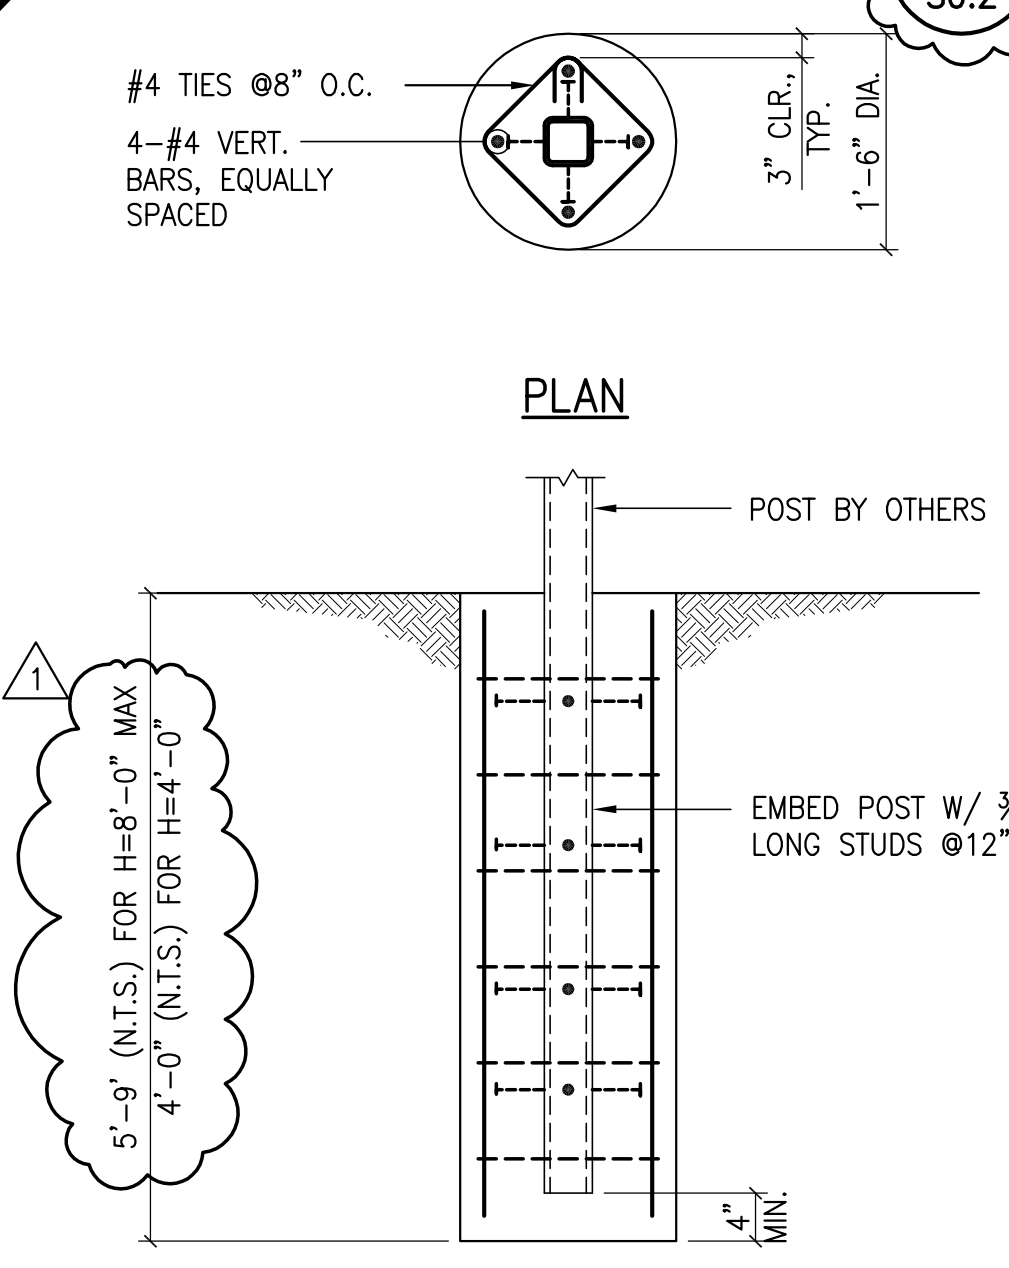


**T.S. PEDESTRIAN GATE POST FTG.** 8  
3/4" = 1'-0" S0.2

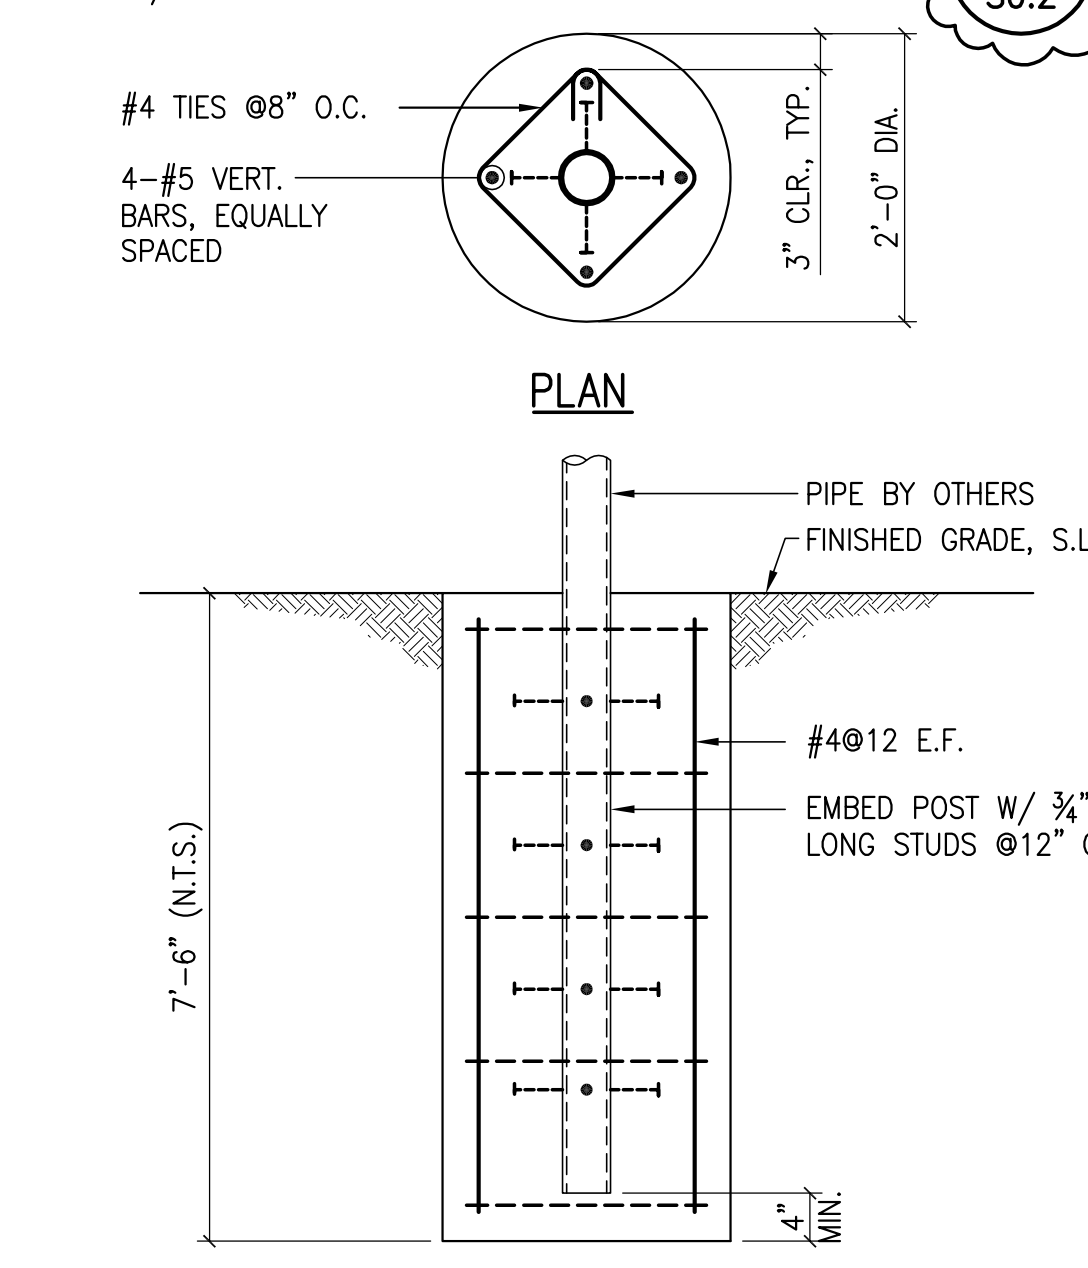

**FLAG POLE BASE DETAIL** 4  
3/4" = 1'-0" S0.2

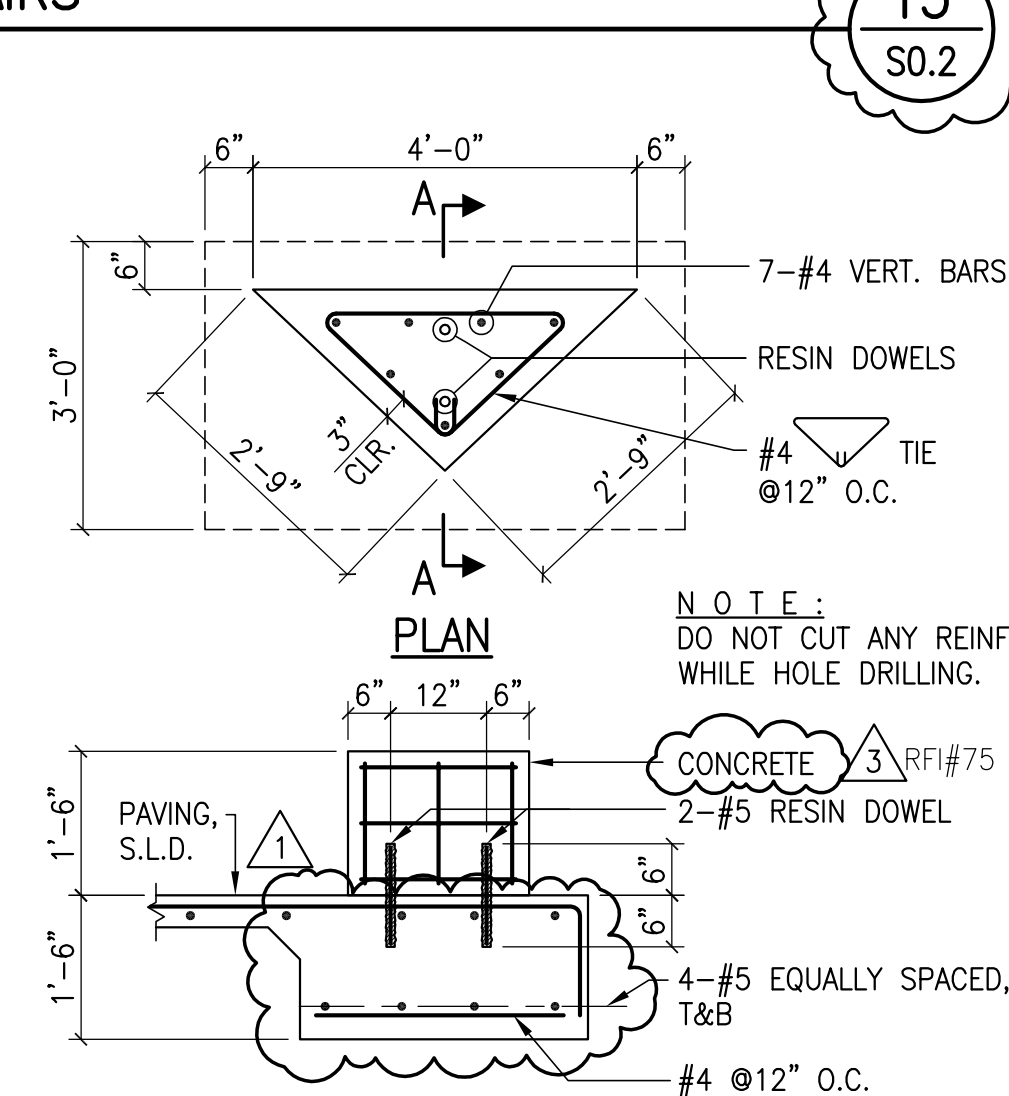

**PAVERS AT TRIANGULAR SEAT** 16  
1/2" = 1'-0" S0.2

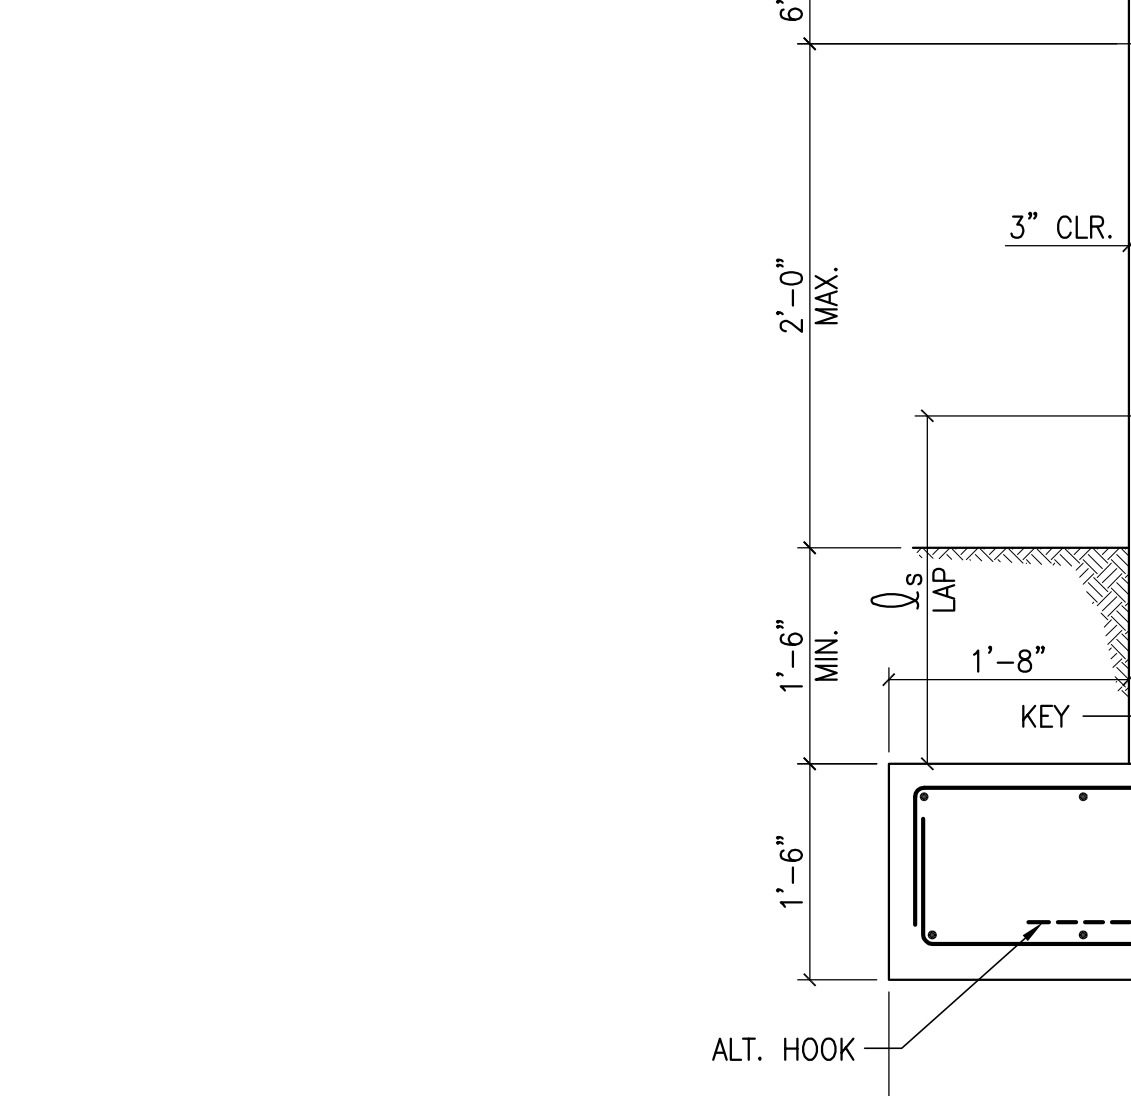

**2'-0" RETAINING WALL** 20  
3/4" = 1'-0" S0.2