




20 19 18 17 16 15 14 13 12 11 10 9 8 7 6 5 4 3 2 1

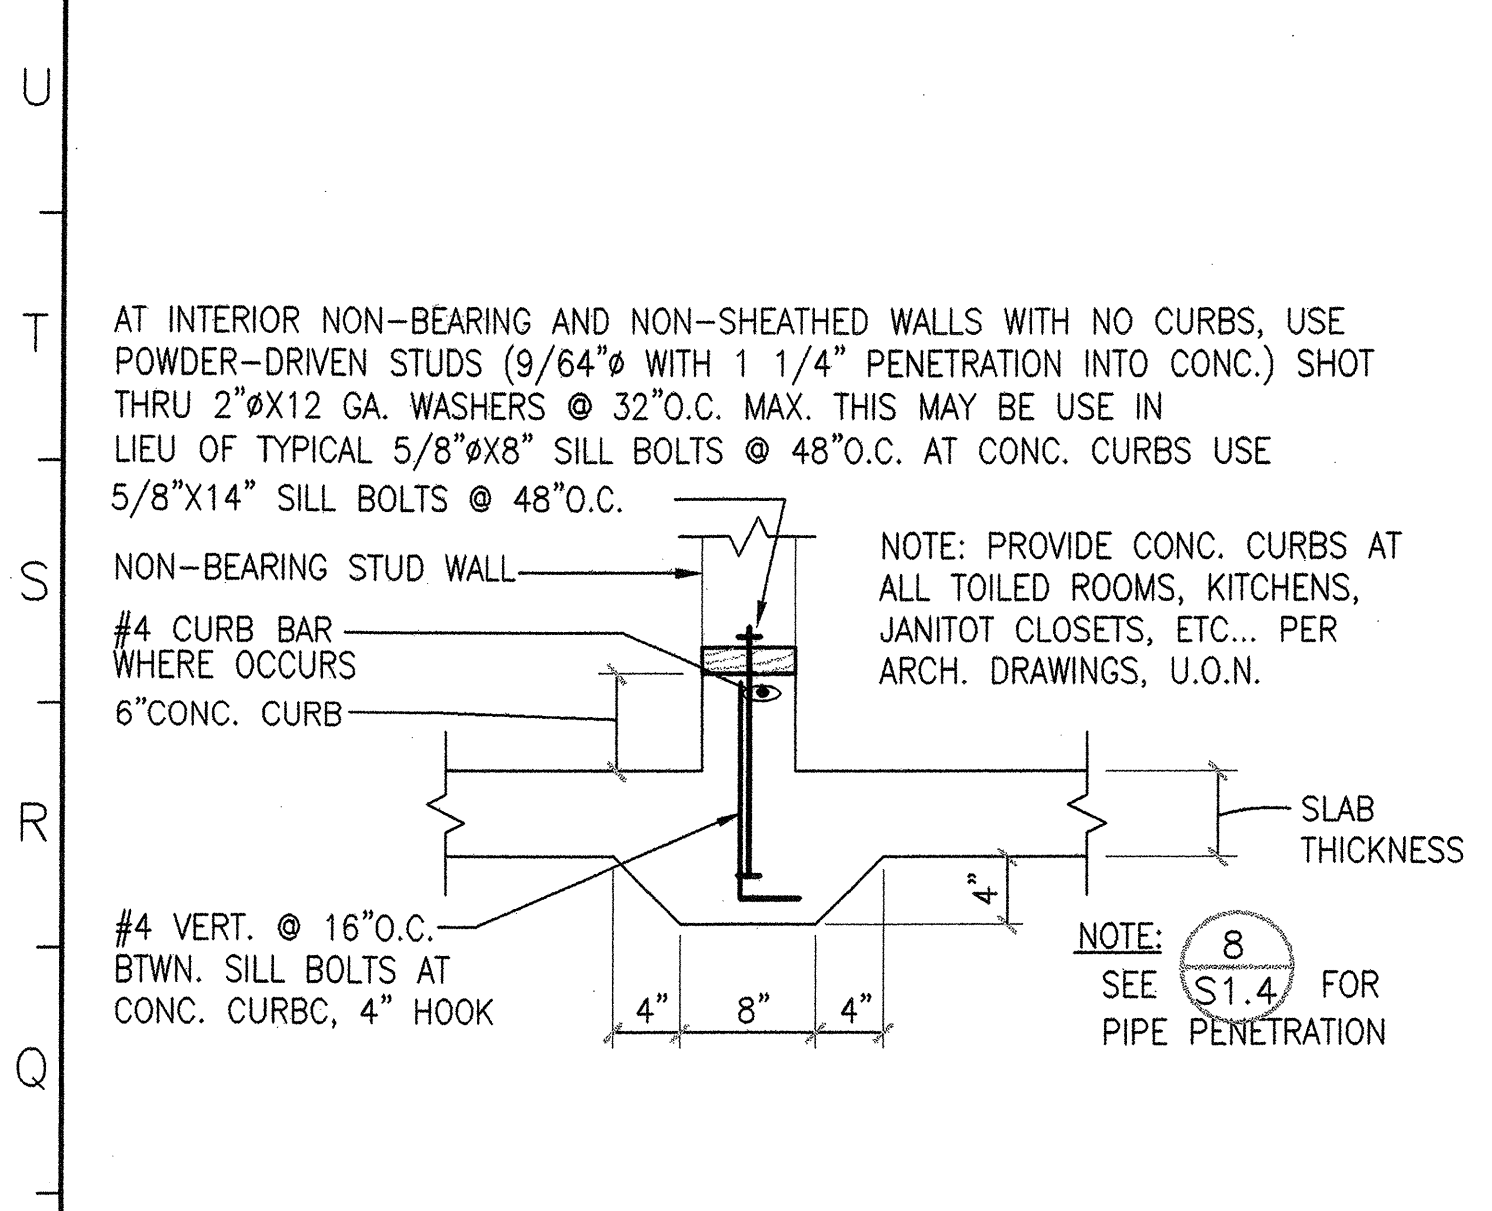


9 INTERIOR CONC. CURB ON SLAB ON GRADE (NON-BEARING STUDS)
N.T.S.

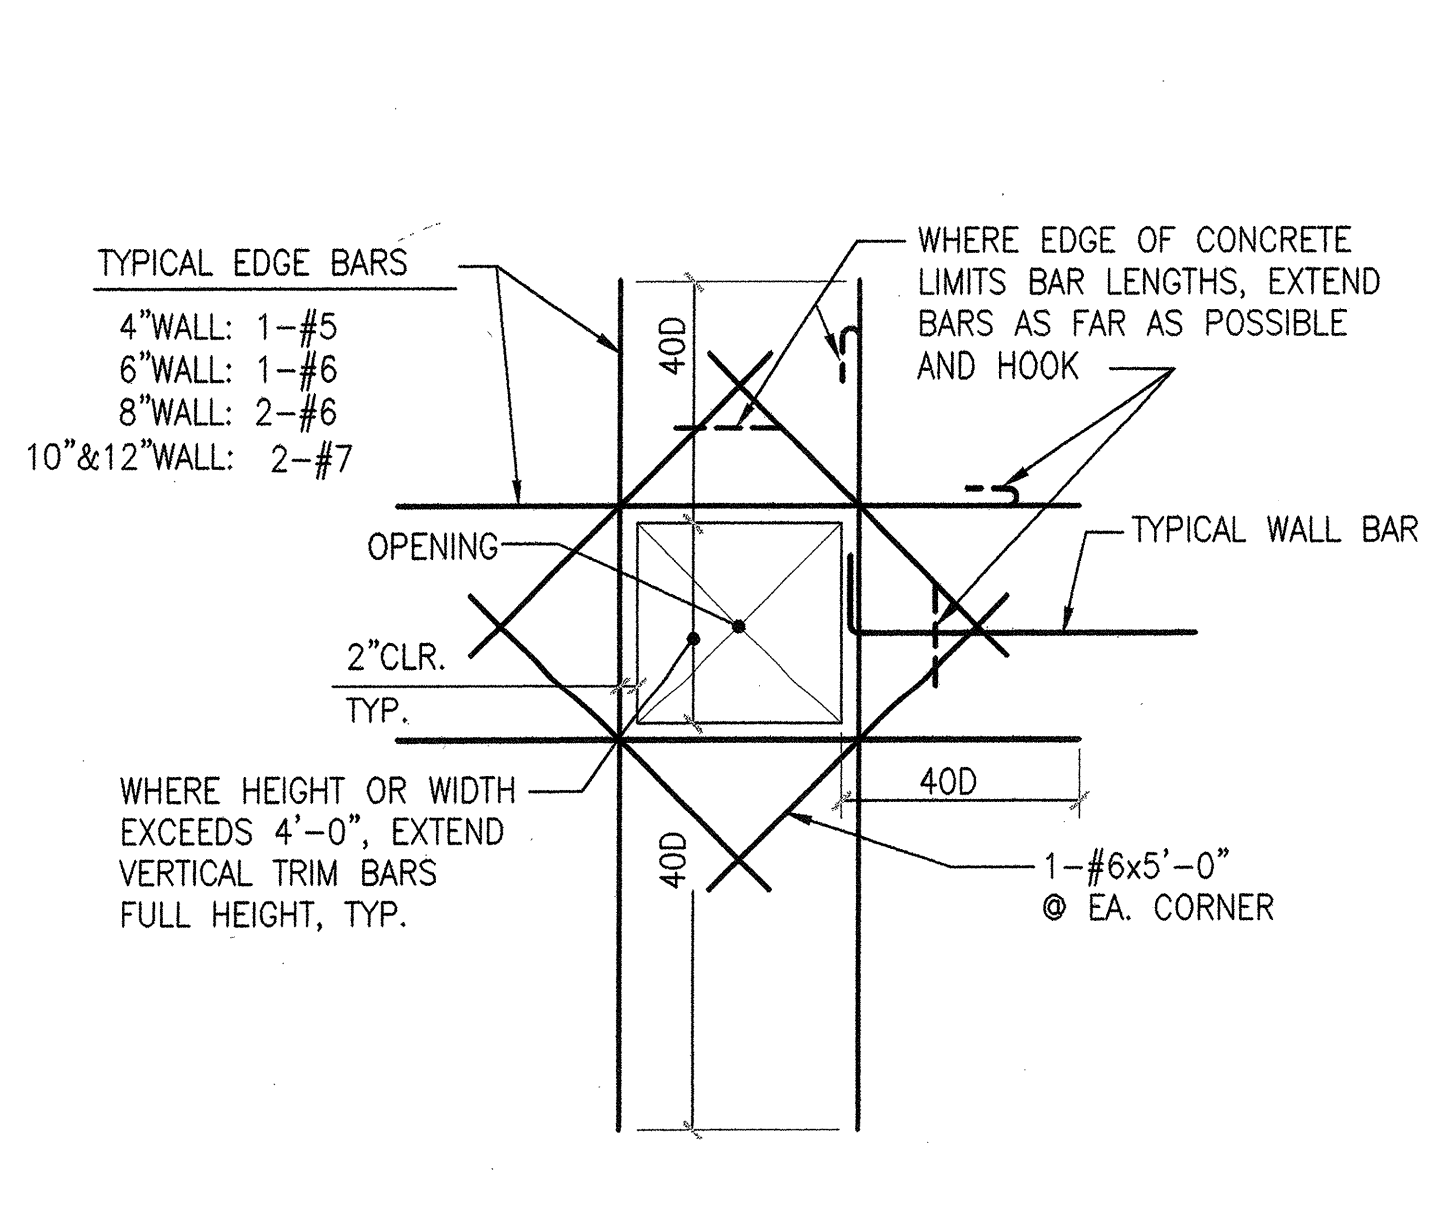


6 TYP. REINF. IN CONCRETE WALL OPENING
N.T.S. UNLESS OTHERWISE NOTED ON OTHER STRUCTURAL DRAWINGS

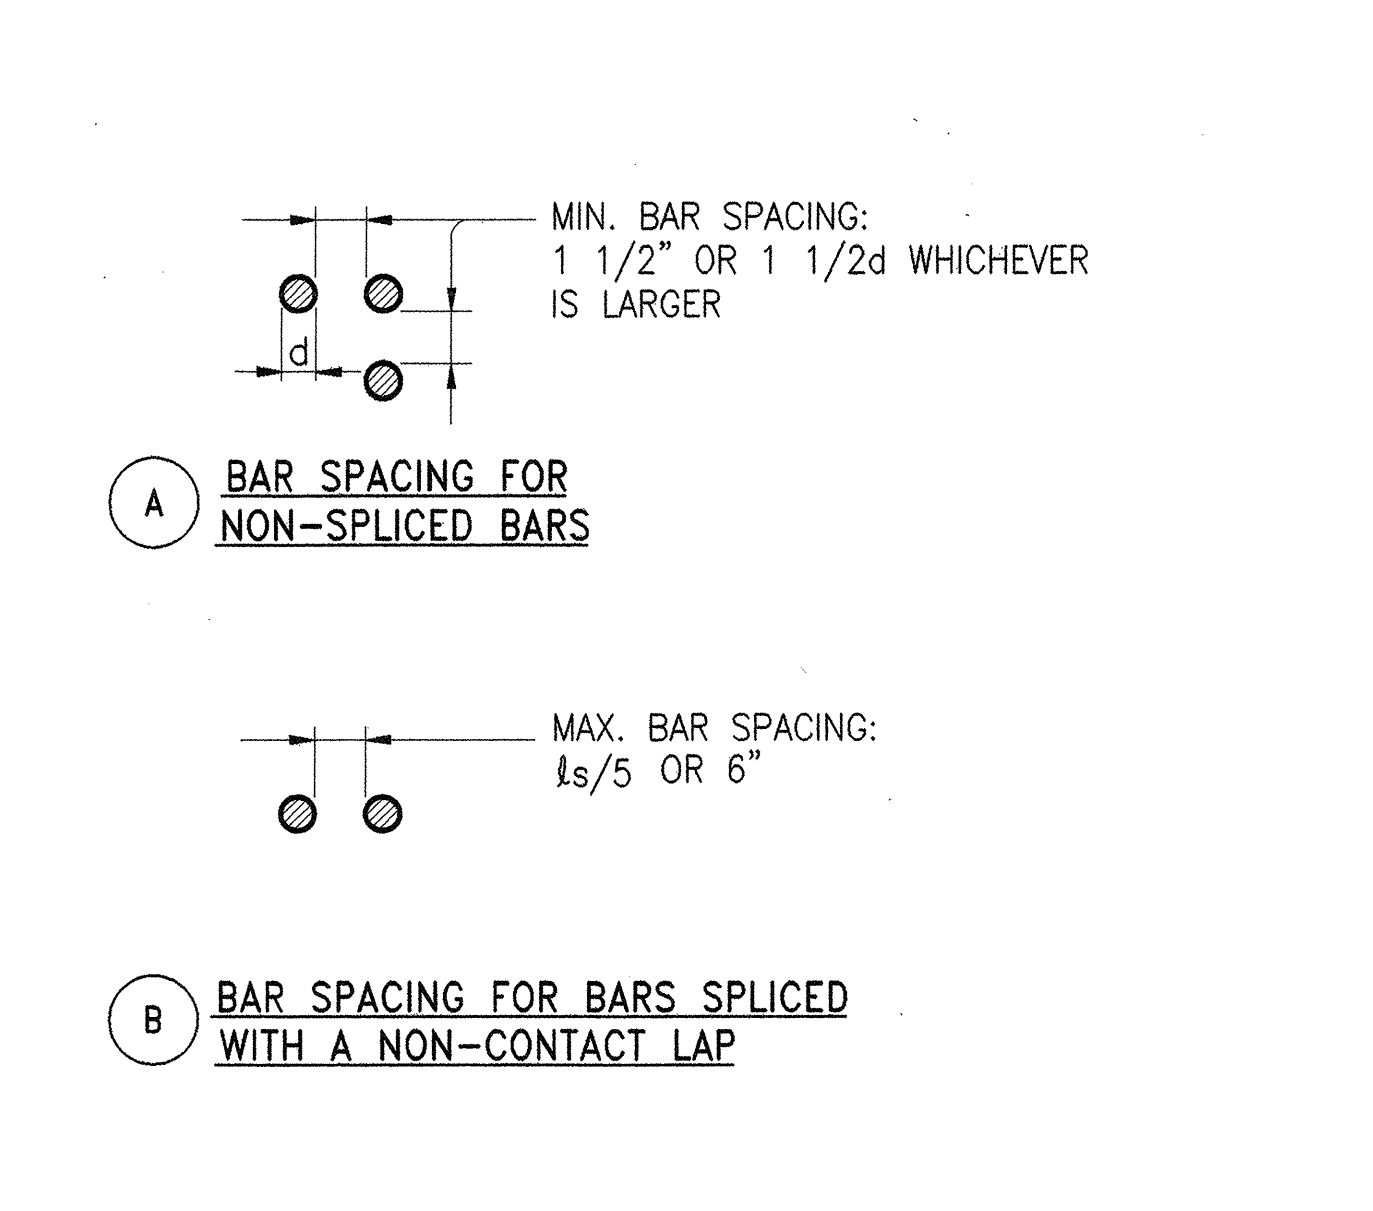


3 BAR SPACING IN CONCRETE
N.T.S.

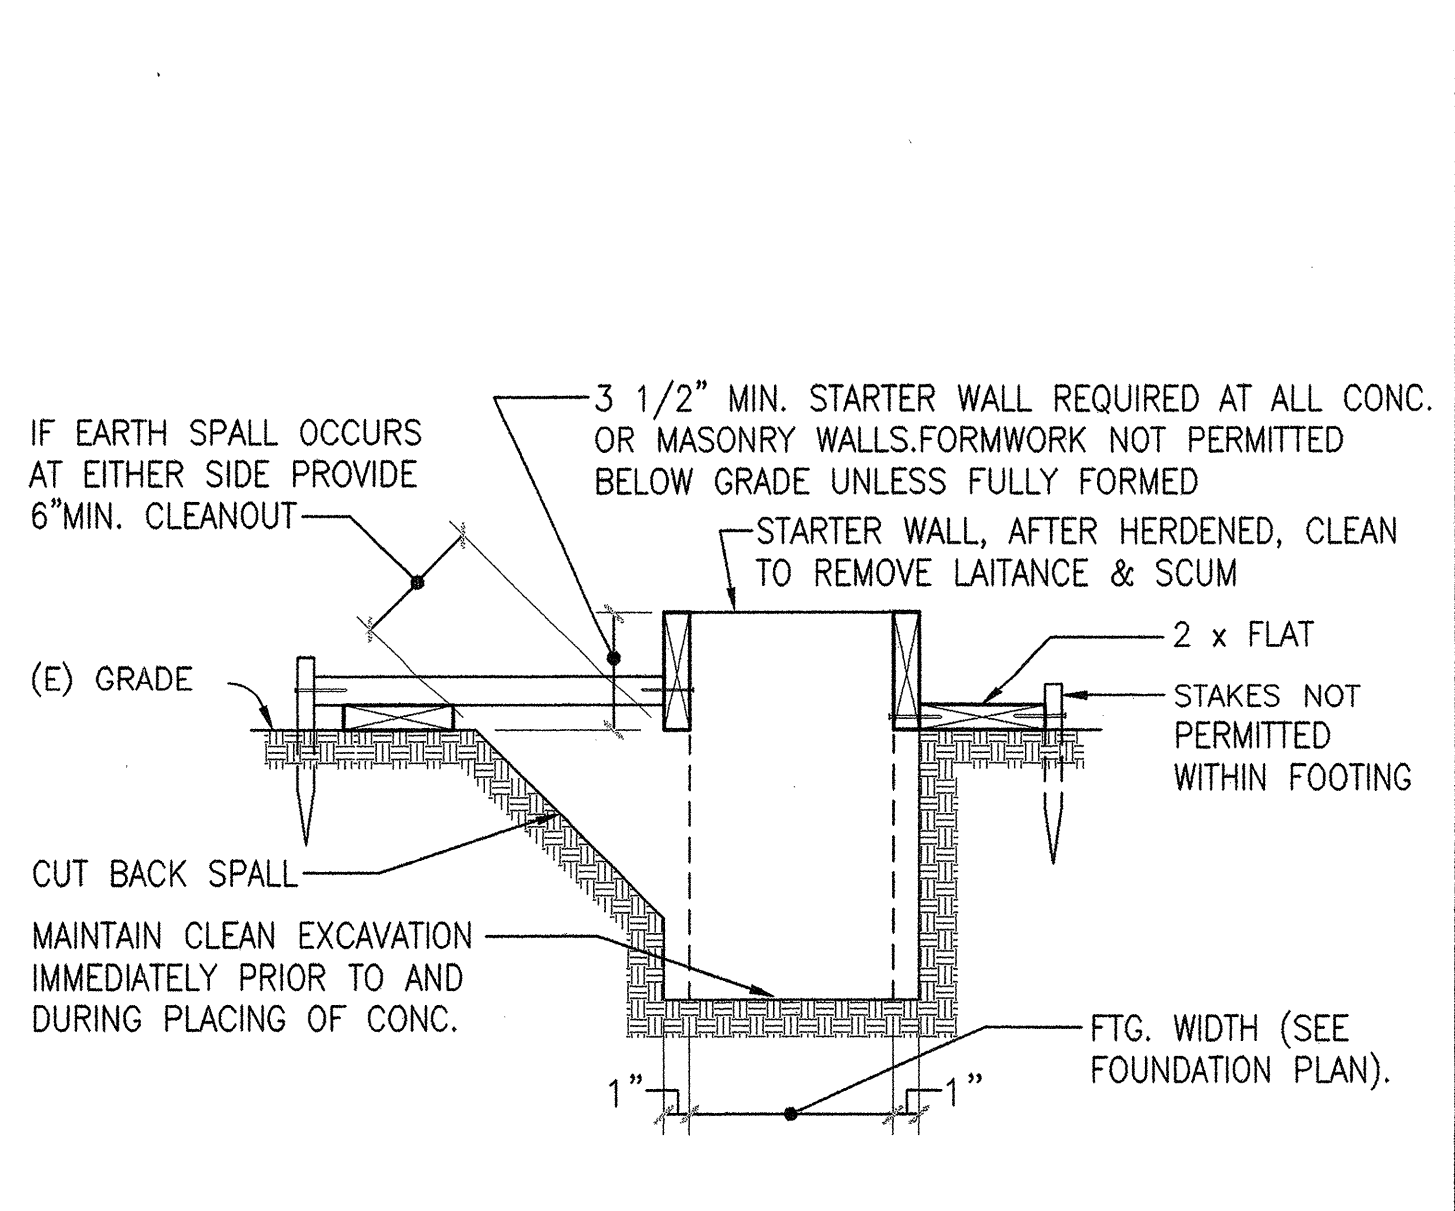


1 TRENCH FOOTING DETAIL
N.T.S. MINIMUM FORMWORK APPLICABLE WHERE SIDE FORMS CAN BE OMITTED, & APPROVED BY THE ARCHITECT.

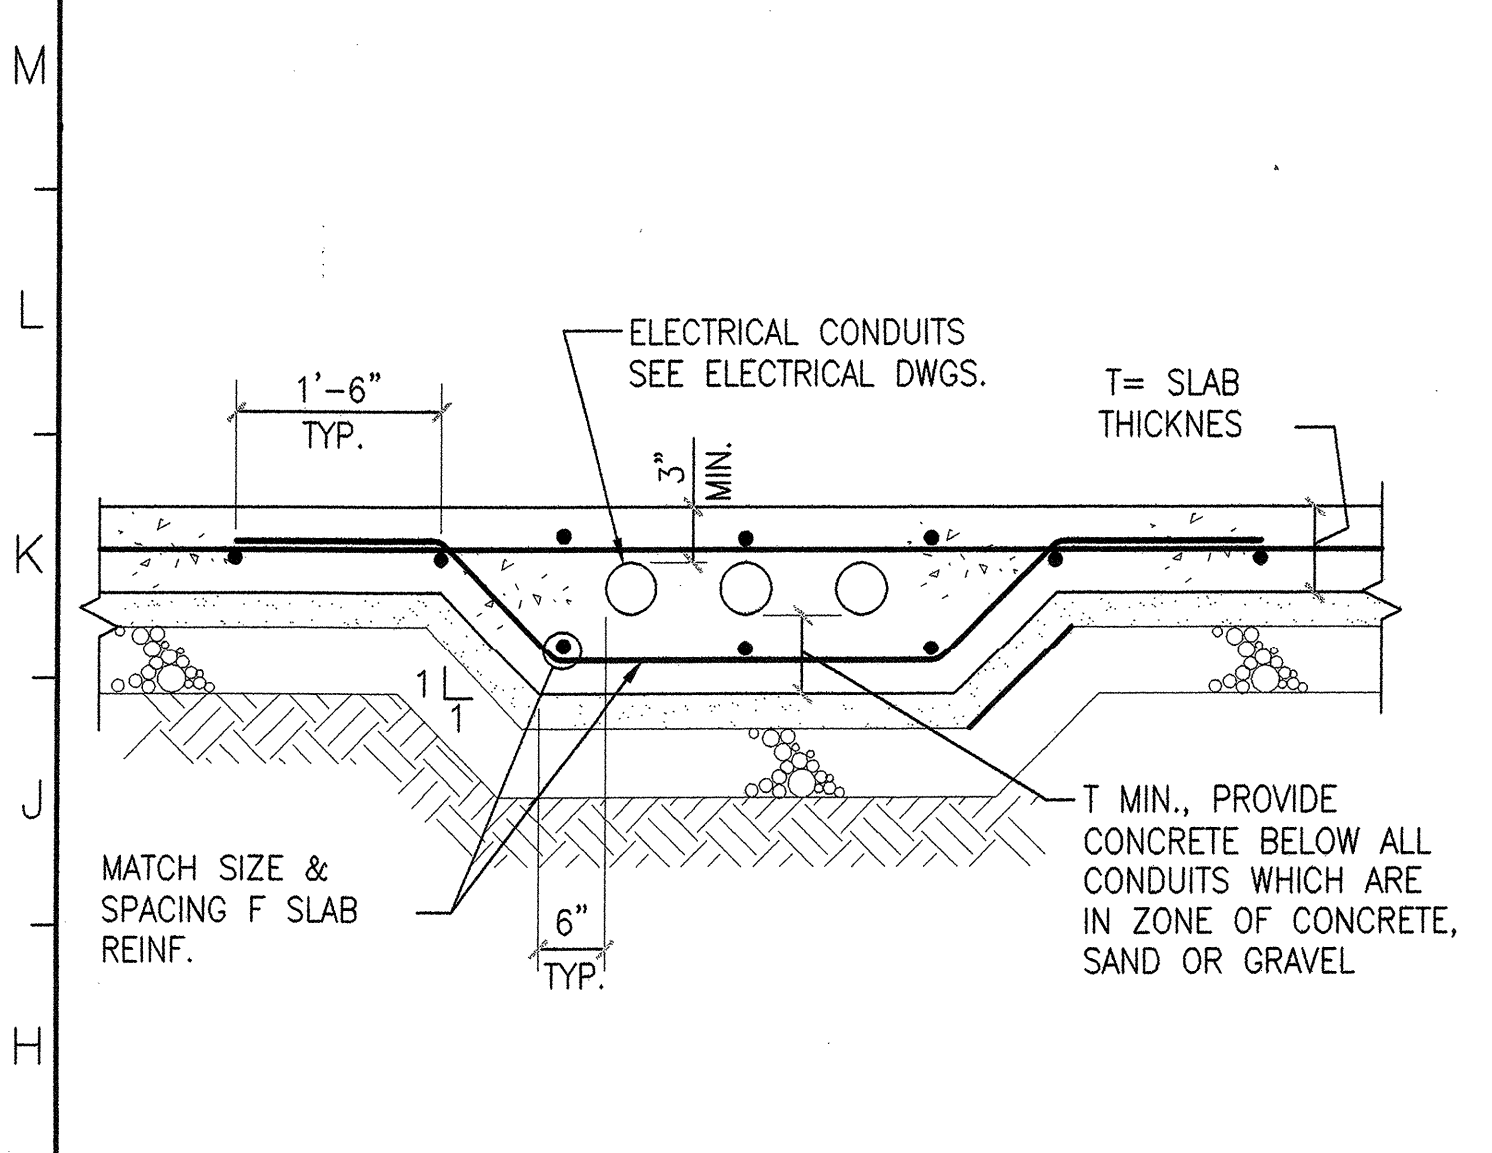


10 TYPICAL ELECTRICAL CONDUIT IN SLAB ON GRADE
N.T.S.

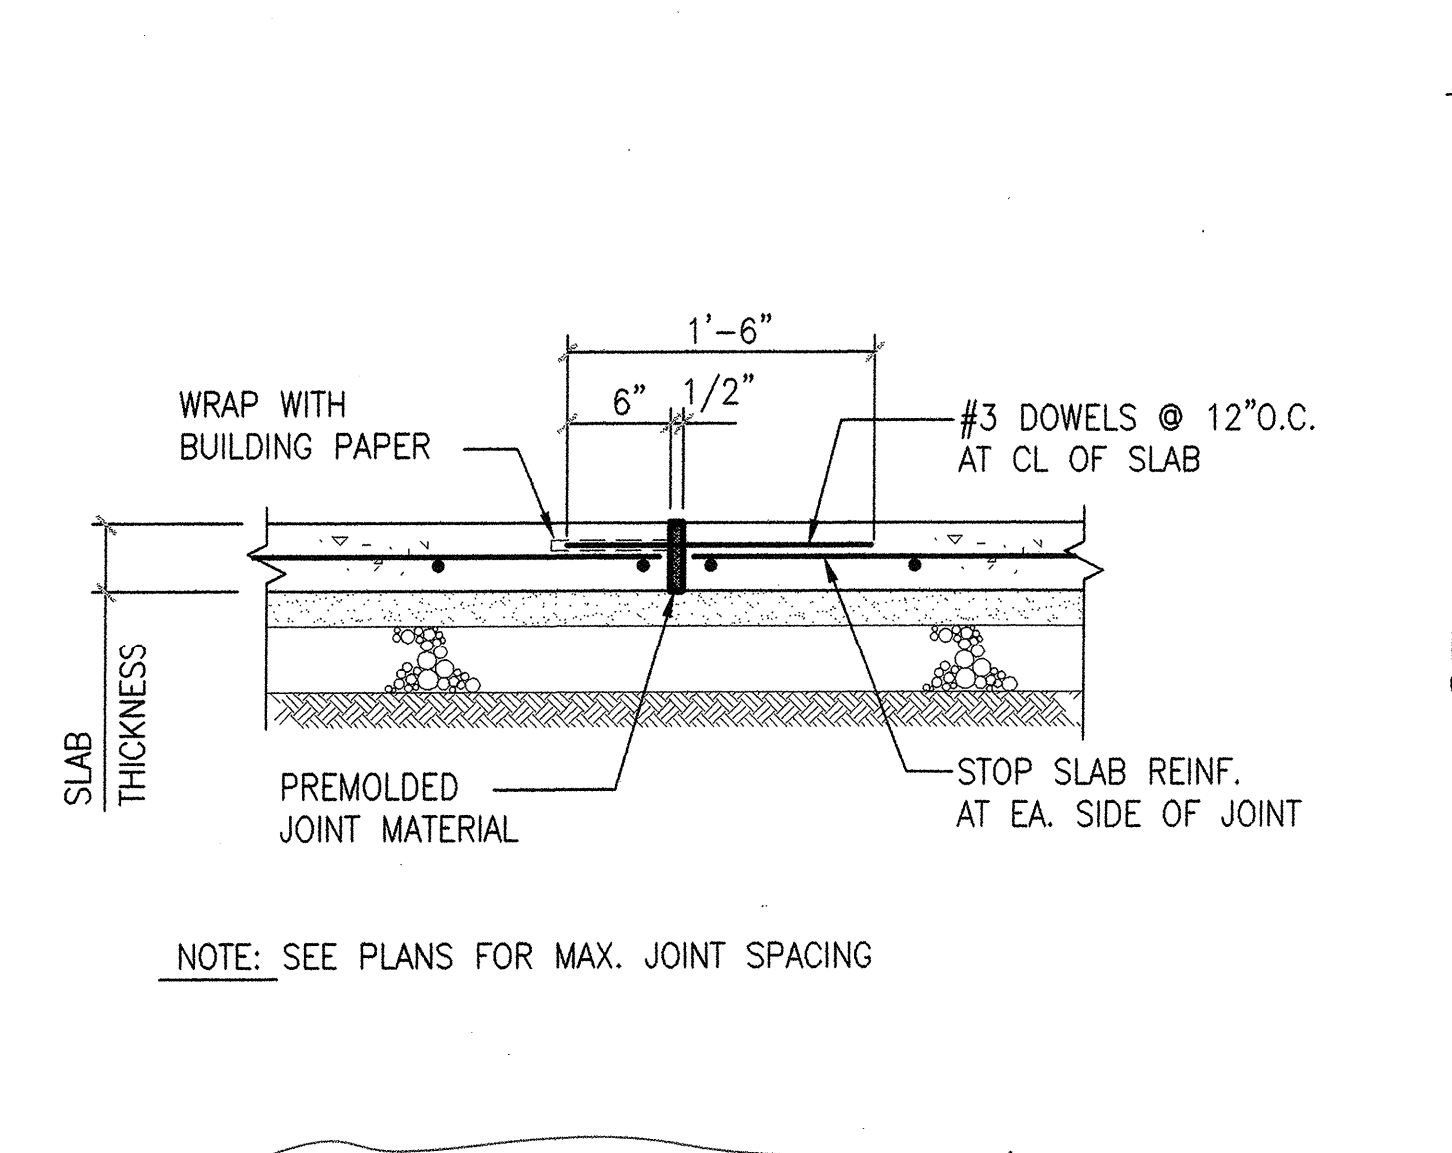


7 CONTROL JOINT (CJ) CONCRETE SLAB ON GRADE
N.T.S.

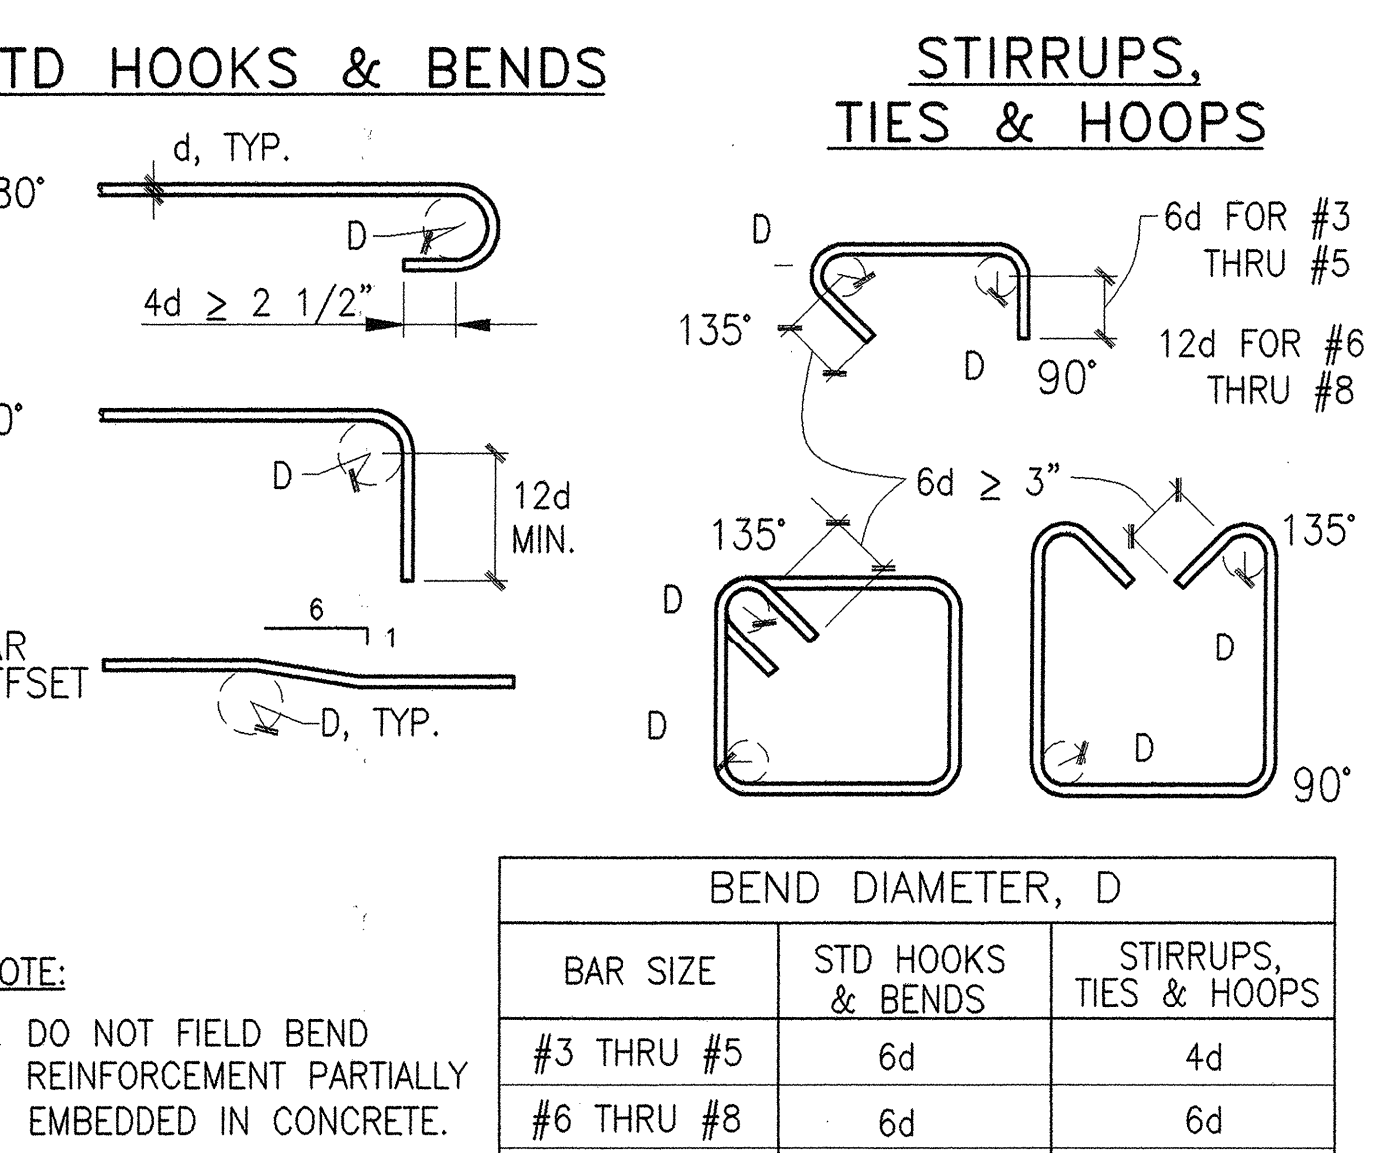


4 HOOKS & BENDS
N.T.S.

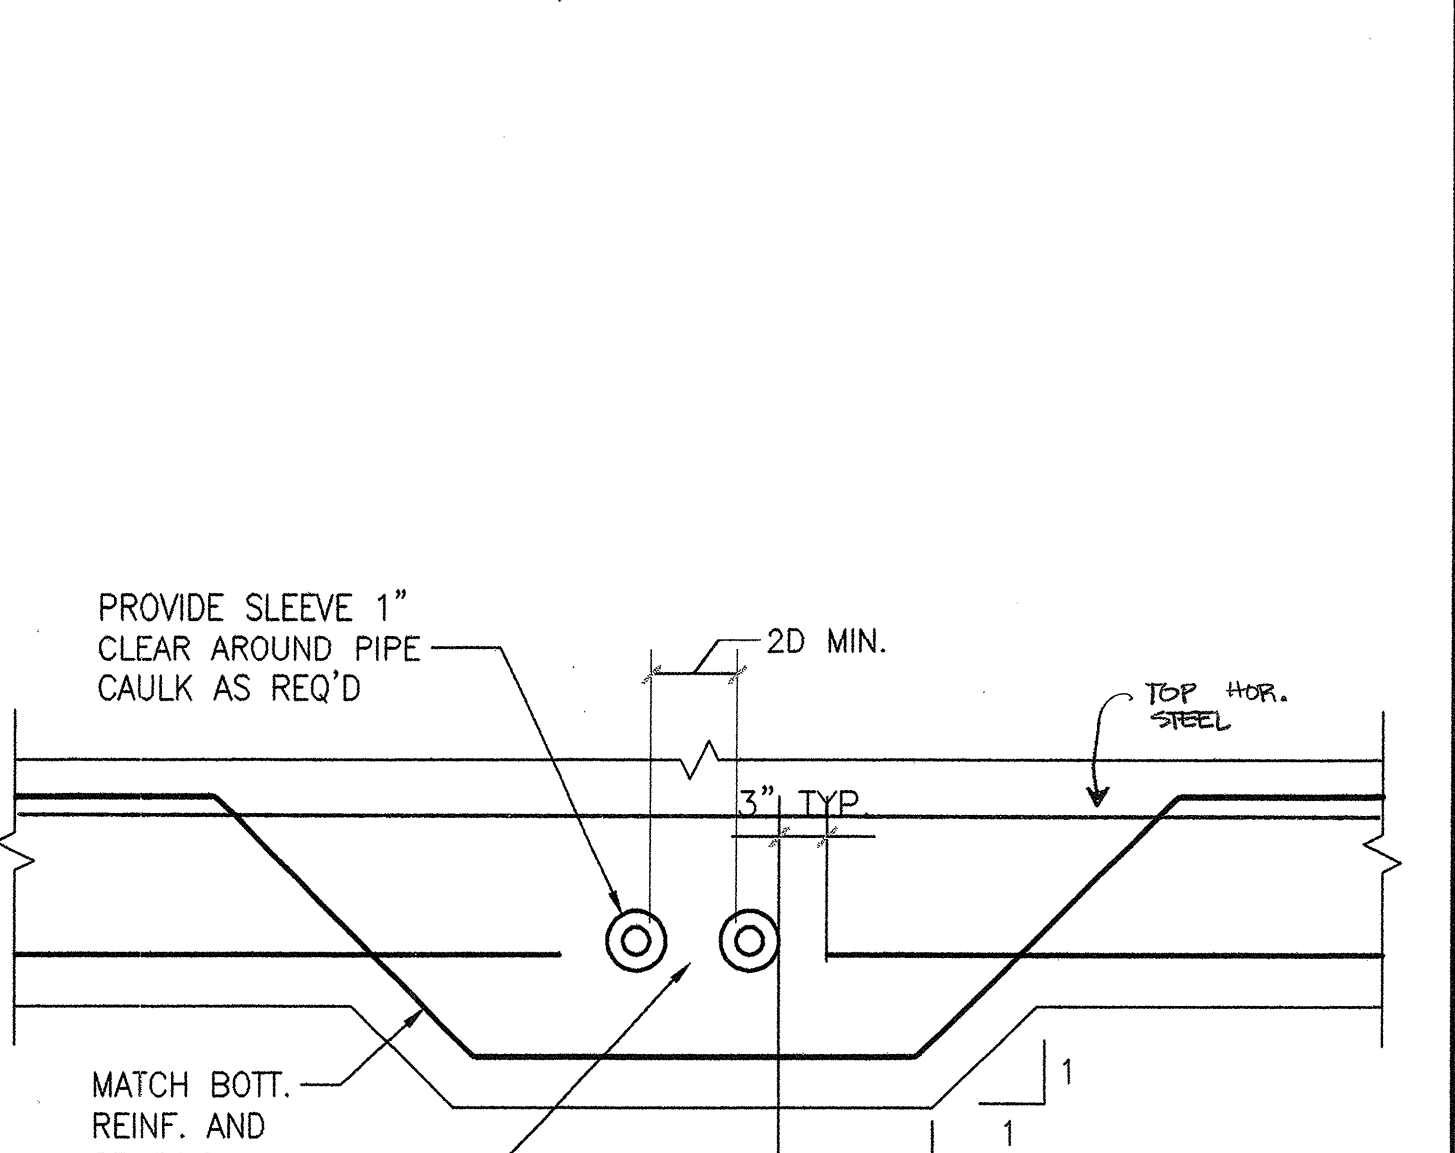


2 RELATION OF PIPES & TRENCHES TO FOOTING
N.T.S.

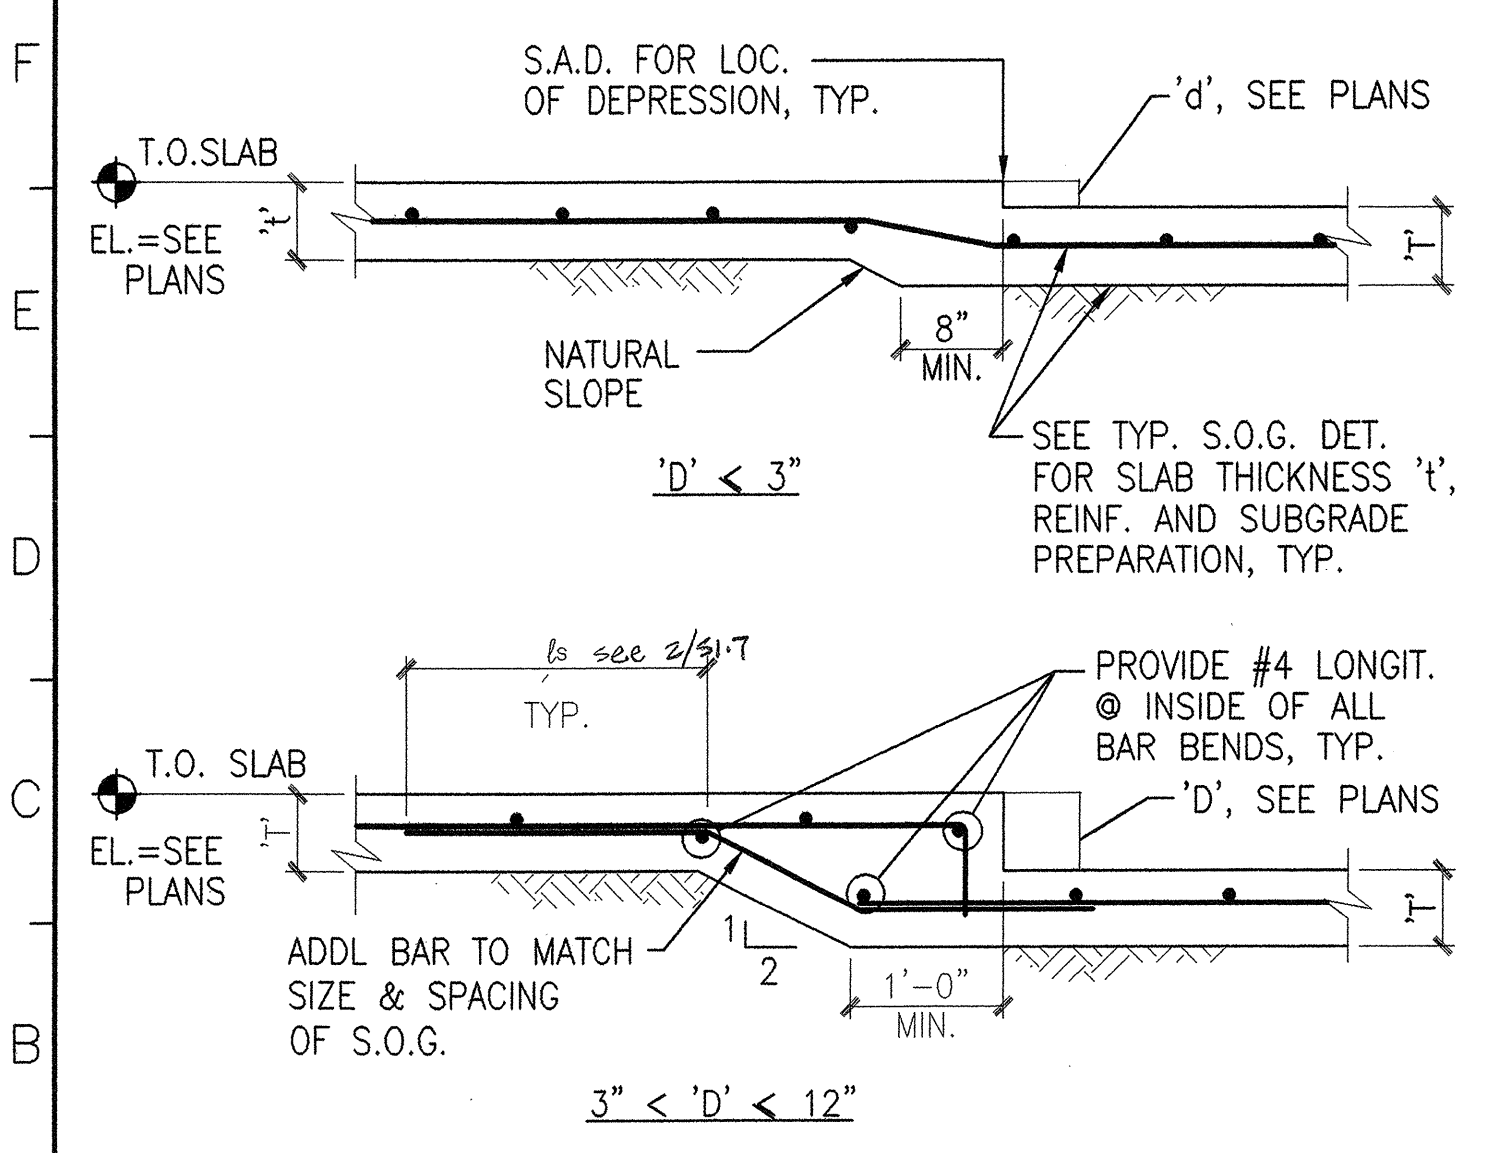


11 SLAB ON GRADE DEPRESSION
N.T.S.

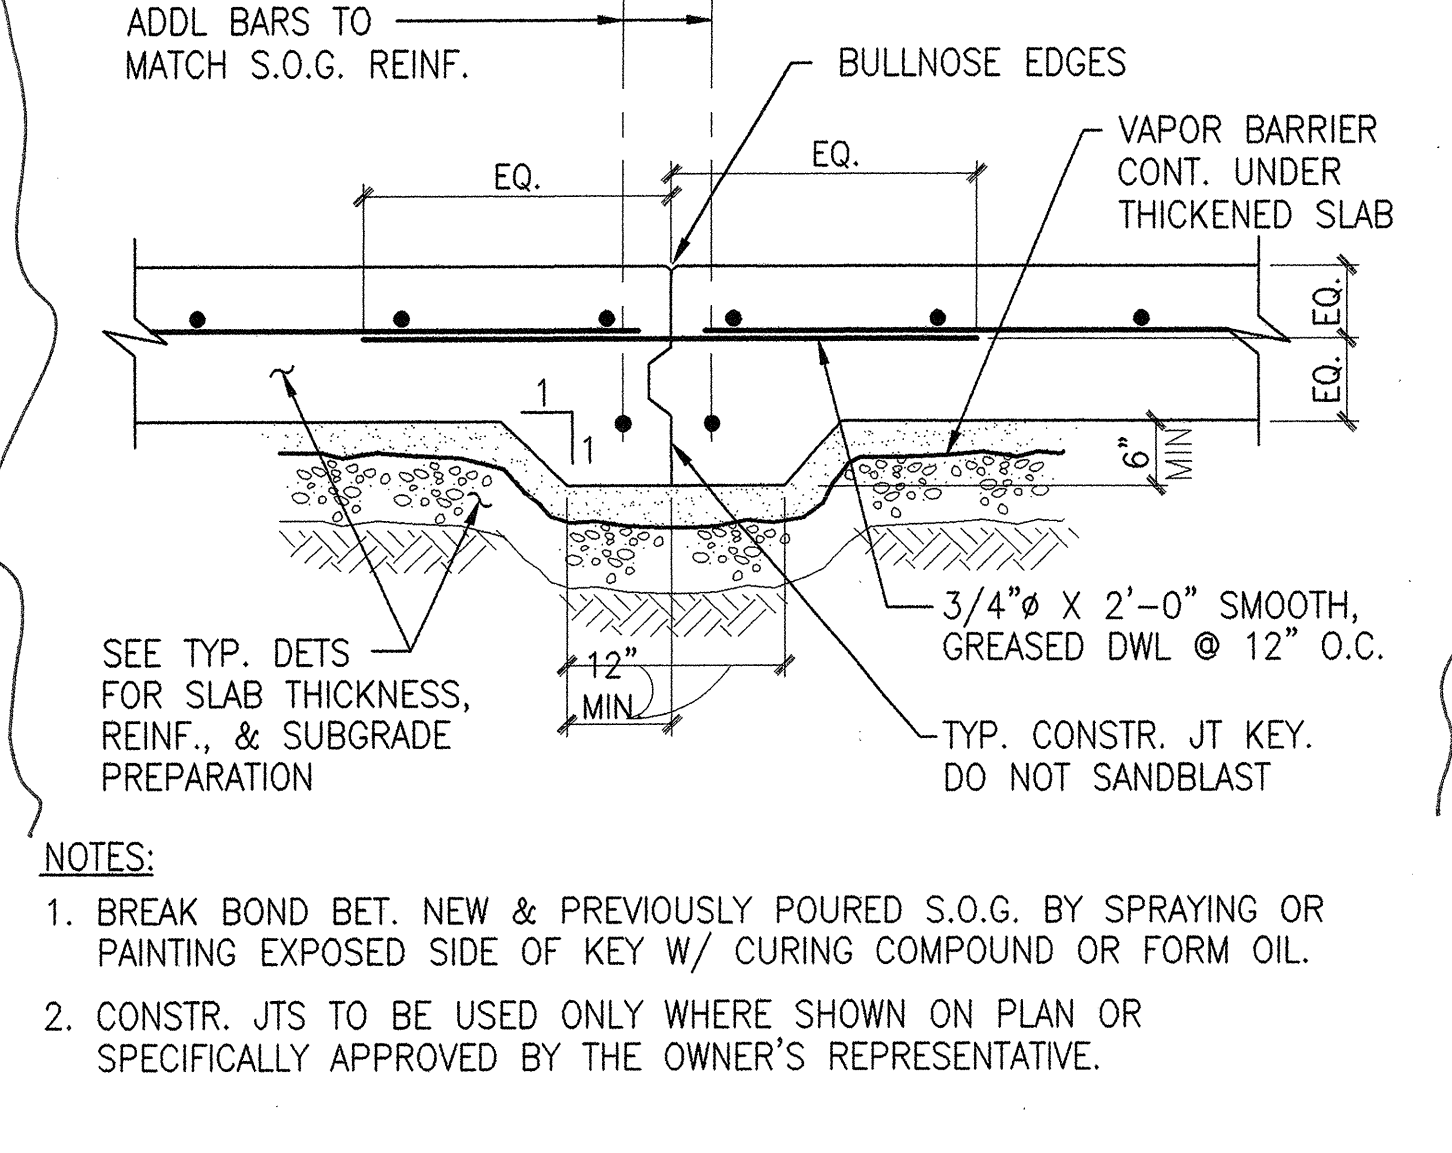

8 SLAB ON GRADE CONSTRUCTION JOINT
N.T.S.

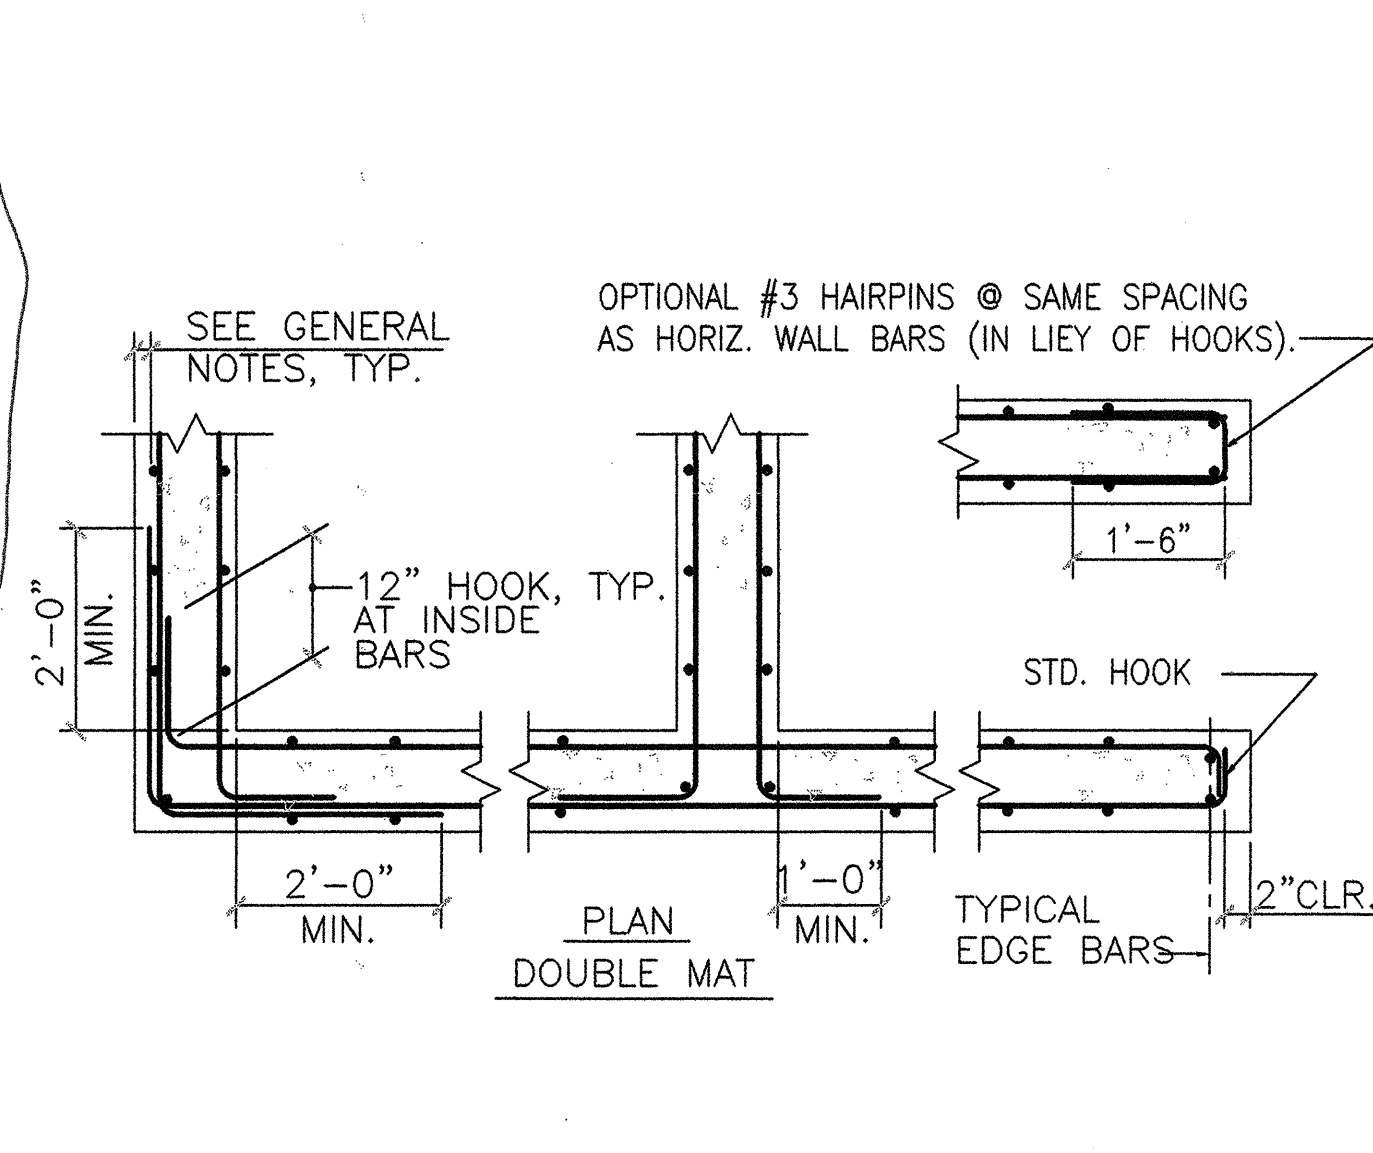

5 TYPICAL REINFORCEMENT AT WALL AND FOOTING CORNERS
nts

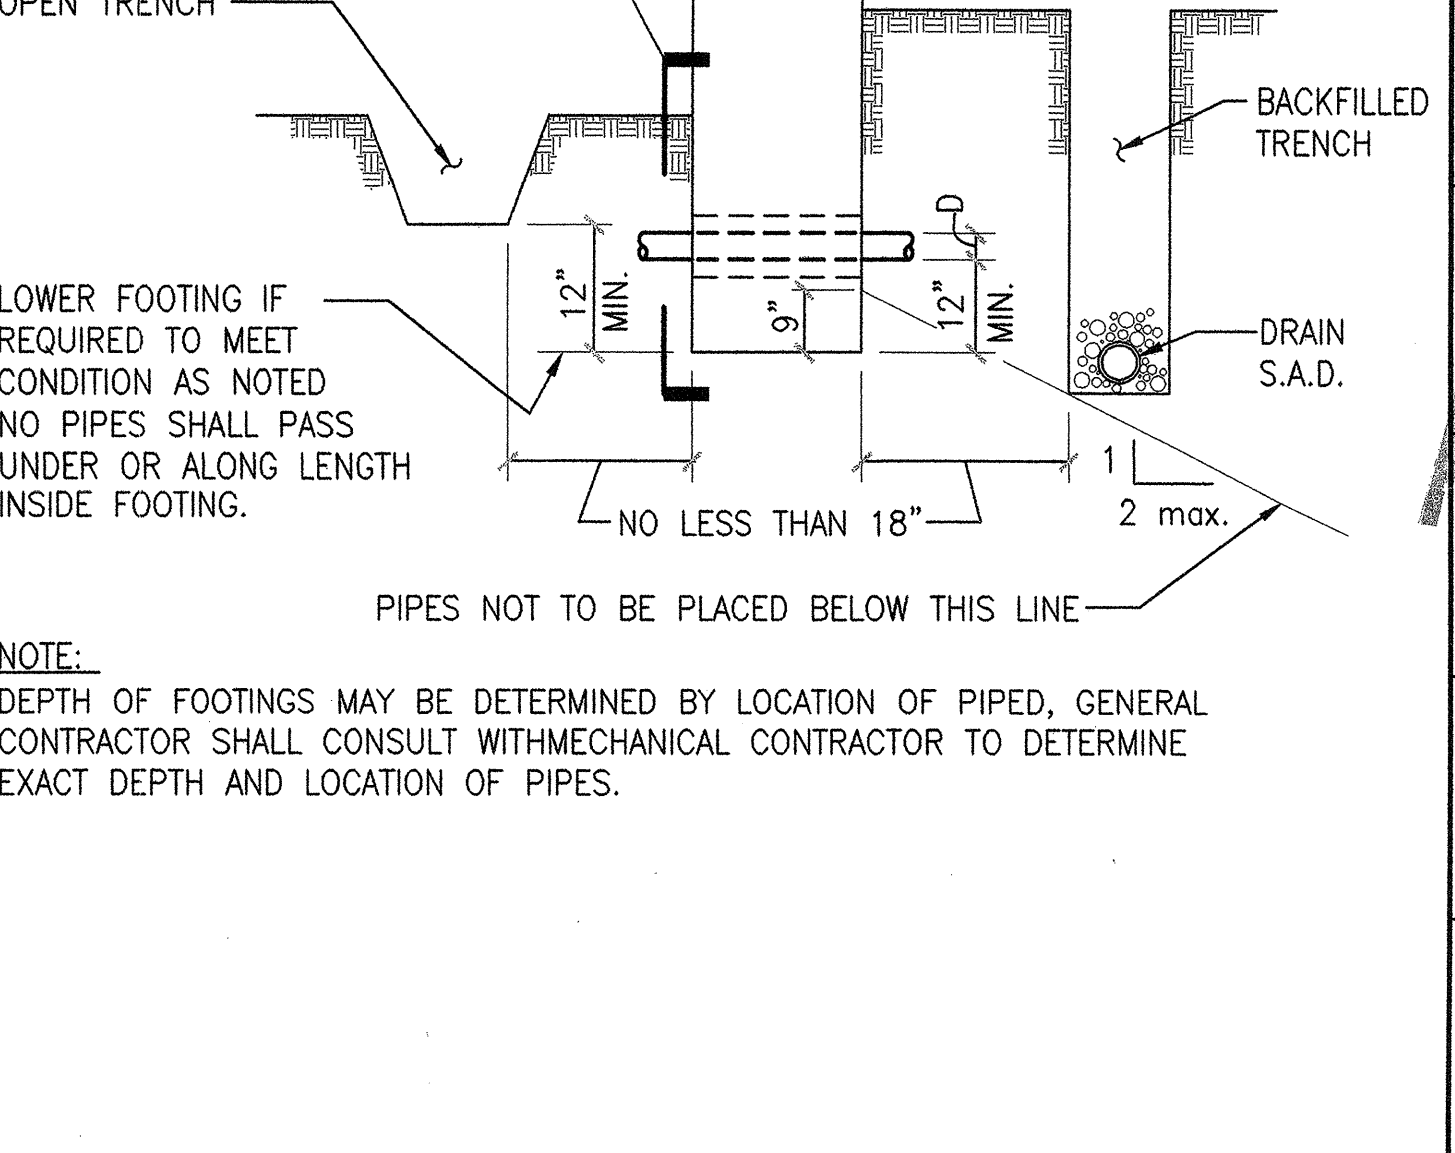

2 RELATION OF PIPES & TRENCHES TO FOOTING
nts

20 19 18 17 16 15 14 13 12 11 10 9 8 7 6 5 4 3 2 1

REVISIONS: (Δ) REVISIONS SHOWN MADE TO THIS SHEET

NO.	DATE	REASON	BY

SEAL:

CONSULTANT: **Degenkolb Engineers**
300 Frank H. Ogawa Plaza
Suite 400
Oakland, CA 94612-2001
Phone: (925) 256-9949
Fax: (925) 256-9959

ARCHITECT: **CIANFICHI ARCHITECTURE • PLANNING**
30 ANNE COURT
WALNUT CREEK, CA 94598
TEL: (925) 256-8838
FAX: (925) 256-8852

PROJECT: **CHILD DEVELOPMENT CENTER CANADA COLLEGE**
4200 FARM HILL BLVD.
REDWOOD CITY, CA 94061

SAN MATEO COUNTY COMMUNITY COLLEGE DISTRICT

STAMP: IDENTIFICATION STAMP
DIVISION OF THE STATE ARCHITECT
APPL. NO. 108529
AC. FLS. SS. Inf. Relete
DATE 5/21/14 mt 5/21/14

APPL. NUMBER:
KEY PLAN:

AS-BUILTS

SHEET TITLE: **TYPICAL STRUCTURAL DETAILS**

DRAWN BY: JS	PROJECT NO.: 304.99
CHECKED BY: MAE/RT	DATE: 01-13-01
APPL. NO.:	SHEET: S15
DATA NO.: 104-000	NO. OF: