



- NOTES:**
- TOP OF FINISHED FLOOR INDICATED ON PLAN
 - CONCRETE: FOR TYPICAL DETAILS, SEE SHEET S5.1
 - C.M.U.: FOR WALL TYPES, AND TYPICAL DETAILS, SEE SHEET S4.1
 - SLAB EDGE: S.L.D. FOR EDGE OF SLAB DIMENSION, CONTRACTOR SHALL COMPARE STRUCTURAL DRAWINGS WITH ALL OTHER DISCIPLINES AND NOTIFY THE ARCHITECT OF ANY DISCREPANCIES PRIOR TO FABRICATION.
 - DEPRESSIONS, CURBS & FINISHES: SEE ARCHITECTURAL DRAWINGS FOR LOCATION OF FLOOR DEPRESSIONS, CURBS AND FINISHES.
 - TOP OF SLAB: TYPICAL TOP OF STRUCTURAL SLAB (T.O.C.) SHALL BE AS INDICATED ON THE ARCHITECTURAL PLANS WITH RESPECT TO TOP OF FINISHED FLOOR. (T.O.F.F.)
 - SPECIAL CONDITIONS: PRIOR TO REQUESTING A FOUNDATION INSPECTION (AT LEAST 48 HOURS) THE CONTRACTOR SHALL CONTACT THE GEOTECHNICAL ENGINEER. THE GEOTECHNICAL ENGINEER SHALL VERIFY IN WRITING TO THE BUILDING OFFICIAL THAT THE BUILDING FOUNDATION FOOTING EXCAVATIONS AND BUILDING PAD WERE PREPARED IN ACCORDANCE WITH THE SOIL REPORT RECOMMENDATIONS. THE FOUNDATION FORMING AND GRADING WERE PERFORMED IN CONFORMANCE WITH THE SOIL REPORT RECOMMENDATION AND APPROVED PLANS.
 - S.L.D. FOR DIMENSIONS OF WALLS & OPENINGS.


FOUNDATION PLAN
1/8" = 1'-0" S1.0

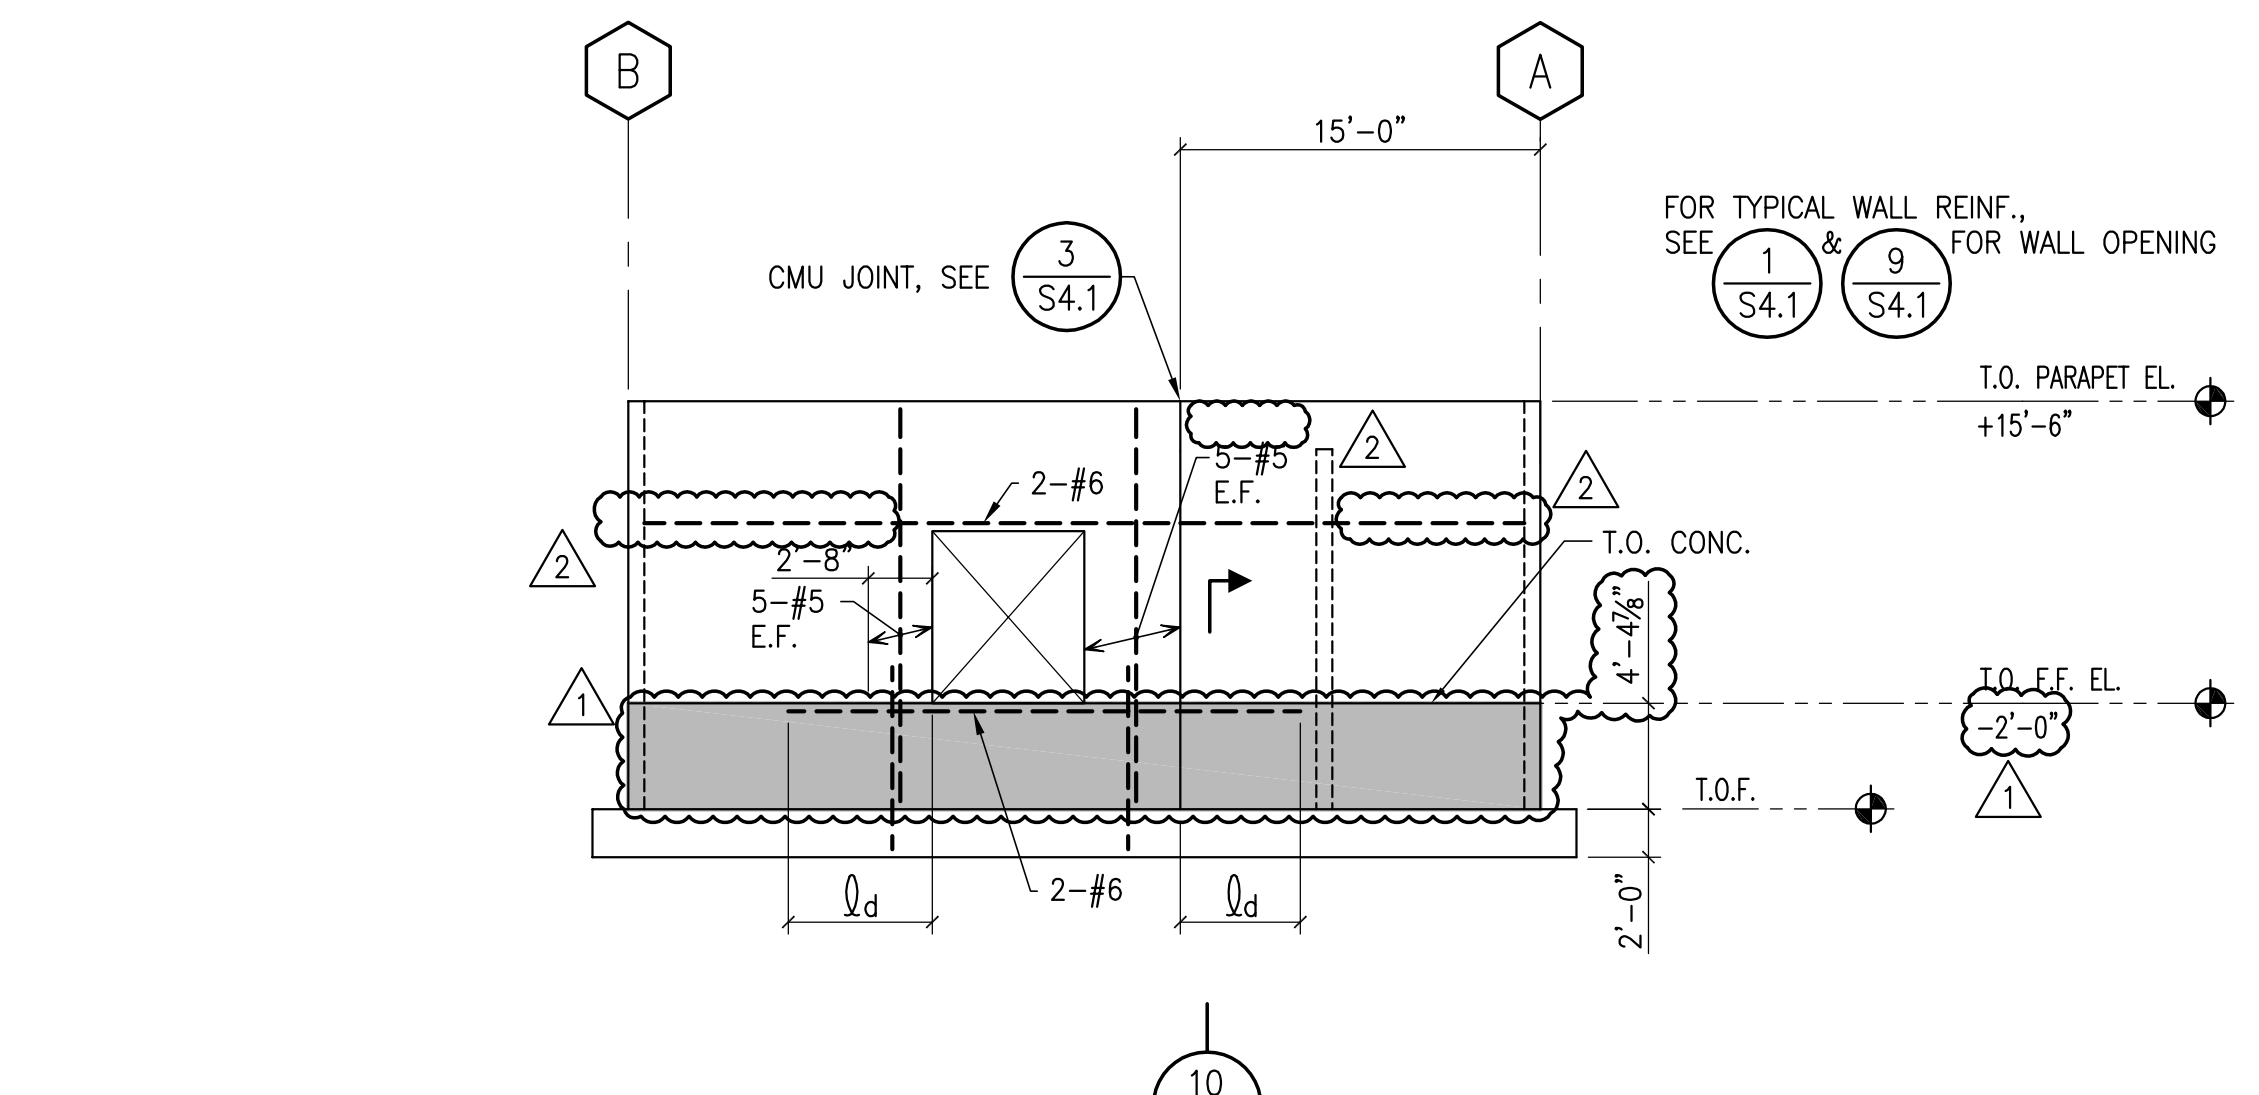

EAST WALL ELEVATION
1/8" = 1'-0" S1.0

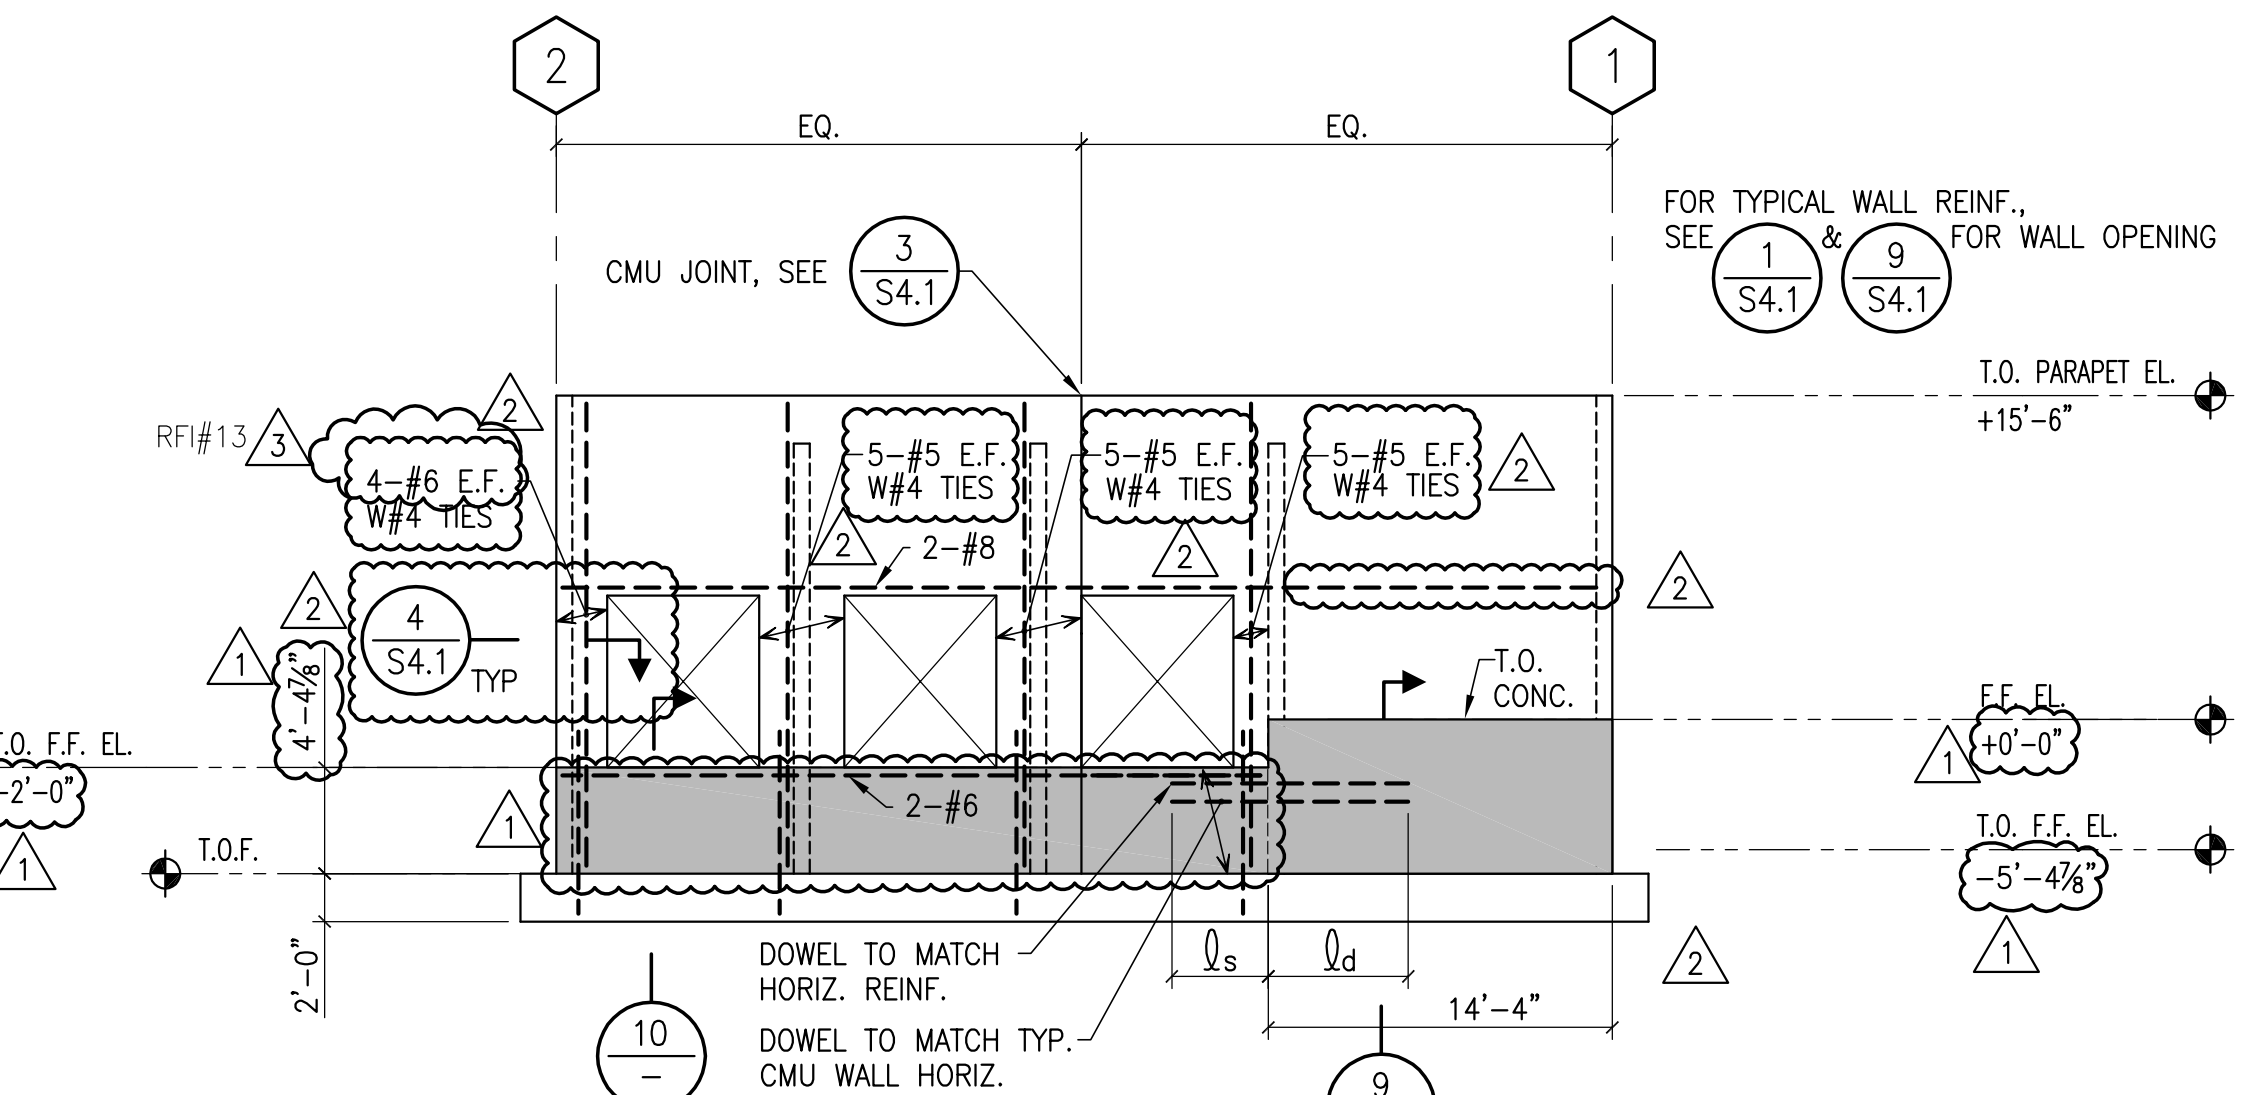


NORTH WALL ELEVATION
1/8" = 1'-0" S1.0

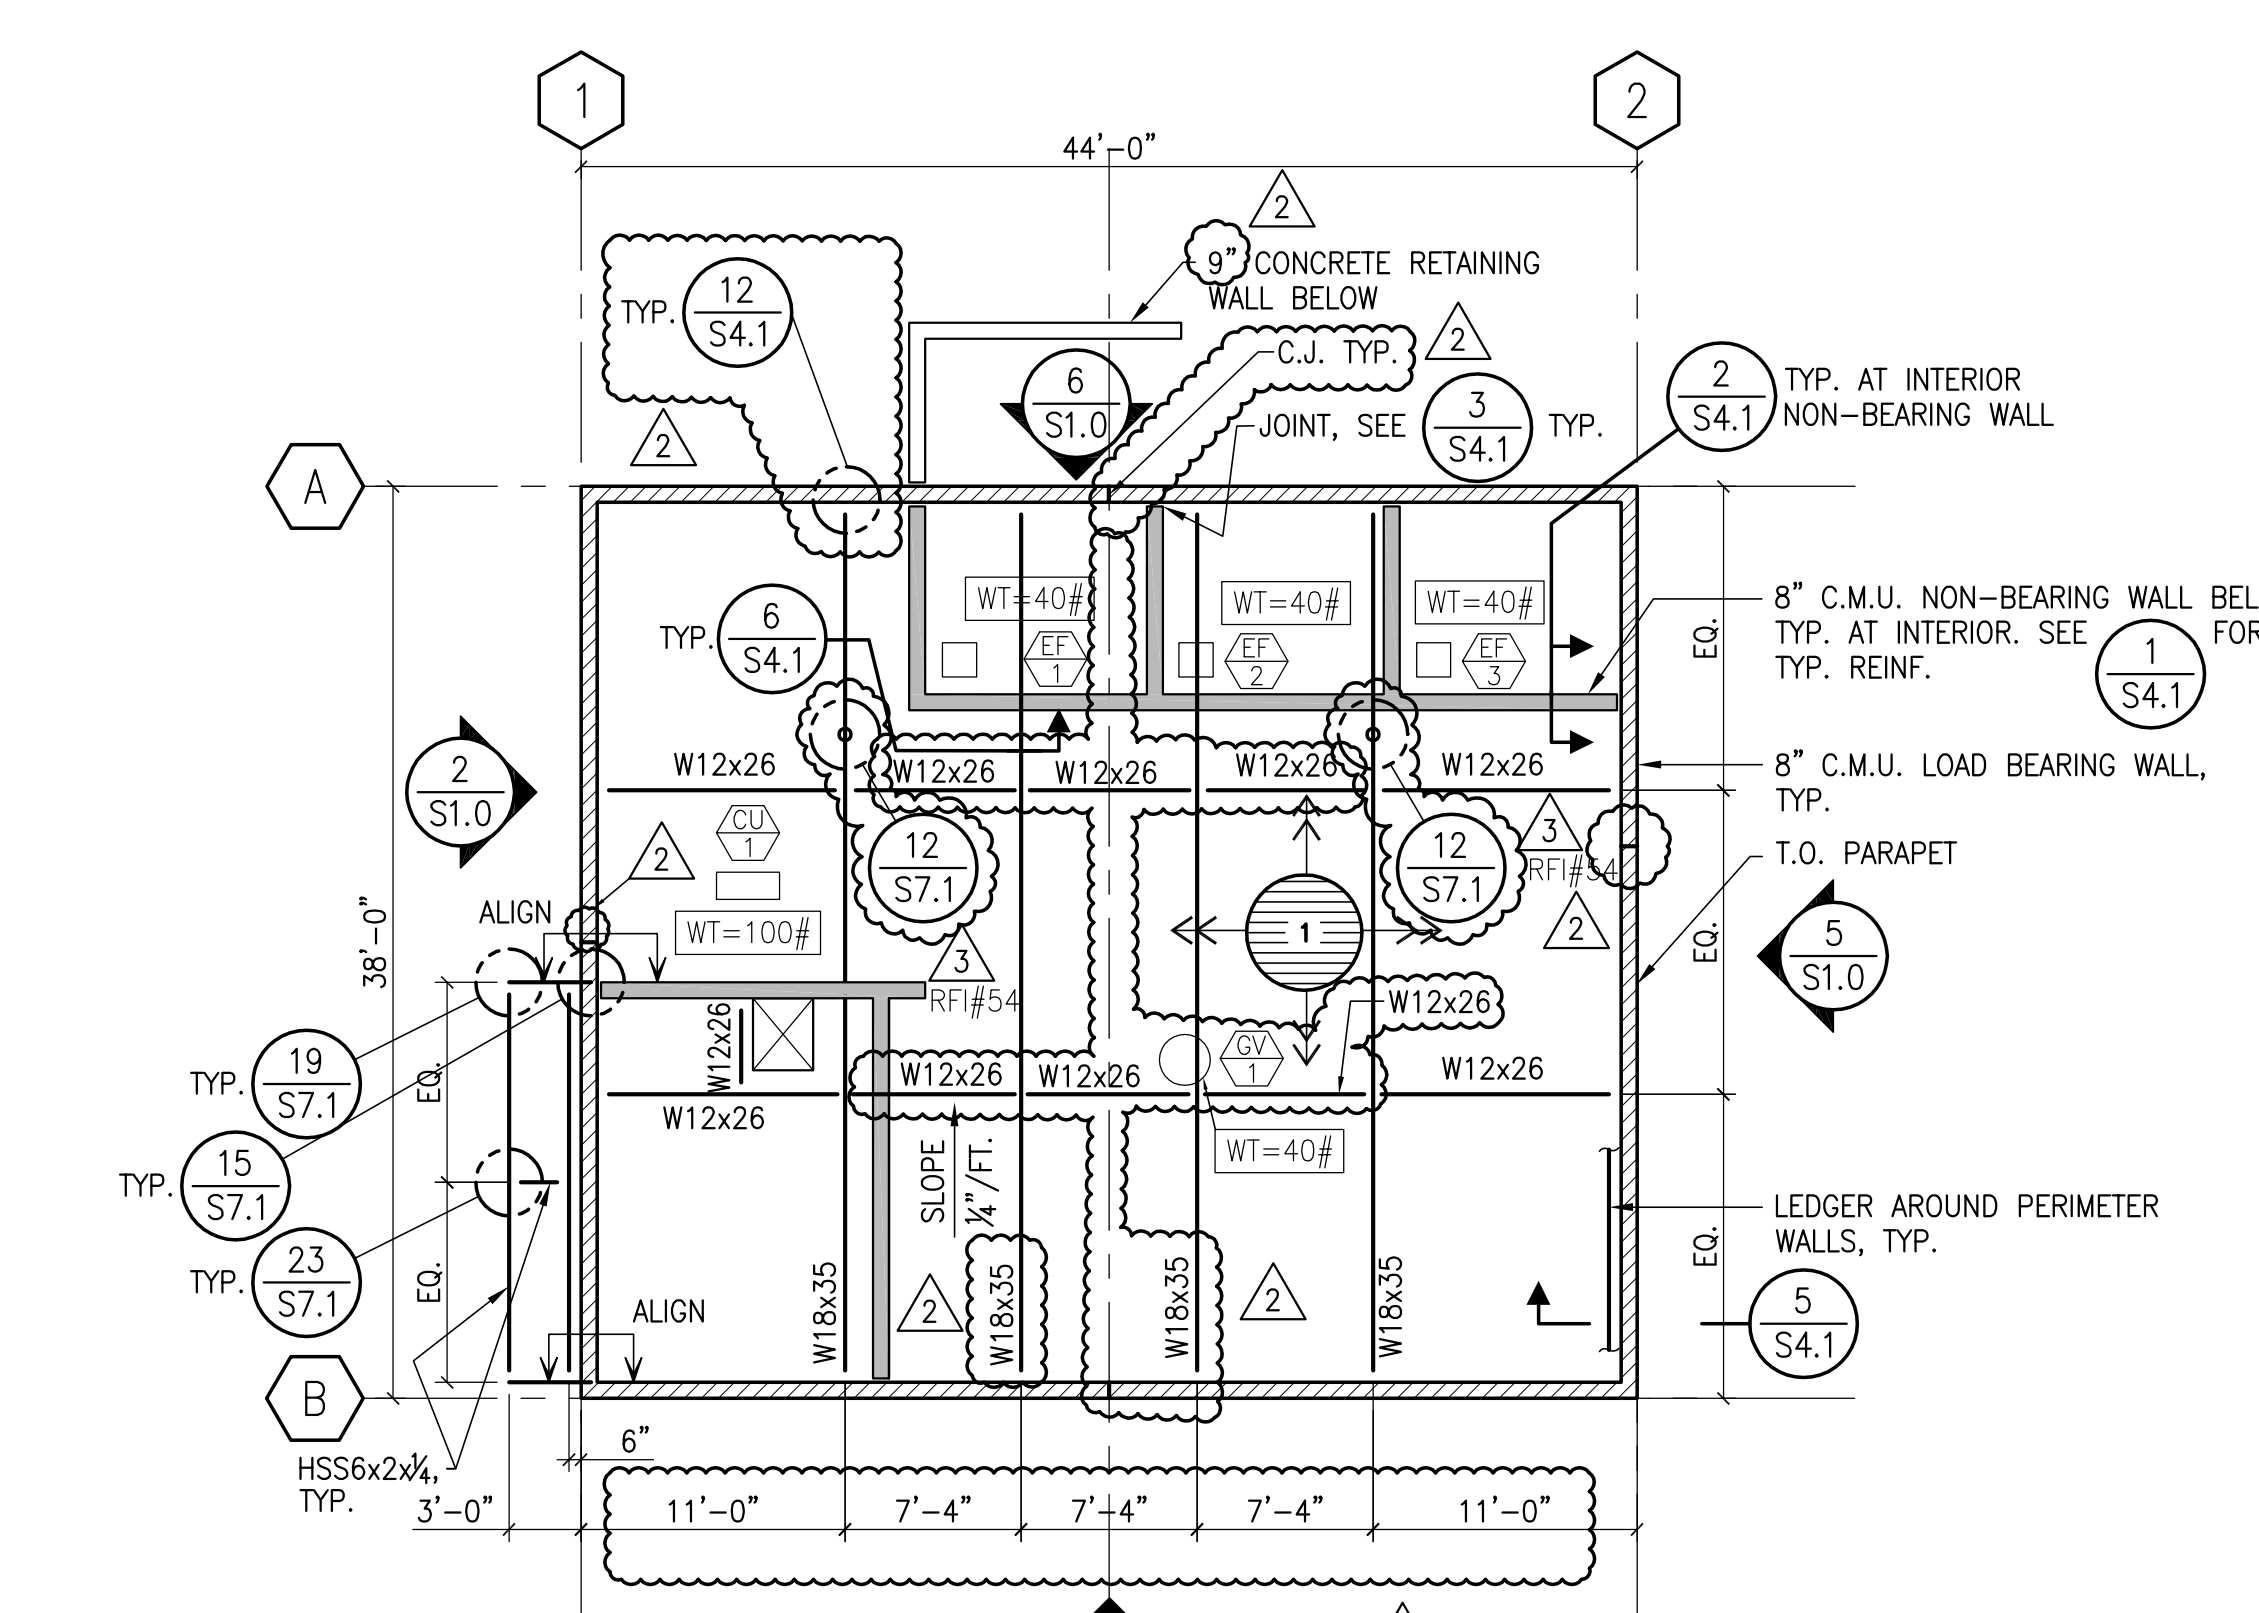


- NOTES:**
- STEEL: FOR TYPICAL DETAILS, SEE SHEET S7.1
 - METAL DECK: FOR TYPICAL DETAILS SEE SHEET S7.1
 - DECK EDGE: ALL BEAMS AT INTERIOR DECK OPENINGS ARE CENTERED 6" FROM EDGE UNLESS OTHERWISE NOTED. CONTRACTOR SHALL COMPARE STRUCTURAL DRAWINGS WITH ALL OTHER DISCIPLINES AND NOTIFY THE ARCHITECT OF ANY DISCREPANCIES PRIOR TO FABRICATION.
 - TOP OF DECK: TYPICAL TOP OF DECK SHALL BE AS INDICATED ON LANDSCAPE ARCHITECTURAL DWG.
 - OPENINGS: NOT ALL OPENINGS ARE SHOWN. ONLY LARGE OPENINGS ARE SHOWN HERE. S.L.D. FOR SIZE AND LOCATION OF OPENINGS. SEE SHEET S7.1 FOR TYPICAL SECONDARY FRAMING AND REINFORCEMENT CRITERIA.
 - CMU WALL
CMU WALL BLW., U.O.N.
 - S.A.D. FOR DIMENSIONS

ROOF FRAMING PLAN
1/8" = 1'-0" S1.0

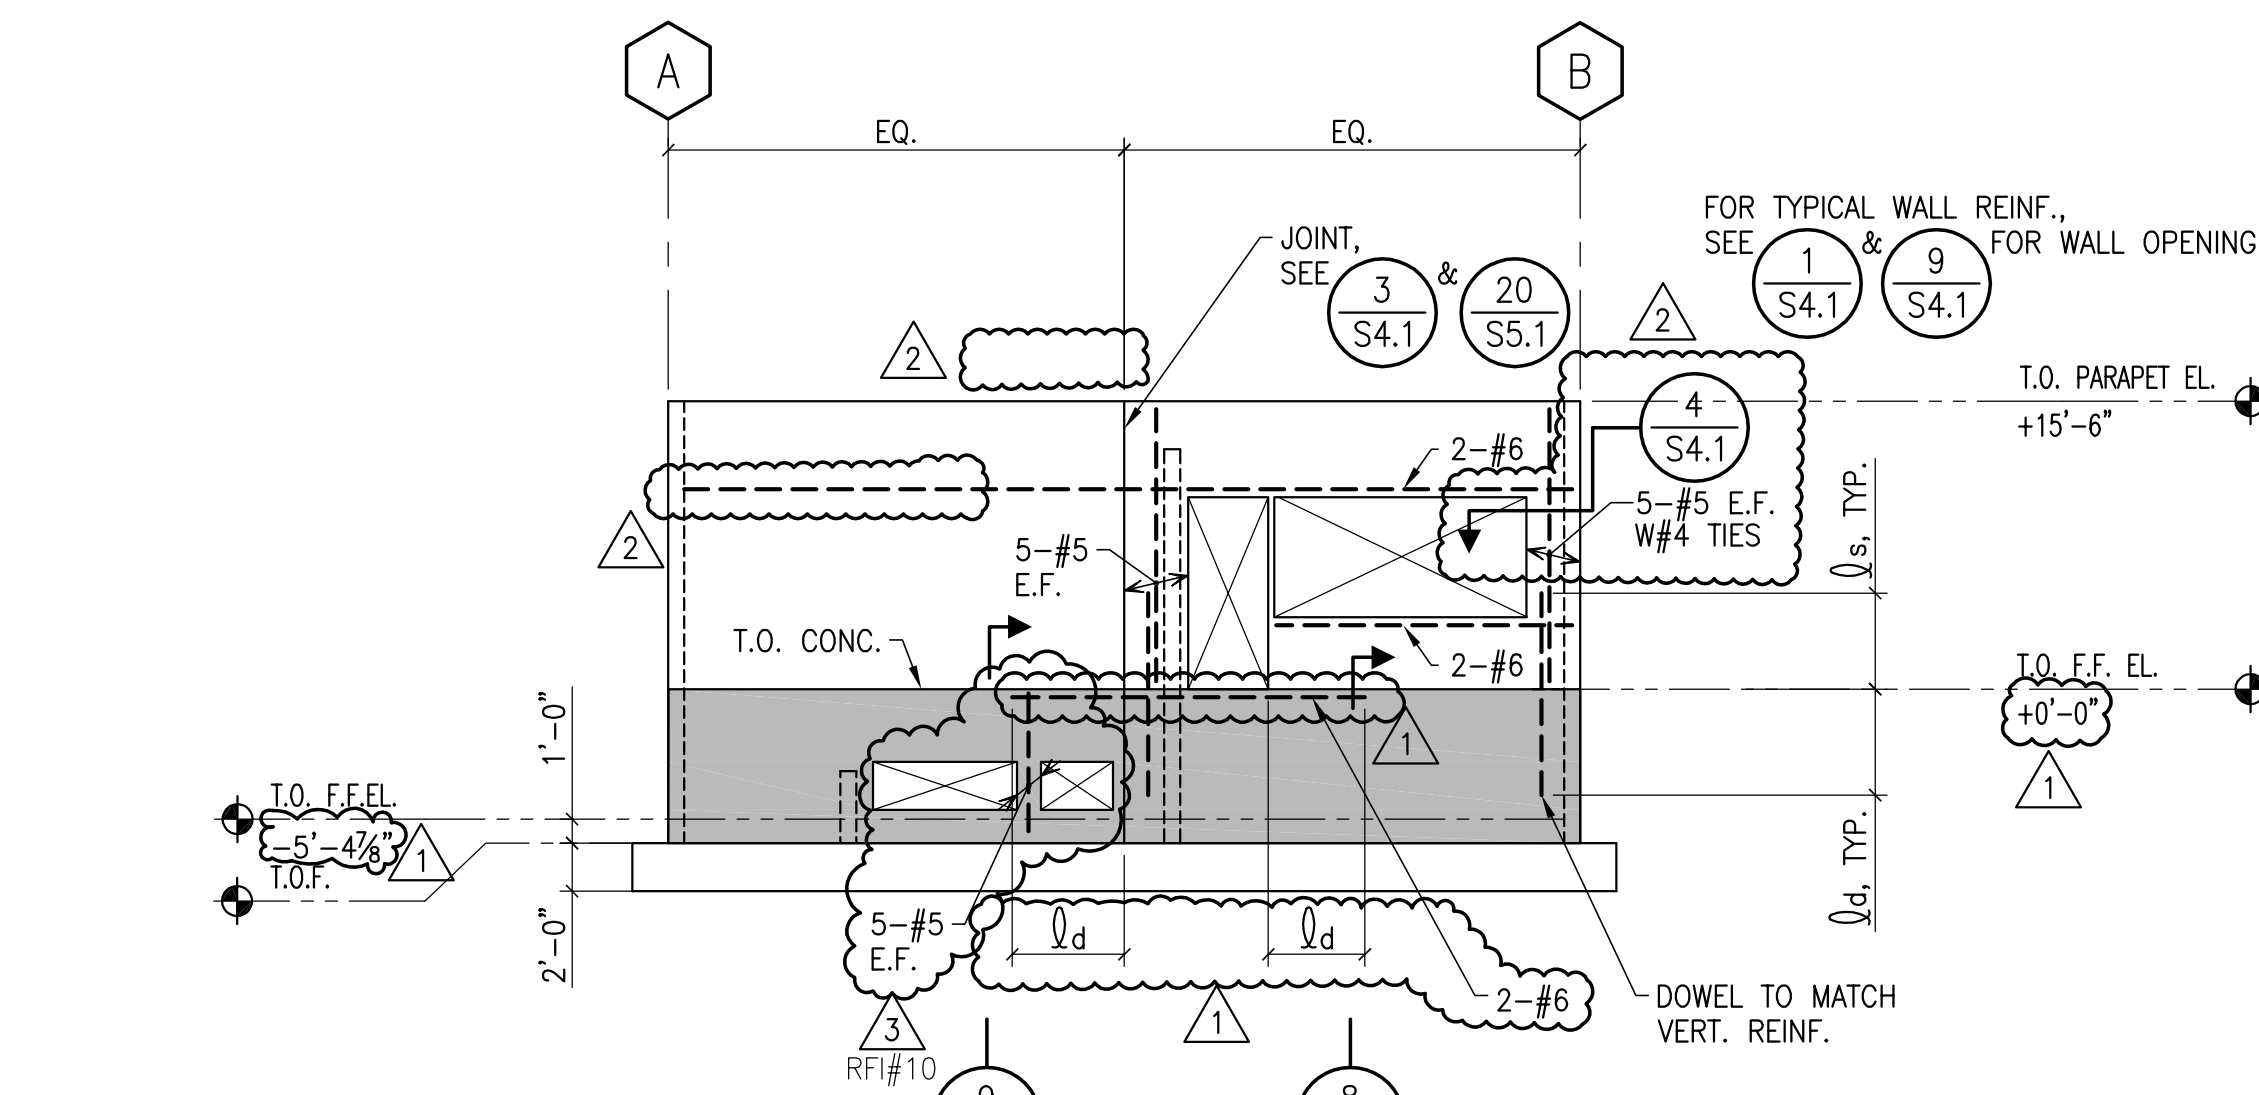

WEST WALL ELEVATION
1/8" = 1'-0" S1.0

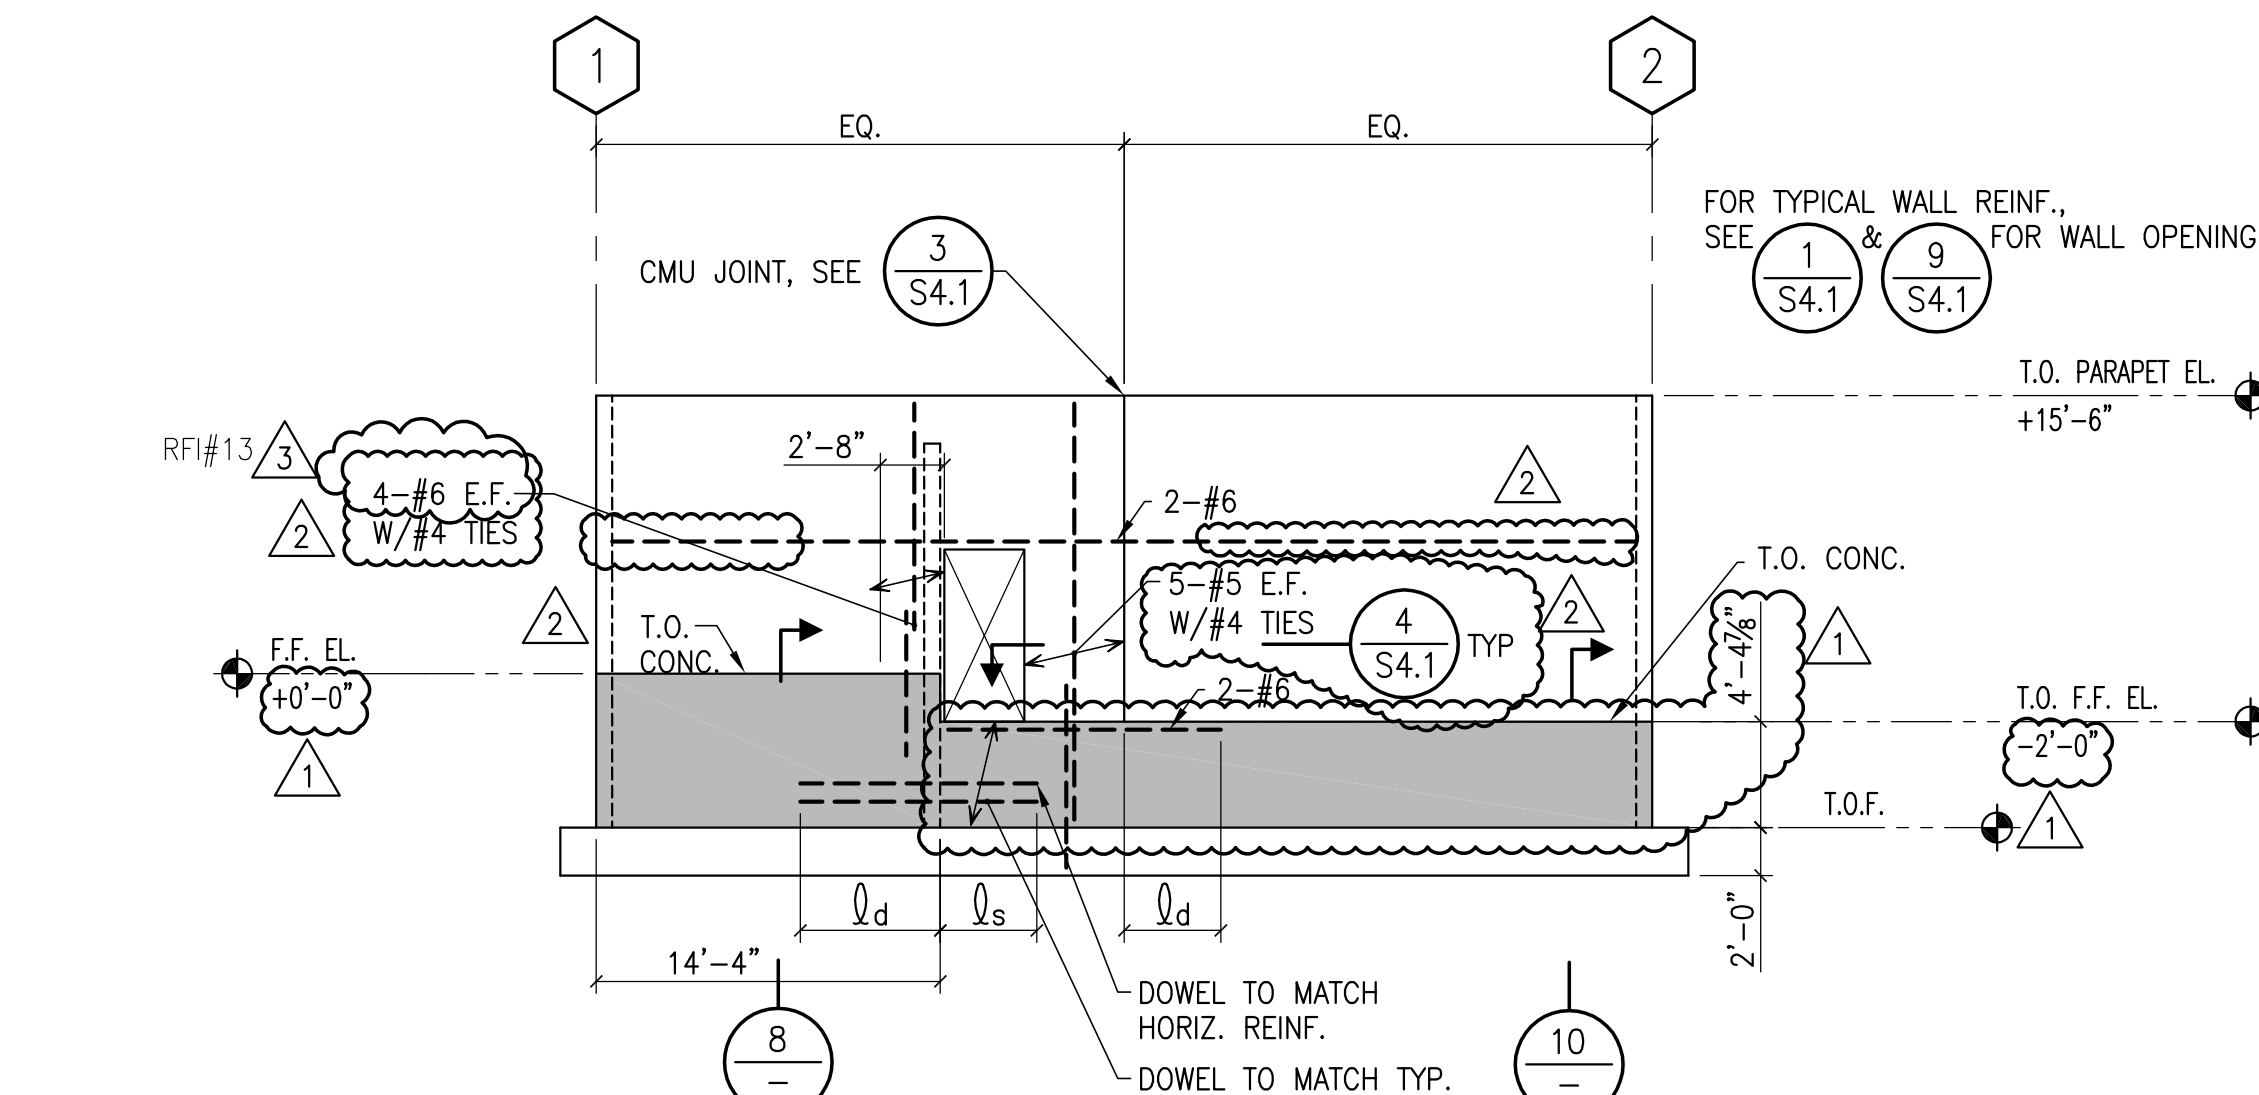

SOUTH WALL ELEVATION
1/8" = 1'-0" S1.0

Revision	Description	Date
1	ISSUED FOR PERMITS	09-15-08
2	ISSUED FOR PERMITS SET	09-APRIL-2009
3	ISSUED FOR PERMITS SET	09-APRIL-2009
4	PROJECT RECORD DRAWING	JUNE 2011

Revision	Description	Date
1	ISSUED FOR PERMITS	09-15-08
2	ISSUED FOR PERMITS SET	09-APRIL-2009
3	ISSUED FOR PERMITS SET	09-APRIL-2009
4	PROJECT RECORD DRAWING	JUNE 2011

Job No.	27082.30
Date	09 APRIL 2009
Drawn by	MC
Checked by	PR
Scale	AS NOTED
POOL EQUIPMENT BUILDING PLANS, DETAILS AND ELEVATIONS	