


SECOND FLOOR PLAN

ASI-22  
Ref. SSX-131-5


SHEET NOTES

1. REFER TO ARCHITECTURAL AND MECHANICAL DRAWINGS FOR LOCATIONS OF EQUIPMENT, SIZE OF OPENING, CURB DETAILS.
2. SEE GENERAL NOTES, EXISTING CONSTRUCTION DIVISION, ITEM "C" FOR NEW PENETRATIONS REQUIREMENTS.
3. COORDINATE WITH ARCHITECTURAL DRAWINGS AND ELEVATOR VENDOR ALL DIMENSIONS AND ALL REQUIREMENTS PRIOR TO START OF CONSTRUCTION.
4. FOR SAFETY BEAM SEE 5.2N SIM.

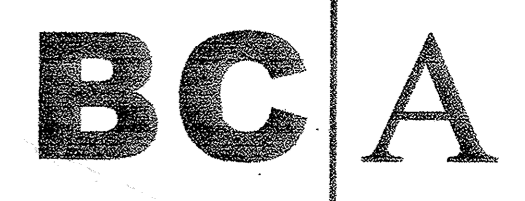

architecture  
planning  
interiors

Bunton Clifford Associates, Inc.  
210 Hammond Ave.  
Fremont, California 94539  
[ T ] 510.445.1000  
[ F ] 510.445.1005  
www.BCAincOnline.com

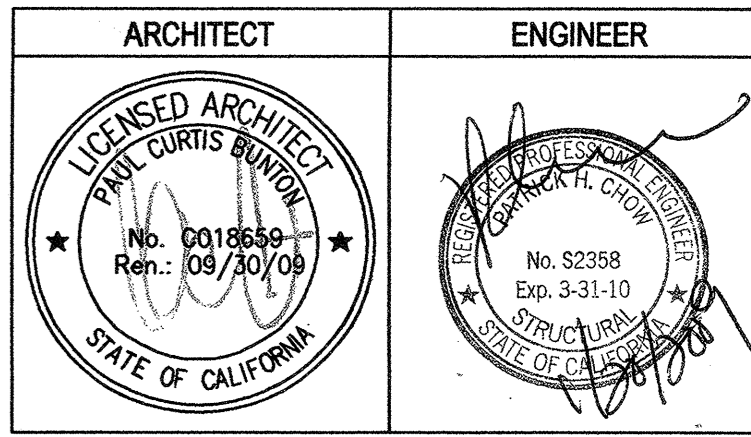

1. This sheet is part of a set and is not to be used alone.  
2. This sheet is not to be used for construction unless the architect's stamp and signature appear on the drawings and the status box indicates drawings have been released for construction.  
3. These plans and prints, when used as instruments of service, are owned by the architect and are for use on this project only. Reproduction and/or distribution without the prior written consent of the architect is forbidden.  
4. Copyright Bunton Clifford Associates, 2007

REMARKS	DATE

DATE

FILE NO. 41-C1

IDENTIFICATION STAMP  
DIV. OF THE STATE ARCHITECT

01-110074

AC FLS SS

DATE MAR 10 2008

BUILDINGS 5 & 6  
RENOVATIONS

San Mateo County Community  
College District

DSA BACK-CHECK

CAÑADA COLLEGE  
4200 Farm Hill Boulevard  
Redwood City, CA 94061

SECOND FLOOR PLAN

Date 12/31/08  
Scale AS NOTED  
Project Number 07013

Drawing Number S2.2