


REVISIONS:  $\Delta$  (REVISIONS SHOULD MAKE TO THIS SHEET)

NO.	DATE	REASON	BY
1	1/9/15	ADDENDUM #1	

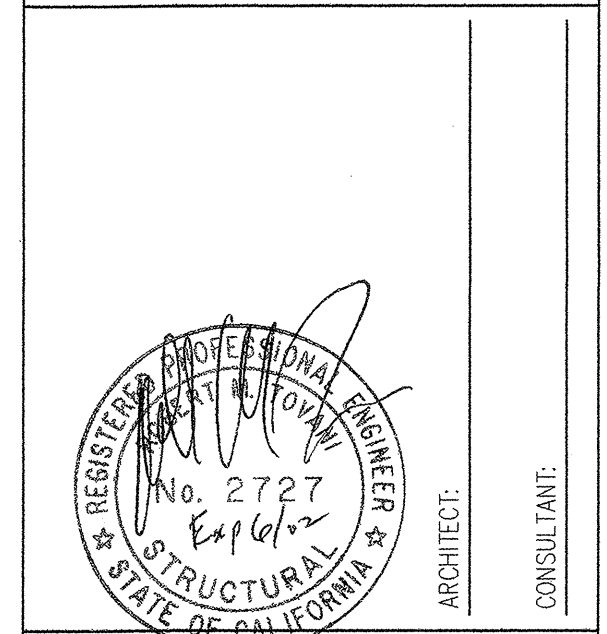

CONSULTANT:  
**Degenkolb Engineers**  
 300 Frank E. Ogawa Plaza  
 Suite 400  
 Oakland, CA 94612-5001  
 Phone 510-272-8600  
 Fax 510-272-8626

ARCHITECT:  
**CIANFICHI ARCHITECTURE • PLANNING**  
 30 ANNE COURT  
 WALNUT CREEK, CA 94598  
 TEL: (925) 256-8653  
 FAX: (925) 256-8652

PROJECT:  
**CHILD DEVELOPMENT CENTER CAÑADA COLLEGE**  
 4200 FARM HILL BLVD.  
 REDWOOD CITY, CA 94061  
**SAN MATEO COUNTY COMMUNITY COLLEGE DISTRICT**

STAMP:  
 APPROVED  
 DIV OF THE STATE ARCHITECT  
 AC BR FILS BH SS MP  
 APPL NO. 0-103525 DATE 3/1/15

APPL NUMBER:  
 KEY PLAN:

**AS-BUILTS**

SHEET TITLE:  
**STRUCTURAL BUILDING SECTION AND DETAILS**

DRAWN BY: JS	PROJECT NO.: 20024
CHECKED BY: MAE/RT	DATE: 01-13-01
APPL NO.:	SHEET:
DATA NO.: 302-000	NO. OF: S3.2a