
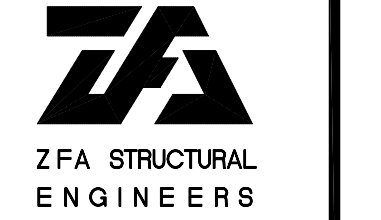


KEY NOTES

XXXX

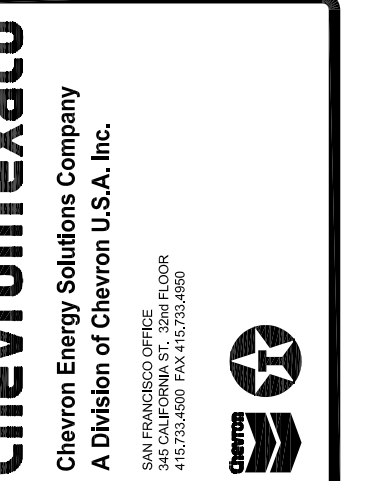


555 HOWARD STREET
SAN FRANCISCO
CALIFORNIA 94105
TEL (415) 243-4091
FAX (415) 243-0241
Copyright © 2003

Canada College Modernization
CENTRAL PLANT RENOVATION
San Mateo County Community College District


PLANS AND DETAILS

SCALE	AS SHOWN
PROJECT NO.	04321.00
DESIGNED BY	JSS
DRAWN BY	FF
CHECKED BY	AI
DATE	6/3/2005
ISSUE NO.	
ISSUE (DATE)	
ISSUE (DATE)	

S3

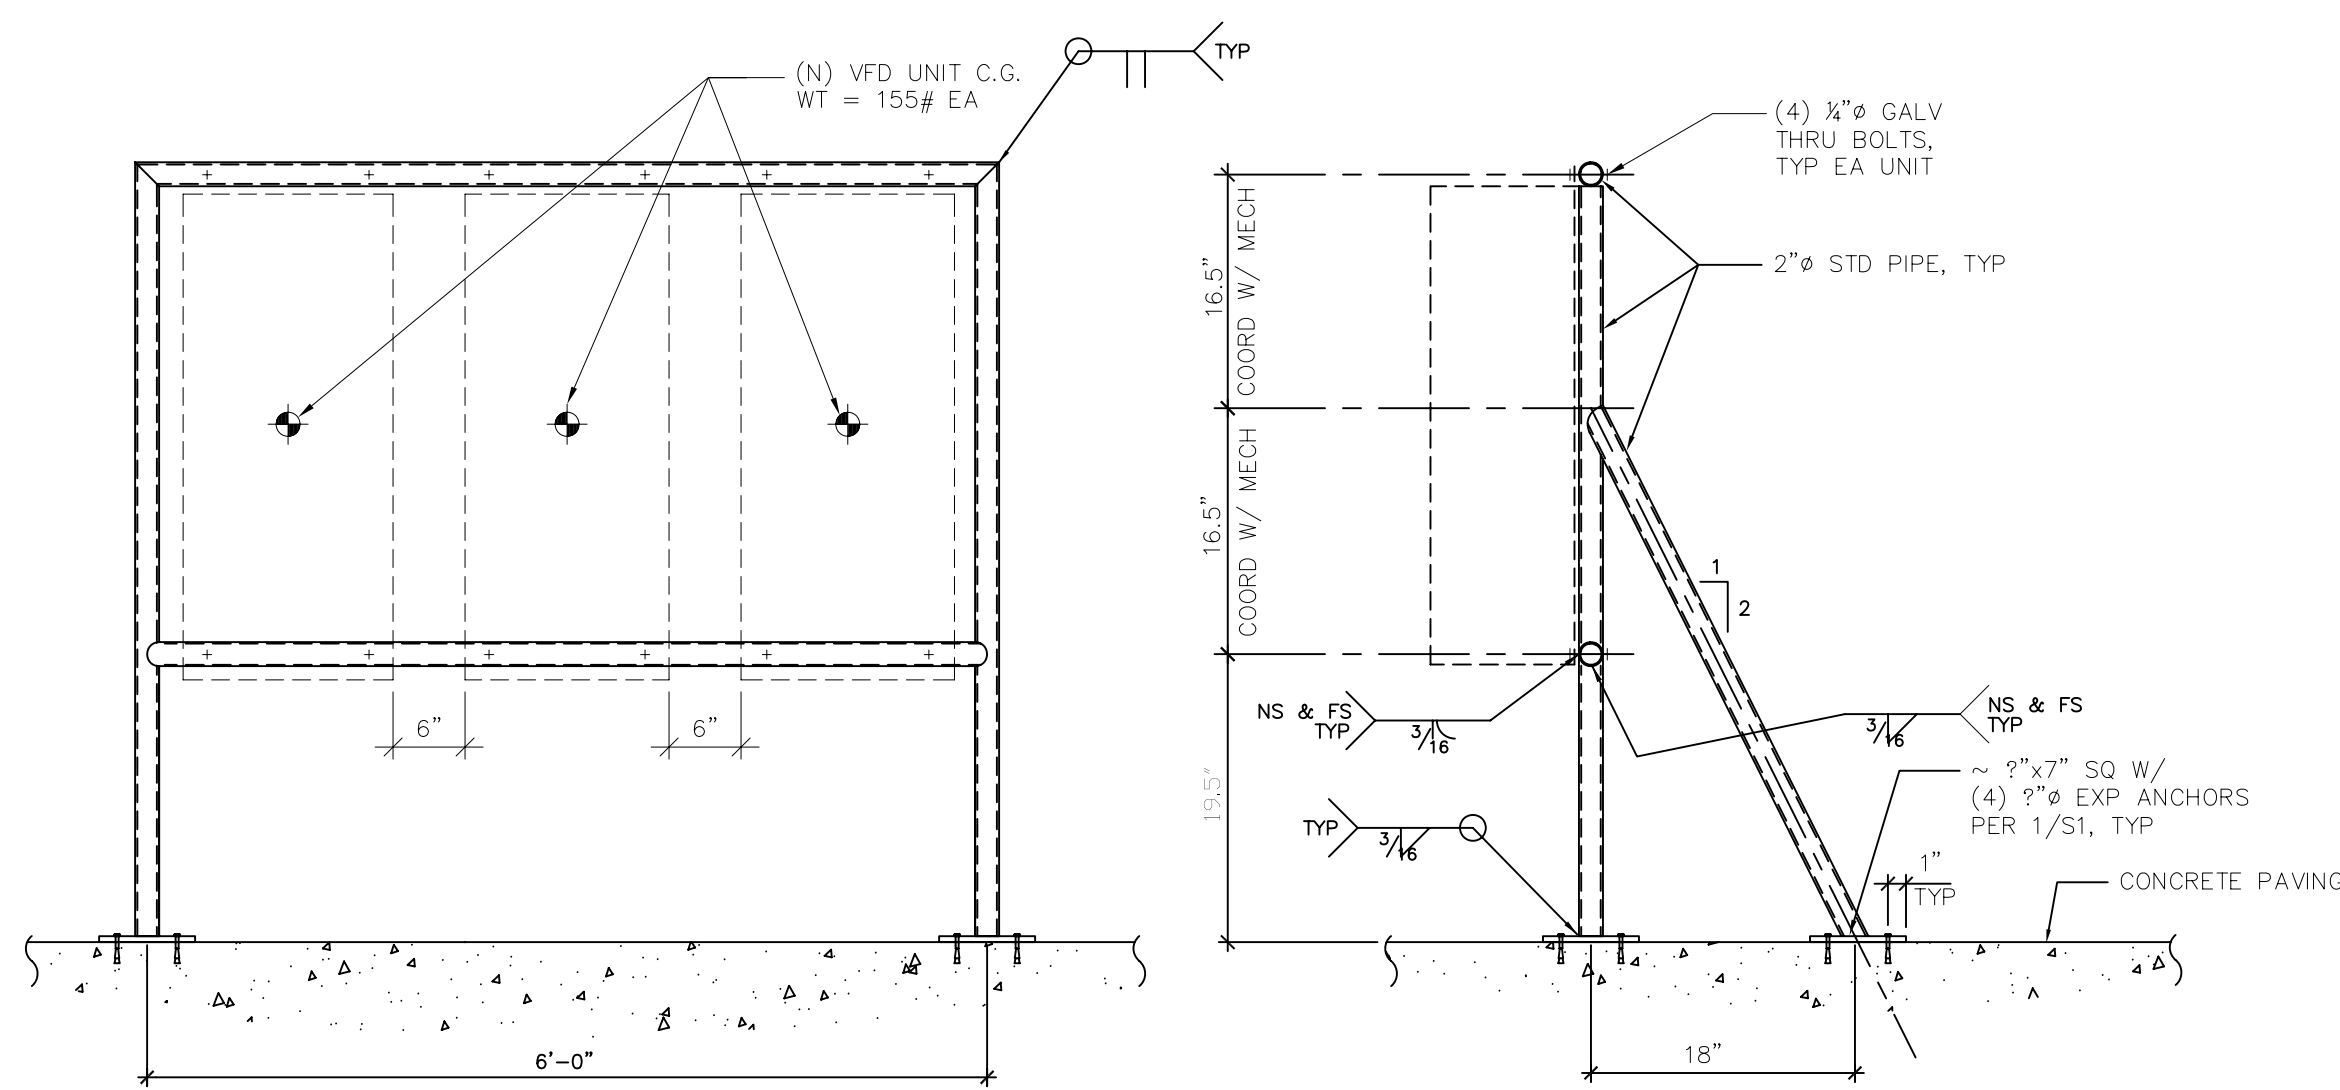


11 S3
CABINET FRAME
MECH UNIT VFD-1, VFD-2, VFD-3

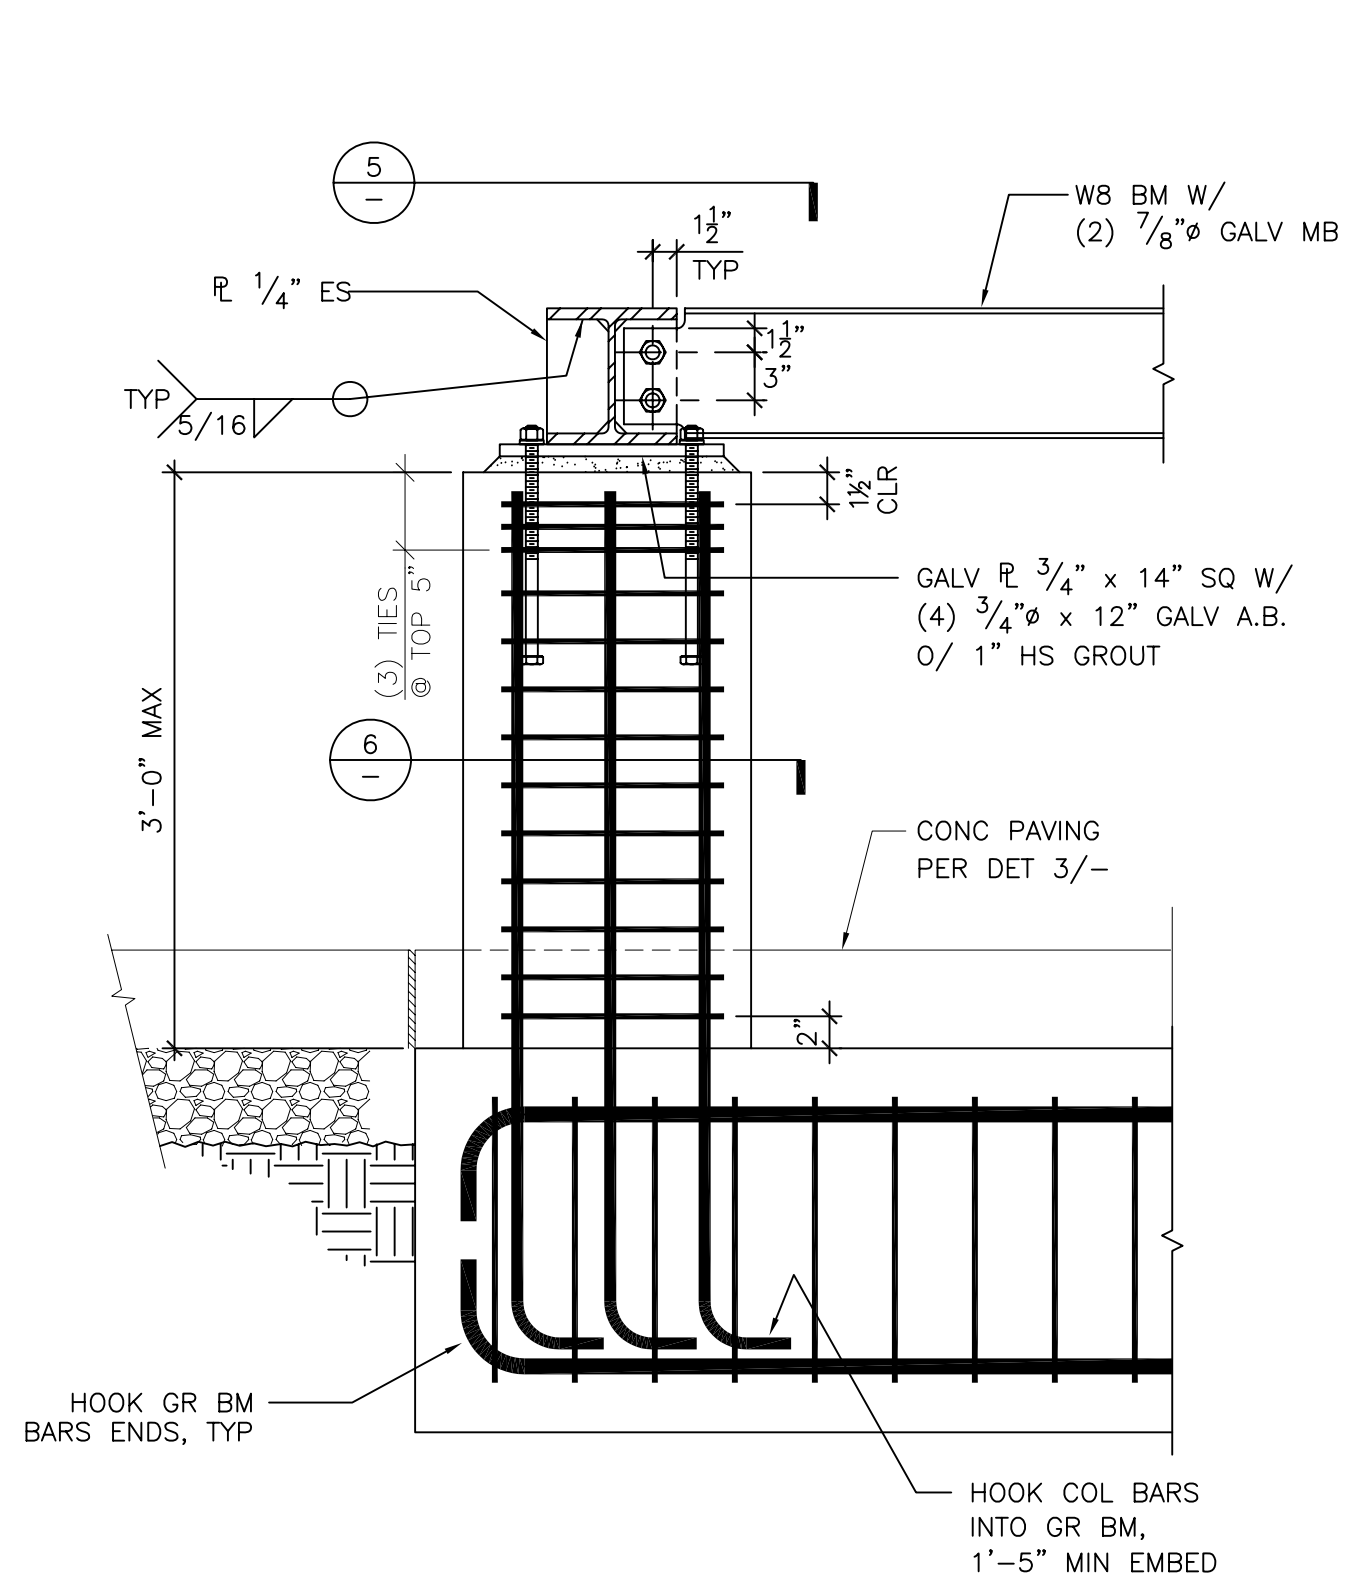


4 S3
DETAIL
1"=1'-0"

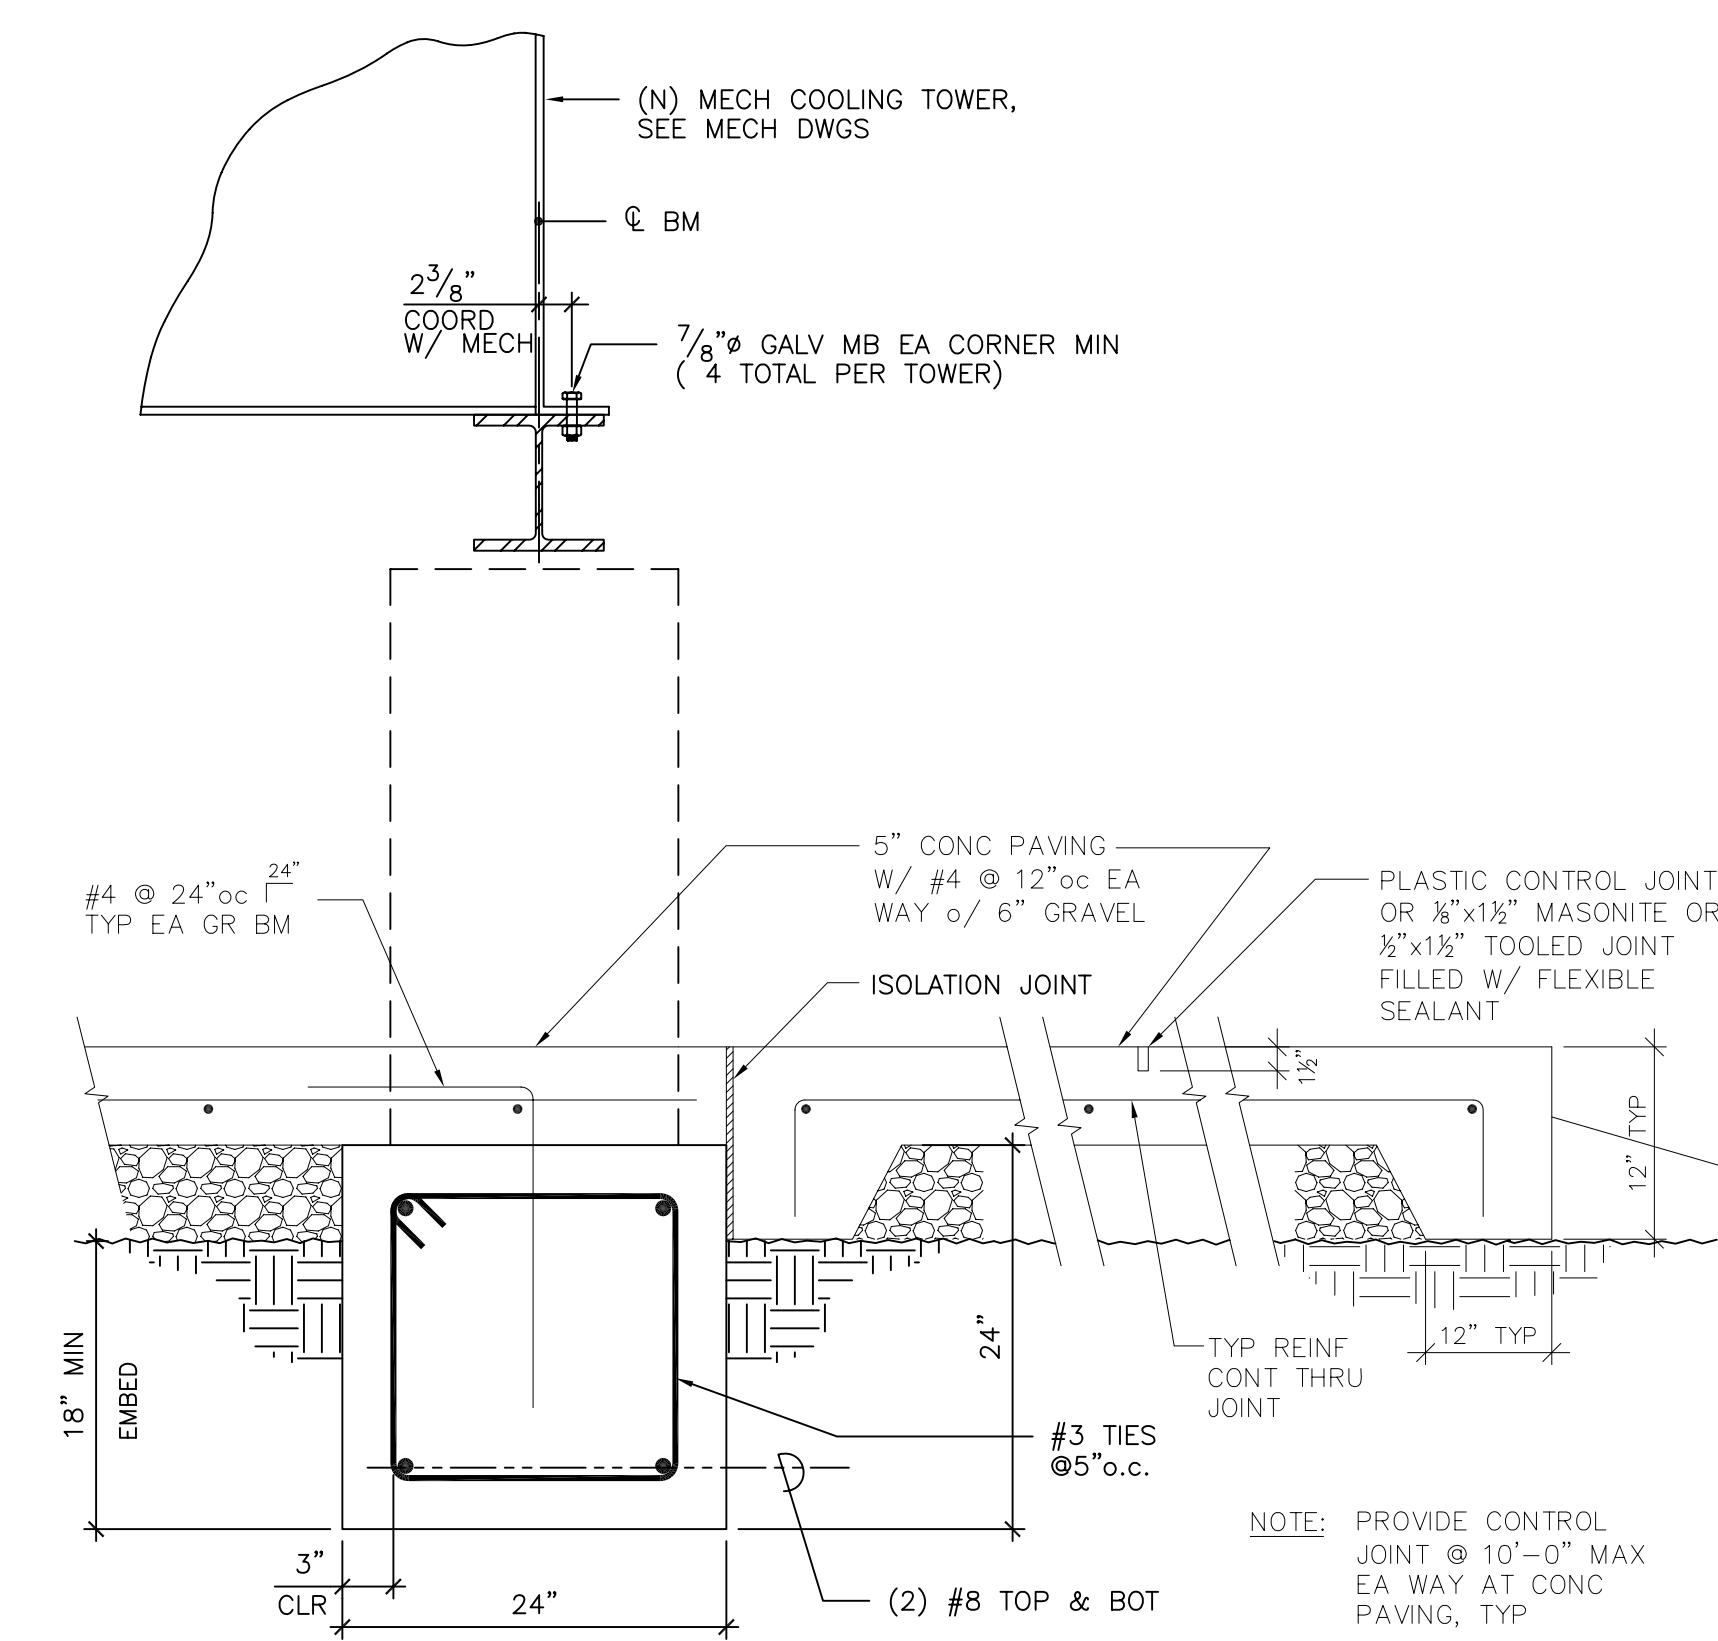


3 S3
DETAIL
1"=1'-0"

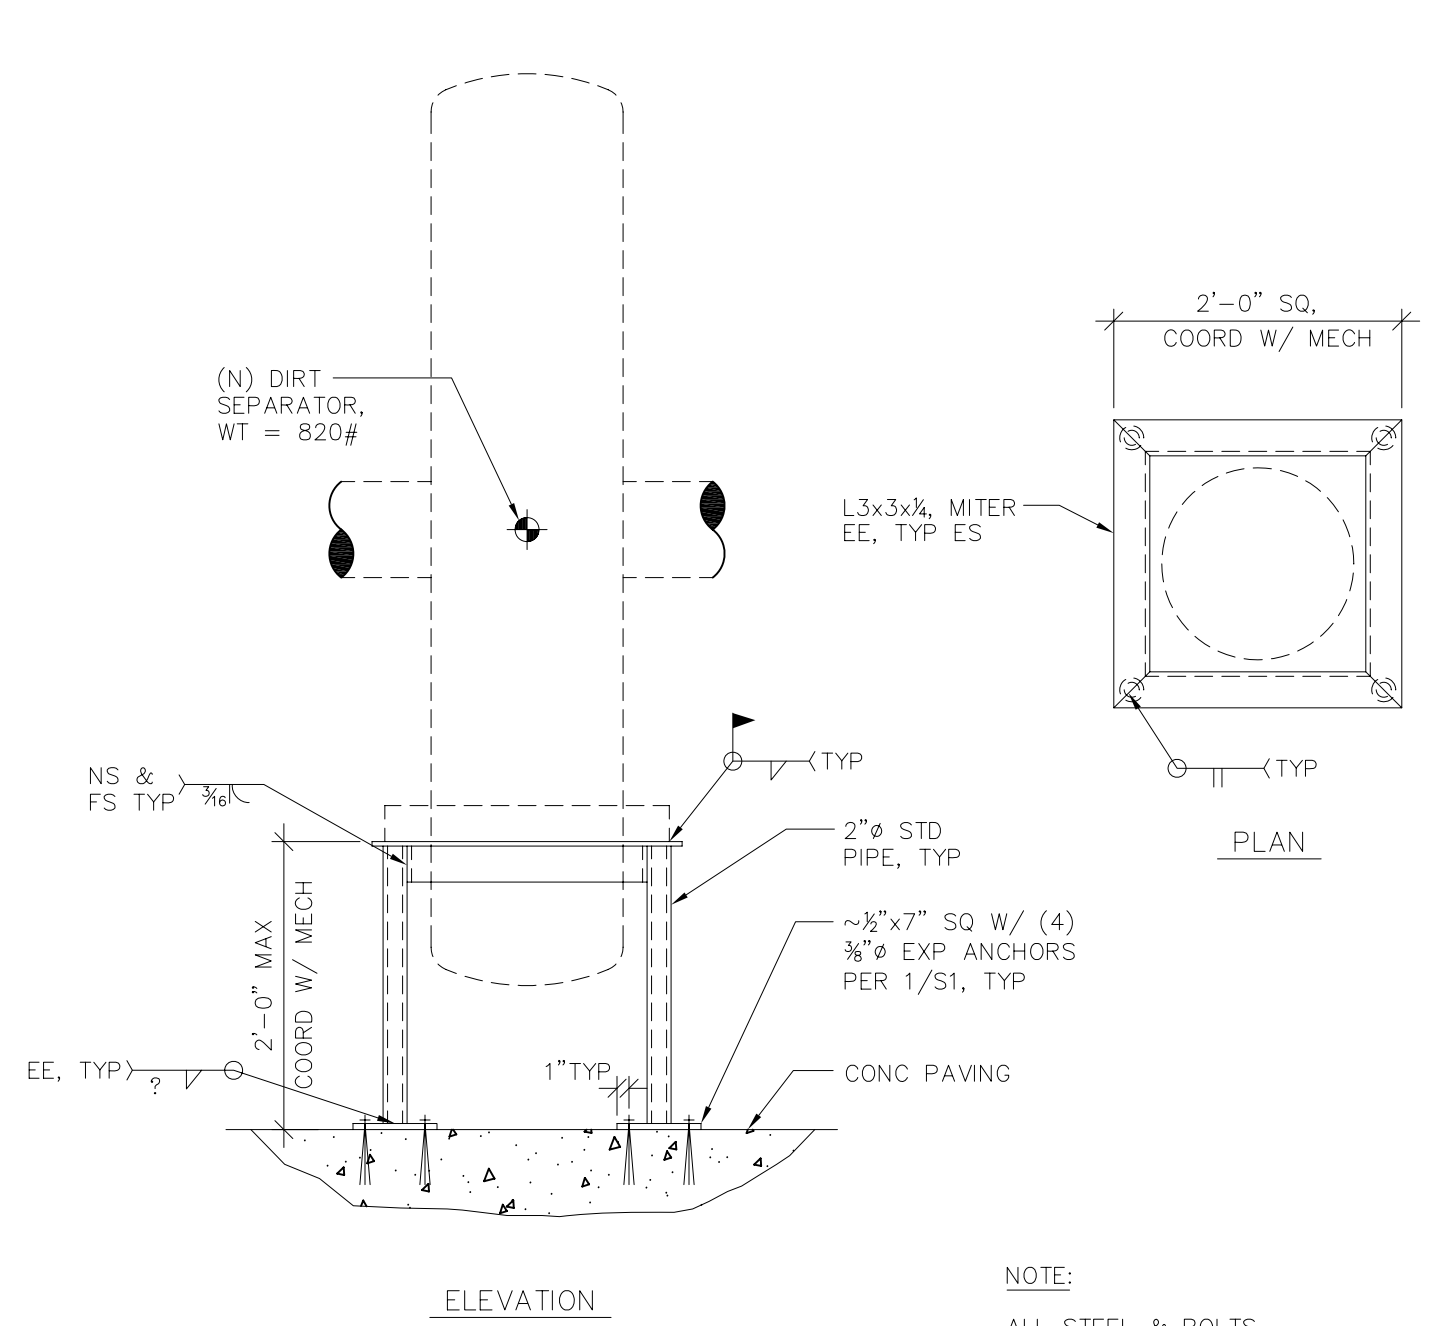


10 S3
DIRT SEPARATOR DETAIL
3/4"=1'-0"

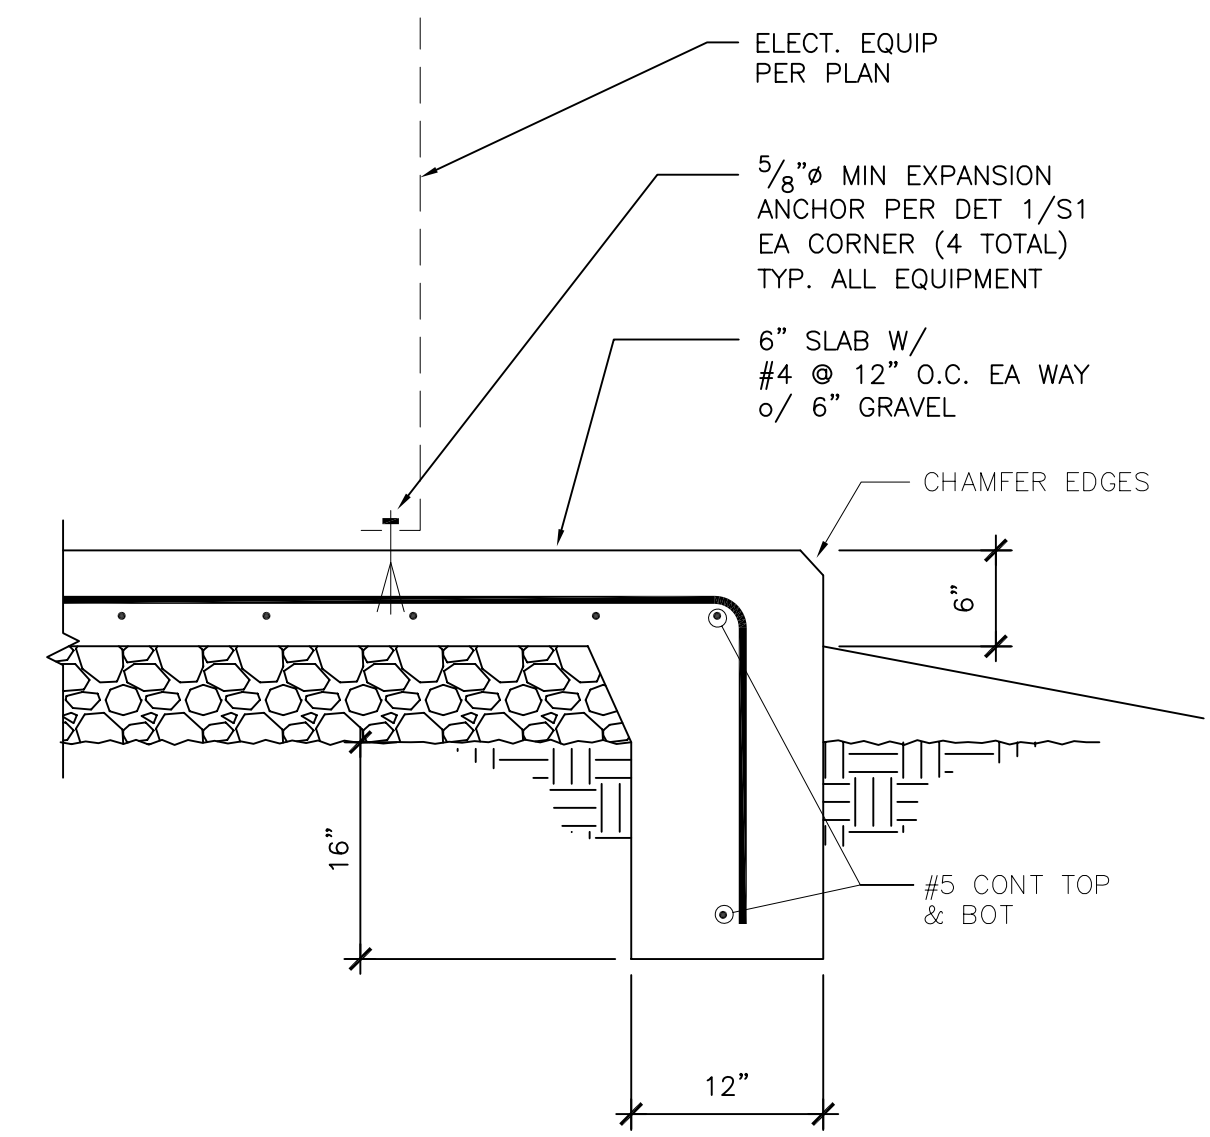


7 S3
EQUIP PAD
1"=1'-0"

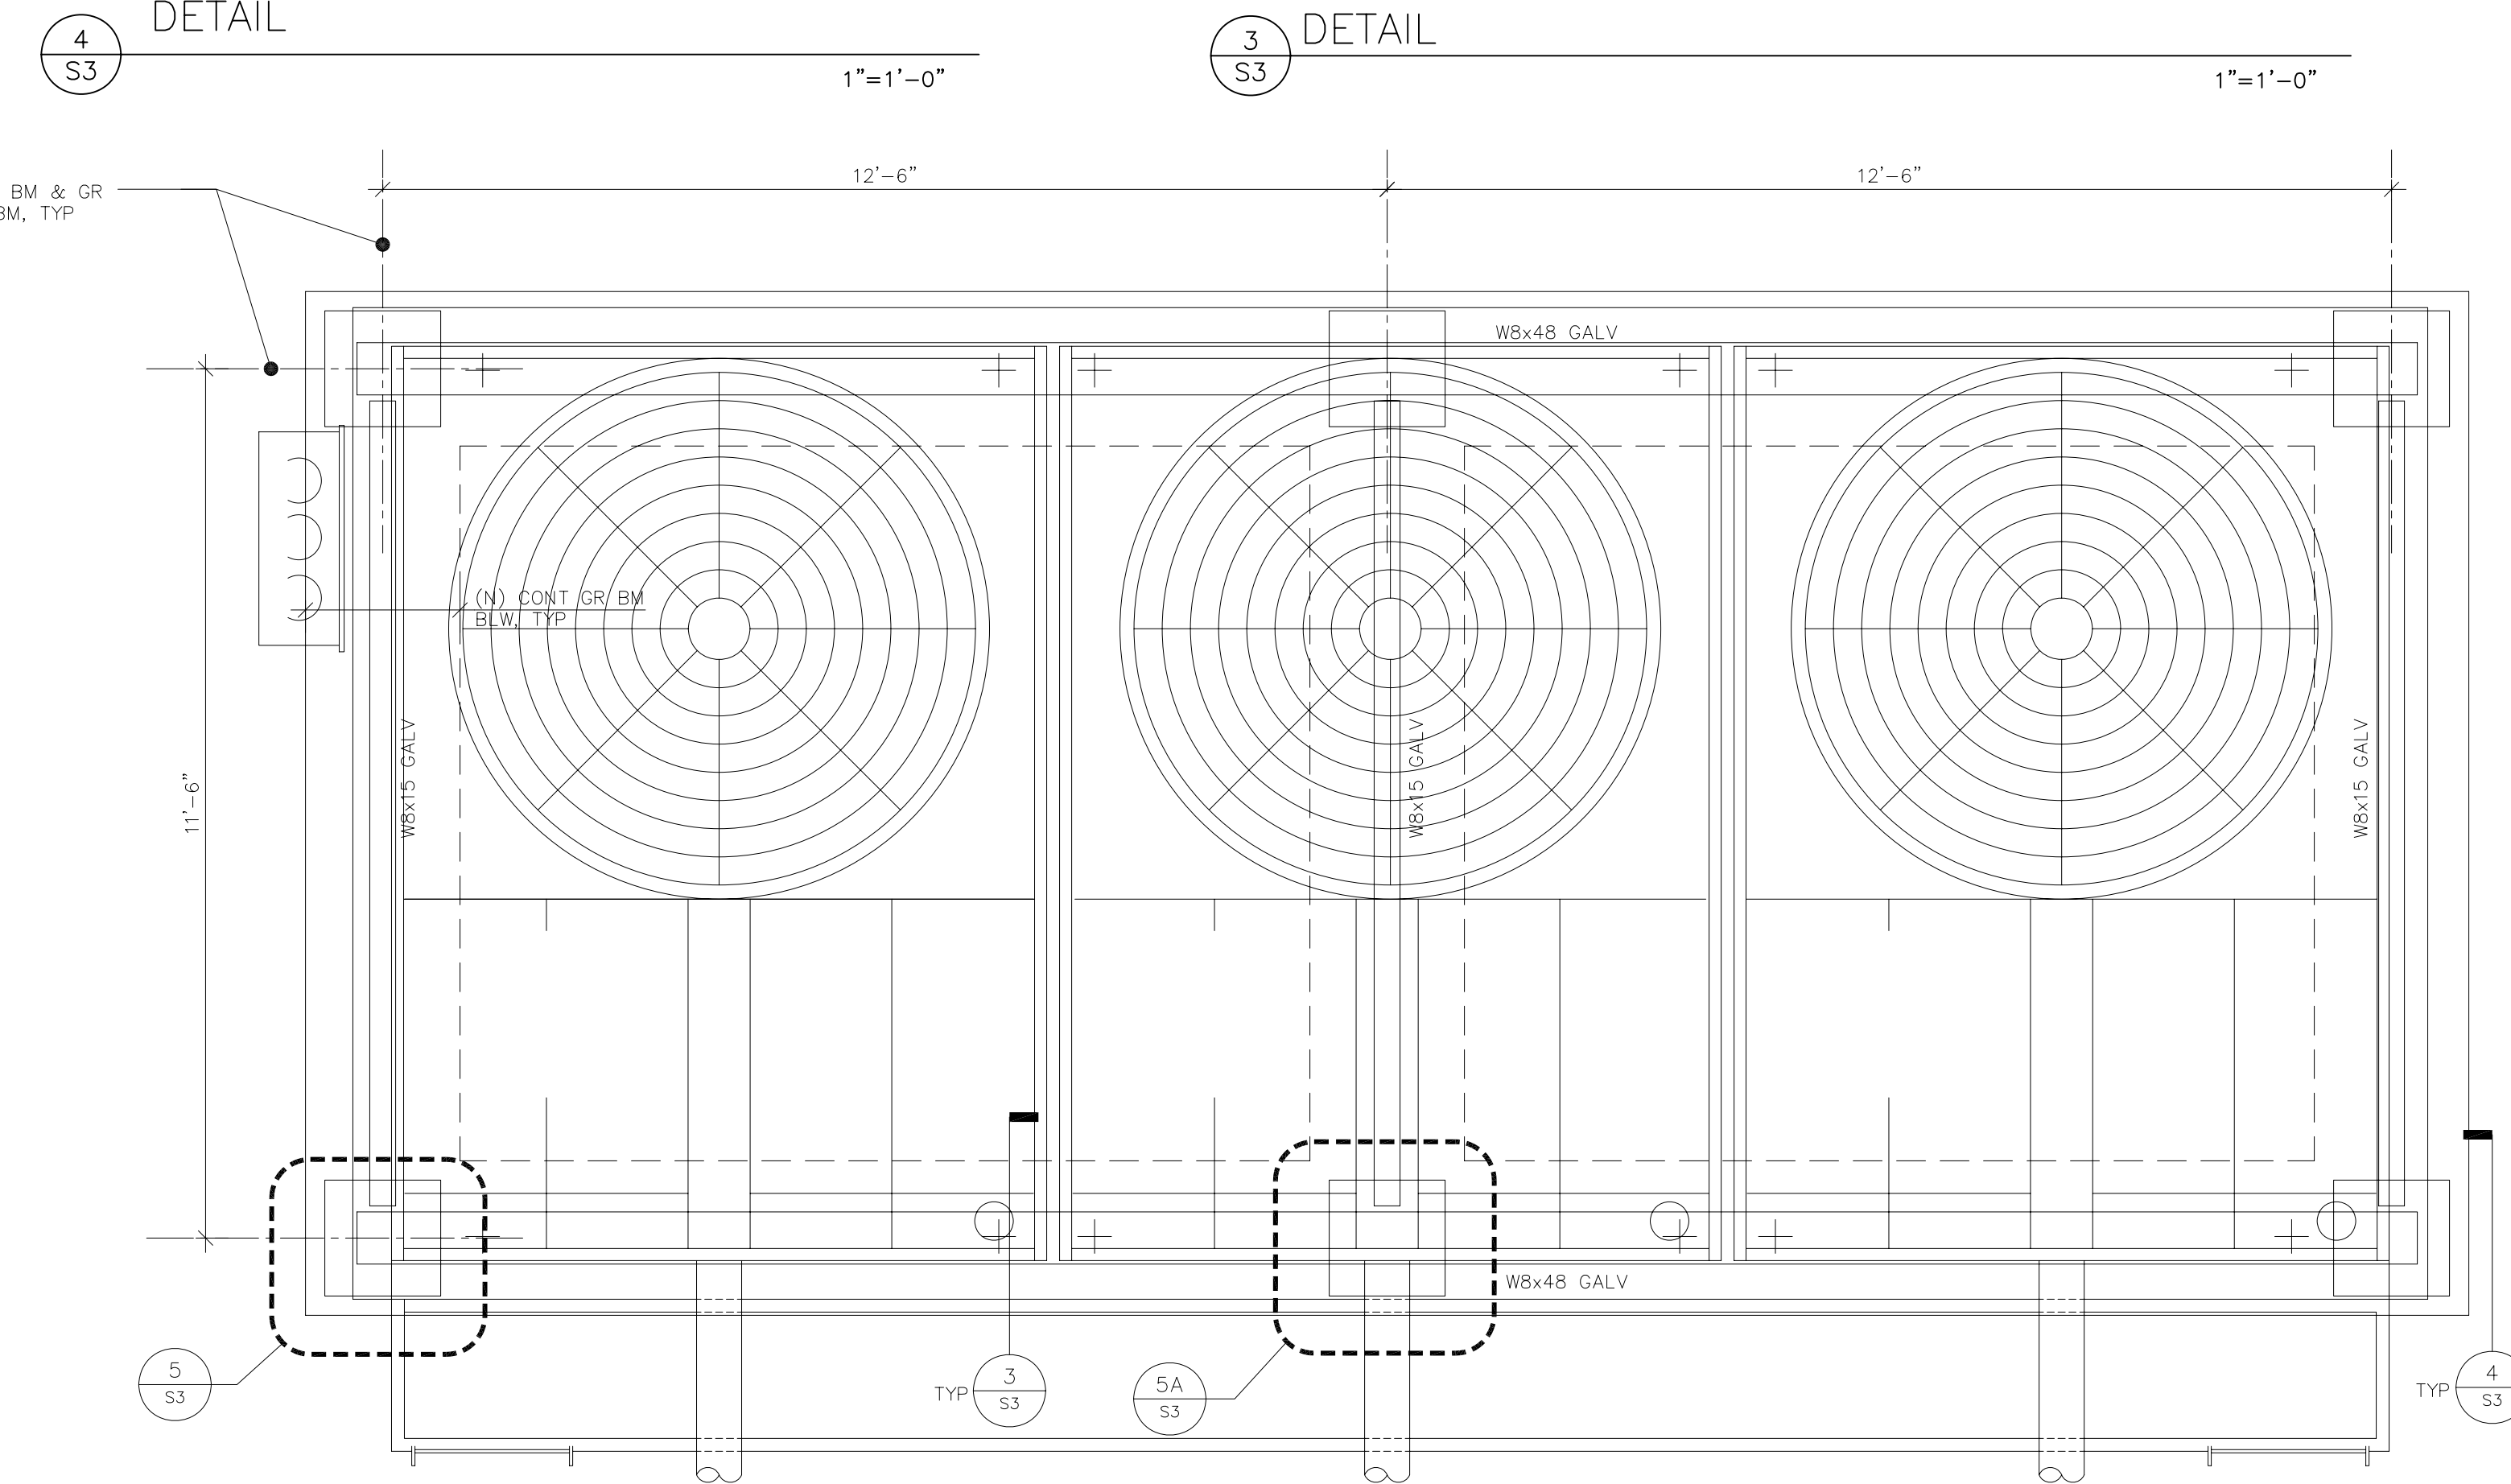


2 S3
DETAIL - PLAN
1/2"=1'-0"

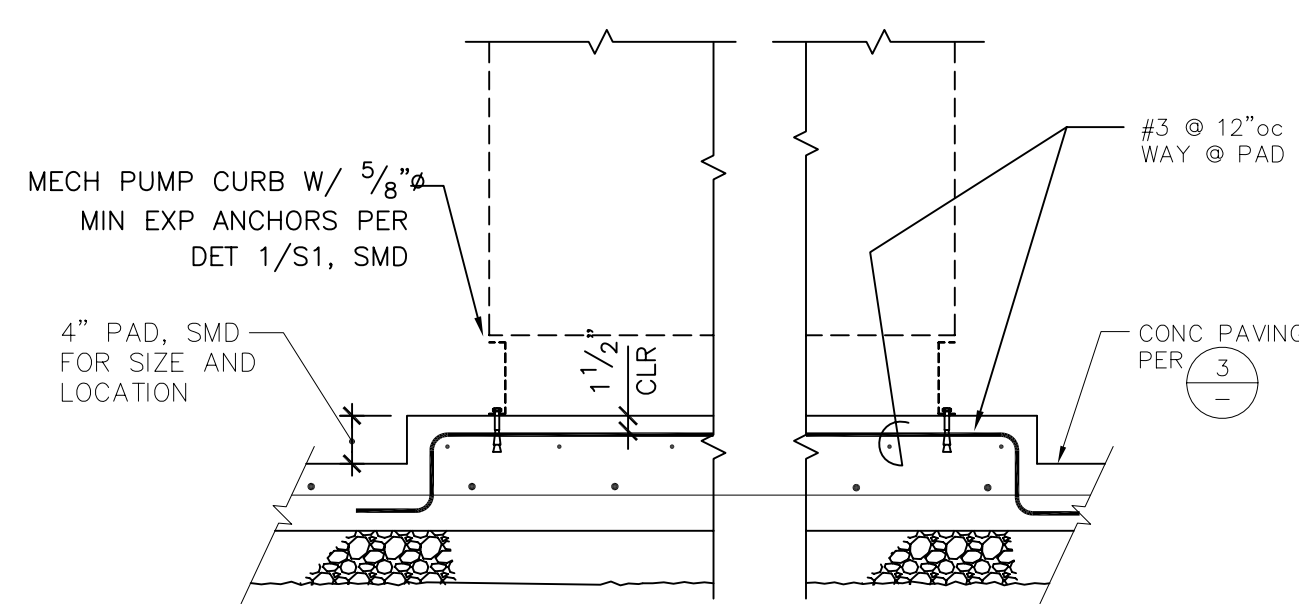


9 S3
EQUIP PAD
3/4"=1'-0"

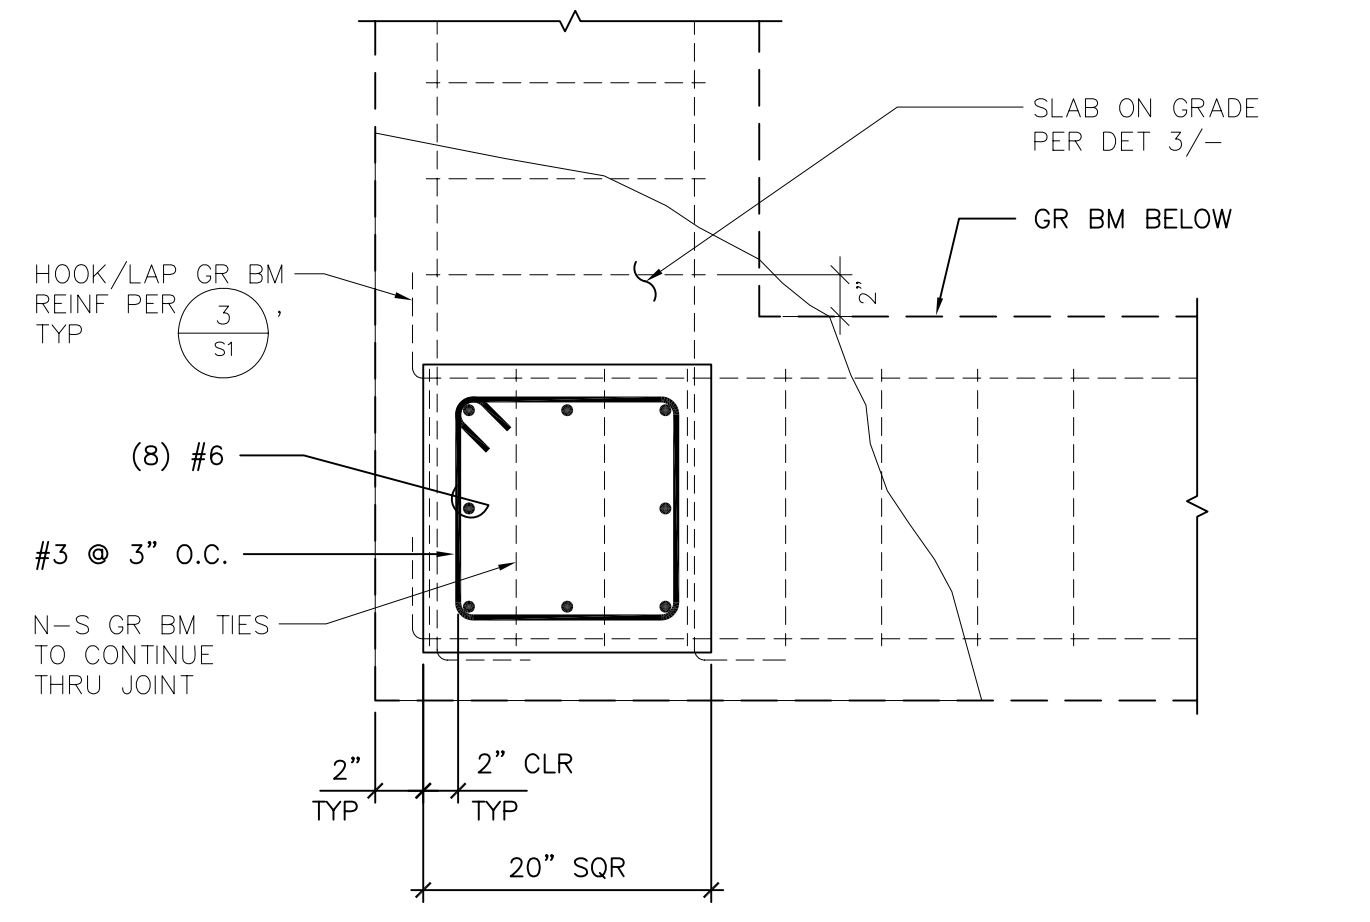


6 S3
DETAIL
1"=1'-0"

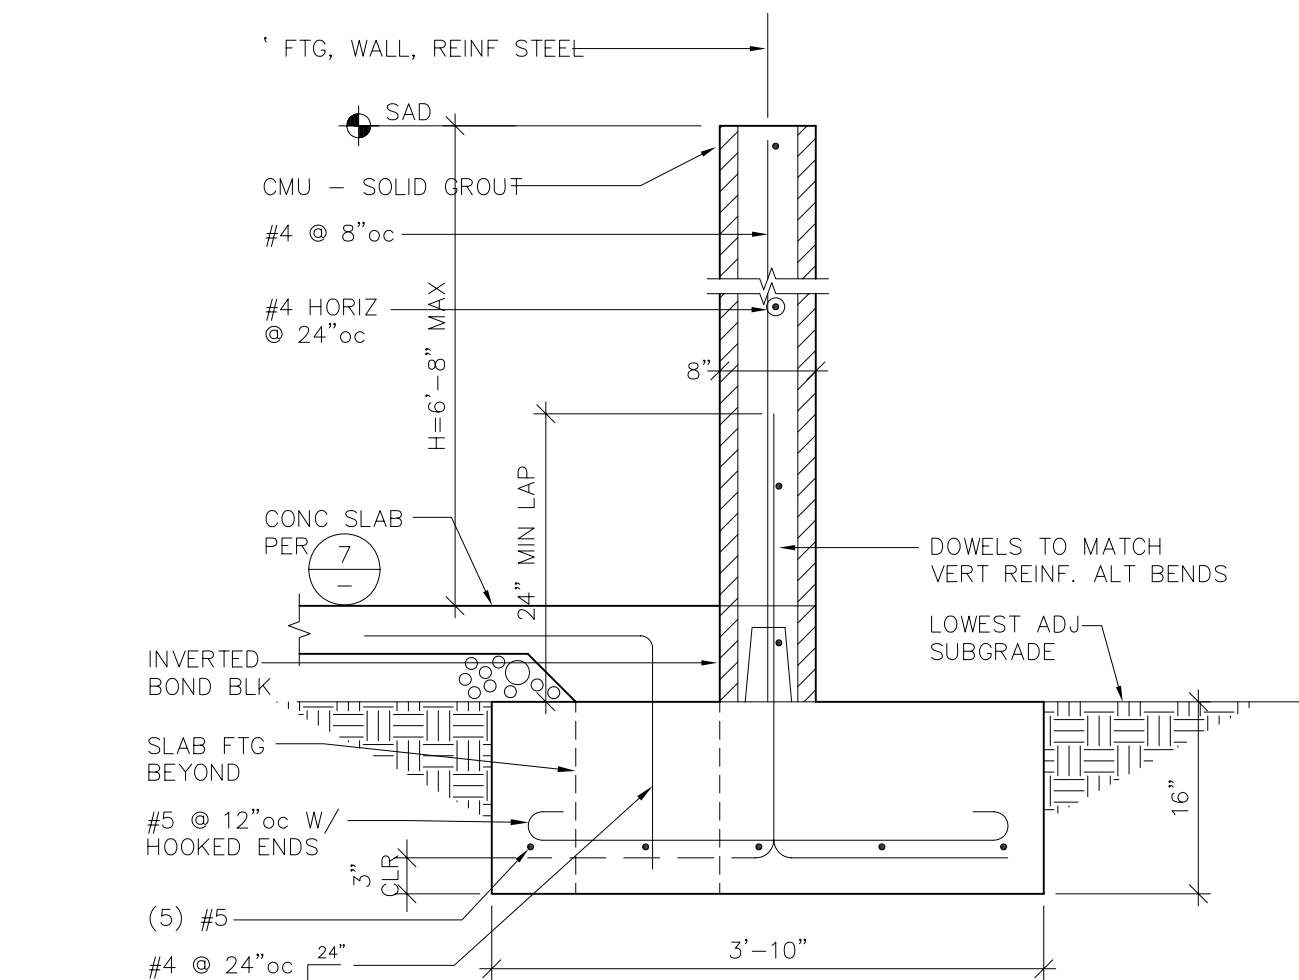

8 S3
DETAIL
3/4"=1'-0"

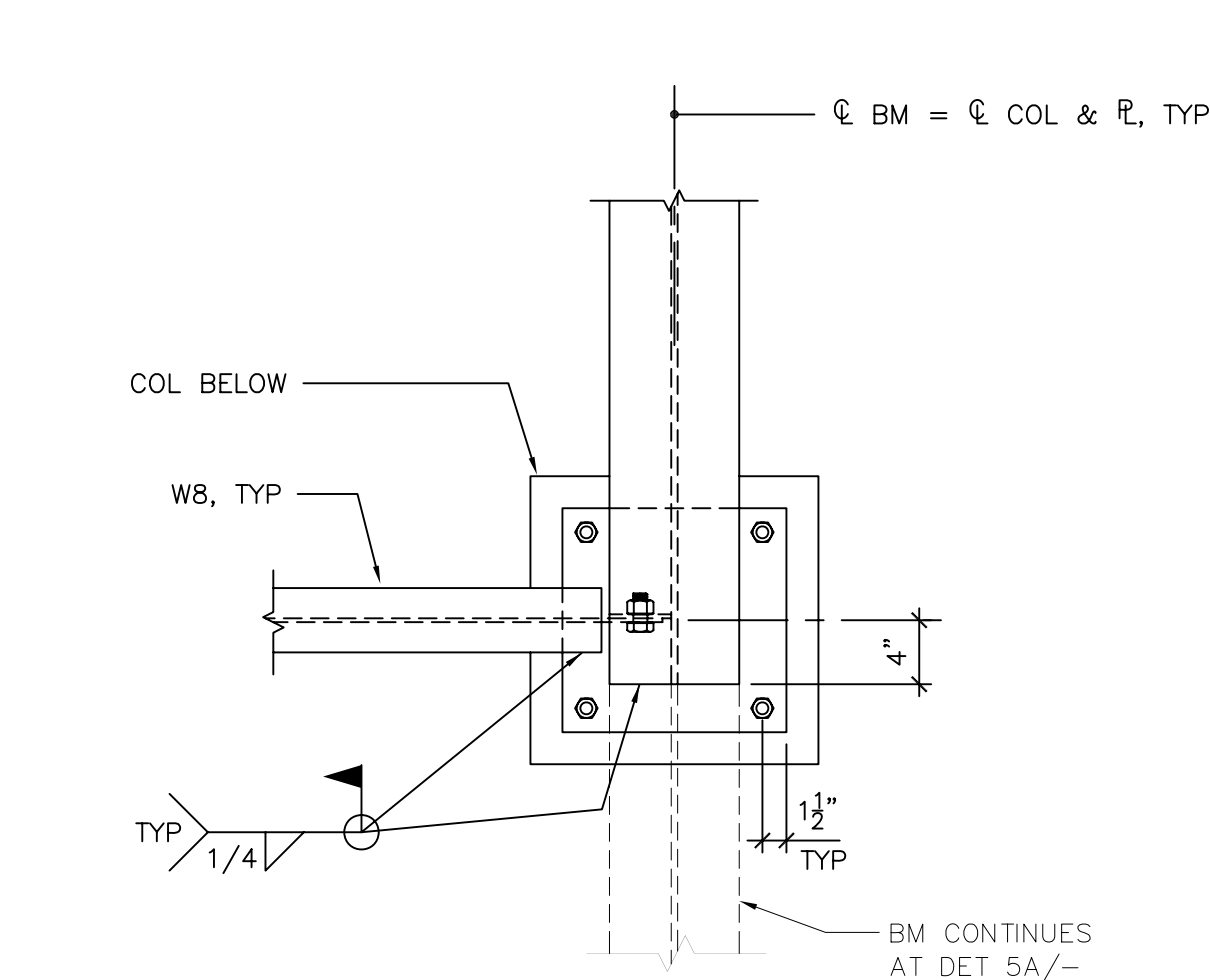


5 S3
DETAIL
1"=1'-0"

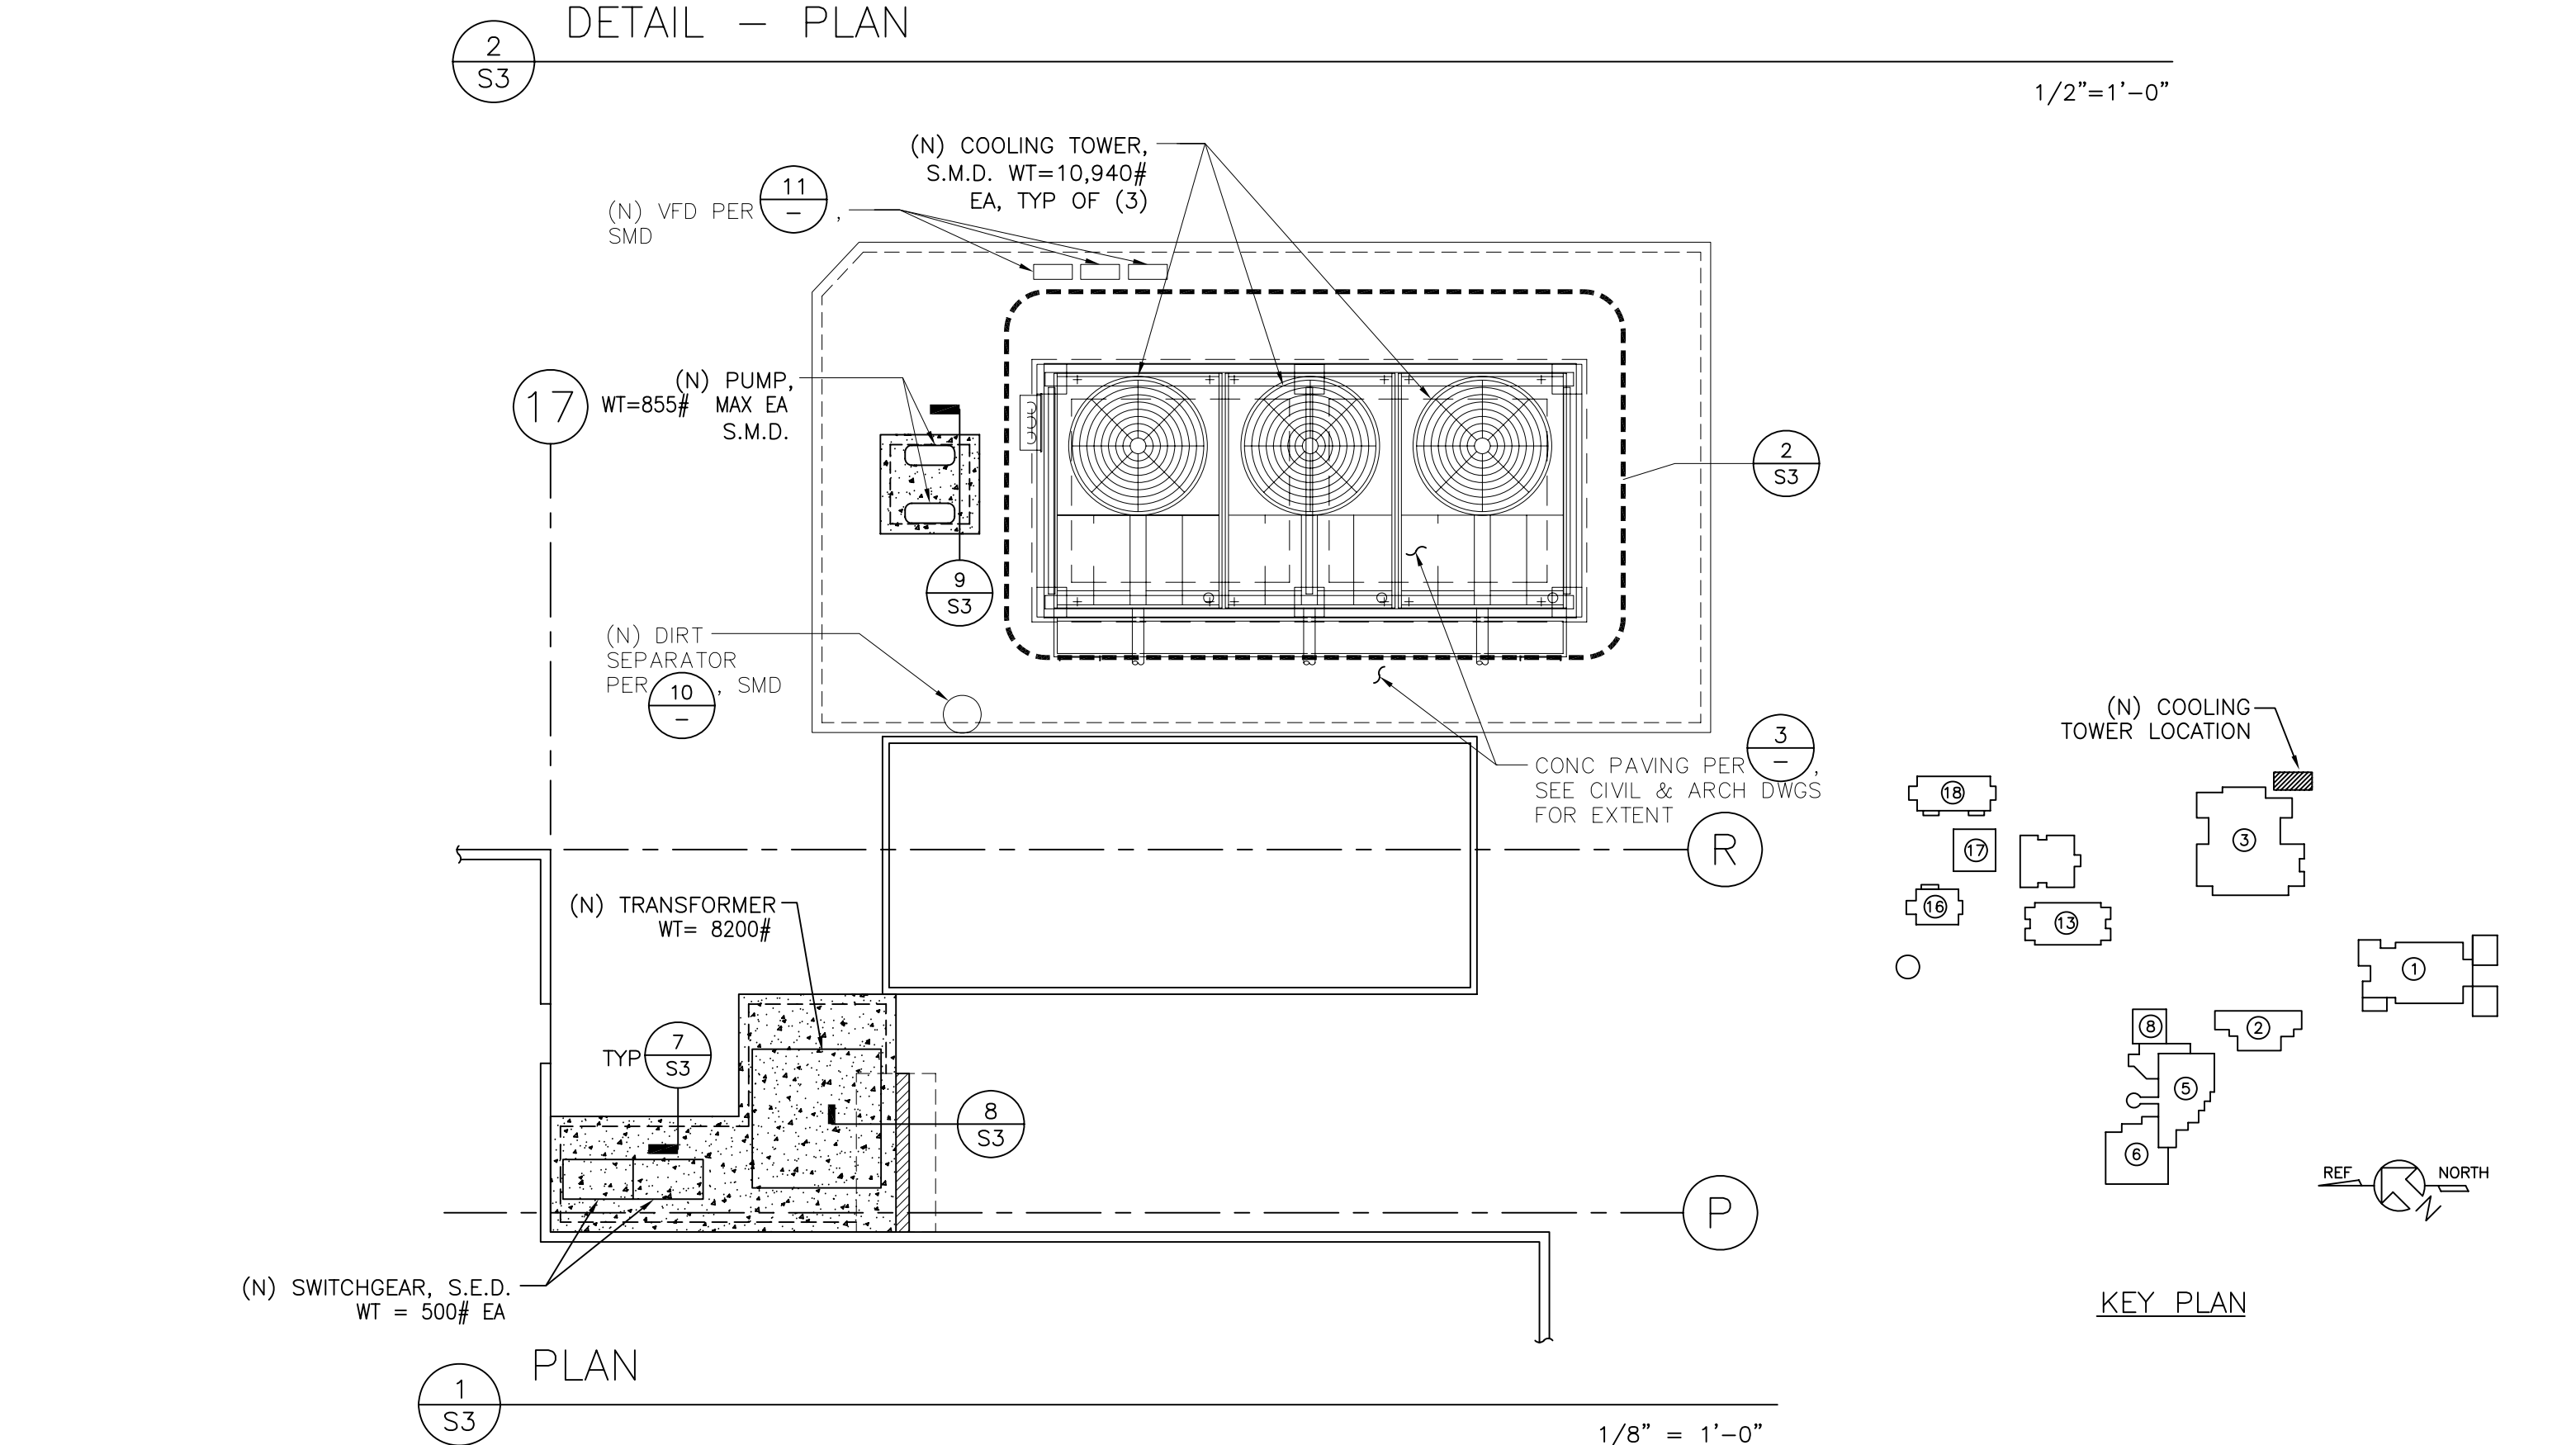

17 S3
PLAN
1/8"=1'-0"

AS BUILT

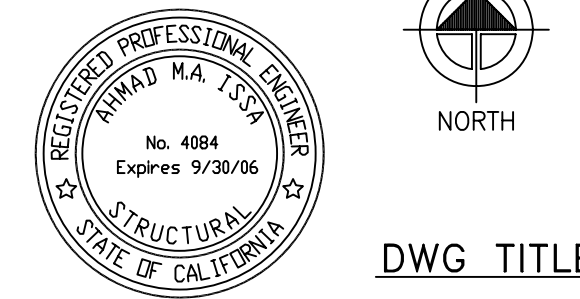

DWG TITLE