

IS INTERUPTED BY

2 - ¾"ø ANCHOR BOLTS —

C.L. BM. ABV. — — — —

4 - #6 ADD VERTS @ EA. -

VERT. BARS ARE INTERUPTED BY WALL OPENING BELOW

TERMINATE BARS WITH STD.

PILASTER DETAIL

HOOK., TYP.

1 1/2"=1'-0"

BEAM LOCATION. WHERE

BEAMS EITHER WELD BARS TO BEAM OR DRILL HOLE AND

FULL HEIGHT STIFF PL. ONE SIDE, -

BOTH SIDES 5/16 5

ANCHOR BOLTS w/ 12" MIN. EMBED, TYP.

AT C.M.U. WALL

TYP. BEAM BEARING CONN.

BEARING PL

\_1"x5½"x1'−3"

TYP. WHERE W BM OCCURS &

3/4"=1'-0"

S4.1

ROOF

- CMU FACE SHELL ELEMENTS, ANCHOR TO GROUT, TYP.

- FILL IN BLOCK-OUT

VOID W/ GROUT AFTER PLACING BEAM.

-GROUT, 2½" MAX.

-#4 TIES @ 8" O.C.


-2 - #6 BARS EA.

FACE IN NEAREST

OF WALL

CELLS FULL-HEIGHT

S4.1

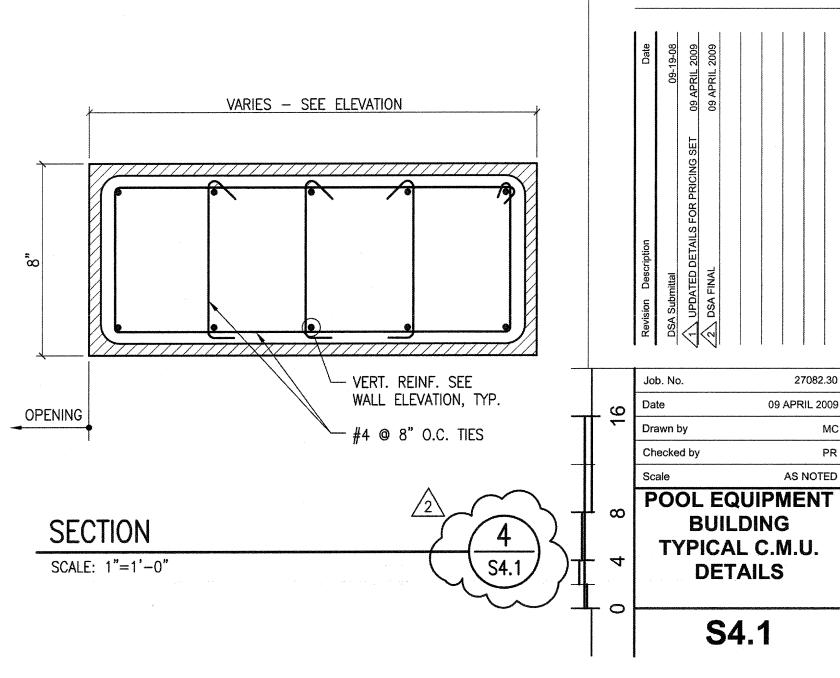

McCarthy Building Companies, Inc 343 Sansome Street, 14th Floor

FORELL/ELSESSER ENGINEERS, INC. Structural Engineers

IDENTIFICATION STAMP
DIV. OF THE STATE ARCHITECT
OFFICE OF REGULATION SERVICE

AC\_\_\_\_\_FLS\_\_\_\_SS\_\_\_D.M DATE\_\_\_\_\_\_APR 0 9 2009

This and all other project documents and all ideas, aesthetics and designs incorporated therein are instruments of service. All project documents are the registered property of LPA, INC. (LPA) and cannot be lowfully used in whole or in part for any project or purpose except as described in the contractual agreement between McCarthy and the District. LPA hereby gives formal notice that any such project document use,

reproduction or modification (misuse) is not only unlawful but automatically binds all parties involved with misuse to fully

indemnify and defend LPA and LPA's Consultants to the maximum legal extent against all losses, demands, claims or liabilities arising directly or indirectly from project document

are not a representation of as-built or existing conditions.

LPA and LPA's Consultants make no representations concerning the accuracy of documents and are not responsible for any

discrepancies between project documents and the existing

© Copyright 2008

Colle Site

Structural Engineers

160 Pine Street · San Francisco, CA. 94111
Phone: (415) 837-0700 · Fax: (415) 837-0800
www.forell.com Job No.: 06-091.004A

APPL #: 01-110097

San Francisco, California 94104

P 415 | 364-1339 F 415 | 397-5999

S4.1

S4.1

S4.1