


ASI - 11

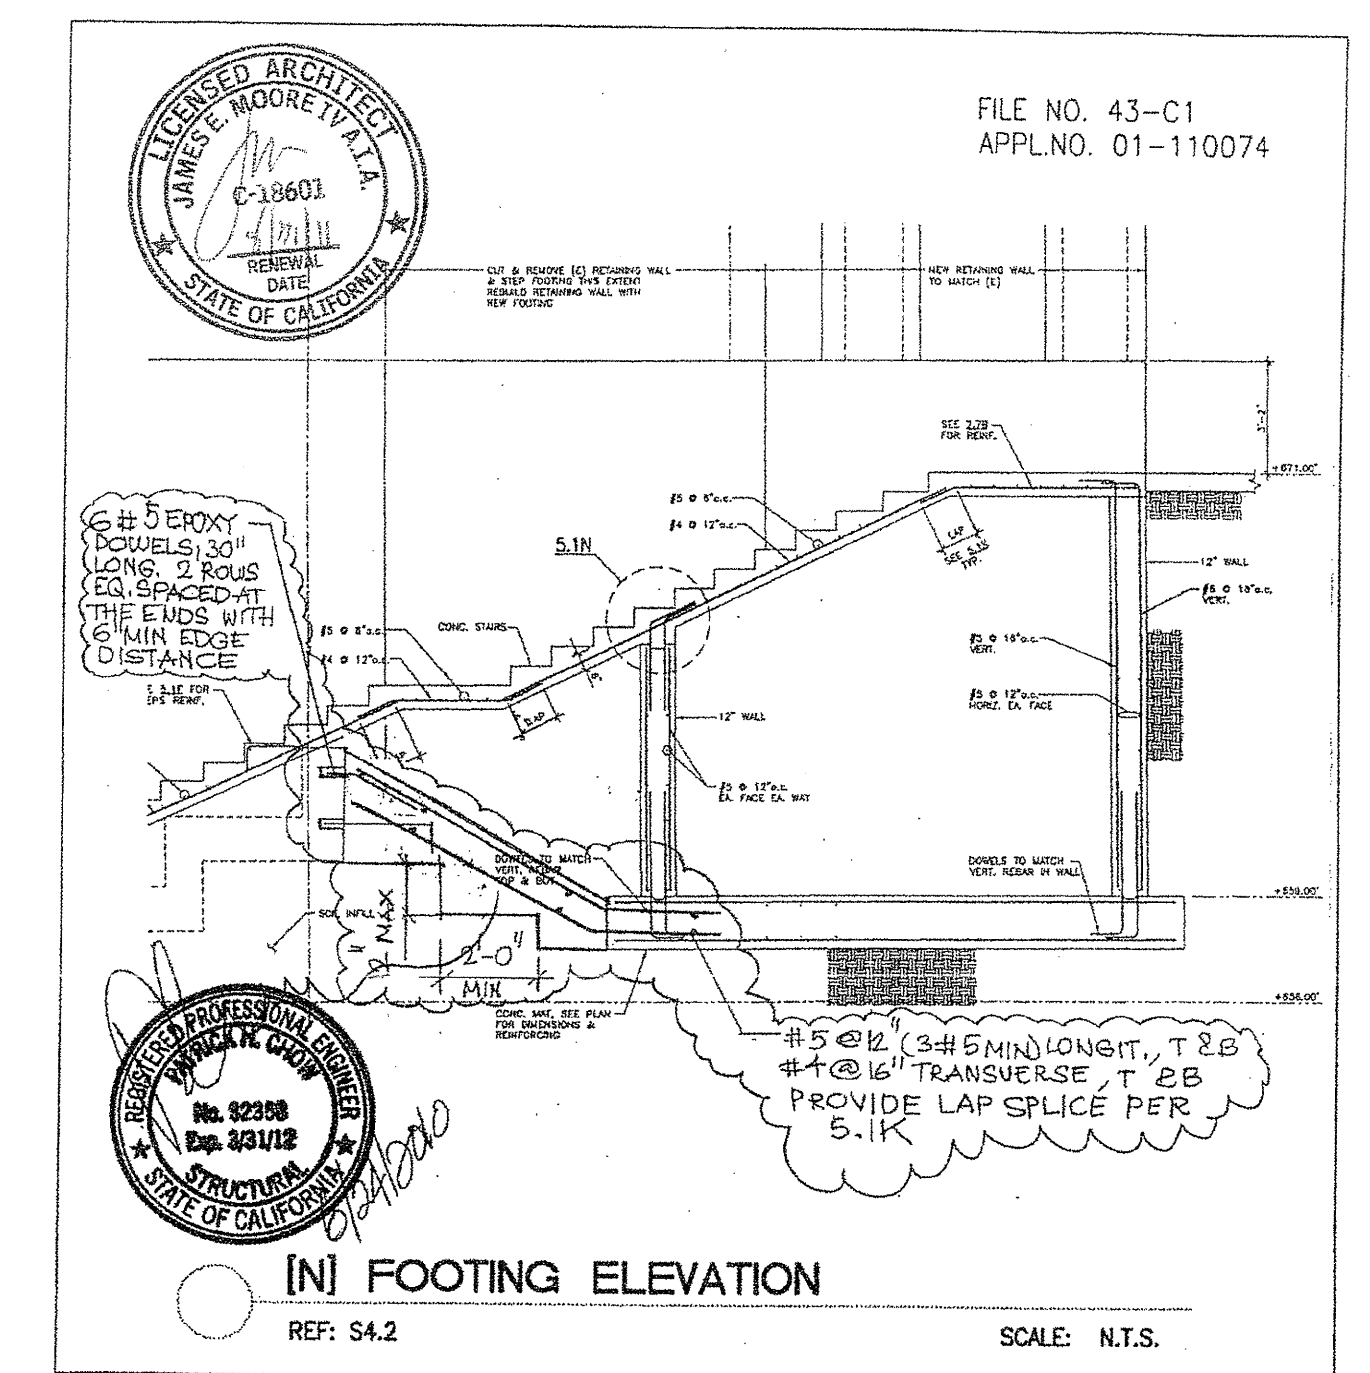

<b>BCA</b>	Title	Revision
ARCHITECTS ENGINEERS PLUMBERS ELECTRICIANS	[N] FTG @ GRID 18 BETWEEN "Z" AND "AA"	
210 Hammond Ave. Redwood City, CA 94061 Tel: 650.448.1000 Fax: 650.448.1000	Project Name: CANADA COLLEGE - BUILDINGS 5 & 6 RENOVATIONS SAN MATEO COUNTY COMMUNITY COLLEGE DISTRICT 4200 FARM HILL BOULEVARD REDWOOD CITY, CA 94061 FILE NO. 43-C1 APPL. 01-110074	Date: 06/24/10 Scale: AS NOTED Project Number: 07913

SK-1