


RECUIVED

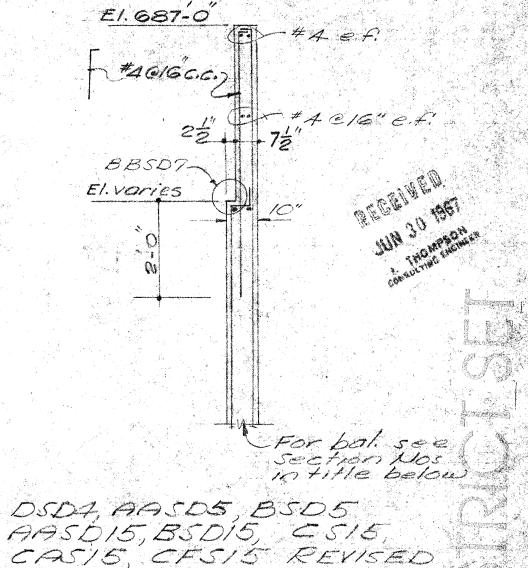

A A S D 29

12 Revised 12-27-67 J.M. REVISED WALL SECTIONS 1-2-629 BUILDING D TENDONINE HOPEOUR S-7-69 COLLEGE OF SAN MATEO STATE OF CALIFORNIA — DEPARTMENT OF GENERAL SERVICES
OFFICE OF ARCHITECTURE AND CONSTRUCTION DRAWN BY JOHN CARL WARNICKE 27746 Opp 5/10/47 100 6/26/20/07 MHW ARCHITECT DATE 5-5-67 APPLICATION POT_ I. THOMPSON SHEET NO APPLICATION NO. 27746 1304

RECEIVED

138 2 0 1367

VIOSEMICHT A

JANIT 1968
CONSTRUCTION OFFICE

ARCHITECT

A 6-21.67